


DRAWING NUMBER: MD - 216 - 3510 - EG - CV - GAD - 1277
REV: D01

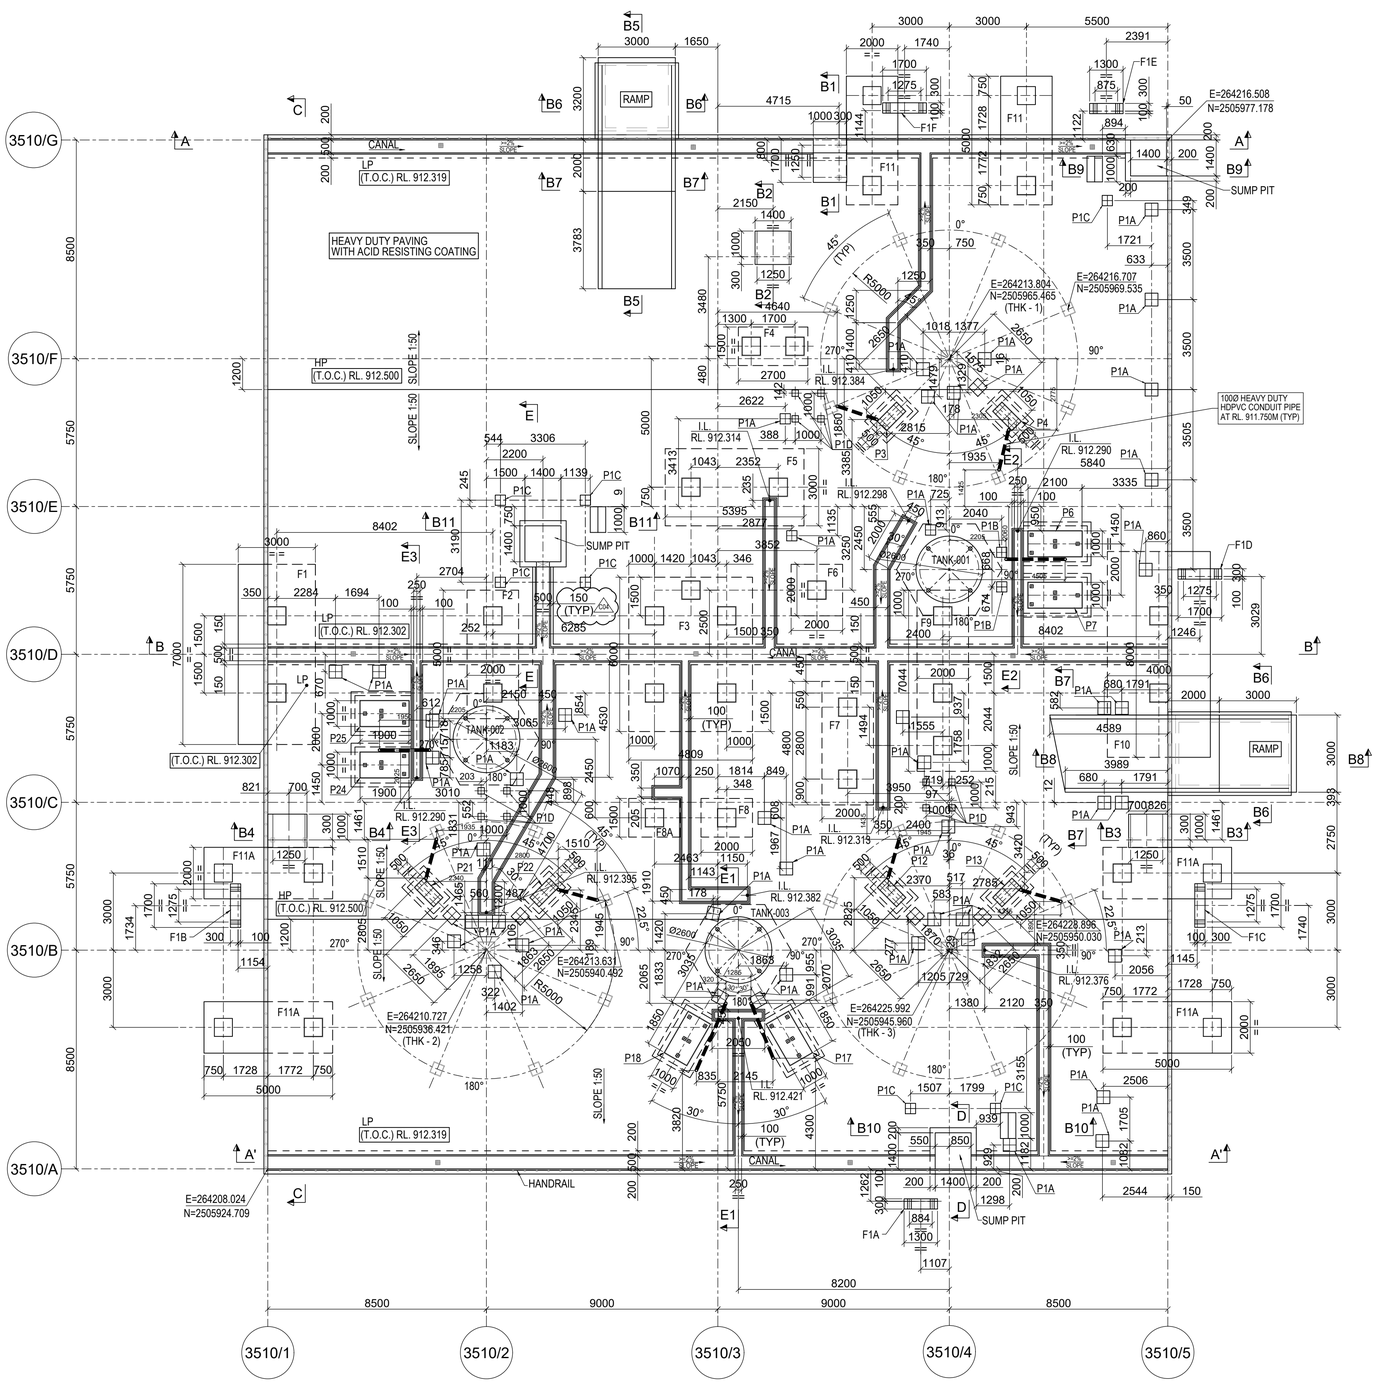

LAYOUT PLAN FOR CCD AREA
(SCALE - 1:125)

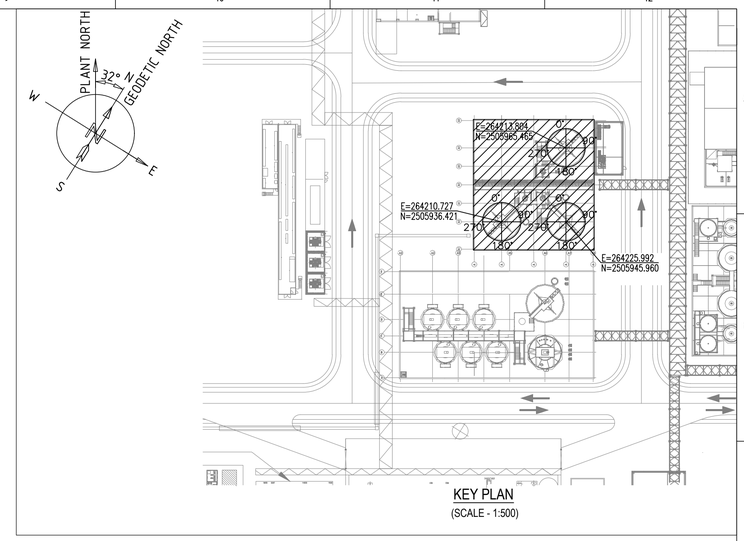

KEY PLAN
(SCALE - 1:500)

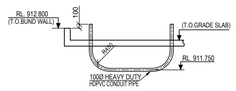

TYPICAL DETAIL OF CONDUIT
(FOR LOCATION REF. LAYOUT PLAN)
(SCALE 1:50)

LEGEND :-

R.L. - REDUCED LEVEL
T.O.C. - TOP OF CONCRETE.
F.G.L. - FINISHED GROUND LEVEL
B.O.F. - BOTTOM OF FOUNDATION
P.C.C - PLAIN CEMENT CONCRETE
TYP. - TYPICAL.
MKD. - MARKED.
THK. - THICK
℄ - CENTRE LINE
H.P. - HIGH POINT
L.P. - LOW POINT
DRG. - DRAWING
Ø - DIAMETER
I.L. - INVERT LEVEL

NOTES:-

1. ALL DIMENSIONS ARE IN MILLIMETRES AND LEVELS ARE IN METRES UNLESS OTHERWISE STATED.
2. GRADE OF CONCRETE SHALL BE C35 UNLESS NOTED OTHERWISE.
3. GRADE OF REINFORCEMENT SHALL BE DEFORMED BAR ASTM A615-GRADE 60 (fy=420 MPa)
4. NET SAFE BEARING CAPACITY CONSIDERED AT THE FOUNDING LEVEL IS 460 KN/SQ. M
5. IF ANY PART OF FOUNDATION COMES ON BACKFILL ZONE OF ADJACENT FOUNDATION OR ANY LOOSE POCKETS ARE ENCOUNTERED BELOW FOUNDATION LEVEL THE SAME SHALL BE REMOVED AND FILLED WITH PCC.
6. FOR DETAIL DRAWING REFER DRG. NO. MD - 216 - 3510 - EG - CV - DED - 1279. MD - 216 - 3510 - EG - CV - DED - 1280.
7. THIS DRAWING SHOULD READ IN CONJUNCTION WITH DRG. NO : MD - 216 - 3510 - EG - CV - GAD - 1278. MD - 216 - 3510 - EG - CV - GAD - 1279. MD - 216 - 3510 - EG - CV - GAD - 1280.
8. FOR STANDARD DETAILS FOR PAVING REFER DRG. NO : MD-216-1000-EG-CV-DED-1002.
9. FOR ELECTRICAL CABLE ROUTE LAYOUT EMBEDDED PART REF. DRG. NO : MD-216-3500-EG-EL-LAD-1010.

REFERENCE DOCUMENTS		REV	DATE	REVISION DESCRIPTION	DRN	CHK	ENG	APP	EMP
		D01	22/02/2023	AS-BUILT	SBH	BDA	STY	AG	
		C04	08/03/2021	ISSUED FOR CONSTRUCTION AND REVISED AS MARKED	SBH	BDA	STY	AG	
		C03	11/11/2020	ISSUED FOR CONSTRUCTION AND REVISED AS MARKED	SBH	BDA	STY	AG	
MD-216-3510-EG-CV-GAD-1002	PLAN AT RL. 912.5 GRID D-G / 1-5	C02	17/10/2020	ISSUED FOR CONSTRUCTION AND REVISED AS MARKED	SBH	BDA	STY	AG	
MD-216-3510-EG-CV-GAD-1001	PLAN AT RL. 912.5 GRID A-D / 1-5	C01	20/05/2020	ISSUED FOR CONSTRUCTION AND REVISED AS MARKED	APM	BDA	STY	AG	
MD-216-3510-EG-ME-GAD-1025	CCD CIRCUIT STEEL STRUCTURE LOADING DIAGRAM	A01	30/03/2020	ISSUED FOR REFERENCE	APM	BDA	STY	AG	
DOCUMENT NUMBER					DRN	CHK	ENG	APP	EMP

RESERVED FOR VENDOR LOGO AND DRAWING NUMBER

LARSEN & TOUBRO DRAWING NUMBER: 019045_450_C_G_24116_002 — REVISION: 5
OUTOTEC DRAWING NUMBER: 900707__GAU01__ST61__MTL03__35108 — DOCUMENT ID: OU100673100 — REVISION: 5

LARSEN & TOUBRO
This drawing is the property of LARSEN & TOUBRO and must not be passed on to any person or body not authorized by us to receive it nor be copied or otherwise made use either in full or in part by such person or body without our prior permission in writing.

Outotec
The content of these documents are the sole property of Outotec Oyj. Any rights not expressly granted herein are reserved. Reproduction, transfer or distribution of part or all of the contents in any form without prior written permission of Outotec is prohibited.

MA'ADEN معادن
Saudi Arabian Mining Company شركة معادن العربية السعودية
This document and the information contained herein is Ma'aden proprietary know-how. This document or any part thereof should not be reproduced, stored in a retrieval system or transmitted by any means, electronic or otherwise, or divulged without prior written permission of Ma'aden.

DRAWN	APM	26/03/2020
CHECKED	BDA	27/03/2020
ENGINEER	STY	26/03/2020
APPROVED	AG	30/03/2020
EMPLOYER		
SCALE	1:100, 1:50	A1

MANSOURAH - MASSARAH GOLD PROJECT
GENERAL ARRANGEMENT DRAWING
COUNTER CURRENT DECANTATION
GRADE SLAB & PIPE RACK FOUNDATION PLAN

DRAWING NUMBER: MD - 216 - 3510 - EG - CV - GAD - 1277 — REV: D01