


DRAWING NUMBER: MD - 216 - 3510 - EG - CV - GAD - 1279
REV: D01

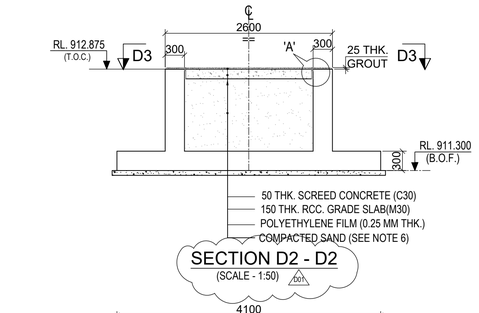


SECTION D2 - D2
(SCALE - 1:50)

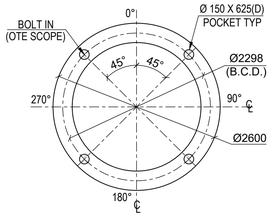

VIEW D3 - D3
(SCALE - 1:50)

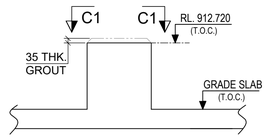


DETAIL OF PEDESTAL MKD. P1B
(SCALE 1:25)

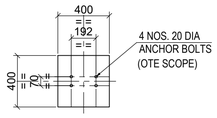


SECTION : C2 - C2
(SCALE 1:25)




SECTION : C3 - C3
(SCALE 1:25)

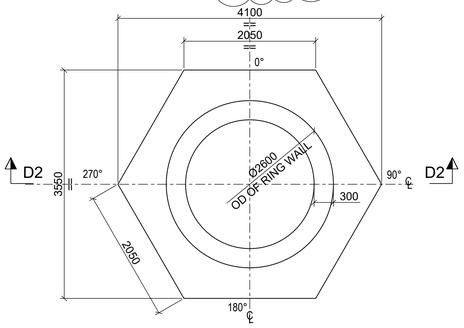


FOUNDATION PLAN OF TANK-003
(SCALE 1:50)

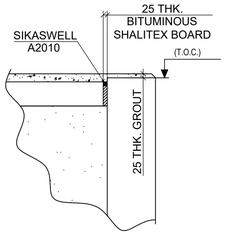


DETAIL - 'A'
(SCALE 1:20)

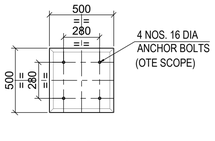


VIEW : C1 - C1
(SCALE 1:25)

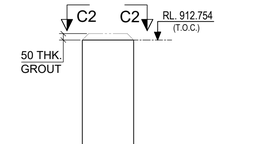


DETAIL OF PEDESTAL MKD. P1C
(SCALE 1:25)

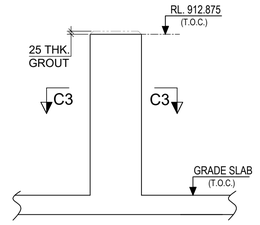


DETAIL OF PEDESTAL MKD. P1D
(SCALE 1:25)

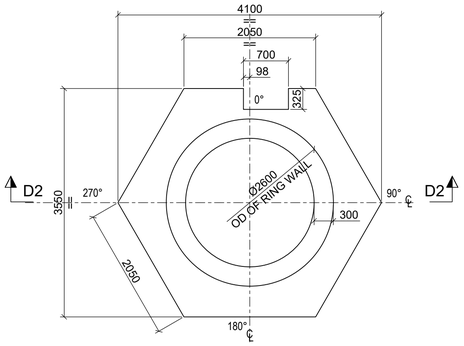


FOUNDATION PLAN OF TANK-002
(SCALE 1:50)

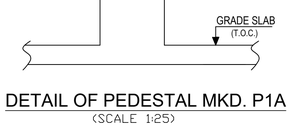


DETAIL OF PEDESTAL MKD. P1A
(SCALE 1:25)

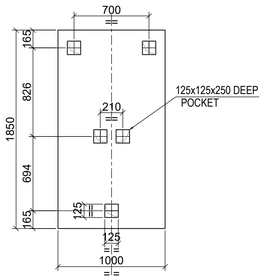


SECTION : D5 - D5
(SCALE 1:30)

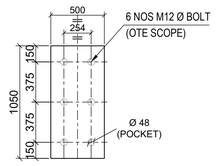

VIEW : D1 - D1
(SCALE 1:30)

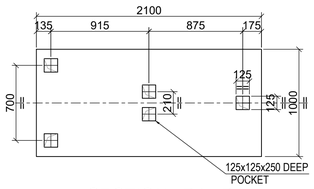


SECTION : D4 - D4
(SCALE 1:30)

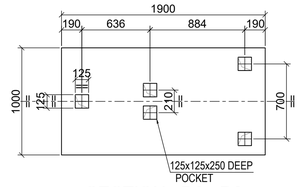


SECTION : D6 - D6
(SCALE 1:30)

LEGEND :-


R.L. - REDUCED LEVEL
T.O.C. - TOP OF CONCRETE.
B.O.F. - BOTTOM OF FOUNDATION
F.G.L. - FINISHED GROUND LEVEL
TYP. - TYPICAL.
P.C.C - PLAIN CEMENT CONCRETE
MKD. - MARKED.
THK. - THICK
℄ - CENTRE LINE
H.P. - HIGH POINT
L.P. - LOW POINT
OD - OUTER DIAMETER
BCD - BOLT CENTRE DIAMETER
Ø - DIAMETER
RCC. - REINFORCED CEMENT CONCRETE
DIA - DIAMETER
DRG. - DRAWING

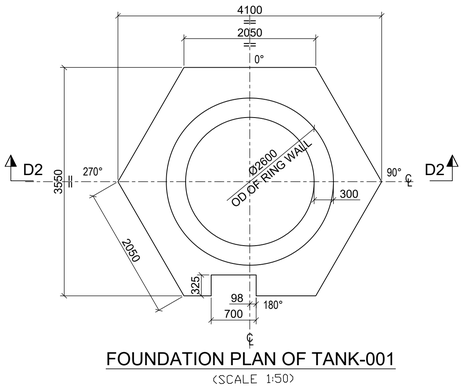


FOUNDATION PLAN OF TANK-001
(SCALE 1:50)

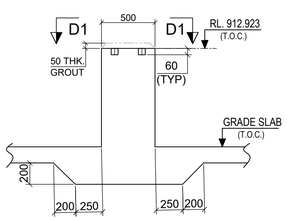


DETAIL OF PEDESTAL MKD. P3, P4, P12, P13, P21 & P22
(SCALE 1:30)

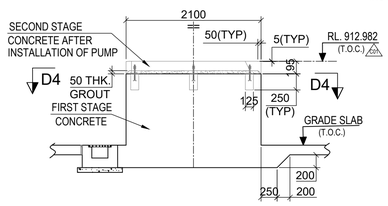

DETAIL OF PEDESTAL MKD. P6 & P7
(SCALE 1:50)

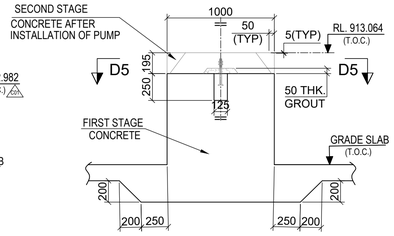

DETAIL OF PEDESTAL MKD. P17 & P18
(SCALE 1:30)

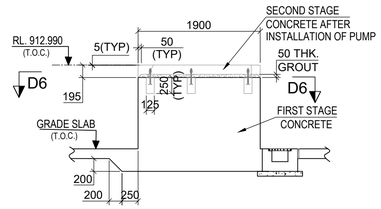

DETAIL OF PEDESTAL MKD. P24 & P25
(SCALE 1:50)

NOTES:-

1. ALL DIMENSIONS ARE IN MILLIMETRES AND LEVELS ARE IN METRES UNLESS OTHERWISE STATED.
2. GRADE OF CONCRETE SHALL BE C35 UNLESS NOTED OTHERWISE.
3. GRADE OF REINFORCEMENT SHALL BE DEFORMED BAR ASTM A615-GRADE 60 (fy=420 MPa)
4. NET SAFE BEARING CAPACITY CONSIDERED AT THE FOUNDING LEVEL IS 460 KN/SQ. M
5. IF ANY PART OF FOUNDATION COMES ON BACKFILL ZONE OF ADJACENT FOUNDATION OR ANY LOOSE POCKETS ARE ENCOUNTERED BELOW FOUNDATION LEVEL THE SAME SHALL BE REMOVED AND FILLED WITH PCC.
6. SAND SHALL BE COMPACTED TO A MAXIMUM DEPTH OF 300MM & SHALL BE COMPACTED TO 80% RELATIVE DENSITY AS DETERMINED BY ASTM D4253 & ASTM D4254
7. FOR DETAIL DRAWING REFER DRG. NO. MD - 216 - 3510 - EG - CV - DED - 1279.
8. THIS DRAWING SHOULD READ IN CONJUNCTION WITH DRG. NO : MD - 216 - 3510 - EG - CV - GAD - 1277. MD - 216 - 3510 - EG - CV - GAD - 1278. MD - 216 - 3510 - EG - CV - GAD - 1280.
9. FOR STANDARD DETAILS FOR PAVING REF. DRG. NO : MD-216-1000-EG-CV-DED-1002.

DOCUMENT NUMBER	REFERENCE DOCUMENTS	REV	DATE	REVISION DESCRIPTION	DRN	CHK	ENG	APP	EMP
		D01	18/02/2023	AS-BUILT	NAEW-SN	BDA	STY	AG	
MD-216-3510-EG-CV-GAD-1002	PLAN AT RL. 912.5 GRID D-G / 1-5	C02	14/04/2021	ISSUED FOR CONSTRUCTION AND REVISED AS MARKED	SBH	BDA	STY	AG	
MD-216-3510-EG-CV-GAD-1001	PLAN AT RL. 912.5 GRID A-D / 1-5	C01	07/11/2020	ISSUED FOR CONSTRUCTION AND REVISED AS MARKED	SBH	BDA	STY	AG	
MD-216-3510-EG-ME-GAD-1025	CCD CIRCUIT STEEL STRUCTURE LOADING DIAGRAM	A01	17/10/2020	ISSUED FOR REFERENCE	SBH	BDA	STY	AG	

RESERVED FOR VENDOR LOGO AND DRAWING NUMBER

LARSEN & TOUBRO DRAWING NUMBER: 019045_450_C_G_24116_004 — REVISION: 3
OUTOTEC DRAWING NUMBER: 900707__GAU01__ST61__MTL01__35105 — DOCUMENT ID: OU100676806 — REVISION: 3

LARSEN & TOUBRO
This drawing is the property of LARSEN & TOUBRO and must not be passed on to any person or body not authorized by us to receive it nor be copied or otherwise made use either in full or in part by such person or body without our prior permission in writing.

Outotec
The content of these documents are the sole property of Outotec Oyj. Any rights not expressly granted herein are reserved. Reproduction, transfer or distribution of part or all of the contents in any form without prior written permission of Outotec is prohibited.

MA'ADEN معادن
Saudi Arabian Mining Company شركة التعدين العربية السعودية
This document and the information contained herein is Ma'aden proprietary know-how. This document or any part thereof should not be reproduced, stored in a retrieval system or transmitted by any means, electronic or otherwise, or divulged without prior written permission of Ma'aden.

DRAWN	SBH	15/10/2020	
CHECKED	BDA	16/10/2020	
ENGINEER	STY	15/10/2020	
APPROVED	AG	17/10/2020	
EMPLOYER			
SCALE	1:100, 1:50	A1	

MANSOURAH - MASSARAH GOLD PROJECT
GENERAL ARRANGEMENT
COUNTER CURRENT DECANTATION
SECTIONS

DRAWING NUMBER: MD - 216 - 3510 - EG - CV - GAD - 1279 — REV: D01