


DRAWING NUMBER: MD - 216 - 3510 - EG - CV - GAD - 1280 | REV: D01

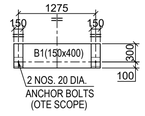


SECTION : A4 - A4
(SCALE 1:50)

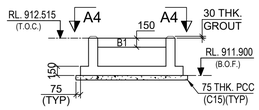


SECTION : A3 - A3
(SCALE 1:50)

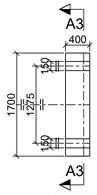


DETAIL OF FOUNDATION MKD. F1B
(SCALE 1:50)

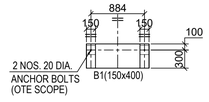


SECTION : A2 - A2
(SCALE 1:50)

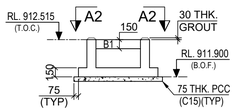


SECTION : A1 - A1
(SCALE 1:50)

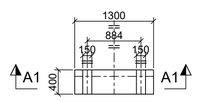


DETAIL OF FOUNDATION MKD. F1A
(SCALE 1:50)

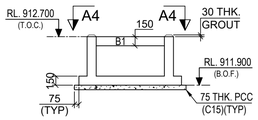


SECTION : A7 - A7
(SCALE 1:50)

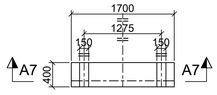


DETAIL OF FOUNDATION MKD. F1D
(SCALE 1:50)

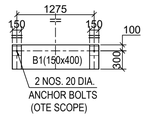


SECTION : A6 - A6
(SCALE 1:50)

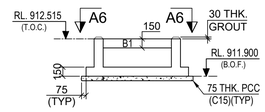


SECTION : A5 - A5
(SCALE 1:50)

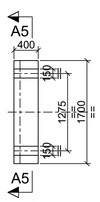


DETAIL OF FOUNDATION MKD. F1C
(SCALE 1:50)

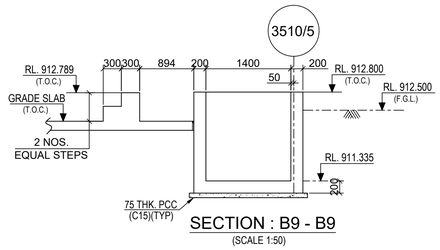


SECTION : B9 - B9
(SCALE 1:50)

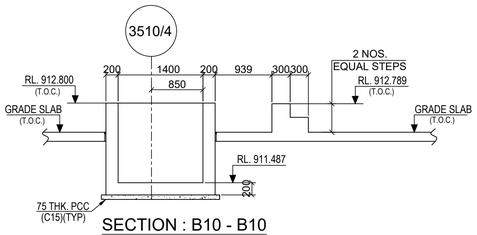


SECTION : B10 - B10
(SCALE 1:50)

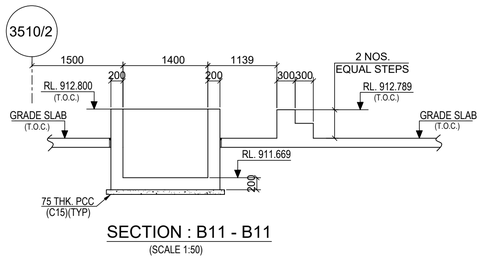


SECTION : B11 - B11
(SCALE 1:50)

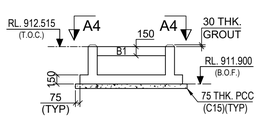


SECTION : A10 - A10
(SCALE 1:50)

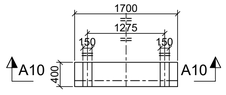


DETAIL OF FOUNDATION MKD. F1F
(SCALE 1:50)

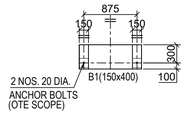


SECTION : A9 - A9
(SCALE 1:50)

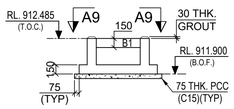


SECTION : A8 - A8
(SCALE 1:50)

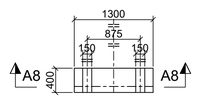


DETAIL OF FOUNDATION MKD. F1E
(SCALE 1:50)

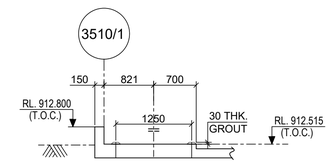


SECTION : B4 - B4
(SCALE 1:50)

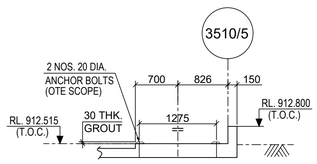


SECTION : B3 - B3
(SCALE 1:50)

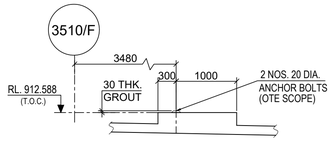


SECTION : B2 - B2
(SCALE 1:50)

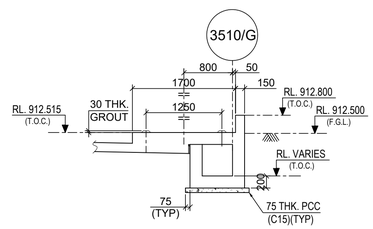


SECTION : B1 - B1
(SCALE 1:50)

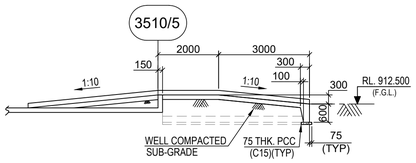


SECTION : B8 - B8
(SCALE 1:100)

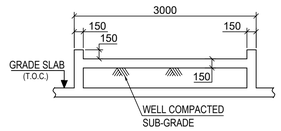

SECTION : B7 - B7
(SCALE 1:50)

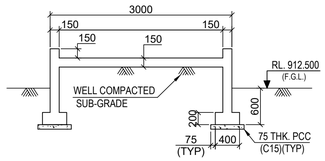

SECTION : B6 - B6
(SCALE 1:50)

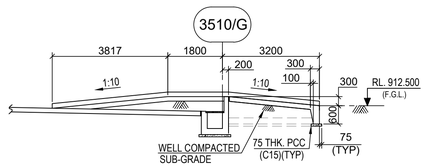

SECTION : B5 - B5
(SCALE 1:100)

LEGEND :-

R.L. - REDUCED LEVEL
T.O.C. - TOP OF CONCRETE.
B.O.F. - BOTTOM OF FOUNDATION
F.G.L. - FINISHED GROUND LEVEL
TYP - TYPICAL
P.C.C - PLAIN CEMENT CONCRETE
MKD. - MARKED.
THK. - THICK
DRG. - DRAWING
DIA - DIAMETER

NOTES:-

1. ALL DIMENSIONS ARE IN MILLIMETRES AND LEVELS ARE IN METRES UNLESS OTHERWISE STATED.
2. GRADE OF CONCRETE SHALL BE C35 UNLESS NOTED OTHERWISE.
3. GRADE OF REINFORCEMENT SHALL BE DEFORMED BAR ASTM A615-GRADE 60 (fy=420 MPa)
4. IF ANY PART OF FOUNDATION COMES ON BACKFILL ZONE OF ADJACENT FOUNDATION OR ANY LOOSE POCKETS ARE ENCOUNTERED BELOW FOUNDATION LEVEL THE SAME SHALL BE REMOVED AND FILLED WITH PCC.
5. FOR DETAIL DRAWING REFER DRG. NO. MD - 216 - 3510 - EG - CV - DED - 1279.
6. THIS DRAWING SHOULD READ IN CONJUNCTION WITH DRG. NO : MD - 216 - 3510 - EG - CV - GAD - 1277. MD - 216 - 3510 - EG - CV - GAD - 1278. MD - 216 - 3510 - EG - CV - GAD - 1279.

DOCUMENT NUMBER	REFERENCE DOCUMENTS	REV	DATE	REVISION DESCRIPTION	DRN	CHK	ENG	APP	EMP
MD-216-3510-EG-CV-GAD-1002	PLAN AT RL. 912.5 GRID D-G / 1-5	D01	22/02/2023	AS-BUILT	SBH	BDA	STY	AG	
MD-216-3510-EG-CV-GAD-1001	PLAN AT RL. 912.5 GRID A-D / 1-5	C01	07/11/2020	ISSUED FOR CONSTRUCTION	SBH	BDA	STY	AG	
MD-216-3510-EG-ME-GAD-1025	CCD CIRCUIT STEEL STRUCTURE LOADING DIAGRAM	A01	17/10/2020	ISSUED FOR REFERENCE	SBH	BDA	STY	AG	

RESERVED FOR VENDOR LOGO AND DRAWING NUMBER

LARSEN & TOUBRO

This drawing is the property of LARSEN & TOUBRO and must not be passed on to any person or body not authorized by us to receive it nor be copied or otherwise made use either in full or in part by such person or body without our prior permission in writing.

Outotec

The content of these documents are the sole property of Outotec Oyj. Any rights not expressly granted herein are reserved. Reproduction, transfer or distribution of part or all of the contents in any form without prior written permission of Outotec is prohibited.

MA'ADEN معادن
Saudi Arabian Mining Company شركة معادن السعودية

This document and the information contained herein is Ma'aden proprietary know-how. This document or any part thereof should not be reproduced, stored in a retrieval system or transmitted by any means, electronic or otherwise, or divulged without prior written permission of Ma'aden.

LARSEN & TOUBRO DRAWING NUMBER	019045_450_C_G_24116_005		REVISION 2
OUTOTEC DRAWING NUMBER	900707__GAU01__ST61__MTL01__35126	DOCUMENT ID OU100700406	REVISION 2
DRAWN	SBH	15/10/2020	MANSOURAH - MASSARAH GOLD PROJECT
CHECKED	BDA	16/10/2020	GENERAL ARRANGEMENT
ENGINEER	STY	15/10/2020	COUNTER CURRENT DECANTATION
APPROVED	AG	17/10/2020	GRADE SLAB
EMPLOYER			
SCALE	1:100, 1:50	A1	DRAWING NUMBER: MD - 216 - 3510 - EG - CV - GAD - 1280
			REV: D01