


DRAWING NUMBER MD-216-3640-EG-CV-DED-1319 REV D01

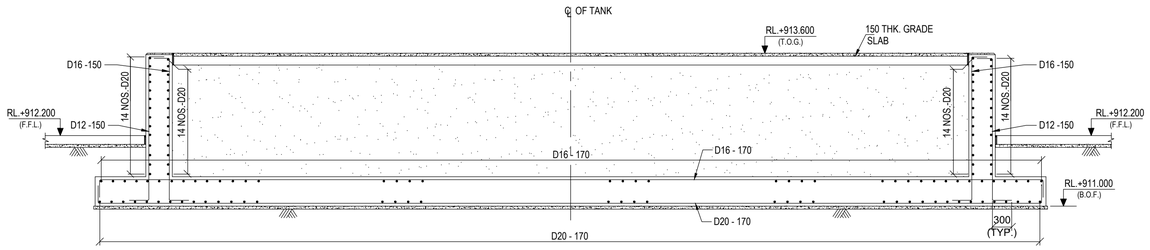


SECTION : A-A
SCALE 1:50

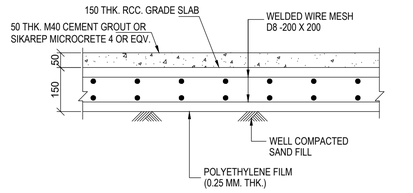


TYP. DET. OF 150 THK. GRADE SLAB
SCALE 1:10 C02

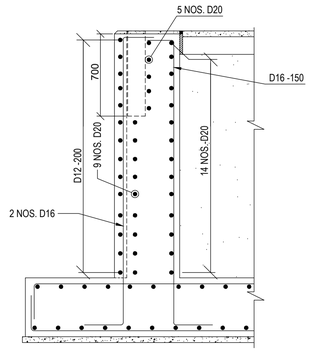


SECTION : B-B
SCALE 1:20

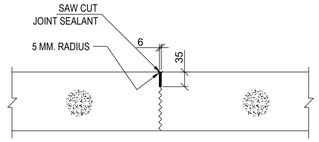


CONSTRUCTION JOINT
SCALE 1:10

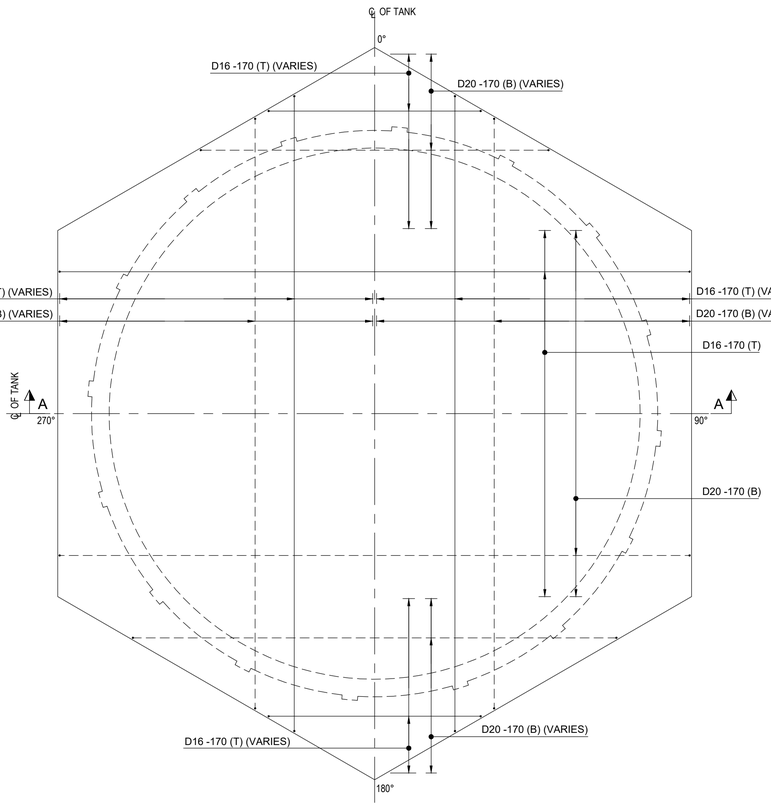


RCC. DETAIL OF TANK FOUNDATION MKD. F3
(7 NOS. REQD.)
SCALE 1:75

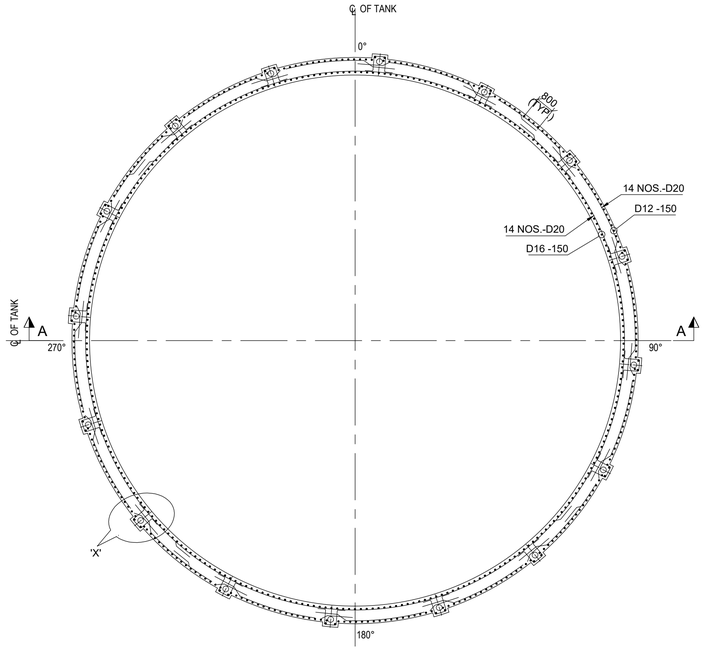

RCC. DETAIL OF WALL
SCALE 1:75

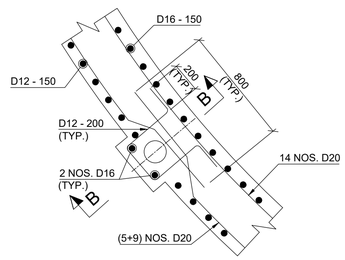

DETAIL : 'X'
SCALE 1:20

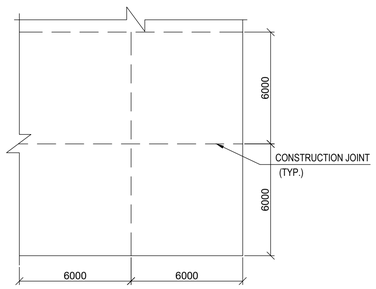

TYP. PLAN OF CONSTRUCTION JOINT
(CONCRETE GRADE SLAB AREA)
SCALE 1:50

LEGEND :-
R.L. - REDUCED LEVEL
℄ - CENTRE LINE
T.O.C. - TOP OF CONCRETE
F.G.L. - FINISHED GROUND LEVEL
B.O.F. - BOTTOM OF FOUNDATION
TYP. - TYPICAL
P.C.D. - PITCH CIRCLE DIAMETER
R.C.C - REINFORCED CEMENT CONCRETE
P.C.C - PLAIN CEMENT CONCRETE
BOTTOM REINF.(B) - - - - - - - -
TOP REINF.(T) - ————
MKD. - MARKED
THK. - THICK

NOTES:-
1. ALL DIMENSIONS ARE IN MILLIMETRES AND LEVELS AND CO-ORDINATES ARE IN METRES UNLESS OTHERWISE STATED.
2. GRADE OF CONCRETE SHALL BE C35 (35MPa) FOR FOUNDATION, C30 (30MPa) FOR GRADE SLAB & C15 (15MPa) FOR BLINDING CONCRETE.
3. GRADE OF REINFORCEMENT SHALL BE DEFORMED BAR 420 MPa (GRADE 60) - ASTM A615/A615M.
4. GRADE OF WELDED WIRE MESH SHALL BE GRADE 60 (fy = 420 MPa) ACCORDING TO A1064.
5. NET SAFE BEARING CAPACITY OF SOIL AT BOTTOM OF FOUNDATION CONSIDER 450KN/ SQ. M
6. CLEAR COVER TO REINFORCEMENT SHALL BE FOUNDATIONS = 50 MM., WALLS = 50 MM., GRADE SLAB = 25 MM.
7. IF ANY PART OF FOUNDATION COMES ON BACKFILL ZONE OF ADJACENT FOUNDATION OR ANY LOOSE SOIL ARE ENCOUNTERED BELOW FOUNDATION LEVEL THE SAME SHALL BE REMOVED AND FILLED WITH PCC.

DOCUMENT NUMBER	REFERENCE DOCUMENTS	REV	DATE	REVISION DESCRIPTION	DRN	CHK	ENG	APP	EMP
MD-216-3640-EG-CV-GAD-1312	DETAIL OF TANK FOUNDATION MKD. F1, F2 & F3								
MD-216-3640-EG-CV-GAD-1311	LAYOUT & DETAIL OF TANK FOUNDATIONS								
MD-216-1000-EG-ST-CRT-1001	CIVIL, STRUCTURAL & ARCHITECTURAL - DESIGN CRITERIA								
MD-216-3640-EG-ME-PLN-1031	LOW GRADE CONDITIONING, LEACHING & ADSORPTION PLAN AT EL.+912.200	D01	13/03/2023	AS-BUILT	ABS	SJM	AVG	AG	
MD-216-3640-EG-ME-PLN-1019	FOUNDATION AND LOAD PLAN FLOAT TAILS CONDITIONING, LEACHING &	C02	10/05/2020	ISSUED FOR CONSTRUCTION & REVISED AS MKD. C02	ABS	SJM	AVG	AG	
	ADSORPTION 3640-REA-001 TO 009 LOW GRADE CONDITIONING / CIL REACTOR	C01	04/03/2020	ISSUED FOR CONSTRUCTION & REVISED AS MKD. C01	ABS	SJM	AVG	AG	
DOCUMENT NUMBER	REFERENCE DOCUMENTS	A01	18/01/2020	ISSUED FOR REFERENCE	ABS	SJM	AVG	AG	

RESERVED FOR VENDOR LOGO AND DRAWING NUMBER

LARSEN & TOUBRO

This drawing is the property of LARSEN & TOUBRO and must not be passed on to any person or body not authorized by us to receive it nor be copied or otherwise made use either in full or in part by such person or body without our prior permission in writing.

Outotec

The content of these documents are the sole property of Outotec Oyj. Any rights not expressly granted herein are reserved. Reproduction, transfer or distribution of part or all of the contents in any form without prior written permission of Outotec is prohibited.

MA'ADEN معادن
Saudi Arabian Mining Company شركة معادن العربية السعودية

This document and the information contained herein is Ma'aden proprietary know-how. This document or any part thereof should not be reproduced, stored in a retrieval system or transmitted by any means, electronic or otherwise, or divulged without prior written permission of Ma'aden.

LARSEN & TOUBRO DRAWING NUMBER: O19045_450_C_D_24137_002 — REVISION: 3
OUTOTEC DRAWING NUMBER: 900707 _GAU01 _HL13 _CTB01 _36402 — DOCUMENT ID: OU100667143 — REVISION: 3

DRAWN	ABS	15/01/2020
CHECKED	SJM	17/01/2020
ENGINEER	AVG	16/01/2020
APPROVED	AG	18/01/2020
EMPLOYER		
SCALE	1:75, 1:50, 1:25, 1:10	A1

MANSOURAH - MASSARAH GOLD PROJECT
DETAIL DRAWING
LOW GRADE CONDITIONING,LEACHING & ADSORPTION
RCC. DETAIL OF TANK FOUNDATION MKD. F3

DRAWING NUMBER: MD-216-3640-EG-CV-DED-1319 — REV: D01