


DRAWING NUMBER MD-216-3640-EG-CV-DED-1320 REV D01

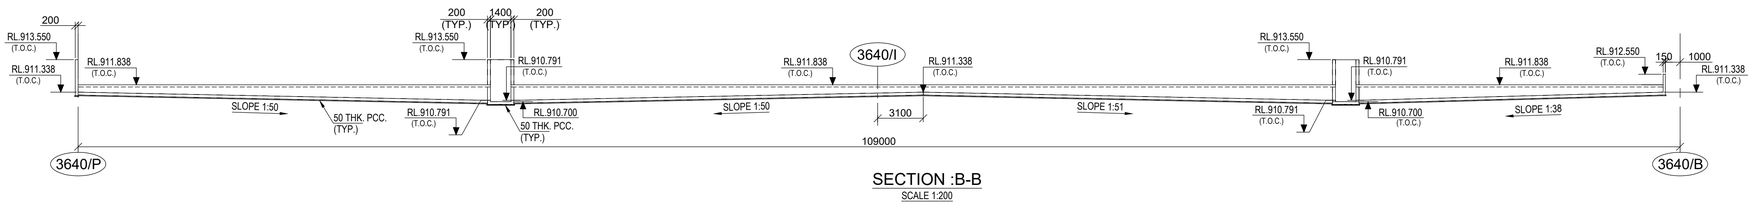


SECTION :B-B
SCALE 1:200

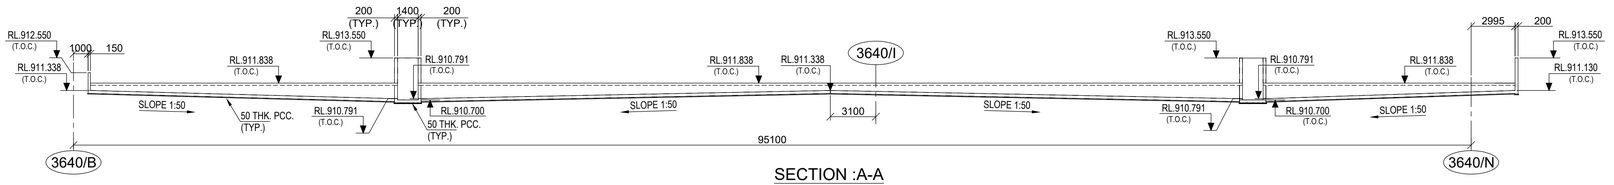


SECTION :A-A
SCALE 1:200

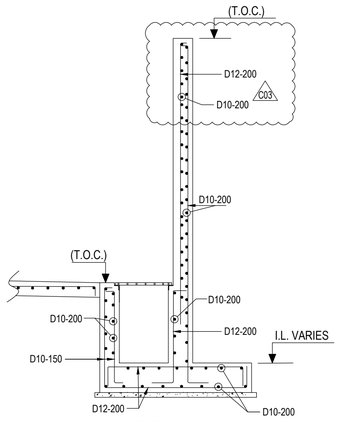


SECTION : H'-H'
(R.C DETAIL)
SCALE 1:30

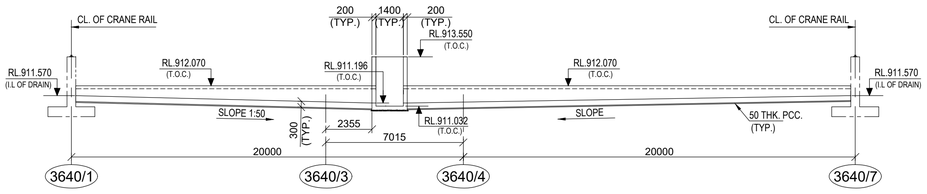


SECTION : K-K
SCALE 1:150

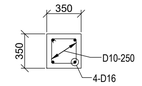


DETAIL OF P11
SCALE 1:30

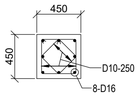


SECTION : M-M
SCALE 1:30

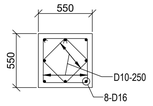


SECTION : H-H
SCALE 1:30

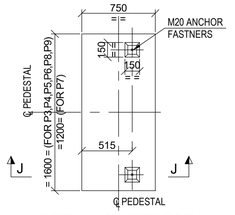


DETAIL OF PEDESTAL MKD. P3 TO P9
(PEDESTAL ORIENTATION TREATED AS PER LAYOUT PLAN)
(SCALE - 1:30)

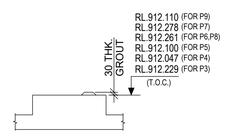


SECTION : J-J
(SCALE - 1:30)

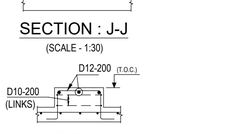


SECTION : J-J
(R.C DETAIL)
(SCALE - 1:30)

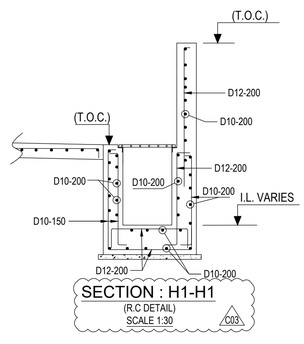


SECTION : H1-H1
(R.C DETAIL)
SCALE 1:30
C03

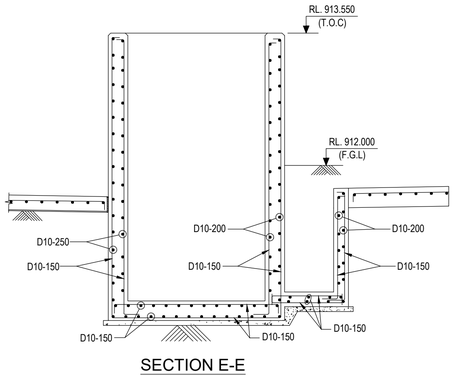


SECTION E-E
(RC. DETAIL)
SCALE 1:30

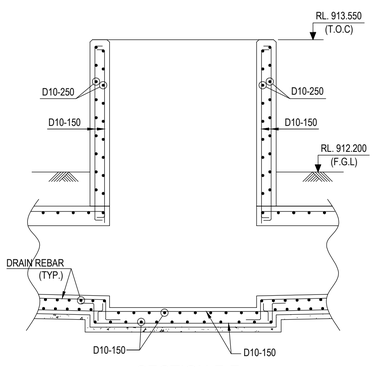


SECTION F-F
(RC. DETAIL)
SCALE 1:30

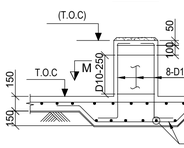


DETAIL OF P1,P2, P2A
(R.C DETAIL)
SCALE 1:30

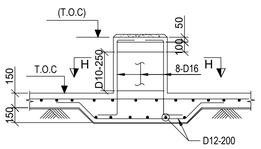


DETAIL OF P10
(R.C DETAIL)
SCALE 1:30

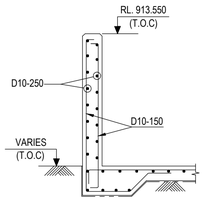

SECTION D'-D'
(R.C DETAIL)
SCALE 1:30

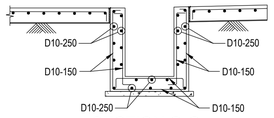

SECTION G-G
SECTION G'-G' (OPP. HAND)
(R.C DETAIL)
SCALE 1:30

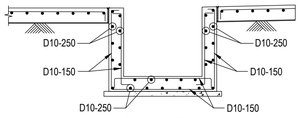

SECTION J-J
(R.C DETAIL)
SCALE 1:30

LEGEND :-
R.L. - REDUCED LEVEL
℄ - CENTRE LINE
T.O.C. - TOP OF CONCRETE
F.G.L. - FINISHED GROUND LEVEL
TYP. - TYPICAL
R.C. - REINFORCED CONCRETE
P.C.C - PLAIN CEMENT CONCRETE
MKD. - MARKED
THK. - THICK
I.L. - INVERT LEVEL

NOTES:-
1. ALL DIMENSIONS ARE IN MILLIMETRES AND LEVELS AND CO-ORDINATES ARE IN METRES UNLESS OTHERWISE STATED.
2. GRADE OF CONCRETE SHALL BE C30 (30MPa) FOR GRADE SLAB & C15 (15MPa) FOR BLINDING CONCRETE.
3. GRADE OF REINFORCEMENT SHALL BE DEFORMED BAR 420 MPa (GRADE 60) - ASTM A615/A615M.
4. CLEAR COVER TO REINFORCEMENT SHALL BE WALL - 40MM., SLAB - 25 MM., PEDESTAL - 40MM.
5. FOR STANDARD REINFORCEMENT DETAIL & GENERAL NOTES FOR CIVIL WORKS REFER DRAWING NO. MD-216-1000-EG-CV-DED-1005 & 1001.

DOCUMENT NUMBER	REFERENCE DOCUMENTS	REV	DATE	REVISION DESCRIPTION	DRN	CHK	ENG	APP	EMP
MD-216-3640-EG-CV-GAD-1315	LAYOUT & DETAIL OF GRADE SLAB								
MD-216-3640-EG-CV-GAD-1314	LAYOUT OF GRADE SLAB	D01	13/03/2023	AS-BUILT	ABS	SJM	AVG	AG	
MD-216-1000-EG-ST-CRT-1001	CIVIL, STRUCTURAL & ARCHITECTURAL - DESIGN CRITERIA	C03	13/03/2021	ISSUED FOR CONSTRUCTION & REVISED AS MKD. C03	ABS	SJM	AVG	AG	
MD-216-3640-EG-ME-PLN-1031	LOW GRADE CONDITIONING, LEACHING & ADSORPTION PLAN AT EL.+912.200	C02	24/12/2020	ISSUED FOR CONSTRUCTION & REVISED AS MKD. C02	ABS	SJM	AVG	AG	
MD-216-3640-EG-ME-PLN-1019	FOUNDATION AND LOAD PLAN FLOAT TAILS CONDITIONING, LEACHING &	C01	25/05/2020	ISSUED FOR CONSTRUCTION AND REVISED AS MKD. C01	ABS	SJM	AVG	AG	
	ADSORPTION 3640-REA-001 TO 009 LOW GRADE CONDITIONING / CIL REACTOR	A01	18/04/2020	ISSUED FOR REFERENCE	ABS	SJM	AVG	AG	

RESERVED FOR VENDOR LOGO AND DRAWING NUMBER

LARSEN & TOUBRO

This drawing is the property of LARSEN & TOUBRO and must not be passed on to any person or body not authorized by us to receive it nor be copied or otherwise made use either in full or in part by such person or body without our prior permission in writing.

Outotec

The content of these documents are the sole property of Outotec Oyj. Any rights not expressly granted herein are reserved. Reproduction, transfer or distribution of part or all of the contents in any form without prior written permission of Outotec is prohibited.

MA'ADEN معادن Saudi Arabian Mining Company شركة المعادن العربية السعودية

This document and the information contained herein is Ma'aden proprietary know-how. This document or any part thereof should not be reproduced, stored in a retrieval system or transmitted by any means, electronic or otherwise, or divulged without prior written permission of Ma'aden.

LARSEN & TOUBRO DRAWING NUMBER: O19045_450_C_D_24137_003 — REVISION: 4

OUTOTEC DRAWING NUMBER: 900707__GAU01__HL13__CTB01__36403 — DOCUMENT ID: OU100667144 — REVISION: 4

DRAWN	ABS	18/03/2020
CHECKED	SJM	16/04/2020
ENGINEER	AVG	18/03/2020
APPROVED	AG	18/04/2020
EMPLOYER		
SCALE	1:200, 1:50, 1:25, 1:10	A1

MANSOURAH - MASSARAH GOLD PROJECT
DETAIL DRAWING
LOW GRADE CONDITIONING,LEACHING & ADSORPTION
RC. DETAILS OF GRADE SLAB

DRAWING NUMBER: MD-216-3640-EG-CV-DED-1320 — REV: D01