




RCC. DET. OF FOUNDATION
MKD. F1
SCALE 1:50

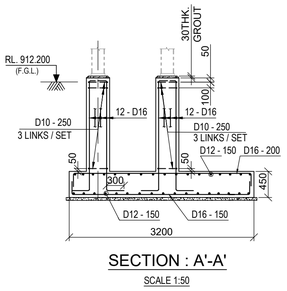


SECTION : A'-A'
SCALE 1:50

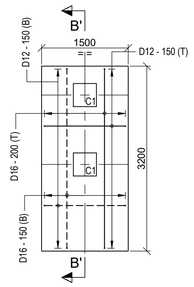


DET. OF FOUNDATION
MKD. F2
SCALE 1:50

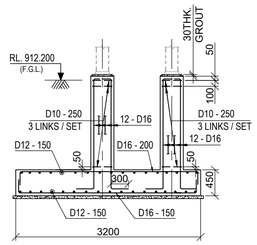


SECTION : B'-B'
SCALE 1:50

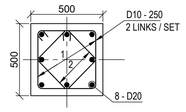


RCC. DET. OF C2
SCALE 1:20

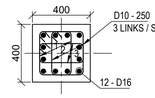


RCC. DET. OF C1
SCALE 1:20

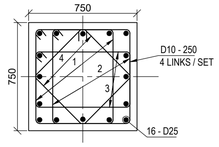


RCC. DET. OF C3
SCALE 1:20

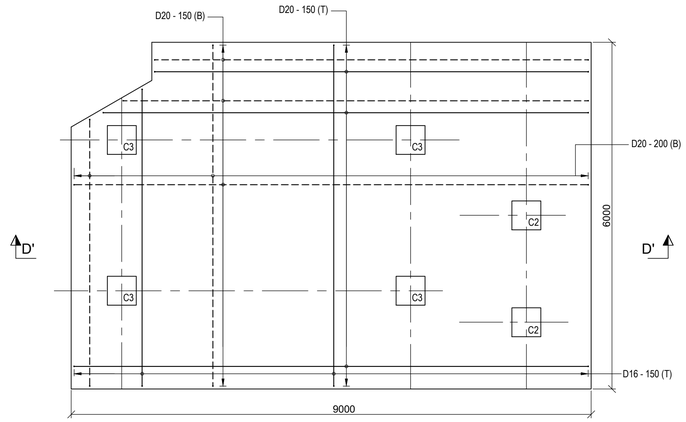


DET. OF FOUNDATION
MKD. F4
SCALE 1:50

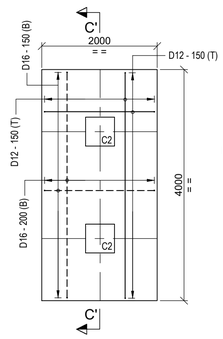


DET. OF FOUNDATION
MKD. F3
SCALE 1:50

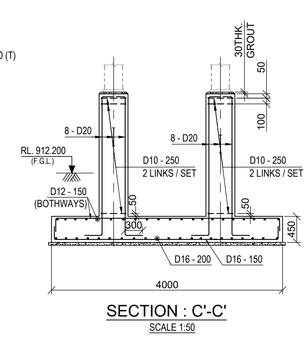


SECTION : C'-C'
SCALE 1:50

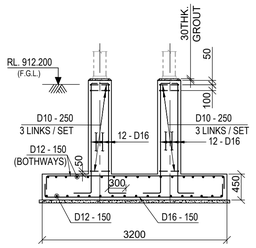

SECTION : E'-E'
SCALE 1:50

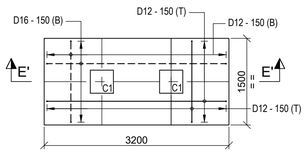

DET. OF FOUNDATION
MKD. F5
SCALE 1:50

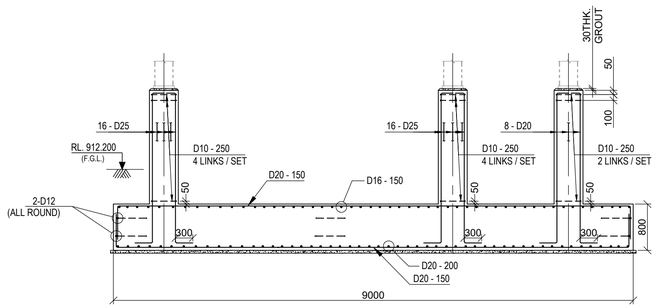

SECTION : D'-D'
SCALE 1:50

LEGEND :-

R.L - REDUCED LEVEL
℄ - CENTRE LINE
T.O.C. - TOP OF CONCRETE
T.O.G. - TOP OF GROUT
TYP. - TYPICAL
F.G.L. - FINISHED GROUND LEVEL
F.F.L. - FINISHED FLOOR LEVEL
B.O.F. - BOTTOM OF FOUNDATION
MKD. - MARKED
P.C.C - PLAIN CEMENT CONCRETE
BOTTOM REINFORCEMENT (B) - - - - - - -
TOP REINFORCEMENT (T) - ———
R.C. - REINFORCE CONCRETE
THK. - THICK
DET. - DETAIL
R.C.C. - REINFORCE CEMENT CONCRETE

NOTES:-

1. ALL DIMENSIONS ARE IN MILLIMETRES AND LEVELS AND CO-ORDINATES ARE IN METRES UNLESS OTHERWISE STATED.
2. NET SAFE BEARING CAPACITY OF SOIL AT BOTTOM OF FOUNDATION CONSIDERED AS 450KN/ SQ. M
3. GRADE OF CONCRETE SHALL BE C35 (35MPa) FOR FOUNDATION & C15 (15MPa) FOR BLINDING CONCRETE.
4. GRADE OF REINFORCEMENT SHALL BE DEFORMED BAR 420 MPa (GRADE 60) - ASTM A615/A615M.
5. IF ANY PART OF FOUNDATION COMES ON BACKFILL ZONE OF ADJACENT FOUNDATION OR ANY LOOSE SOIL ARE ENCOUNTERED BELOW FOUNDATION LEVEL THE SAME SHALL BE REMOVED AND FILLED WITH PCC.
6. FOR DETAIL OF ANCHOR BOLTS, REFER DRAWING NO. MD-216-1000-EG-CV-DED-1003.
7. FOR DETAILS OF FOUNDATION REFER DRAWING NO. MD-216-3640-EG-CV-GAD-1316, MD-216-3640-EG-CV-DED-1317.

DOCUMENT NUMBER	REFERENCE DOCUMENTS	REV	DATE	REVISION DESCRIPTION	DRN	CHK	ENG	APP	EMP
MD-216-3640-EG-CV-GAD-1313	LAYOUT & DETAIL OF MISCELLANEOUS FOUNDATION								
MD-216-3640-EG-CV-GAD-1311	LAYOUT & DETAIL OF TANK FOUNDATIONS								
MD-216-3640-EG-CV-GAD-1314	LAYOUT OF GRADE SLAB	D01	13/03/2023	AS-BUILT	ABS	SJM	AVG	AG	
MD-216-3640-EG-ME-GAD-1038	LOW GRADE CONDITIONING, LEACHING PLAN AT EL.+912.200	C01	26/11/2020	ISSUED FOR CONSTRUCTION	ABS	SJM	AVG	AG	
MD-216-1000-EG-ST-CRT-1001	CIVIL, STRUCTURAL & ARCHITECTURAL - DESIGN CRITERIA	A01	22/10/2020	ISSUED FOR REFERENCE	RM	SJM	AVG	AG	

RESERVED FOR VENDOR LOGO AND DRAWING NUMBER

LARSEN & TOUBRO

This drawing is the property of LARSEN & TOUBRO and must not be passed on to any person or body not authorized by us to receive it nor be copied or otherwise made use either in full or in part by such person or body without our prior permission in writing.

Outotec

The content of these documents are the sole property of Outotec Oyj. Any rights not expressly granted herein are reserved. Reproduction, transfer or distribution of part or all of the contents in any form without prior written permission of Outotec is prohibited.

MA'ADEN معادن
Saudi Arabian Mining Company شركة معادن العربية السعودية

This document and the information contained herein is Ma'aden proprietary know-how. This document or any part thereof should not be reproduced, stored in a retrieval system or transmitted by any means, electronic or otherwise, or divulged without prior written permission of Ma'aden.

LARSEN & TOUBRO DRAWING NUMBER: 019045_450_C_D_24383_001 — REVISION: 2
OUTOTEC DRAWING NUMBER: 900707 _GAU01 _HL13 _CTB17 _36402 — DOCUMENT ID: OU100695970 — REVISION: 2

DRAWN	RM	17/10/2020
CHECKED	SJM	18/10/2020
ENGINEER	AVG	17/10/2020
APPROVED	AG	22/10/2020
EMPLOYER		
SCALE	1:20, 1:50	A1

MANSOURAH - MASSARAH GOLD PROJECT
GENERAL ARRANGEMENT DRAWING
LOW GRADE CONDITIONING,LEACHING & ADSORPTION
RC. DETAILS OF MISCELLANEOUS FOUNDATION

DRAWING NUMBER: MD-216-3640-EG-CV-DED-1322 — REV: D01