


DRAWING NUMBER MD-216-3640-EG-CV-DED-1323 REV D01

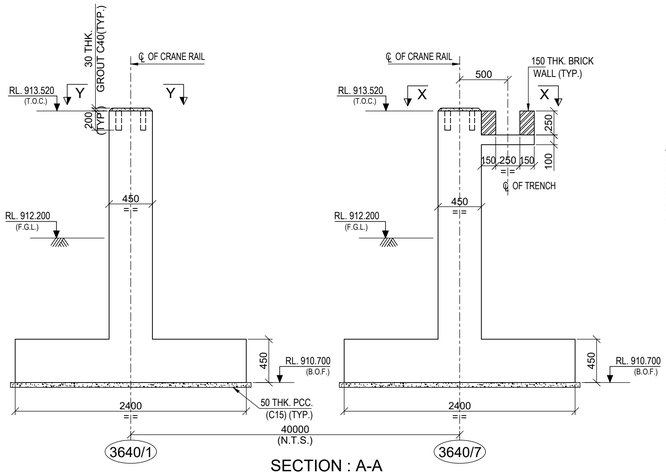


SECTION : A-A
SCALE 1:30

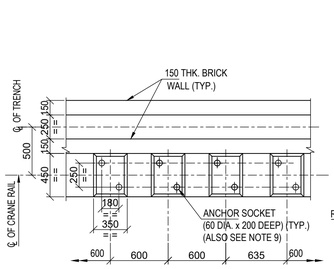


VIEW : X-X
SCALE 1:30

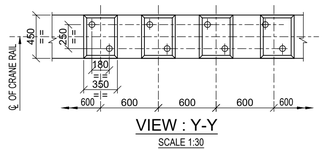


VIEW : Y-Y
SCALE 1:30

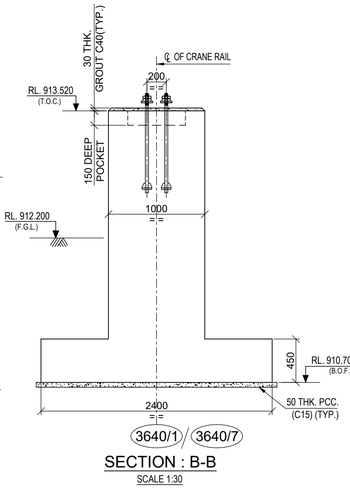


SECTION : B-B
SCALE 1:30

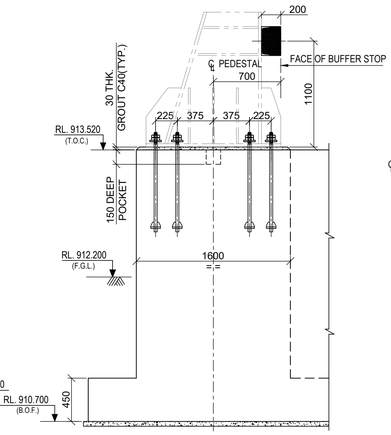


SECTION : B1-B1
SCALE 1:30

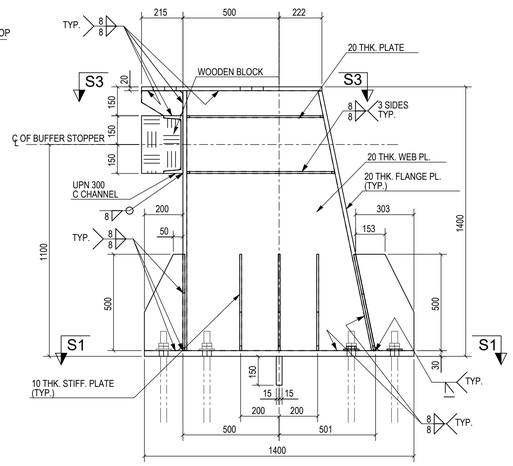


TYP. DETAIL OF BUFFER STOP
SCALE 1:15

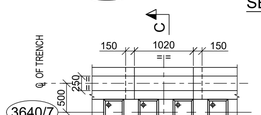


DETAIL - 'C'
SCALE 1:50

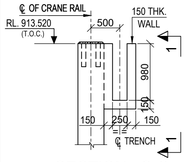


SECTION : C-C
SCALE 1:50

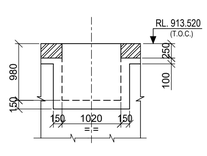


VIEW : 1-1
SCALE 1:50

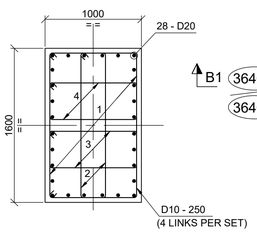


VIEW : Z-Z
SCALE 1:30

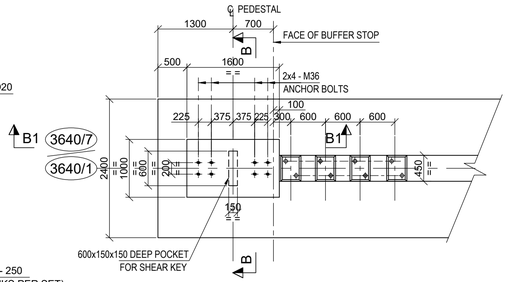


DETAIL - 'A'
DETAIL - 'B' (SIMILAR BUT OPPOSITE HAND)
SCALE 1:50

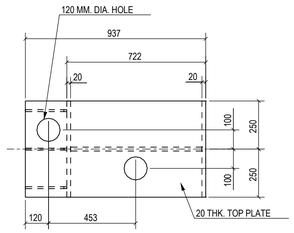

SECTION : S3-S3
SCALE 1:15

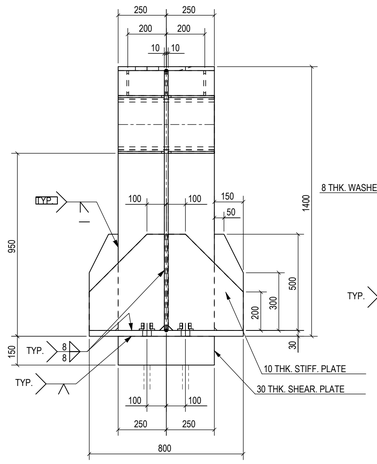


SECTION : S2-S2
SCALE 1:15

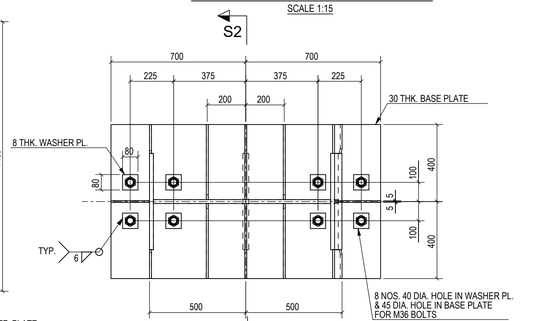


SECTION : S1-S1
SCALE 1:15

LEGEND :-


R.L. - REDUCED LEVEL
℄ - CENTRE LINE
T.O.C. - TOP OF CONCRETE
T.O.G. - TOP OF GROUT
TYP. - TYPICAL
F.G.L. - FINISHED GROUND LEVEL
B.O.F. - BOTTOM OF FOUNDATION
MKD. - MARKED
P.C.C - PLAIN CEMENT CONCRETE
N.T.S. - NOT TO SCALE
EXP. JT. - EXPANSION JOINT
THK. - THIKNESS
M.S. - MILD STEEL

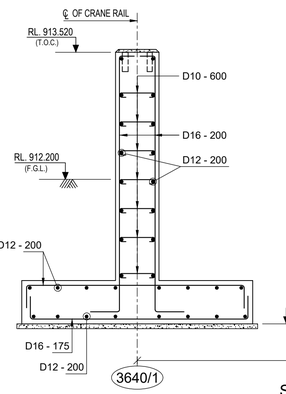


SECTION : A-A
(RC. DETAIL)
SCALE 1:30

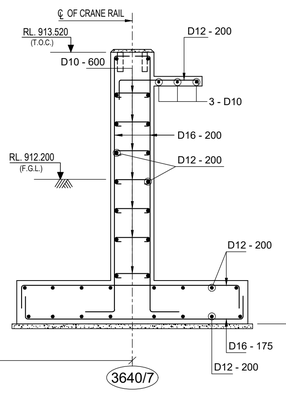


SECTION : B-B
(RC. DETAIL)
SCALE 1:30

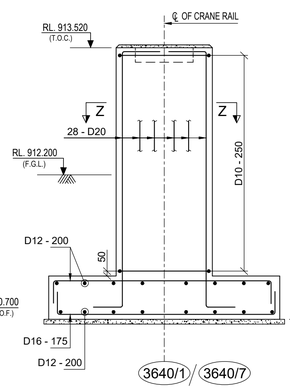


SECTION : C-C
(RC. DETAIL)
SCALE 1:50

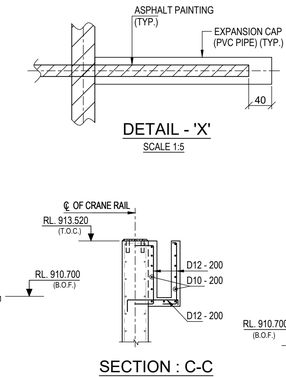

DETAIL - 'X'
SCALE 1:5

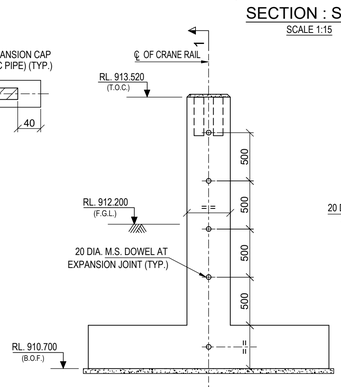

DETAIL OF EXPANSION JOINT
SCALE 1:30

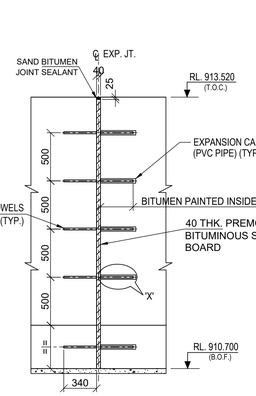

SECTION : 1-1
SCALE 1:30

NOTES:-

1. ALL DIMENSIONS ARE IN MILLIMETRES AND LEVELS AND CO-ORDINATES ARE IN METRES UNLESS OTHERWISE STATED.
2. NET SAFE BEARING CAPACITY OF SOIL AT BOTTOM OF FOUNDATION CONSIDERED AS 450KN/ SQ. M
3. GRADE OF CONCRETE SHALL BE C35 (35MPa) FOR FOUNDATION & C15 (15MPa) FOR BLINDING CONCRETE.
4. GRADE OF REINFORCEMENT SHALL BE DEFORMED BAR 420 MPa (GRADE 60) - ASTM A615/A615M.
5. IF ANY PART OF FOUNDATION COMES ON BACKFILL ZONE OF ADJACENT FOUNDATION OR ANY LOOSE SOIL ARE ENCOUNTERED BELOW FOUNDATION LEVEL THE SAME SHALL BE REMOVED AND FILLED WITH PCC.
6. CLEAR COVER TO REINFORCEMENT SHALL BE FOUNDATIONS = 50 MM., COLUMNS = 50 MM., WALL = 40 MM., SLAB = 20 MM.
7. FOR DETAIL OF ANCHOR BOLTS, REFER DRAWING NO. MD-216-1000-EG-CV-DED-1003.
8. THIS DRAWING SHOULD BE READ IN CONJUNCTION WITH DRG. NO. MD-216-3640-EG-CV-GAD-1319.
9. BOLT FIXING IN ANCHOR SOCKET SHALL BE DONE WITH EPOXY GROUT (GANTREX S3) OR EQUIVALENT.
10. FOR STRUCTURAL GENERAL NOTES REFER DRAWING NO. MD-216-1000-EG-ST-DED-1001.

DOCUMENT NUMBER	REFERENCE DOCUMENTS	REV	DATE	REVISION DESCRIPTION	DRN	CHK	ENG	APP	EMP
		D01	13/03/2023	AS-BUILT					
		C03	17/07/2021	ISSUED FOR CONSTRUCTION & REVISED AS MKD. C03	PML	SJM	AVG	AG	
		C02	04/12/2020	ISSUED FOR CONSTRUCTION & REVISED AS MKD. C02	MNS	SJM	AVG	AG	
MD-216-1000-EG-ST-CRT-1001	CIVIL, STRUCTURAL & ARCHITECTURAL - DESIGN CRITERIA	C01	13/10/2020	ISSUED FOR CONSTRUCTION & REVISED AS MKD. C01	ABS	SJM	AVG	AG	
MD-216-3640-EG-CV-GAD-1319	LAYOUT OF CRANE RAIL FOUNDATION	A01	14/09/2020	ISSUED FOR REFERENCE	ABS	SJM	AVG	AG	

RESERVED FOR VENDOR LOGO AND DRAWING NUMBER

LARSEN & TOUBRO

This drawing is the property of LARSEN & TOUBRO and must not be passed on to any person or body not authorized by us to receive it nor be copied or otherwise made use either in full or in part by such person or body without our prior permission in writing.

Outotec

The content of these documents are the sole property of Outotec Oyj. Any rights not expressly granted herein are reserved. Reproduction, transfer or distribution of part or all of the contents in any form without prior written permission of Outotec is prohibited.

MA'ADEN معادن
Saudi Arabian Mining Company شركة معادن العربية السعودية

This document and the information contained herein is Ma'aden proprietary know-how. This document or any part thereof should not be reproduced, stored in a retrieval system or transmitted by any means, electronic or otherwise, or divulged without prior written permission of Ma'aden.

DRAWN	ABS	27/08/2020	
CHECKED	SJM	31/08/2020	
ENGINEER	AVG	28/08/2020	
APPROVED	AG	14/09/2020	
EMPLOYER			
SCALE	1:5, 1:30, 1:50	A1	

LARSEN & TOUBRO DRAWING NUMBER: O19045_450_C_D_24386_001 — REVISION: 4
OUTOTEC DRAWING NUMBER: 900707 __GAU01 __HL13 __CTB17 __36403 — DOCUMENT ID: OU100695971 — REVISION: 4

MANSOURAH - MASSARAH GOLD PROJECT
DETAIL DRAWING
LOW GRADE CONDITIONING,LEACHING & ADSORPTION
DETAILS OF CRANE RAIL FOUNDATION

DRAWING NUMBER: MD-216-3640-EG-CV-DED-1323 — REV: D01