


DRAWING NUMBER MD-216-3640-EG-CV-GAD-1311 REV D01

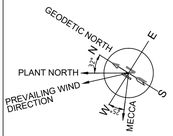

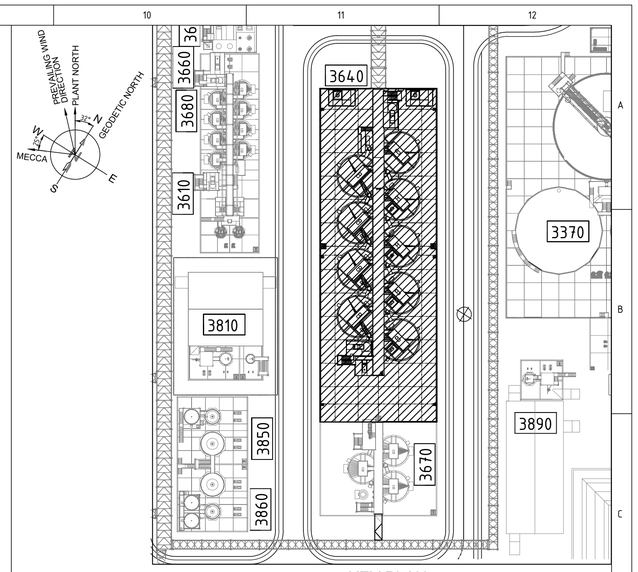

KEY PLAN
SCALE 1:1000

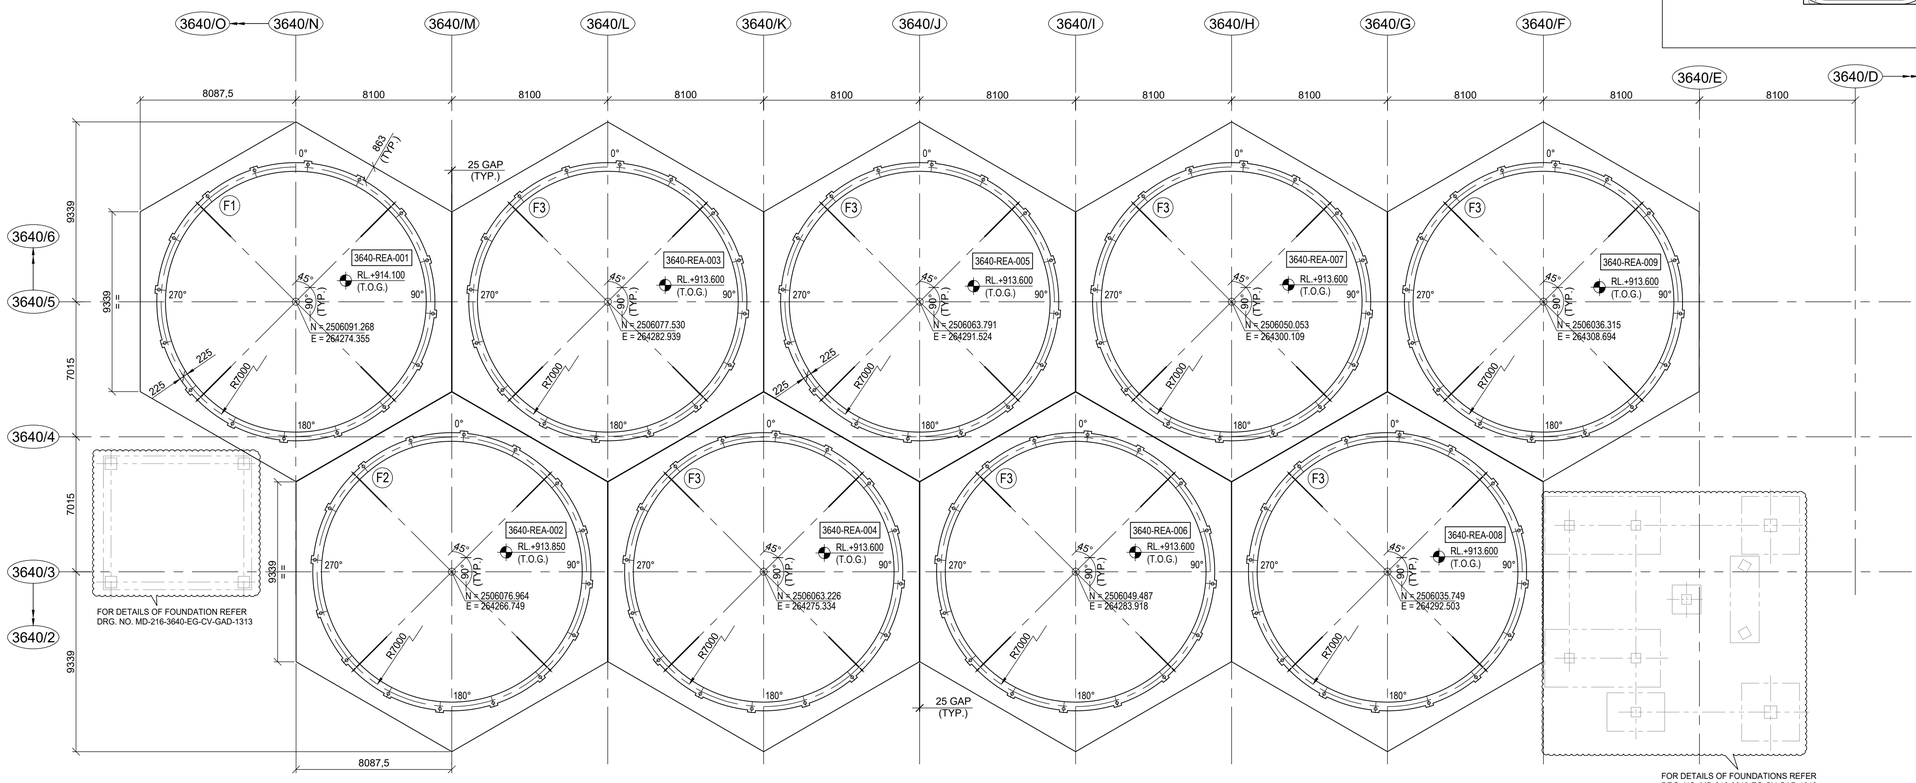

LAYOUT OF FOUNDATION
SCALE 1:150

LEGEND :-
R.L. - REDUCED LEVEL
℄ - CENTRE LINE
T.O.G. - TOP OF GROUT
TYP. - TYPICAL
R - RADIUS

NOTES:-
1. ALL DIMENSIONS ARE IN MILLIMETRES AND LEVELS AND CO-ORDINATES ARE IN METRES UNLESS OTHERWISE STATED.
2. NET SAFE BEARING CAPACITY OF SOIL AT BOTTOM OF FOUNDATION CONSIDER 450KN/ SQ. M
3. IF ANY PART OF FOUNDATION COMES ON BACKFILL ZONE OF ADJACENT FOUNDATION OR ANY LOOSE SOIL ARE ENCOUNTERED BELOW FOUNDATION LEVEL THE SAME SHALL BE REMOVED AND FILLED WITH PCC.
4. FOUNDATION & SUPPORT TOLERANCES
   a) THE FIRST 300MM WIDTH OF AN ANNULAR RING MEASURED FROM THE OUTSIDE OF THE TANK RADIALLY TOWARDS THE CENTRE SHALL BE WITHIN +/-3MM OF THE DESIGN LEVEL.
   b) THE REMAINDER OF THE FOUNDATION SHALL BE WITHIN +/-6MM OF THE DESIGN LEVEL.

DOCUMENT NUMBER	REFERENCE DOCUMENTS	REV	DATE	REVISION DESCRIPTION	DRN	CHK	ENG	APP	EMP
MD-216-3640-EG-CV-GAD-1312	DETAIL OF TANK FOUNDATION MKD. F1, F2 & F3								
MD-216-3640-EG-CV-DED-1319	RCC. DETAIL OF TANK FOUNDATION MKD. F3								
MD-216-3640-EG-CV-DED-1318	RCC. DETAIL OF TANK FOUNDATION MKD. F1 & F2								
MD-216-1000-EG-ST-CRT-1001	CIVIL, STRUCTURAL & ARCHITECTURAL - DESIGN CRITERIA								
MD-216-3640-EG-ME-PLN-1031	LOW GRADE CONDITIONING, LEACHING & ADSORPTION PLAN AT EL.+912.200	D01	13/03/2023	AS-BUILT	ABS	SJM	AVG	AG	
MD-216-3640-EG-ME-PLN-1019	FOUNDATION AND LOAD PLAN FLOAT TAILS CONDITIONING, LEACHING &	C02	10/05/2020	ISSUED FOR CONSTRUCTION & REVISED AS MKD. C02	ABS	SJM	AVG	AG	
	ADSORPTION 3640-REA-001 TO 009 LOW GRADE CONDITIONING / CIL REACTOR	C01	04/03/2020	ISSUED FOR CONSTRUCTION & REVISED AS MKD. C01	ABS	SJM	AVG	AG	
DOCUMENT NUMBER	REFERENCE DOCUMENTS	A01	17/01/2020	ISSUED FOR REFERENCE	ABS	SJM	AVG	AG	

RESERVED FOR VENDOR LOGO AND DRAWING NUMBER

LARSEN & TOUBRO
This drawing is the property of LARSEN & TOUBRO and must not be passed on to any person or body not authorized by us to receive it nor be copied or otherwise made use either in full or in part by such person or body without our prior permission in writing.

Outotec
The content of these documents are the sole property of Outotec Oyj. Any rights not expressly granted herein are reserved. Reproduction, transfer or distribution of part or all of the contents in any form without prior written permission of Outotec is prohibited.

MA'ADEN معادن
Saudi Arabian Mining Company شركة معادن العربية السعودية
This document and the information contained herein is Ma'aden proprietary know-how. This document or any part thereof should not be reproduced, stored in a retrieval system or transmitted by any means, electronic or otherwise, or divulged without prior written permission of Ma'aden.

LARSEN & TOUBRO DRAWING NUMBER	O19045_450_C_G_24136_001	REVISION 3
OUTOTEC DRAWING NUMBER	900707 _GAU01 _HL13 _MTL01 _36407	DOCUMENT ID OU100667099 / REVISION 3

DRAWN	ABS	05/12/2019
CHECKED	SJM	16/01/2020
ENGINEER	AVG	15/01/2020
APPROVED	AG	17/01/2020
EMPLOYER		
SCALE	1:150	A1

MANSOURAH - MASSARAH GOLD PROJECT
GENERAL ARRANGEMENT DRAWING
LOW GRADE CONDITIONING,LEACHING & ADSORPTION LAYOUT & DETAIL OF TANK FOUNDATIONS

DRAWING NUMBER MD-216-3640-EG-CV-GAD-1311 REV D01