


DRAWING NUMBER MD-216-3640-EG-CV-GAD-1312 REV D01

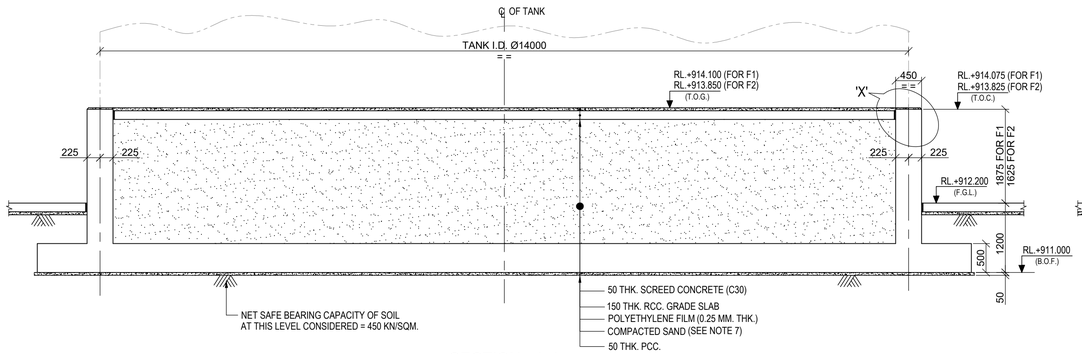


SECTION : A-A
SCALE 1:50

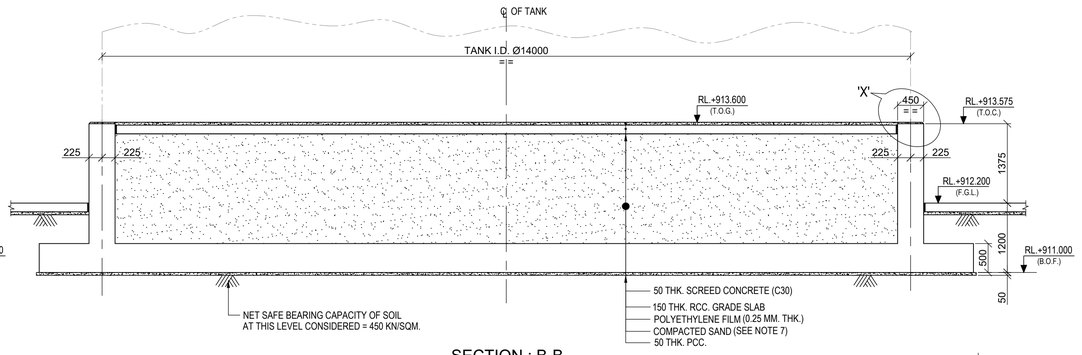


SECTION : B-B
SCALE 1:50

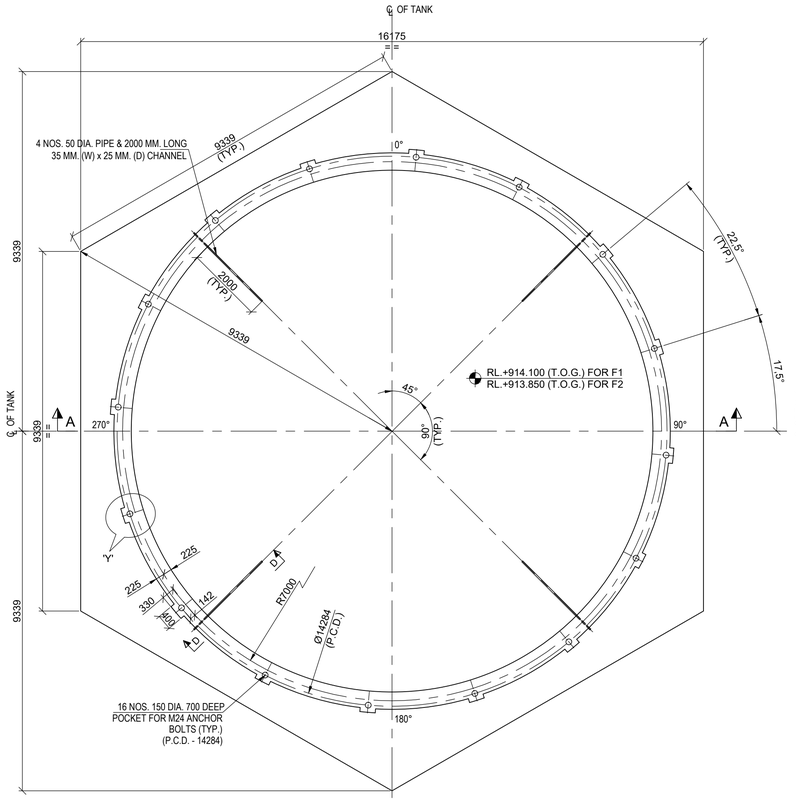


DETAIL OF TANK FOUNDATION MKD. F1 & F2
(1 NO. REQUIRED EACH)
SCALE 1:75

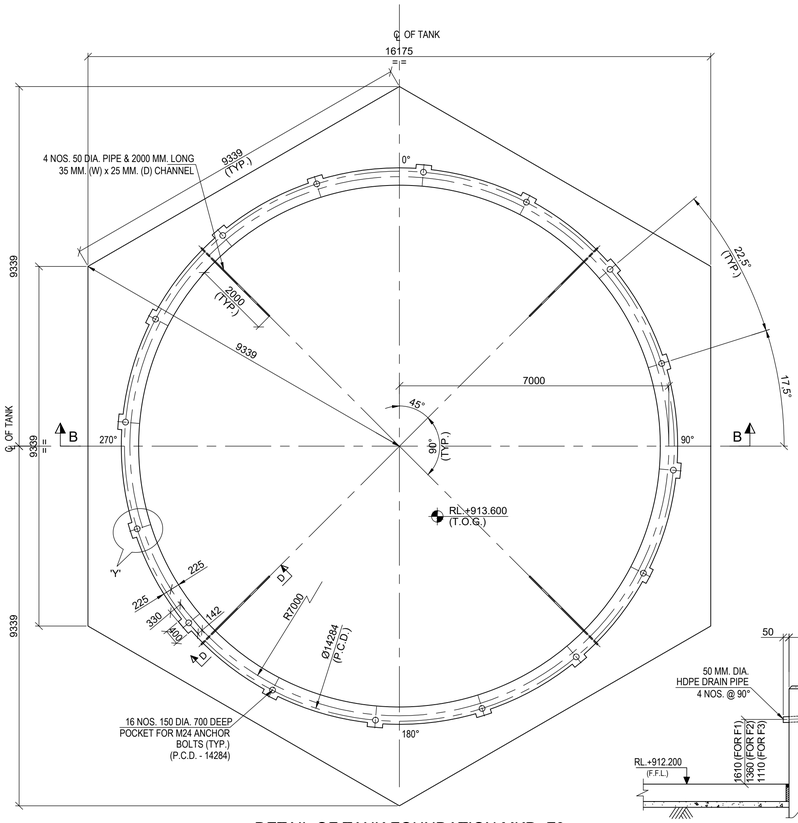


DETAIL OF TANK FOUNDATION MKD. F3
(7 NOS. REQUIRED)
SCALE 1:75

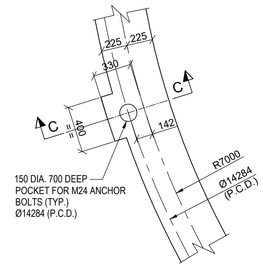

DETAIL : 'Y'
SCALE 1:25

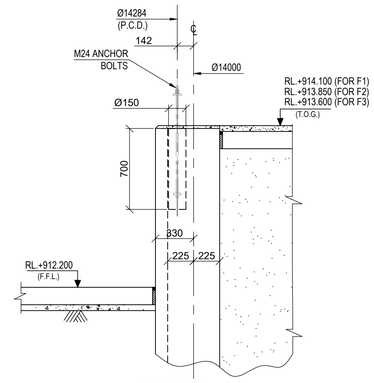


SECTION : C-C
SCALE 1:25

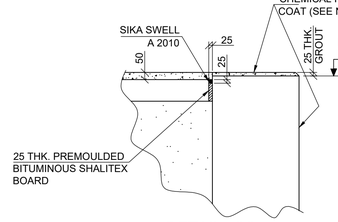

DETAIL - 'X'
SCALE 1:20

LEGEND :-
R.L. - REDUCED LEVEL
℄ - CENTRE LINE
T.O.C. - TOP OF CONCRETE
F.G.L. - FINISHED GROUND LEVEL
F.F.L. - FINISHED FLOOR LEVEL
B.O.F. - BOTTOM OF FOUNDATION
TYP. - TYPICAL
P.C.D. - PITCH CIRCLE DIAMETER
R.C.C - REINFORCED CEMENT CONCRETE
P.C.C - PLAIN CEMENT CONCRETE
MKD. - MARKED
I.D. - INTERNAL DIAMETER
Ø - DIAMETER
R - RADIUS
THK. - THICK
EQV. - EQUIVALENT
DIA. - DIAMETER

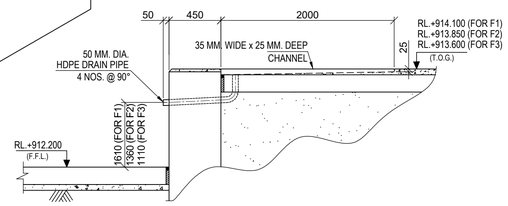

SECTION : D-D
SCALE 1:25

NOTES:-
1. ALL DIMENSIONS ARE IN MILLIMETRES AND LEVELS AND CO-ORDINATES ARE IN METRES UNLESS OTHERWISE STATED.
2. GRADE OF CONCRETE SHALL BE C35 (35MPa) FOR FOUNDATION, C30 C30 (30MPa) FOR GRADE SLAB & C15 (15MPa) FOR BLINDING CONCRETE.
3. GRADE OF REINFORCEMENT SHALL BE DEFORMED BAR 420 MPa (GRADE 60) - ASTM A615/A615M.
4. GRADE OF WELDED WIRE MESH SHALL BE GRADE 60 (fy = 420 MPa) ACCORDING TO A1064.
5. NET SAFE BEARING CAPACITY OF SOIL AT BOTTOM OF FOUNDATION CONSIDER 450KN/ SQ. M
6. IF ANY PART OF FOUNDATION COMES ON BACKFILL ZONE OF ADJACENT FOUNDATION OR ANY LOOSE SOIL ARE ENCOUNTERED BELOW FOUNDATION LEVEL THE SAME SHALL BE REMOVED AND FILLED WITH PCC.
7. SAND SHALL BE COMPACTED TO A MAXIMUM DEPTH OF 300MM AND SHALL BE COMPACTED TO 80% RELATIVE DENSITY AS DETERMINED BY ASTM D4253 AND ASTM D4254.
8. ACID/ALKALI RESISTANT COATING TO BE APPLIED ON ALL EXPOSED CONCRETE SURFACE.
9. FOUNDATION & SUPPORT TOLERANCES
   a) THE FIRST 300MM WIDTH OF AN ANNULAR RING MEASURED FROM THE OUTSIDE OF THE TANK RADIALLY TOWARDS THE CENTRE SHALL BE WITHIN +/-3MM OF THE DESIGN LEVEL.
   b) THE REMAINDER OF THE FOUNDATION SHALL BE WITHIN +/-6MM OF THE DESIGN LEVEL.
10. CHEMICAL RESISTANT COATING SHALL BE APPLIED FOR PROTECTING CONCRETE AGAINST CYANIDE, ACID AND ALKALI.

DOCUMENT NUMBER	REFERENCE DOCUMENTS	REV	DATE	REVISION DESCRIPTION	DRN	CHK	ENG	APP	EMP
MD-216-3640-EG-CV-GAD-1311	LAYOUT & DETAIL OF TANK FOUNDATIONS								
MD-216-3640-EG-CV-DED-1319	RCC. DETAIL OF TANK FOUNDATION MKD. F3								
MD-216-3640-EG-CV-DED-1318	RCC. DETAIL OF TANK FOUNDATION MKD. F1 & F2	D01	13/03/2023	AS-BUILT	ABS	SJM	AVG	AG	
MD-216-1000-EG-ST-CRT-1001	CIVIL, STRUCTURAL & ARCHITECTURAL - DESIGN CRITERIA	C03	22/08/2020	ISSUED FOR CONSTRUCTION & REVISED AS MKD. C03	ABS	SJM	AVG	AG	
MD-216-3640-EG-ME-PLN-1019	FOUNDATION AND LOAD PLAN FLOAT TAILS	C02	10/05/2020	ISSUED FOR CONSTRUCTION & REVISED AS MKD. C02	ABS	SJM	AVG	AG	
	CONDITIONING, LEACHING & ADSORPTION 3640-REA-001 TO 009	C01	04/03/2020	ISSUED FOR CONSTRUCTION & REVISED AS PER EMPLOYER					
MD-216-3640-EG-ME-PLN-1031	LOW GRADE CONDITIONING, LEACHING & ADSORPTION			COMMENTS ON 27/02/20 & REVISED AS MKD. C01	ABS	SJM	AVG	AG	
	PLAN AT EL.+912.200	A01	17/01/2020	ISSUED FOR REFERENCE	ABS	SJM	AVG	AG	

RESERVED FOR VENDOR LOGO AND DRAWING NUMBER

LARSEN & TOUBRO DRAWING NUMBER: 019045_450_C_G_24136_002 — REVISION: 4

OUTOTEC DRAWING NUMBER: 900707__GAU01__HL13__MTL01__36408 — DOCUMENT ID: OU100667100 — REVISION: 4

LARSEN & TOUBRO
This drawing is the property of LARSEN & TOUBRO and must not be passed on to any person or body not authorized by us to receive it nor be copied or otherwise made use either in full or in part by such person or body without our prior permission in writing.

Outotec
The content of these documents are the sole property of Outotec Oyj. Any rights not expressly granted herein are reserved. Reproduction, transfer or distribution of part or all of the contents in any form without prior written permission of Outotec is prohibited.

MA'ADEN معادن
Saudi Arabian Mining Company شركة معادن العربية السعودية
This document and the information contained herein is Ma'aden proprietary know-how. This document or any part thereof should not be reproduced, stored in a retrieval system or transmitted by any means, electronic or otherwise, or divulged without prior written permission of Ma'aden.

DRAWN	ABS	18/12/2019
CHECKED	SJM	16/01/2020
ENGINEER	AVG	15/01/2020
APPROVED	AG	17/01/2020
EMPLOYER		
SCALE	1:75, 1:50, 1:25, 1:20	A1

MANSOURAH - MASSARAH GOLD PROJECT
GENERAL ARRANGEMENT DRAWING
LOW GRADE CONDITIONING,LEACHING & ADSORPTION
DETAIL OF TANK FOUNDATION MKD. F1, F2 & F3

DRAWING NUMBER: MD-216-3640-EG-CV-GAD-1312 — REV: D01