


DRAWING NUMBER
MD - 216 - 3640 - EG - CV - GAD - 1313
REV D01

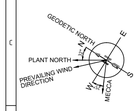


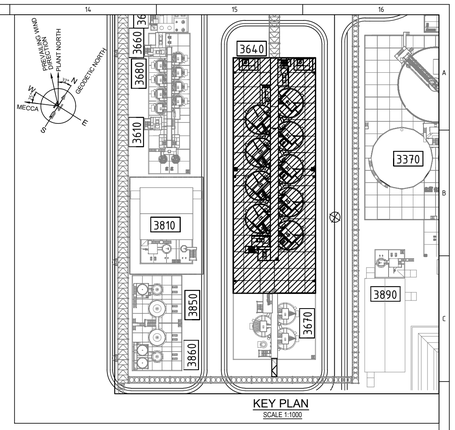


KEY PLAN
SCALE 1:1000

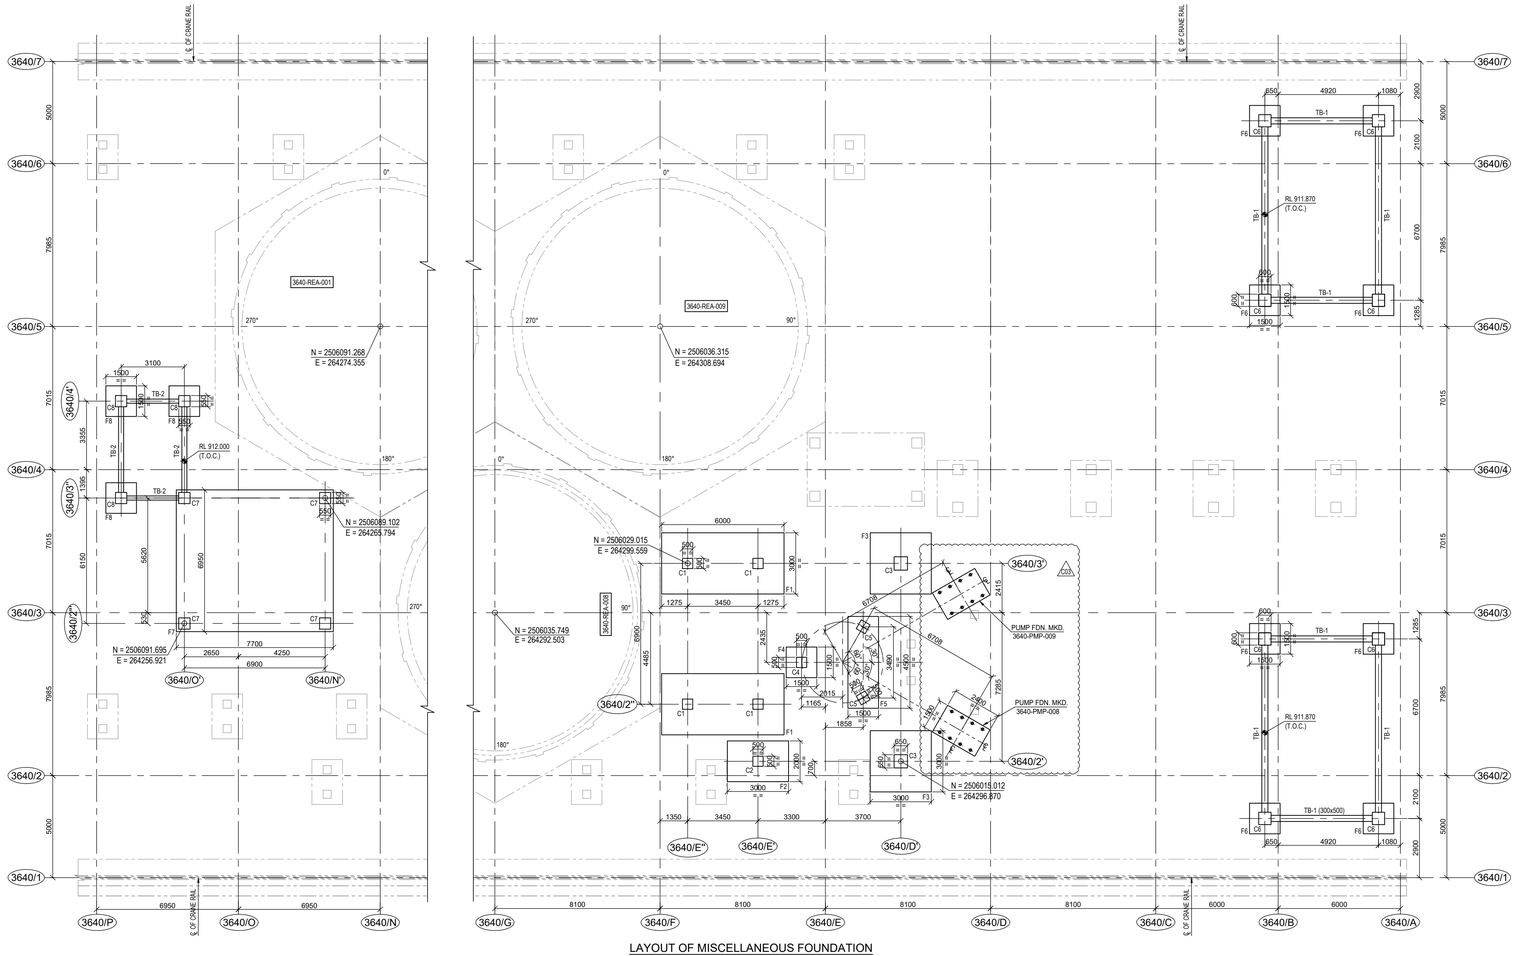


LAYOUT OF MISCELLANEOUS FOUNDATION
SCALE 1:100

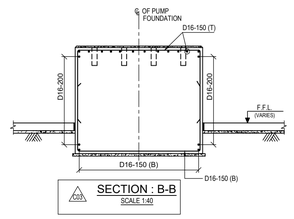


SECTION : B-B
SCALE 1:40

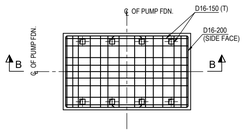


TYP. RC. DET. OF FDN. FOR PUMP MKD. 3640-PMP-008 & 009
(TOP VIEW)
SCALE 1:40

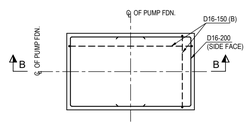

TYP. RC. DET. OF FDN. FOR PUMP MKD. 3640-PMP-008 &009
(BOTTOM VIEW)
SCALE 1:40

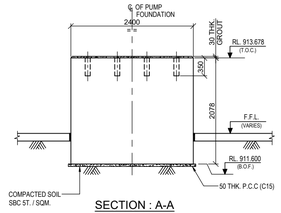

SECTION : A-A
SCALE 1:40

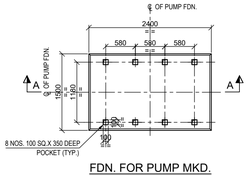

FDN. FOR PUMP MKD. 3640-PMP-008 & 009
SCALE 1:40

LEGEND :-
R.L - REDUCED LEVEL
℄ - CENTRE LINE
T.O.C - TOP OF CONCRETE
T.O.G - TOP OF GROUT
TYP - TYPICAL
F.G.L - FINISHED GROUND LEVEL
F.F.L - FINISHED FLOOR LEVEL
B.O.F - BOTTOM OF FOUNDATION
MKD. - MARKED
P.C.C - PLAIN CEMENT CONCRETE
SBC - SAFE BEARING CAPACITY
T - TON
SQ.M. -SQUARE METRE

NOTES:-
1. ALL DIMENSIONS ARE IN MILLIMETRES AND LEVELS AND CO-ORDINATES ARE IN METRES UNLESS OTHERWISE STATED.
2. NET SAFE BEARING CAPACITY OF SOIL AT BOTTOM OF FOUNDATION CONSIDERED AS 45KN/ SQ. M.
3. GRADE OF CONCRETE SHALL BE C35 (35MPa) FOR FOUNDATION & C15 (15MPa) FOR BLINDING CONCRETE.
4. GRADE OF REINFORCEMENT SHALL BE DEFORMED BAR 420 MPa (GRADE 60) - ASTM A615/A615M.
5. IF ANY PART OF FOUNDATION COMES ON BACKFILL ZONE OF ADJACENT FOUNDATION OR ANY LOOSE SOIL ARE ENCOUNTERED BELOW FOUNDATION LEVEL THE SAME SHALL BE REMOVED AND FILLED WITH PCC.
6. FOR DETAIL OF ANCHOR BOLTS, REFER DRAWING NO. MD-216-1000-EG-CV-DED-1003.

DOCUMENT NUMBER	REFERENCE DOCUMENTS	REV	DATE	REVISION DESCRIPTION	DRN	CHK	ENG	APP	EMP
MD-216-3640-EG-CV-DED-1321	RC DETAIL OF MISCELLANEOUS FOUNDATION	D01	13/03/2023	AS-BUILT	SYA	SJM	AVG	AG	
MD-216-3640-EG-CV-GAD-1311	LAYOUT & DETAIL OF TANK FOUNDATIONS	C03	06/08/2021	ISSUED FOR CONSTRUCTION & REVISED AS MKD. △3	SYA	SJM	AVG	AG	
MD-216-3640-EG-CV-GAD-1314	LAYOUT OF GRADE SLAB	C02	15/10/2020	ISSUED FOR CONSTRUCTION & REVISED AS MKD. △2	ABS	SJM	AVG	AG	
MD-216-3640-EG-ME-GAD-1038	LOW GRADE CONDITIONING, LEACHING PLAN AT EL.+912.200	C01	20/06/2020	ISSUED FOR CONSTRUCTION & REVISED AS MKD. △1	ABS	AVG	MMJ	SJM	
MD-216-1000-EG-ST-CRT-1001	CIVIL, STRUCTURAL & ARCHITECTURAL - DESIGN CRITERIA	A01	28/05/2020	ISSUED FOR REFERENCE	ABS	AVG	MMJ	SJM	

RESERVED FOR VENDOR LOGO AND DRAWING NUMBER

LARSEN & TOUBRO

This drawing is the property of LARSEN & TOUBRO and must not be passed on to any person or body not authorized by us to receive it nor be copied or otherwise made use either in full or in part by such person or body without our prior permission in writing.

Outotec

The content of these documents are the sole property of Outotec Oyj. Any rights not expressly granted herein are reserved. Reproduction, transfer or distribution of part or all of the contents in any form without prior written permission of Outotec is prohibited.

MA'ADEN معادن
Saudi Arabian Mining Company
شركة معادن السعودية

This document and the information contained herein is Ma'aden proprietary know-how. This document or any part thereof should not be reproduced, stored in a retrieval system or transmitted by any means, electronic or otherwise, or divulged without prior written permission of Ma'aden.

LARSEN & TOUBRO DRAWING NUMBER: 019045_450_C_G_24136_003 — REVISION: 4
OUTOTEC DRAWING NUMBER: 900707__GAU01__HL13__MTL01__36409 — DOCUMENT ID: 0U100667101 — REVISION: 4

DRAWN	ABS	23/04/2020
CHECKED	AVG	04/05/2020
ENGINEER	MMJ	02/05/2020
APPROVED	SJM	28/05/2020
EMPLOYER		
SCALE	1:100	A0

MANSOURAH - MASSARAH GOLD PROJECT
GENERAL ARRANGEMENT DRAWING
LOW GRADE CONDITIONING,LEACHING & ADSORPTION
LAYOUT OF MISCELLANEOUS FOUNDATION

DRAWING NUMBER: MD - 216 - 3640 - EG - CV - GAD - 1313 — REV: D01