


DRAWING NUMBER: MD-216-3640-EG-CV-GAD-1314 | REV: D01

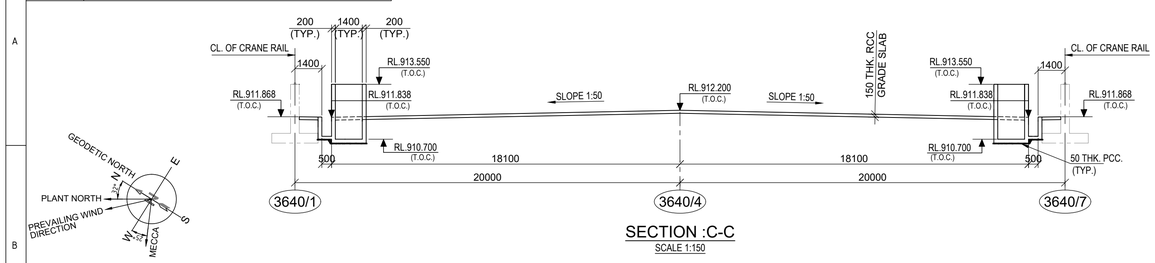


SECTION :C-C
SCALE 1:150

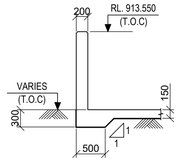


SECTION D'-D'
SCALE 1:50

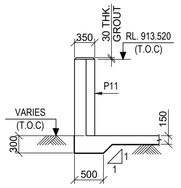


SECTION D"-D"
SCALE 1:50

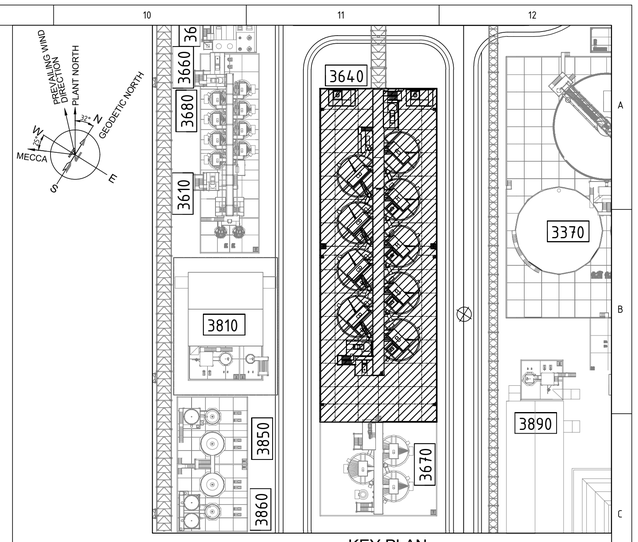


KEY PLAN
SCALE 1:1000

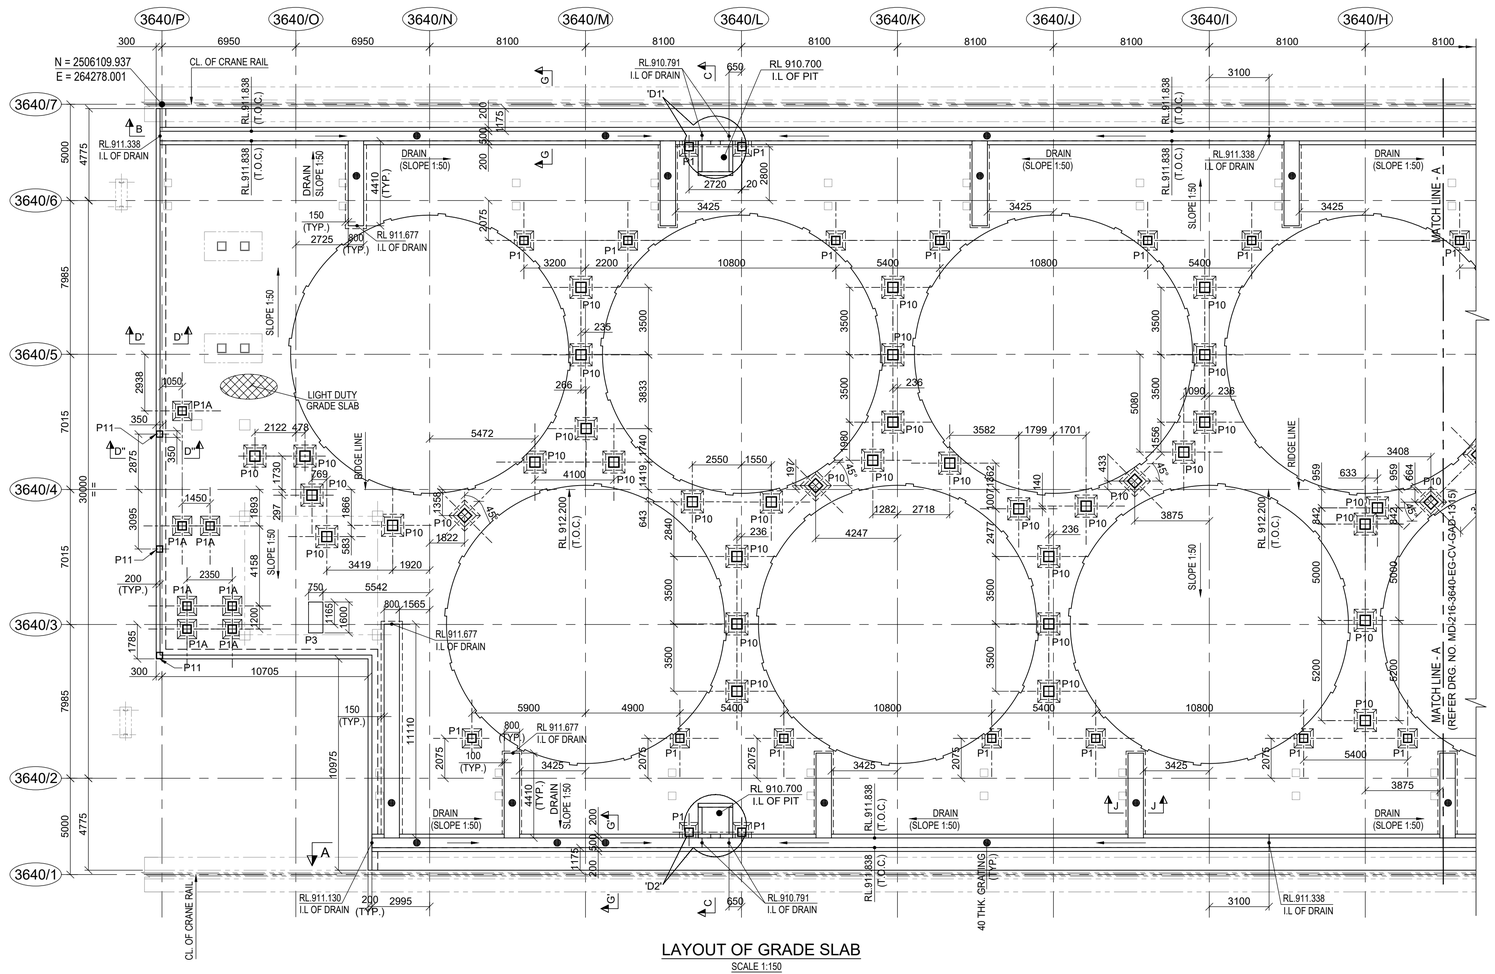


LAYOUT OF GRADE SLAB
SCALE 1:150

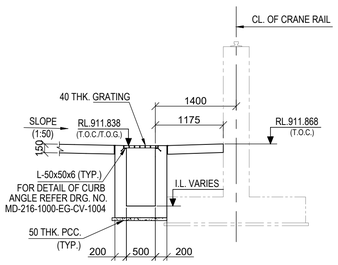


SECTION G-G
SECTION G'-G' (OPP. HAND)
SCALE 1:50

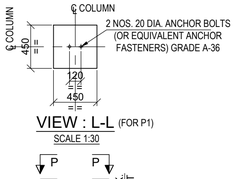


VIEW : L-L (FOR P1)
SCALE 1:30

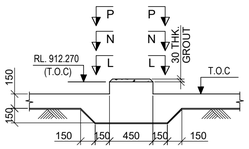


DETAIL OF P1 & P1B
SCALE 1:30

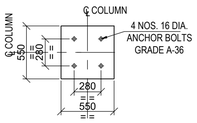


VIEW : M-M
SCALE 1:30

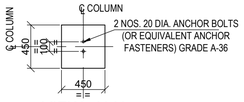

VIEW : N-N (FOR P1A)
SCALE 1:30

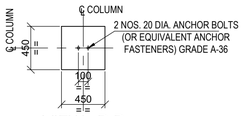

VIEW : P-P (FOR P1B)
SCALE 1:30

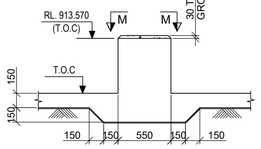

DETAIL OF P10
SCALE 1:30

LEGEND :-
R.L. - REDUCED LEVEL
CL. - CENTRE LINE
I.L - INVERT LEVEL
F.G.L - FINISHED GROUND LEVEL
T.O.C. - TOP OF CONCRETE
P.C.C - PLAIN CEMENT CONCRETE

NOTES:-
1. ALL DIMENSIONS ARE IN MILLIMETRES AND LEVELS AND CO-ORDINATES ARE IN METRES UNLESS OTHERWISE STATED.
2. FOR DETAILS OF GRADE SLAB REFER DRG. NO. MD-216-1000-EG-CV-DED-1002.
3. CHEMICAL RESISTANT COATING SHALL BE APPLIED FOR PROTECTING CONCRETE AGAINST CYANIDE, ACID & ALKALI.

DOCUMENT NUMBER	REFERENCE DOCUMENTS	REV	DATE	REVISION DESCRIPTION	DRN	CHK	ENG	APP	EMP
MD-216-3640-EG-CV-GAD-1316	LAYOUT OF MISCELLANEOUS FOUNDATIONS								
MD-216-3640-EG-CV-GAD-1311	LAYOUT & DETAIL OF TANK FOUNDATIONS								
MD-216-3640-EG-CV-DED-1320	RC. DETAILS OF GRADE SLAB								
MD-216-3640-EG-CV-GAD-1315	LAYOUT & DETAIL OF GRADE SLAB								
MD-216-1000-EG-ST-CRT-1001	CIVIL, STRUCTURAL & ARCHITECTURAL - DESIGN CRITERIA	D01	13/03/2023	AS-BUILT	ABS	SJM	AVG	AG	
MD-216-3640-EG-ME-PLN-1031	LOW GRADE CONDITIONING, LEACHING & ADSORPTION PLAN AT EL.+912.200	C02	22/12/2020	ISSUED FOR CONSTRUCTION & REVISED AS MKD. 002	ABS	SJM	AVG	AG	
MD-216-3640-EG-ME-PLN-1019	FOUNDATION AND LOAD PLAN FLOAT TAILS CONDITIONING, LEACHING &	C01	25/05/2020	ISSUED FOR CONSTRUCTION	ABS	SJM	AVG	AG	
	ADSORPTION 3640-REA-001 TO 009 LOW GRADE CONDITIONING / CIL REACTOR	A01	18/04/2020	ISSUED FOR REFERENCE	ABS	SJM	AVG	AG	

RESERVED FOR VENDOR LOGO AND DRAWING NUMBER

LARSEN & TOUBRO
This drawing is the property of LARSEN & TOUBRO and must not be passed on to any person or body not authorized by us to receive it nor be copied or otherwise made use either in full or in part by such person or body without our prior permission in writing.

Outotec
The content of these documents are the sole property of Outotec Oyj. Any rights not expressly granted herein are reserved. Reproduction, transfer or distribution of part or all of the contents in any form without prior written permission of Outotec is prohibited.

MA'ADEN معادن
Saudi Arabian Mining Company شركة معادن العربية السعودية
This document and the information contained herein is Ma'aden proprietary know-how. This document or any part thereof should not be reproduced, stored in a retrieval system or transmitted by any means, electronic or otherwise, or divulged without prior written permission of Ma'aden.

LARSEN & TOUBRO DRAWING NUMBER	019045_450_C_G_24136_004		REVISION 3
OUTOTEC DRAWING NUMBER	900707 _GAU01 _HL13 _MTL01 _36410	DOCUMENT ID OU100667102	REVISION 3
DRAWN	ABS	18/03/2020	MANSOURAH - MASSARAH GOLD PROJECT
CHECKED	SJM	16/04/2020	GENERAL ARRANGEMENT DRAWING
ENGINEER	AVG	18/03/2020	LOW GRADE CONDITIONING,LEACHING & ADSORPTION
APPROVED	AG	18/04/2020	LAYOUT & DETAIL OF GRADE SLAB
EMPLOYER			
SCALE	1:150	A1	DRAWING NUMBER MD-216-3640-EG-CV-GAD-1314 REV D01