


DRAWING NUMBER MD - 216 - 3640 - EG - CV - GAD - 1315 REV D01

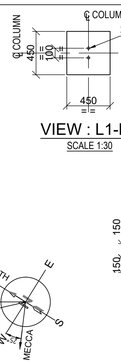

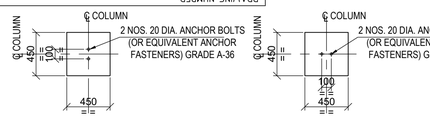


VIEW : L1-L1 (FOR P2)
SCALE 1:30


VIEW : L2-L2 (FOR P2A)
SCALE 1:30

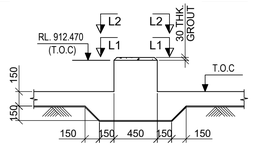


DETAIL OF P2 & P2A
SCALE 1:30

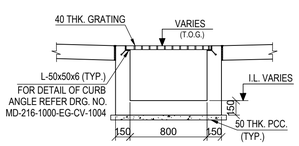


SECTION : J-J
SCALE 1:30

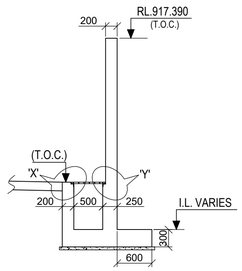


SECTION : H-H
SCALE 1:50

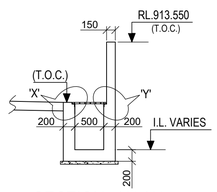


SECTION : H1-H1
SCALE 1:50

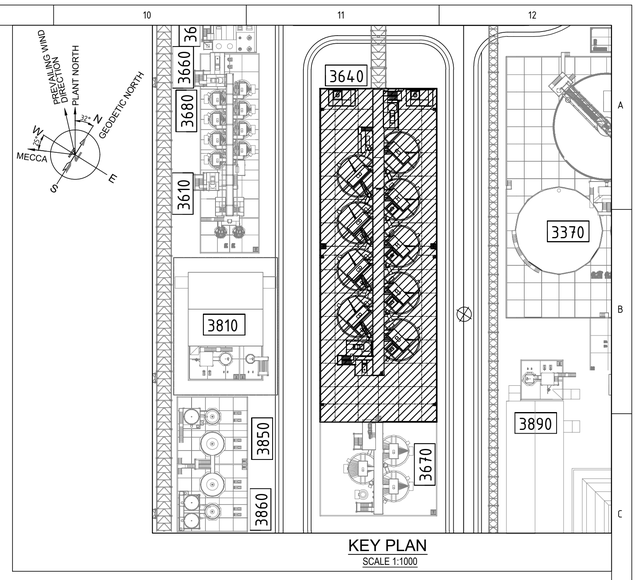


KEY PLAN
SCALE 1:1000

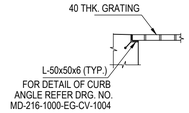


DETAIL - 'X'
SCALE 1:20

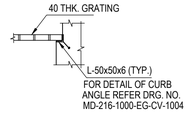


DETAIL - 'Y'
SCALE 1:20

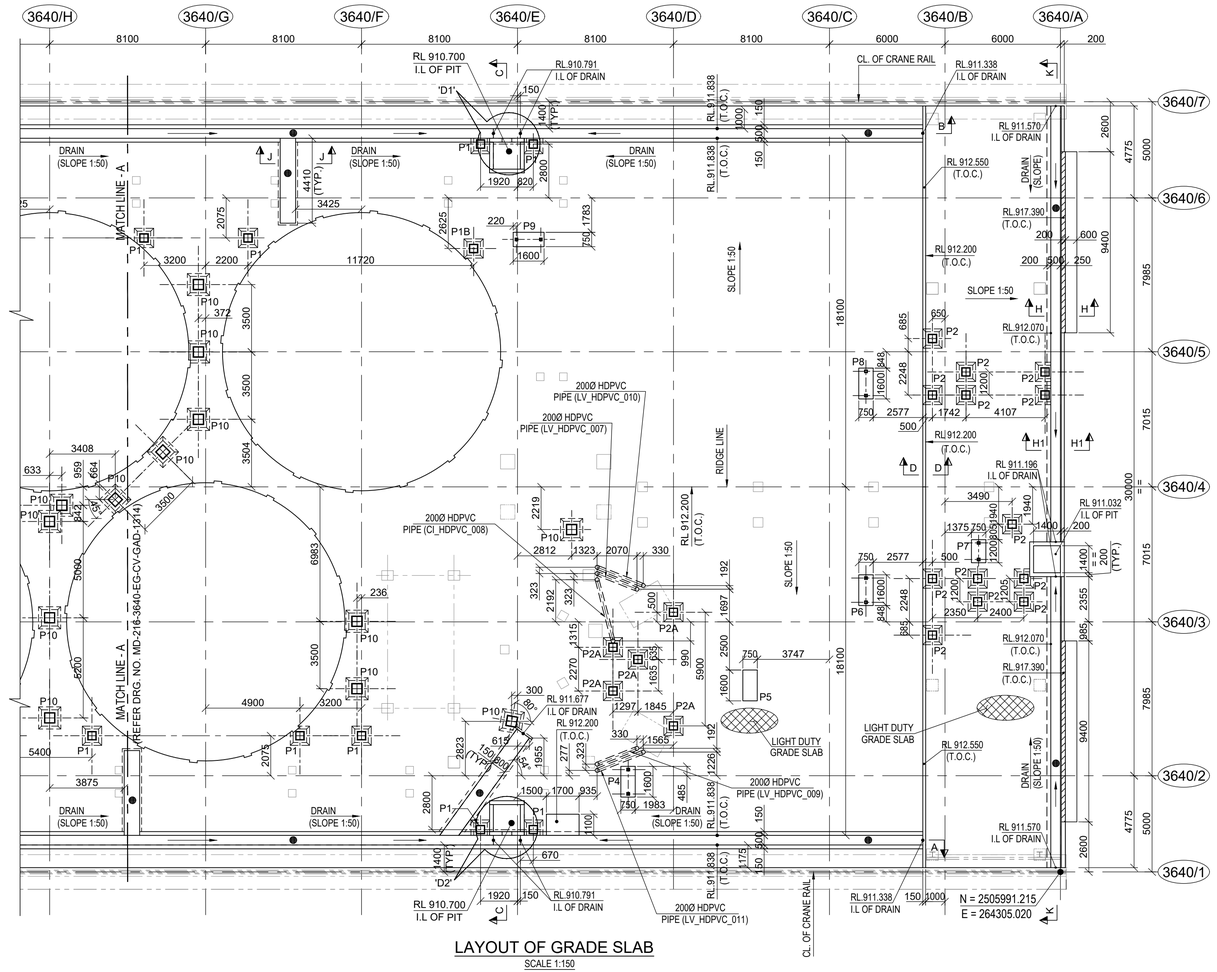


LAYOUT OF GRADE SLAB
SCALE 1:150

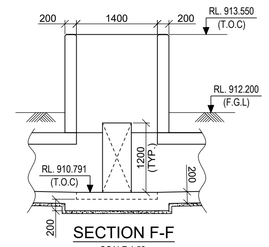


SECTION F-F
SCALE 1:50

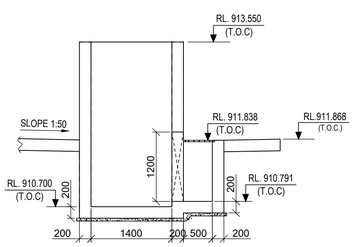


SECTION E-E
SCALE 1:50

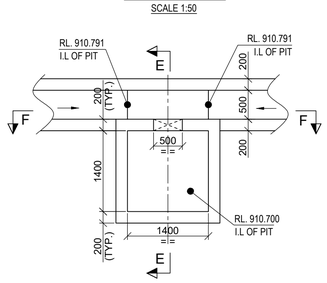

DETAIL-D1
DETAIL-D2 (OPP. HAND)
SCALE 1:50

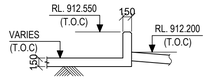

SECTION D-D
SCALE 1:50

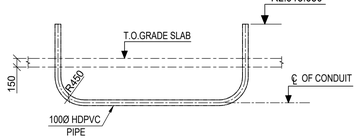

TYPICAL DETAIL OF CONDUIT
SCALE 1:50

SCHEDULE OF CONDUIT :-

CONDUIT MKD.	ELEVATION AT ℄ OF CONDUIT
LV_HDPVC_007	RL 911.825
CI_HDPVC_008	RL 911.825
LV_HDPVC_009	RL 911.825
LV_HDPVC_010	RL 911.825
LV_HDPVC_011	RL 911.825

LEGEND :-
R.L. - REDUCED LEVEL
CL. - CENTRE LINE
I.L - INVERT LEVEL
F.G.L - FINISHED GROUND LEVEL
T.O.C. - TOP OF CONCRETE
P.C.C - PLAIN CEMENT CONCRETE
Ø - DIAMETER
R - RADIUS
℄ - CENTRE LINE

NOTES:-
1. ALL DIMENSIONS ARE IN MILLIMETRES AND LEVELS AND CO-ORDINATES ARE IN METRES UNLESS OTHERWISE STATED.
2. FOR DETAILS OF GRADE SLAB REFER DRG. NO. MD-216-1000-EG-CV-DED-1002.
3. CHEMICAL RESISTANT COATING SHALL BE APPLIED FOR PROTECTING CONCRETE AGAINST CYANIDE, ACID & ALKALI.

DOCUMENT NUMBER	REFERENCE DOCUMENTS	REV	DATE	REVISION DESCRIPTION	DRN	CHK	ENG	APP	EMP
MD-216-3640-EG-CV-GAD-1316	LAYOUT OF MISCELLANEOUS FOUNDATIONS								
MD-216-3640-EG-CV-GAD-1311	LAYOUT & DETAIL OF TANK FOUNDATIONS								
MD-216-3640-EG-CV-DED-1320	RC. DETAILS OF GRADE SLAB	D01	13/03/2023	AS-BUILT	PML	SJM	AVG	AG	
MD-216-3640-EG-CV-GAD-1314	LAYOUT OF GRADE SLAB	C04	19/03/2021	ISSUED FOR CONSTRUCTION & REVISED AS MKD. C04	PML	SJM	AVG	AG	
MD-216-1000-EG-ST-CRT-1001	CIVIL, STRUCTURAL & ARCHITECTURAL - DESIGN CRITERIA	C03	13/03/2021	ISSUED FOR CONSTRUCTION & REVISED AS MKD. C03	ABS	SJM	AVG	AG	
MD-216-3640-EG-ME-PLN-1031	LOW GRADE CONDITIONING, LEACHING & ADSORPTION PLAN AT EL.+912.200	C02	22/12/2020	ISSUED FOR CONSTRUCTION & REVISED AS MKD. C02	ABS	SJM	AVG	AG	
MD-216-3640-EG-ME-PLN-1019	FOUNDATION AND LOAD PLAN FLOAT TAILS CONDITIONING, LEACHING & ADSORPTION 3640-REA-001 TO 009 LOW GRADE CONDITIONING / CIL REACTOR	C01	25/05/2020	ISSUED FOR CONSTRUCTION AND REVISED AS MKD. C01	ABS	SJM	SJM	AG	
		A01	18/04/2020	ISSUED FOR REFERENCE	ABS	SJM	AVG	AG	

RESERVED FOR VENDOR LOGO AND DRAWING NUMBER

LARSEN & TOUBRO

This drawing is the property of LARSEN & TOUBRO and must not be passed on to any person or body not authorized by us to receive it nor be copied or otherwise made use either in full or in part by such person or body without our prior permission in writing.

Outotec

The content of these documents are the sole property of Outotec Oyj. Any rights not expressly granted herein are reserved. Reproduction, transfer or distribution of part or all of the contents in any form without prior written permission of Outotec is prohibited.

MA'ADEN معادن
Saudi Arabian Mining Company شركة معادن العربية السعودية

This document and the information contained herein is Ma'aden proprietary know-how. This document or any part thereof should not be reproduced, stored in a retrieval system or transmitted by any means, electronic or otherwise, or divulged without prior written permission of Ma'aden.

LARSEN & TOUBRO DRAWING NUMBER: O19045_450_C_G_24136_005 — REVISION: 5
OUTOTEC DRAWING NUMBER: 900707 _GAU01 _HL13 _MTL01 _36411 — DOCUMENT ID: OU100667103 — REVISION: 5

DRAWN	ABS	18/03/2020
CHECKED	SJM	16/04/2020
ENGINEER	AVG	18/03/2020
APPROVED	AG	18/04/2020
EMPLOYER		
SCALE	1:200, 1:150	A1

MANSOURAH - MASSARAH GOLD PROJECT
GENERAL ARRANGEMENT DRAWING
LOW GRADE CONDITIONING,LEACHING & ADSORPTION
LAYOUT & DETAIL OF GRADE SLAB

DRAWING NUMBER: MD - 216 - 3640 - EG - CV - GAD - 1315 — REV: D01