

REV D01


DRAWING NUMBER MD-216-1000-EG-CV-TPD-1003

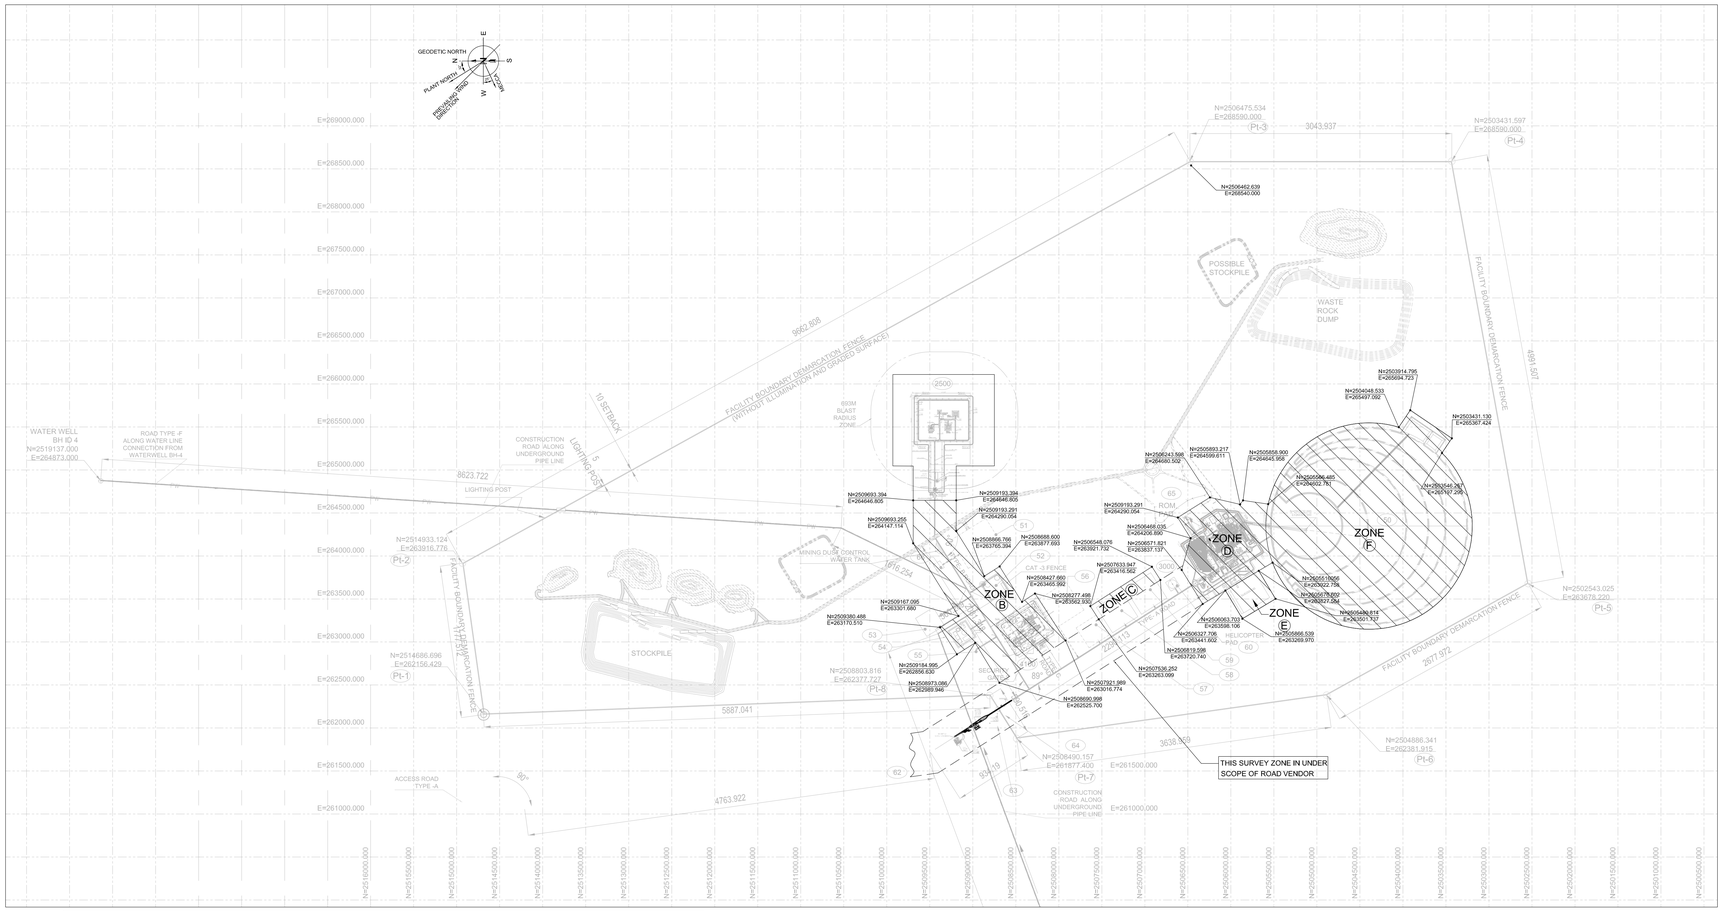

DETAIL-'A'
1:25000

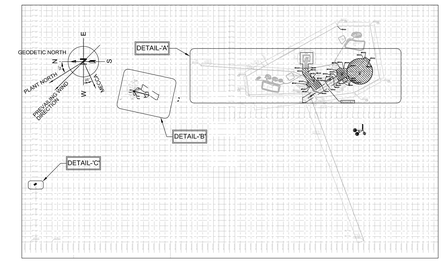


KEY PLAN
1:200000

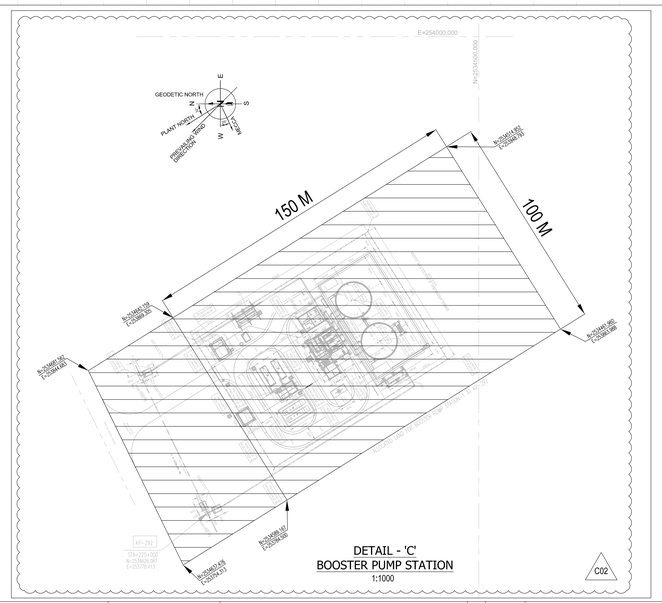

DETAIL - 'C'
BOOSTER PUMP STATION
1:1000

C02

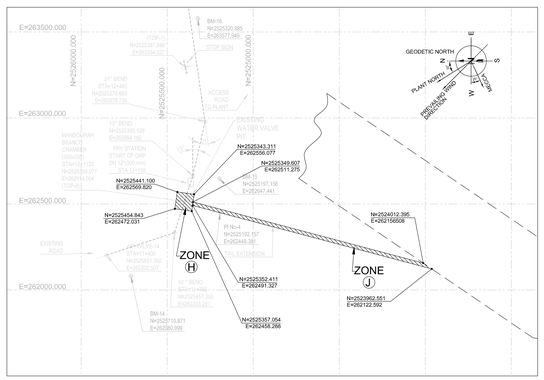

DETAIL-'B'
1:12500

NOTES:-
1. ALL DIMENSIONS ARE IN METER.
2. ALL CO ORDINATES ARE IN METER.

INDICATES SCOPE OF SURVEY AREA

DOCUMENT NUMBER	REFERENCE DOCUMENTS	DOCUMENT NUMBER	REFERENCE DOCUMENTS	REV	DATE	REVISION DESCRIPTION	DRN	CHK	ENG	APP	EMP
MD-216-3100-EG-ME-DLA-0001	PROCESS AREA -CRUSHING OVERALL PLAN	MD-212-0110-EG-CV-DEL-0002	MAIN ACCESS ROAD PROFILES (SHEET 1 TO 87)								
MD-216-3000-EG-GE-DLO-0001	PROCESS PLANT SITE PLAN	MD-212-0110-EG-CV-DEL-0001	MAIN ACCESS ROAD PROFILES (SHEET 1 TO 30)								
MD-216-4200-EG-GE-DLO-0005	EXPLOSIVE MAGAZINE SITE PLAN	MD-215-ADSF-EG-TP-DWG-0208	TOP OF TREATED WATER								
MD-216-4300-EG-GE-DDE-0001 & 2	TYPICAL SECURITY FENCE	MD-216-0000-EG-GE-DSK-0001	PROJECT OVERALL LAYOUT								
MD-216-4300-EG-CV-DDE-0001	TYPICAL ROADWAY SECTIONS	MD-216-0000-EG-SY-DGA-0001	OVERALL SITE SECURITY LAYOUT								
MD-216-0000-EG-GE-DPP-0001	OVERALL PROJECT LAYOUT	MD-216-0000-EG-GE-DPP-0004	WATER-WELL , POTABLE WATER AND WASTE WATER PIPE ROUTE								
MD-216-0000-EG-GE-DLO-0001	OVERALL SITE PLAN	MD-216-2500-EG-GE-DGA-0001 & 2	EXPLOSIVE MAGAZINE STORAGE BUILDINGS								
MD-216-0000-EG-GE-DLO-0002	MINING BOUNDARY LIMITS-SITE PLAN	MD-215-ADSF-EG-PADP-0001	OVERALL PIPELINE ROUTE PACKAGE-3								

REV	DATE	REVISION DESCRIPTION	DRN	CHK	ENG	APP	EMP
D01	10/10/2023	AS BUILT	SYA	SJM	MLI	AG	
C02	15/02/2021	ISSUED FOR CONSTRUCTION & REVISED AS MARKED C02	SYA	SJM	MLI	AG	
C01	06/02/2020	ISSUED FOR CONSTRUCTION	SYA	SJM	MLI	AG	
A02	12/12/2019	REVISED AS PER EMPLOYER COMMENTS DATED 20/09/2019	SYA	SJM	MLI	AG	
A01	27/08/2019	FIRST ISSUE	SYA	SJM	MLI	AG	

RESERVED FOR VENDOR LOGO AND DRAWING NUMBER

LARSEN & TOUBRO DRAWING NUMBER 019045_001_T_B_24756_002 — REVISION 4

OUTOTEC DRAWING NUMBER 900707_GAU01_ZZ01_CLD01_00002 — DOCUMENT ID OU100656267 — REVISION 4

LARSEN & TOUBRO

This drawing is the property of LARSEN & TOUBRO and must not be passed on to any person or body not authorized by us to receive it nor be copied or otherwise made use either in full or in part by such person or body without our prior permission in writing.

Outotec

The content of these documents are the sole property of Outotec Oyj. Any rights not expressly granted herein are reserved. Reproduction, transfer or distribution of part or all of the contents in any form without prior written permission of Outotec is prohibited.

MA'ADEN معادن Saudi Arabian Mining Company شركة التعدين العربية السعودية

This document and the information contained herein is Ma'aden proprietary know-how. This document or any part thereof should not be reproduced, stored in a retrieval system or transmitted by any means, electronic or otherwise, or divulged without prior written permission of Ma'aden.

DRAWN	SYA	27/08/2019
CHECKED	MLI	27/08/2019
ENGINEER	MLI	27/08/2019
APPROVED	SJM	27/08/2019
EMPLOYER		

SCALE 1:25000,12500,1000, 75 — A0

MANSOURAH - MASSARAH GOLD PROJECT
GENERAL ARRANGEMENT DRAWING
TOPOGRAPHICAL SURVEY SCOPE
SITE PLAN

DRAWING NUMBER MD-216-1000-EG-CV-TPD-1003 — REV D01