

DRAWING NUMBER: MD-216-1000-EG-CV-TPD-1004
REV: D01

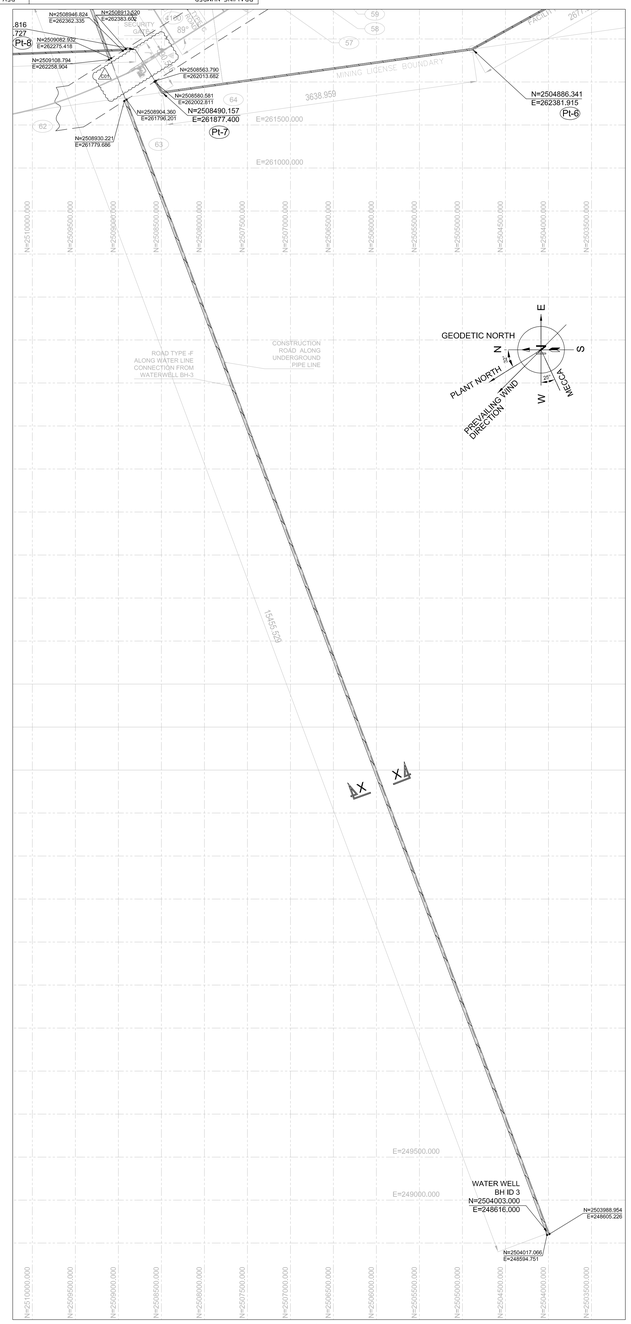


DETAIL-'A'
1:25000

DETAIL-'B'
1:25000

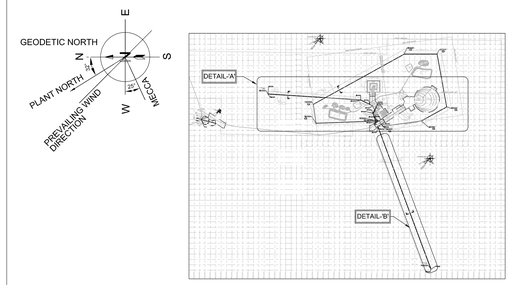

KEY PLAN
1:200000

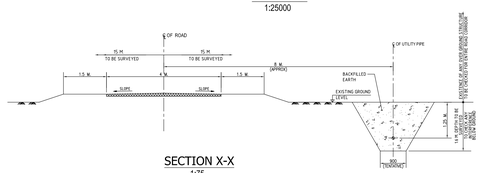

SECTION X-X
1:75



SECTION Y-Y
1:75

NOTES:~

1. ALL DIMENSIONS ARE IN M.
2. ALL CO ORDINATES ARE IN M.
3. THIS DWG. SHALL BE READ IN CONJUNCTION WITH DWG. NO. MD-216-1000-EG-CV-TPD-1003.

INDICATES SCOPE OF SURVEY AREA

REV	DATE	REVISION DESCRIPTION	DRN	CHK	ENG	APP	EMP
D01	10/10/2023	AS BUILT	SYA	NZH	MLI		
C01	07/03/2020	ISSUED FOR CONSTRUCTION & REVISED AS PER EMPLOYER COMMENTS ON 19/12/2019	SYA	NZH	MLI	SJM	
A01	15-11-2019	FIRST ISSUE	SYA	NZH	MLI	SJM	

DOCUMENT NUMBER	REFERENCE DOCUMENTS
MD-216-0000-EG-GE-DLO-0002-C02	MINING BOUNDARY LIMITS SITE PLAN

RESERVED FOR VENDOR LOGO AND DRAWING NUMBER

This drawing is the property of LARSEN & TOUBRO and must not be passed on to any person or body not authorised by us to receive it nor be copied or otherwise made use of/ear in full or in part by such person or body without our prior permission in writing.

The content of these documents are the sole property of Outotec Oy. Any rights not expressly granted herein are reserved. Reproduction, transfer or distribution of part or all of the contents in any form without prior written permission of Outotec is prohibited.

This document and the information contained herein is Ma'aden proprietary know-how. This document or any part thereof should not be reproduced, stored in a retrieval system or transmitted by any means, electronic or otherwise, or divulged without prior written permission of Ma'aden.

LARSEN & TOUBRO DRAWING NUMBER: 019045_001_T_G_24756_003 — REVISION: 2
OUTOTEC DRAWING NUMBER: 900707_GAU01_ZZ01_MTL01_10001 — DOCUMENT ID: OU100665314 — REVISION: 2

DRAWN	SYA	12-11-2019
CHECKED	NZH	13-11-2019
ENGINEER	MLI	14-11-2019
APPROVED	SJM	15-11-2019
EMPLOYER		
SCALE	1:25000, 75	A0

MANSOURAH - MASSARAH GOLD PROJECT
GENERAL ARRANGEMENT DRAWING
TOPOGRAPHICAL SURVEY SCOPE
FOR BORE WELL 3&4 AND BOUNDARY FENCE SITE PLAN

DRAWING NUMBER: MD-216-1000-EG-CV-TPD-1004 — REV: D01

MA'ADEN معادن
Saudi Arabian Mining Company شركة التعدين العربية السعودية

BECHTEL

Mansourah Massarah Gold Project
Comment Resolution Log Sheet / Compliance Report

Outotec
LARSEN & TOUBRO

PROJECT: MANSOURAH MASSARAH GOLD PROJECT — **PROJECT NO.: 216**
STAGE: 4 - PROJECT EXECUTION. — **REVIEW LOG DOC. NO. & REV.:**
ACONEX REF. NO. & DATE: BECHTEL-WTRAN-000766, 19 December 2019

STATUS CODE: A - APPROVED, C - APPROVED WITH COMMENTS, R - REVISE & RESUBMIT & O - OTHERS (INFORMATION, REFERENCE, REVIEWED)

DOCUMENT NUMBER	Area / Title	Comment No.	PMC/PMT COMMENT DATE: 19 December 2019	Comment by	EPC Response DATE: 07 March 2020	Status	Remarks
			General Comments (cc)				
MD-216-1000-EG-CV-TPD-1004-A01	1000	1	Please verify if there is not interference with checkpoint facilities	Mr. Doron Golan BECHTEL	Final approved location of check point is updated in the revised drawing.	Closed	