MA'ADEN معادن

Saudi Arabian Mining Company شركة التعدين العربية السعودية

Project **Mansourah Massarah Gold Project**

Customer: **MA'ADEN GOLD AND BASE METALS (MA'ADEN)**

Title: **TOPOGRAPHICAL SURVEY**
BOREWELL STN 3,4 & PERIMETER BOUNDARY FENCE
SURVEY DRAWING

Document Number: **MD-216-1000-EG-CV-TPD-1005**

Revision: **D01**


Revision Date: **11.10.2023**

Status: **AS BUILT**

Outotec Document Number:	900707	GAU01	ZZ01	CLA04	10000	OU100666654	2
L&T Document Number:	O19045	001	T	G	24525	001	2

REVISION HISTORY						
Rev	**Date**	**Revision Text**	**Prepared By**	**Reviewed By**	**Approved By**	**Employer**
A01	07.12.2019	FIRST ISSUE	C.P	M.A	MUHD/SJM	
A02	11.12.2020	REVISED AS PER EMPLOYER COMMENTS ON 27/01/2020	C.P	M.A	MUHD/SJM	
C01	03.02.2021	ISSUED FOR CONSTRUCTION	C.P	M.A	MUHD/SJM	
D01	11.10.2023	AS BUILT	C.P	M.A	MUHD/SJM	

DRAWING NUMBER
MD - 216 - 1000 - EG - CV - TPD - 1005
REV
D01

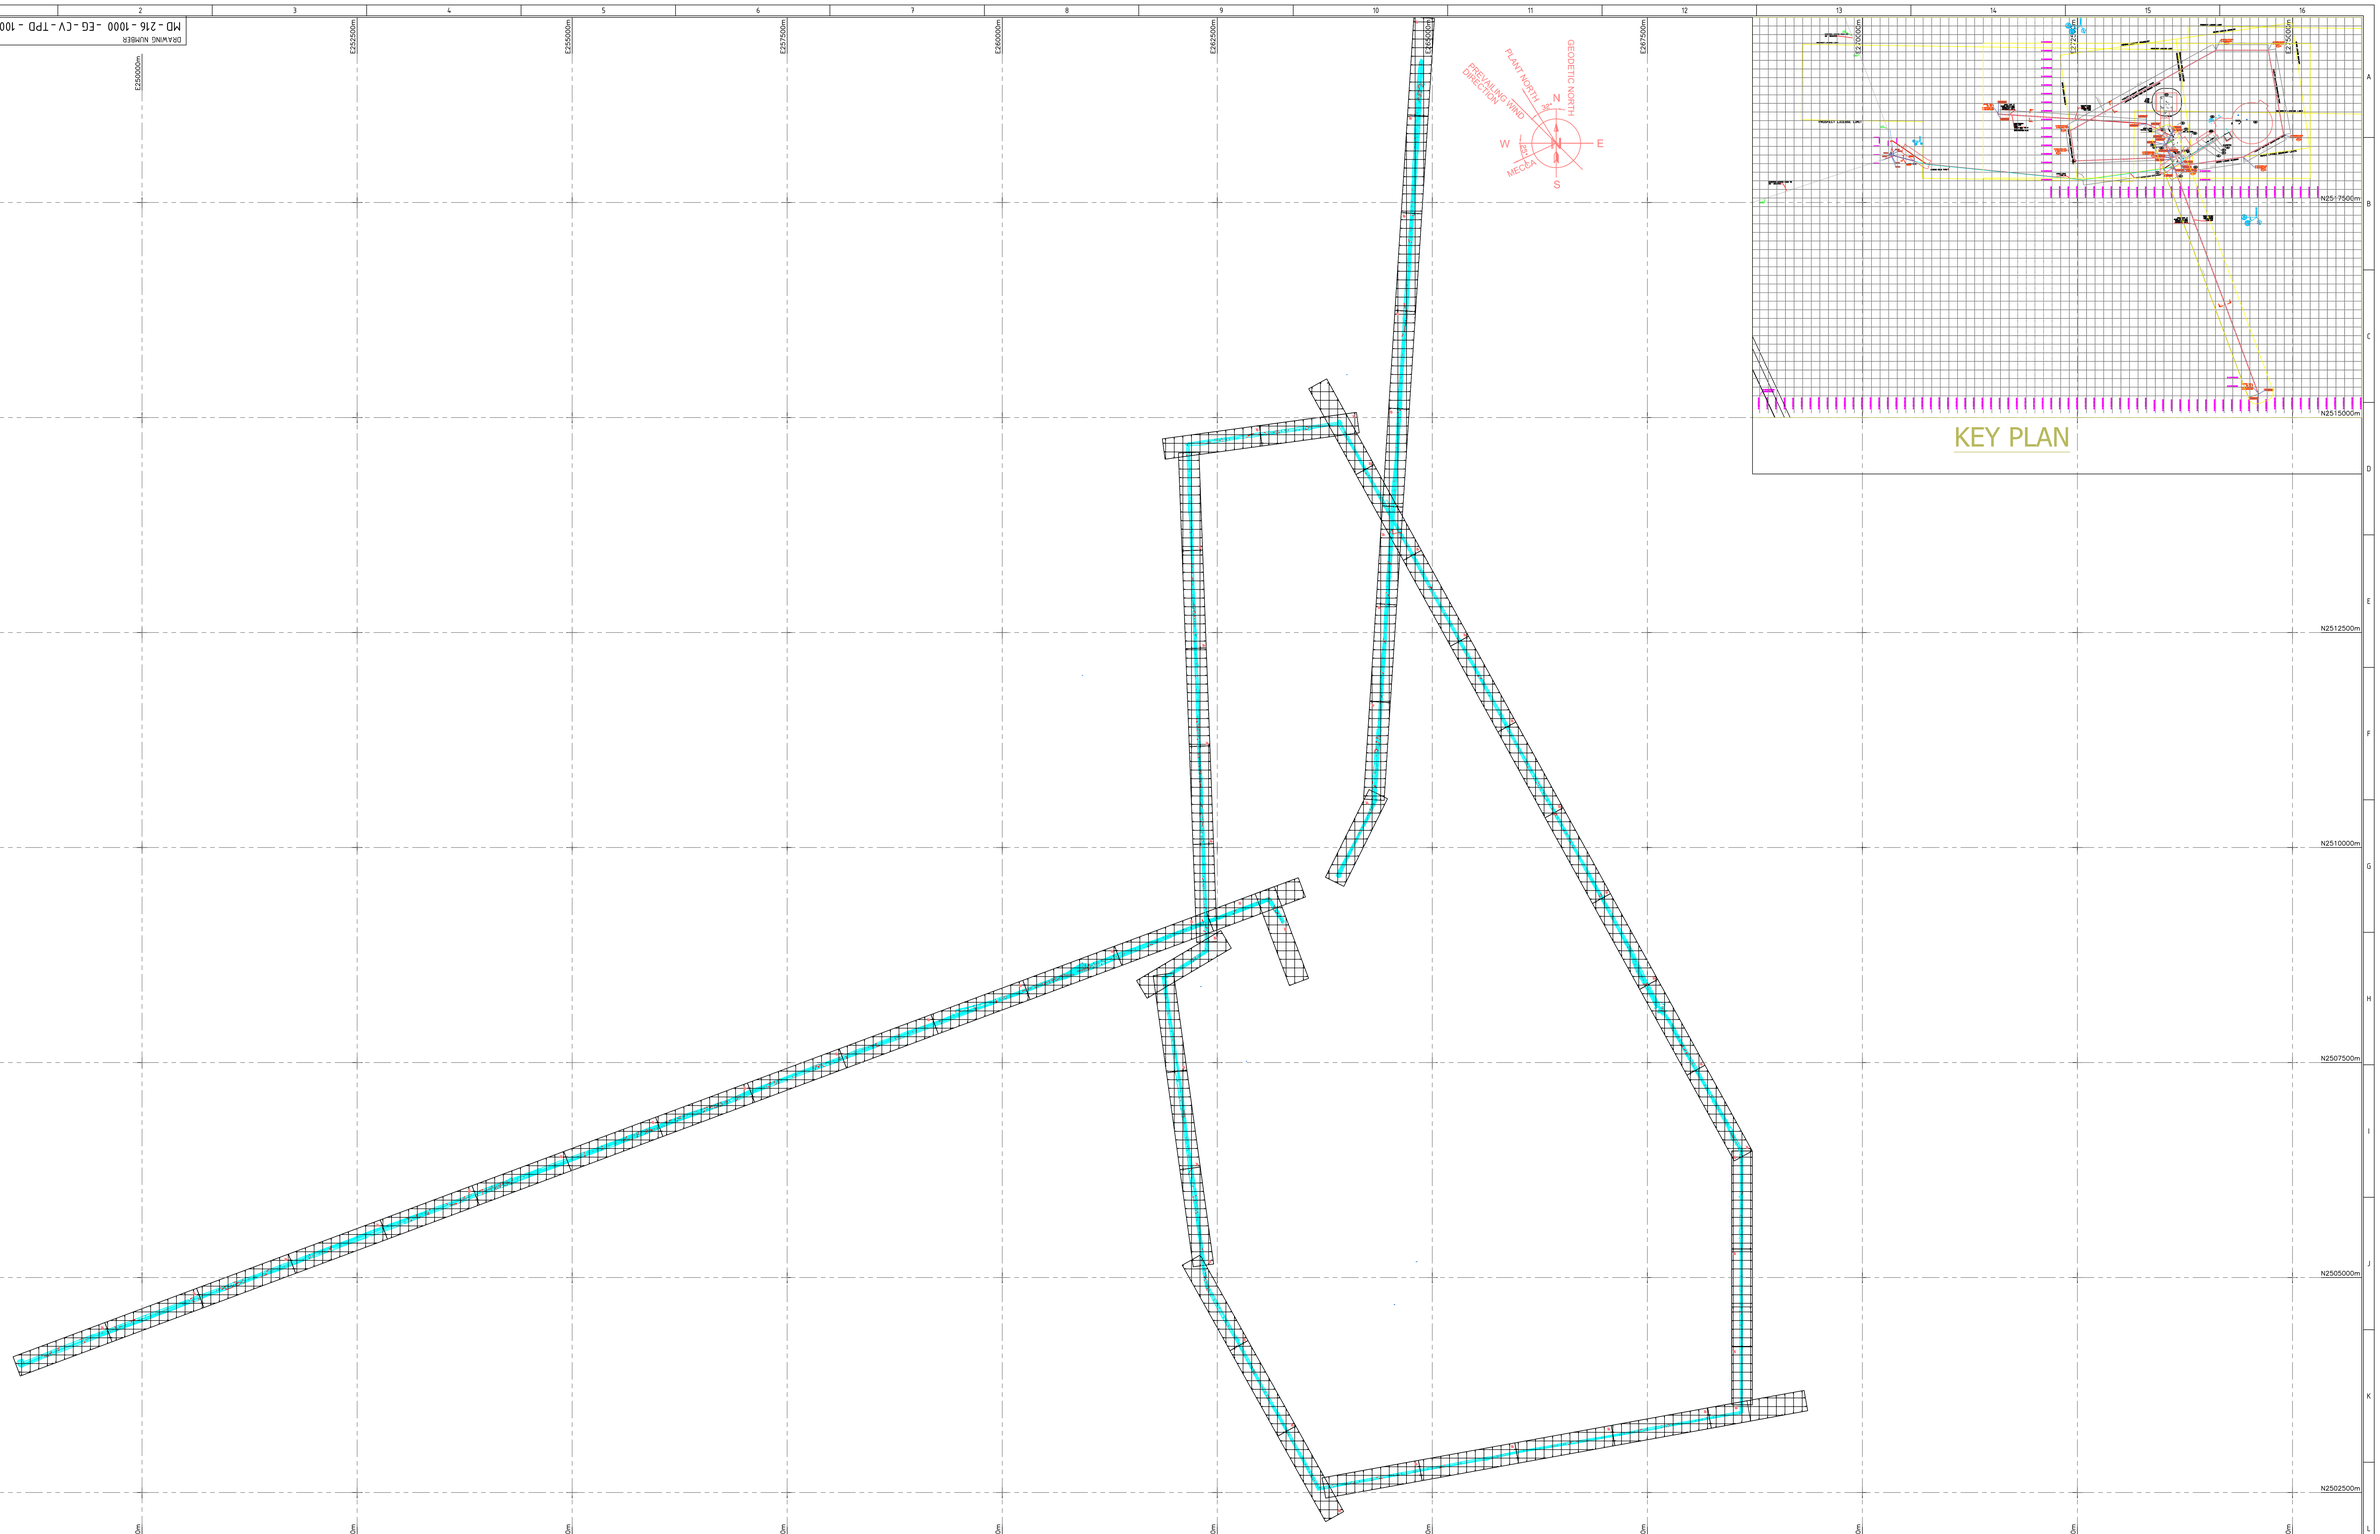

DOCUMENT NUMBER	REFERENCE DOCUMENTS	REV	DATE	REVISION DESCRIPTION	DRN	CHK	ENG	APP	EMP
D01			11/10/2023	AS BUILT	C.P	MLI	M.A	S.JM	
C01			03/02/2021	ISSUED FOR CONSTRUCTION	C.P	MLI	M.A	S.JM	
A02			11/12/2020	REVISED AS PER EMPLOYER COMMENTS ON 27/01/2020	C.P	MLI	M.A	S.JM	
A01			07/12/2019	ISSUED FOR REFERENCE	C.P	M.A	M.A	MUHD/S.JM	

DOCUMENT NUMBER | REFERENCE DOCUMENTS | REV | DATE | REVISION DESCRIPTION | DRN | CHK | ENG | APP | EMP

AFE CONSTRUCTION

مؤسسة أشرف محمد فضل خان للمقاولات
A. M. FAZAL CONTRACTING EST.

LARSEN & TOUBRO

This drawing is the property of LARSEN & TOUBRO and must not be passed on to any person or body not authorized by us to receive it nor be copied or otherwise made use either in full or in part by such person or body without our prior permission in writing.

Outotec

The content of these documents are the sole property of Outotec Oy. Any rights not expressly granted herein are reserved. Reproduction, transfer or distribution of part or all of the contents in any form without prior written permission of Outotec is prohibited.

MA'ADEN معادن
Saudi Arabian Mining Company شركة المعادن العربية السعودية


This document and the information contained herein is Ma'aden proprietary know-how. This document or any part thereof should not be reproduced, stored in a retrieval system or transmitted by any means, electronic or otherwise, or divulged without prior written permission of Ma'aden.


LARSEN & TOUBRO DRAWING NUMBER: 019045_001_T_G_24525_001 — REVISION: 3
OUTOTEC DRAWING NUMBER: 900707 _ GAU01 _ ZZ01 _ CLA04 _ 10000 — DOCUMENT ID: OU100666654 — REVISION: 3


DRAWN	C.P	04/12/2019
CHECKED	M.A	05/12/2019
ENGINEER	M.A	06/12/2019
APPROVED	MUHD/S.JM	07/12/2019
EMPLOYER		
SCALE	1:25000	A0

MANSOURAH - MASSARAH GOLD PROJECT
TOPOGRAPHICAL SURVEY
BOREWELL STN 3,4 & PERIMETER BOUNDARY FENCE SURVEY DRAWING (SHEET-1 OF 19)

DRAWING NUMBER: MD - 216 - 1000 - EG - CV - TPD - 1005 — REV: D01

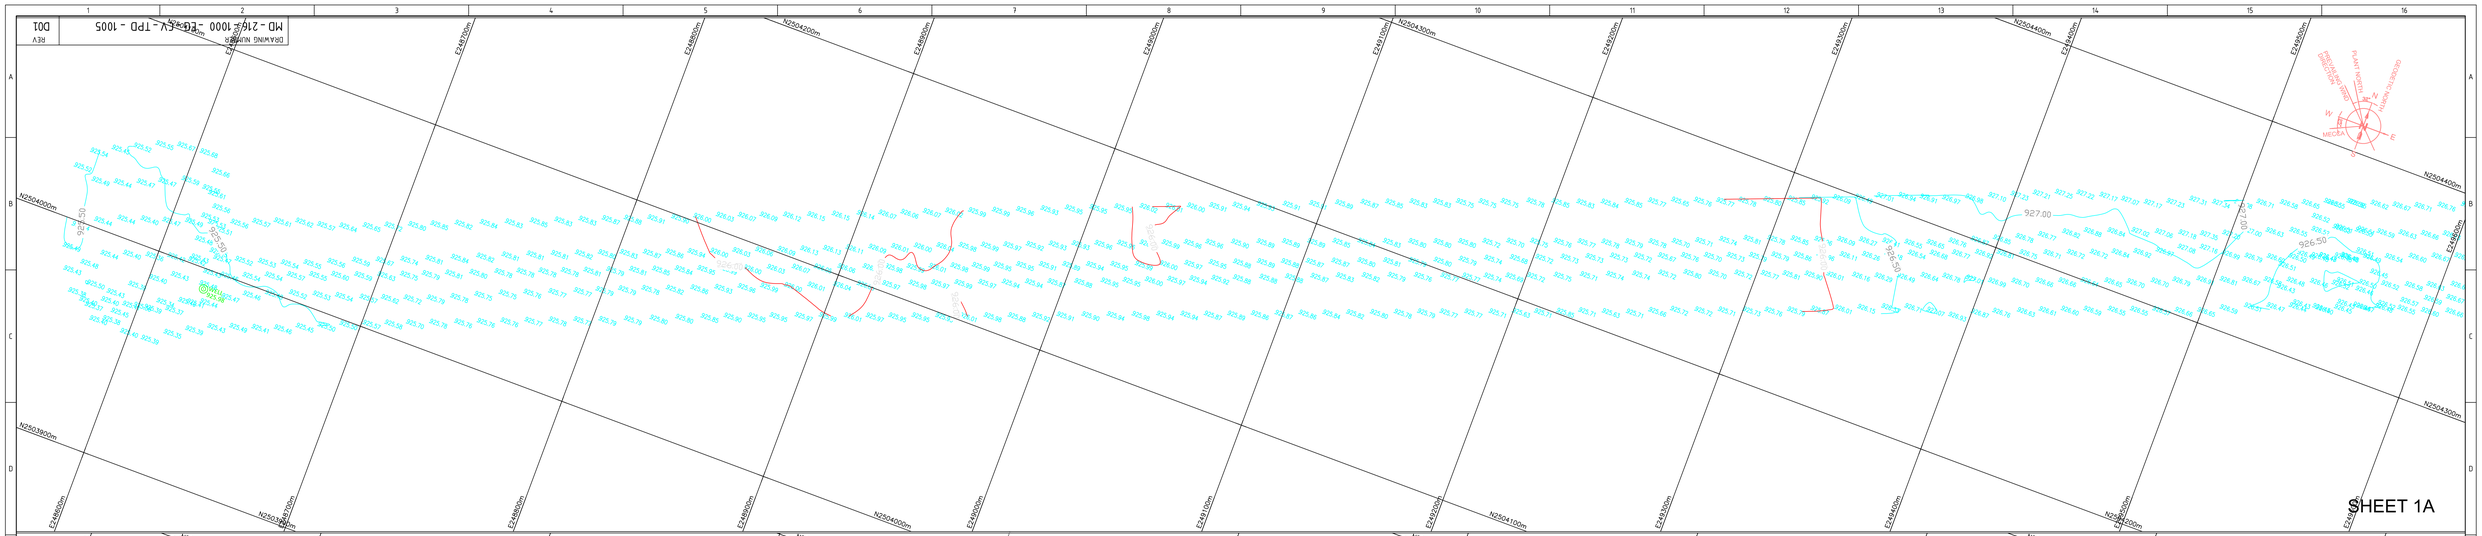

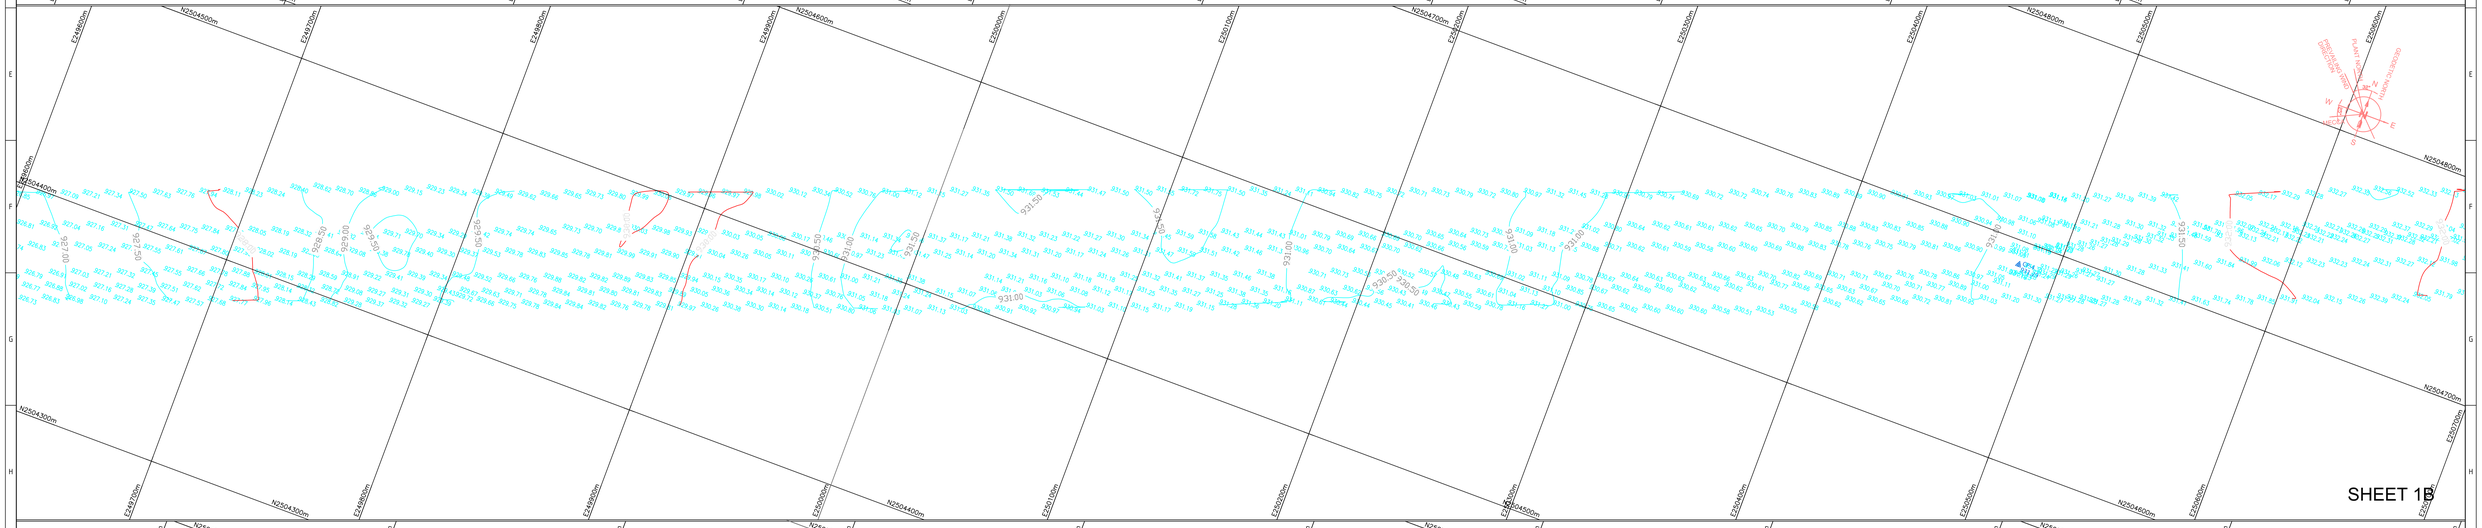

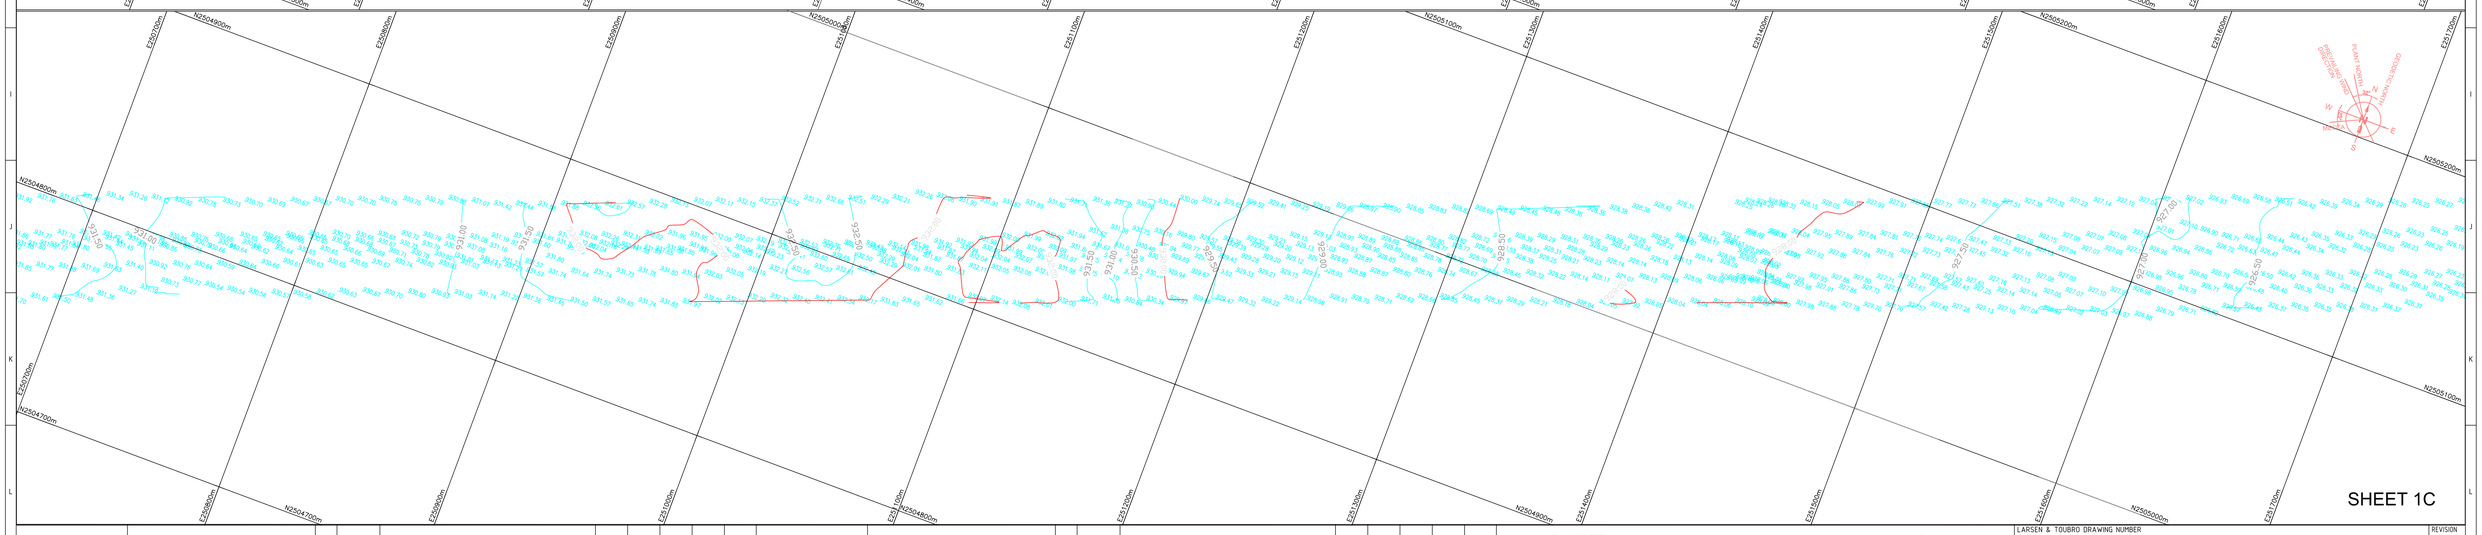

DOCUMENT NUMBER	REFERENCE DOCUMENTS	REV	DATE	REVISION DESCRIPTION	DRN	CHK	ENG	APP	EMP
D01		D01	11/10/2023	AS BUILT	C.P	MLI	M.A	SJM	
C01		C01	03/02/2021	ISSUED FOR CONSTRUCTION	C.P	MLI	M.A	SJM	
A02		A02	11/12/2020	REVISED AS PER EMPLOYER COMMENTS ON 27/01/2020	C.P	MLI	M.A	SJM	
A01		A01	07/12/2019	ISSUED FOR REFERENCE	C.P	M.A	M.A	MUHD/SJM	

AFE CONSTRUCTION

مؤسسة أشرف محمد فضل خان للمقاولات
A. M. FAZAL CONTRACTING EST.

LARSEN & TOUBRO

This drawing is the property of LARSEN & TOUBRO and must not be passed on to any person or body not authorized by us to receive it nor be copied or otherwise made use either in full or in part by such person or body without our prior permission in writing.

Outotec


The content of these documents are the sole property of Outotec Oy. Any rights not expressly granted herein are reserved. Reproduction, transfer or distribution of part or all of the contents in any form without prior written permission of Outotec is prohibited.


MA'ADEN معادن
Saudi Arabian Mining Company شركة المعادن العربية السعودية


This document and the information contained herein is Ma'aden proprietary know-how. This document or any part thereof should not be reproduced, stored in a retrieval system or transmitted by any means, electronic or otherwise, or divulged without prior written permission of Ma'aden.

LARSEN & TOUBRO DRAWING NUMBER	019045_001_T_G_24525_001		REVISION 3
OUTOTEC DRAWING NUMBER	900707 _ GAU01 _ ZZ01 _ CLA04 _ 10000	DOCUMENT ID OU100666654	REVISION 3
DRAWN	C.P	04/12/2019	MANSOURAH - MASSARAH GOLD PROJECT
CHECKED	M.A	05/12/2019	TOPOGRAPHICAL SURVEY
ENGINEER	M.A	06/12/2019	BOREWELL STN 3,4 & PERIMETER BOUNDARY FENCE
APPROVED	MUHD/SJM	07/12/2019	SURVEY DRAWING (SHEET-2 OF 19)
EMPLOYER			DRAWING NUMBER MD - 216 - 1000 - EG - CV - TPD - 1005 REV D01
SCALE	1:1	A0	

DRAWING NUMBER
MD-216/1800-EG-CV-TPD-1005
REV D01

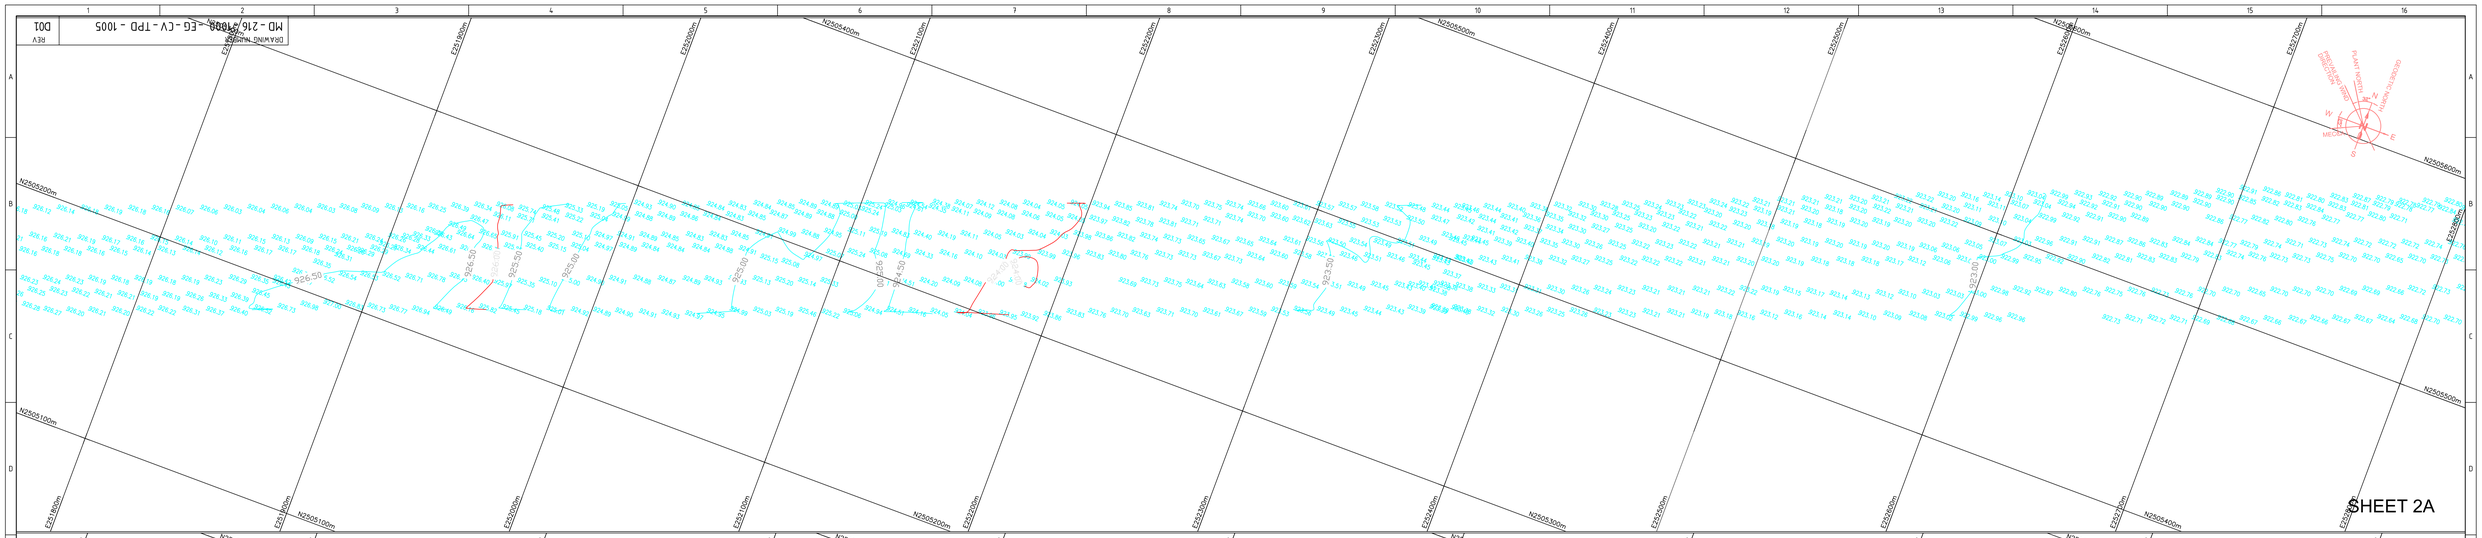

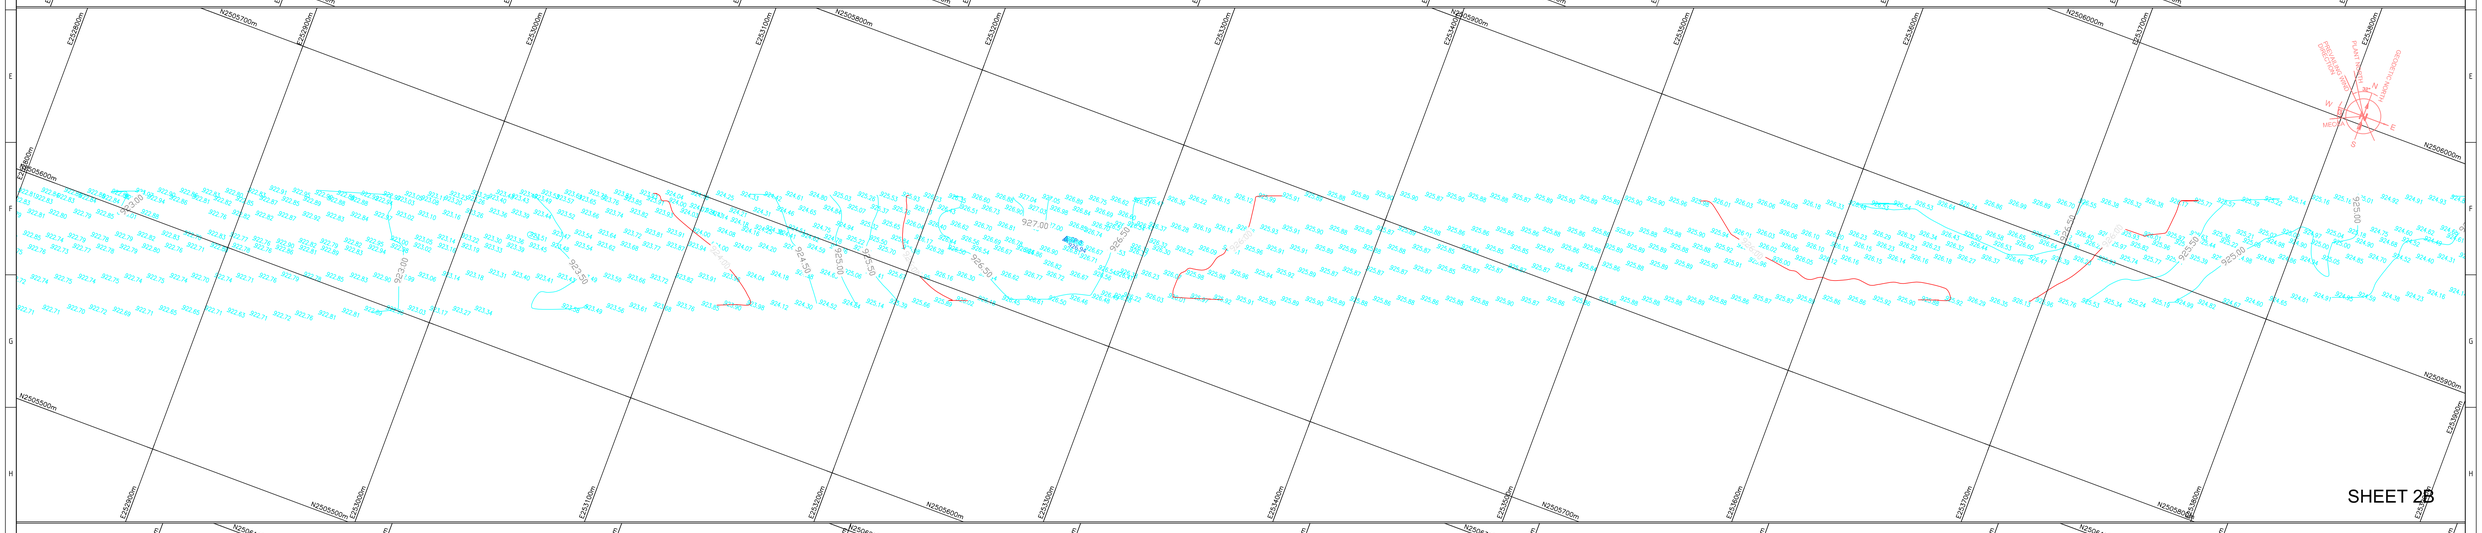

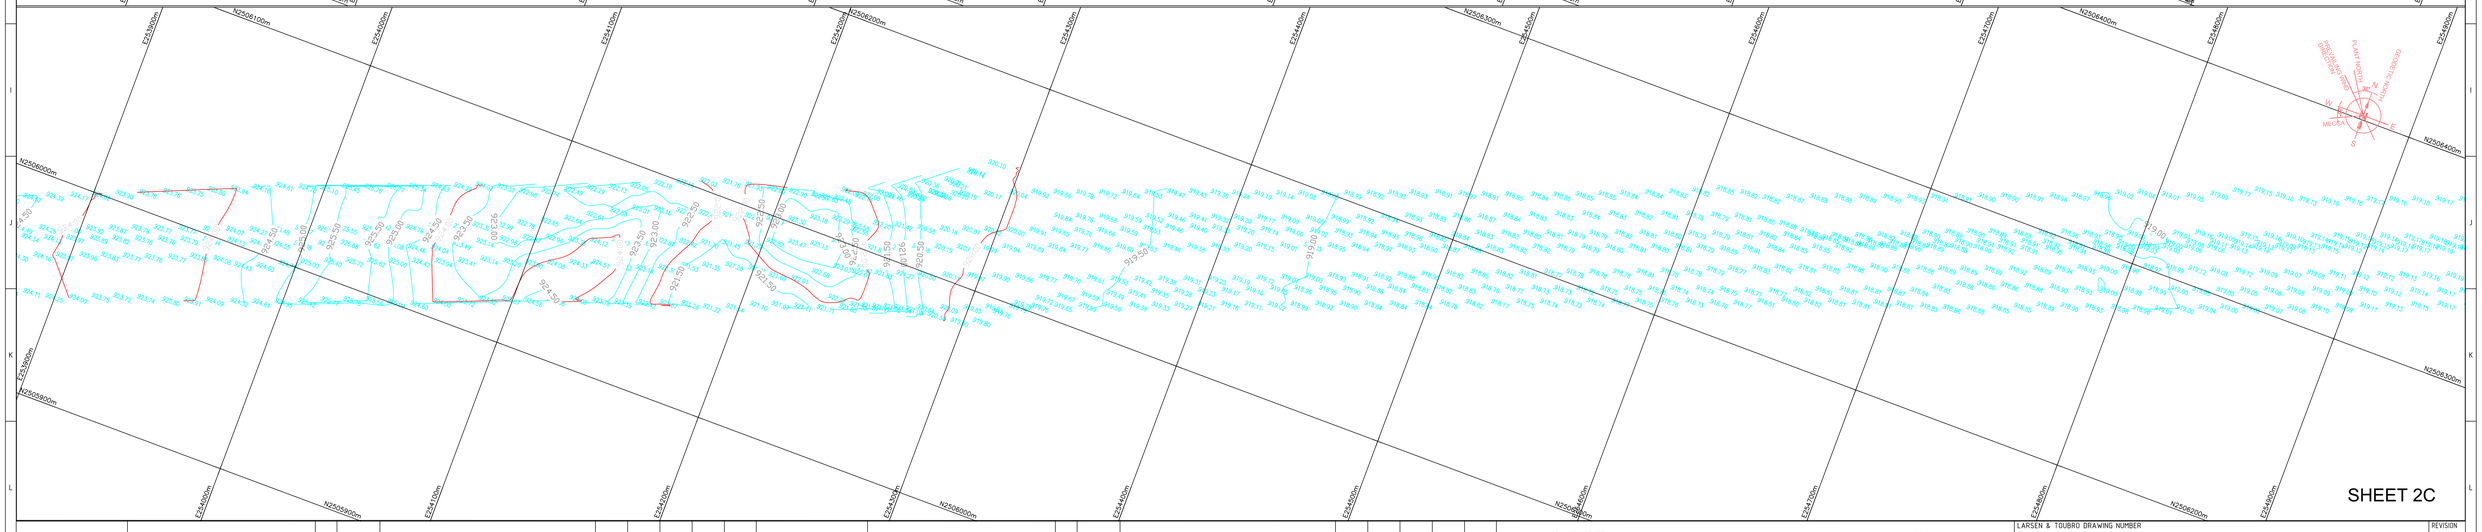

DOCUMENT NUMBER	REFERENCE DOCUMENTS	REV	DATE	REVISION DESCRIPTION	DRN	CHK	ENG	APP	EMP
D01			11/10/2023	AS BUILT	C.P	MLI	M.A	S.JM	
C01			03/02/2021	ISSUED FOR CONSTRUCTION	C.P	MLI	M.A	S.JM	
A02			11/12/2020	REVISED AS PER EMPLOYER COMMENTS ON 27/01/2020	C.P	MLI	M.A	S.JM	
A01			07/12/2019	ISSUED FOR REFERENCE	C.P	M.A	M.A	MUHD/S.JM	

AFE CONSTRUCTION

مؤسسة أشرف محمد فضل خان للمقاولات
A. M. FAZAL CONTRACTING EST.

LARSEN & TOUBRO

This drawing is the property of LARSEN & TOUBRO and must not be passed on to any person or body not authorized by us to receive it nor be copied or otherwise made use either in full or in part by such person or body without our prior permission in writing.

Outotec

The content of these documents are the sole property of Outotec Oy. Any rights not expressly granted herein are reserved. Reproduction, transfer or distribution of part or all of the contents in any form without prior written permission of Outotec is prohibited.

MA'ADEN معادن
Saudi Arabian Mining Company شركة المعادن العربية السعودية

This document and the information contained herein is Ma'aden proprietary know-how. This document or any part thereof should not be reproduced, stored in a retrieval system or transmitted by any means, electronic or otherwise, or divulged without prior written permission of Ma'aden.

LARSEN & TOUBRO DRAWING NUMBER: 019045_001_T_G_24525_001 — REVISION: 3
OUTOTEC DRAWING NUMBER: 900707__GAU01__ZZ01__CLA04__10000 — DOCUMENT ID: OU100666654 — REVISION: 3

DRAWN	C.P	04/12/2019
CHECKED	M.A	05/12/2019
ENGINEER	M.A	06/12/2019
APPROVED	MUHD/S.JM	07/12/2019
EMPLOYER		
SCALE	1:1	A0

MANSOURAH - MASSARAH GOLD PROJECT
TOPOGRAPHICAL SURVEY
BOREWELL STN 3,4 & PERIMETER BOUNDARY FENCE
SURVEY DRAWING (SHEET-3 OF 19)

DRAWING NUMBER: MD-216-1000-EG-CV-TPD-1005 — REV: D01

DRAWING NUMBER: MD-216-1000-EG-CV-TPD-1005 | REV: D01

SHEET 3A

SHEET 3B

SHEET 3C

DOCUMENT NUMBER	REFERENCE DOCUMENTS	REV	DATE	REVISION DESCRIPTION	DRN	CHK	ENG	APP	EMP
DOCUMENT NUMBER	REFERENCE DOCUMENTS	REV	DATE	REVISION DESCRIPTION	DRN	CHK	ENG	APP	EMP
		D01	11/10/2023	AS BUILT	C.P	MLI	M.A	SJM	
		C01	03/02/2021	ISSUED FOR CONSTRUCTION	C.P	MLI	M.A	S.M	
		A02	11/12/2020	REVISED AS PER EMPLOYER COMMENTS ON 27/01/2020	C.P	MLI	M.A	S.M	
		A01	07/12/2019	ISSUED FOR REFERENCE	C.P	M.A	M.A	MUHD/SJM	

AFC CONSTRUCTION

مؤسسة أشرف محمد فضل خان للمقاولات
A. M. FAZAL CONTRACTING EST.

LARSEN & TOUBRO

This drawing is the property of LARSEN & TOUBRO and must not be passed on to any person or body not authorized by us to receive it nor be copied or otherwise made use either in full or in part by such person or body without our prior permission in writing.

Outotec

The content of these documents are the sole property of Outotec Oyj. Any rights not expressly granted herein are reserved. Reproduction, transfer or distribution of part or all of the contents in any form without prior written permission of Outotec is prohibited.

MA'ADEN معادن
Saudi Arabian Mining Company شركة معادن العربية السعودية

This document and the information contained herein is Ma'aden proprietary know-how. This document or any part thereof should not be reproduced, stored in a retrieval system or transmitted by any means, electronic or otherwise, or divulged without prior written permission of Ma'aden.

LARSEN & TOUBRO DRAWING NUMBER			REVISION
019045_001_T_G_24525_001			3
OUTOTEC DRAWING NUMBER		DOCUMENT ID	REVISION
900707__GAU01__ZZ01__CLA04__10000		OU100666654	3
DRAWN	C.P	04/12/2019	MANSOURAH - MASSARAH GOLD PROJECT
CHECKED	M.A	05/12/2019	TOPOGRAPHICAL SURVEY
ENGINEER	M.A	06/12/2019	BOREWELL STN 3,4 & PERIMETER BOUNDARY FENCE
APPROVED	MUHD/SJM	07/12/2019	SURVEY DRAWING (SHEET-4 OF 19)
EMPLOYER			
SCALE 1:1	A0	DRAWING NUMBER: MD-216-1000-EG-CV-TPD-1005	REV: D01

DRAWING NUMBER: MD-216-1000-EG-CV-TPD-1005 | REV: D01

DOCUMENT NUMBER	REFERENCE DOCUMENTS	REV	DATE	REVISION DESCRIPTION	DRN	CHK	ENG	APP	EMP
D01			11/10/2023	AS BUILT	C.P	MLI	M.A	SJM	
C01			03/02/2021	ISSUED FOR CONSTRUCTION	C.P	MLI	M.A	S.M	
A02			11/12/2020	REVISED AS PER EMPLOYER COMMENTS ON 27/01/2020	C.P	MLI	M.A	S.M	
A01			07/12/2019	ISSUED FOR REFERENCE	C.P	M.A	M.A	MUHD/S.JM	

AFC CONSTRUCTION

مؤسسة أشرف محمد فضل خان للمقاولات
A. M. FAZAL CONTRACTING EST.

LARSEN & TOUBRO

This drawing is the property of LARSEN & TOUBRO and must not be passed on to any person or body not authorized by us to receive it nor be copied or otherwise made use either in full or in part by such person or body without our prior permission in writing.

Outotec

The content of these documents are the sole property of Outotec Oyj. Any rights not expressly granted herein are reserved. Reproduction, transfer or distribution of part or all of the contents in any form without prior written permission of Outotec is prohibited.

MA'ADEN معادن
Saudi Arabian Mining Company شركة معادن العربية السعودية

This document and the information contained herein is Ma'aden proprietary know-how. This document or any part thereof should not be reproduced, stored in a retrieval system or transmitted by any means, electronic or otherwise, or divulged without prior written permission of Ma'aden.

LARSEN & TOUBRO DRAWING NUMBER	019045_001_T_G_24525_001	REVISION 3
OUTOTEC DRAWING NUMBER	900707__GAU01__ZZ01__CLA04__10000	DOCUMENT ID OU100666654 / REVISION 3

DRAWN	C.P	04/12/2019
CHECKED	M.A	05/12/2019
ENGINEER	M.A	06/12/2019
APPROVED	MUHD/S.JM	07/12/2019
EMPLOYER		
SCALE	1:1	A0

MANSOURAH - MASSARAH GOLD PROJECT
TOPOGRAPHICAL SURVEY
BOREWELL STN 3,4 & PERIMETER BOUNDARY FENCE SURVEY DRAWING (SHEET-5 OF 19)

DRAWING NUMBER: MD-216-1000-EG-CV-TPD-1005 | REV: D01

DRAWING NUMBER: MD-216-1000-EG-CV-TPD-1005 D01

SHEET 5A

SHEET 5B

SHEET 5C

DOCUMENT NUMBER	REFERENCE DOCUMENTS	REV	DATE	REVISION DESCRIPTION	DRN	CHK	ENG	APP	EMP
		D01	11/10/2023	AS BUILT	C.P	MLI	M.A	SJM	
		C01	03/02/2021	ISSUED FOR CONSTRUCTION	C.P	MLI	M.A	S.M	
		A02	11/12/2020	REVISED AS PER EMPLOYER COMMENTS ON 27/01/2020	C.P	MLI	M.A	S.M	
		A01	07/12/2019	ISSUED FOR REFERENCE	C.P	M.A	M.A	MUHD/S.JM	

AFE CONSTRUCTION

مؤسسة أشرف محمد فضل خان للمقاولات
A. M. FAZAL CONTRACTING EST.

LARSEN & TOUBRO

This drawing is the property of LARSEN & TOUBRO and must not be passed on to any person or body not authorised by us to receive it nor be copied or otherwise made use either in full or in part by such person or body without our prior permission in writing.

Outotec

The content of these documents are the sole property of Outotec Oyj. Any rights not expressly granted herein are reserved. Reproduction, transfer or distribution of part or all of the contents in any form without prior written permission of Outotec is prohibited.

MA'ADEN معادن
Saudi Arabian Mining Company شركة المعادن العربية السعودية

This document and the information contained herein is Ma'aden proprietary know-how. This document or any part thereof should not be reproduced, stored in a retrieval system or transmitted by any means, electronic or otherwise, or divulged without prior written permission of Ma'aden.

LARSEN & TOUBRO DRAWING NUMBER		REVISION
019045_001_T_G_24525_001		3
OUTOTEC DRAWING NUMBER	DOCUMENT ID	REVISION
900707 _ GAU01 _ ZZ01 _ CLA04 _ 10000	OU100666654	3

DRAWN	C.P	04/12/2019
CHECKED	M.A	05/12/2019
ENGINEER	M.A	06/12/2019
APPROVED	MUHD/S.JM	07/12/2019
EMPLOYER		
SCALE 1:1	A0	

MANSOURAH - MASSARAH GOLD PROJECT
TOPOGRAPHICAL SURVEY
BOREWELL STN 3,4 & PERIMETER BOUNDARY FENCE
SURVEY DRAWING (SHEET-6 OF 19)

DRAWING NUMBER: MD-216-1000-EG-CV-TPD-1005 REV: D01

DRAWING NUMBER: MD - 216 - 1000 - EG - CV - TPD - 1005 | REV: D01

SHEET 6A

SHEET 6B

SHEET 6C

DOCUMENT NUMBER	REFERENCE DOCUMENTS	REV	DATE	REVISION DESCRIPTION	DRN	CHK	ENG	APP	EMP
D01			11/10/2023	AS BUILT	C.P	MLI	M.A	SJM	
C01			03/02/2021	ISSUED FOR CONSTRUCTION	C.P	MLI	M.A	S.M	
A02			11/12/2020	REVISED AS PER EMPLOYER COMMENTS ON 23/01/2020	C.P	MLI	M.A	S.M	
A01			07/12/2019	ISSUED FOR REFERENCE	C.P	M.A	M.A	MUHD/S.JM	

AFE CONSTRUCTION

مؤسسة أشرف محمد فضل خان للمقاولات
A. M. FAZAL CONTRACTING EST.

LARSEN & TOUBRO

Outotec

MA'ADEN معادن
Saudi Arabian Mining Company شركة المعادن العربية السعودية


This drawing is the property of LARSEN & TOUBRO and must not be passed on to any person or body not authorized by us to receive it nor be copied or otherwise made use either in full or in part by such person or body without our prior permission in writing.


The content of these documents are the sole property of Outotec Oyj. Any rights not expressly granted herein are reserved. Reproduction, transfer or distribution of part or all of the contents in any form without prior written permission of Outotec is prohibited.


This document and the information contained herein is Ma'aden proprietary know-how. This document or any part thereof should not be reproduced, stored in a retrieval system or transmitted by any means, electronic or otherwise, or divulged without prior written permission of Ma'aden.

LARSEN & TOUBRO DRAWING NUMBER			REVISION
019045_001_T_G_24525_001			3
OUTOTEC DRAWING NUMBER		DOCUMENT ID	REVISION
900707 _ GAU01 _ ZZ01 _ CLA04 _ 10000		OU100666654	3
DRAWN	C.P	04/12/2019	MANSOURAH - MASSARAH GOLD PROJECT
CHECKED	M.A	05/12/2019	TOPOGRAPHICAL SURVEY
ENGINEER	M.A	06/12/2019	BOREWELL STN 3,4 & PERIMETER BOUNDARY FENCE
APPROVED	MUHD/S.JM	07/12/2019	SURVEY DRAWING (SHEET-7 OF 19)
EMPLOYER			DRAWING NUMBER / REV
SCALE 1:1	A0		MD - 216 - 1000 - EG - CV - TPD - 1005 / D01

DRAWING NUMBER: MD - 216 - 1000 - EG - CV - TPD - 1005 | REV: D01

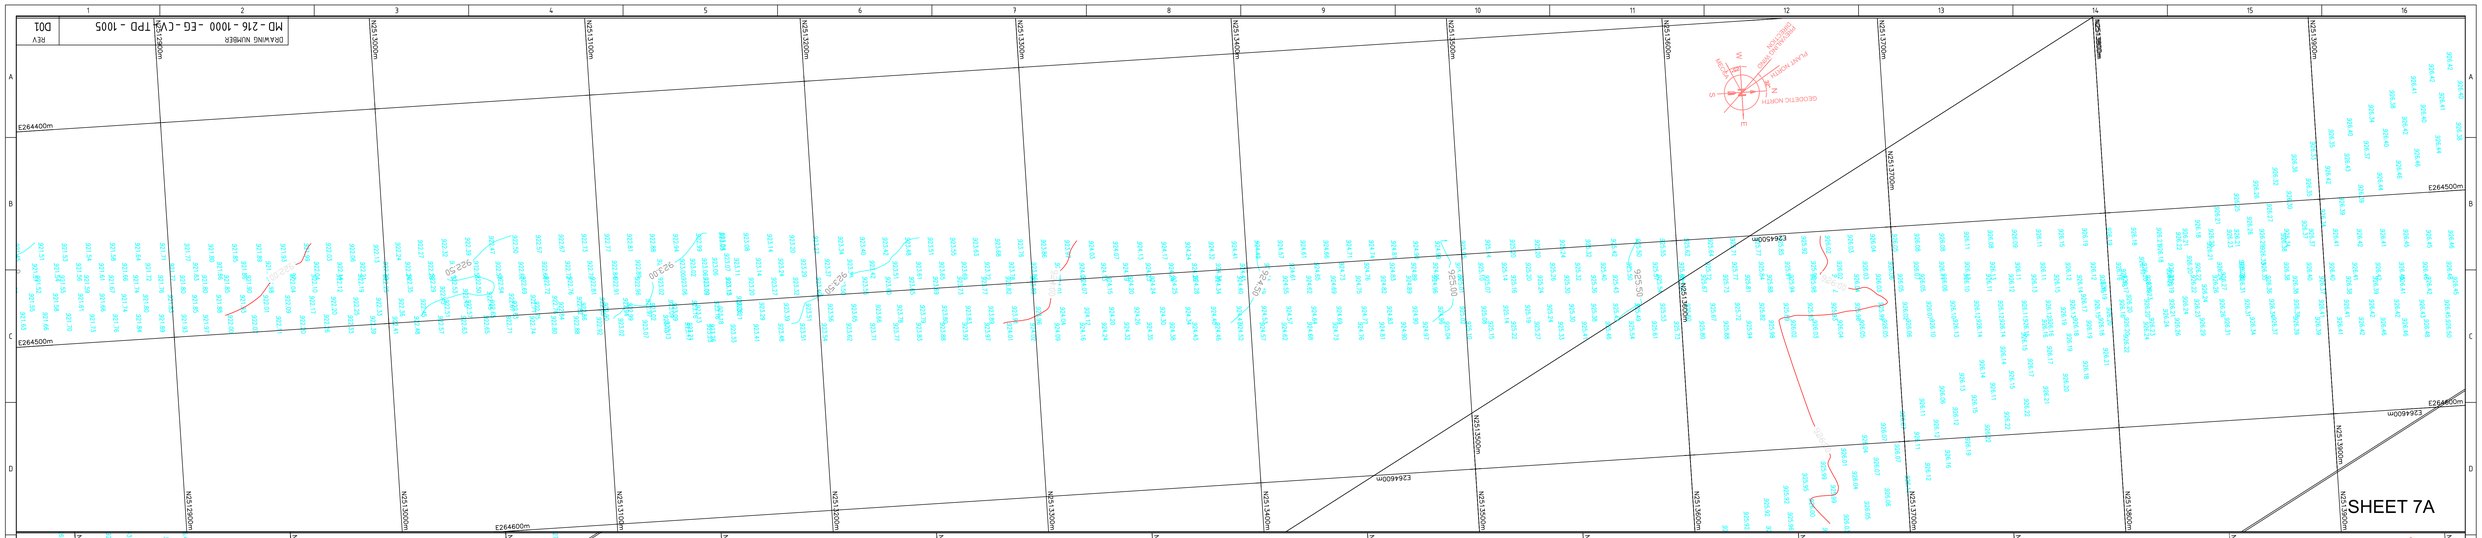

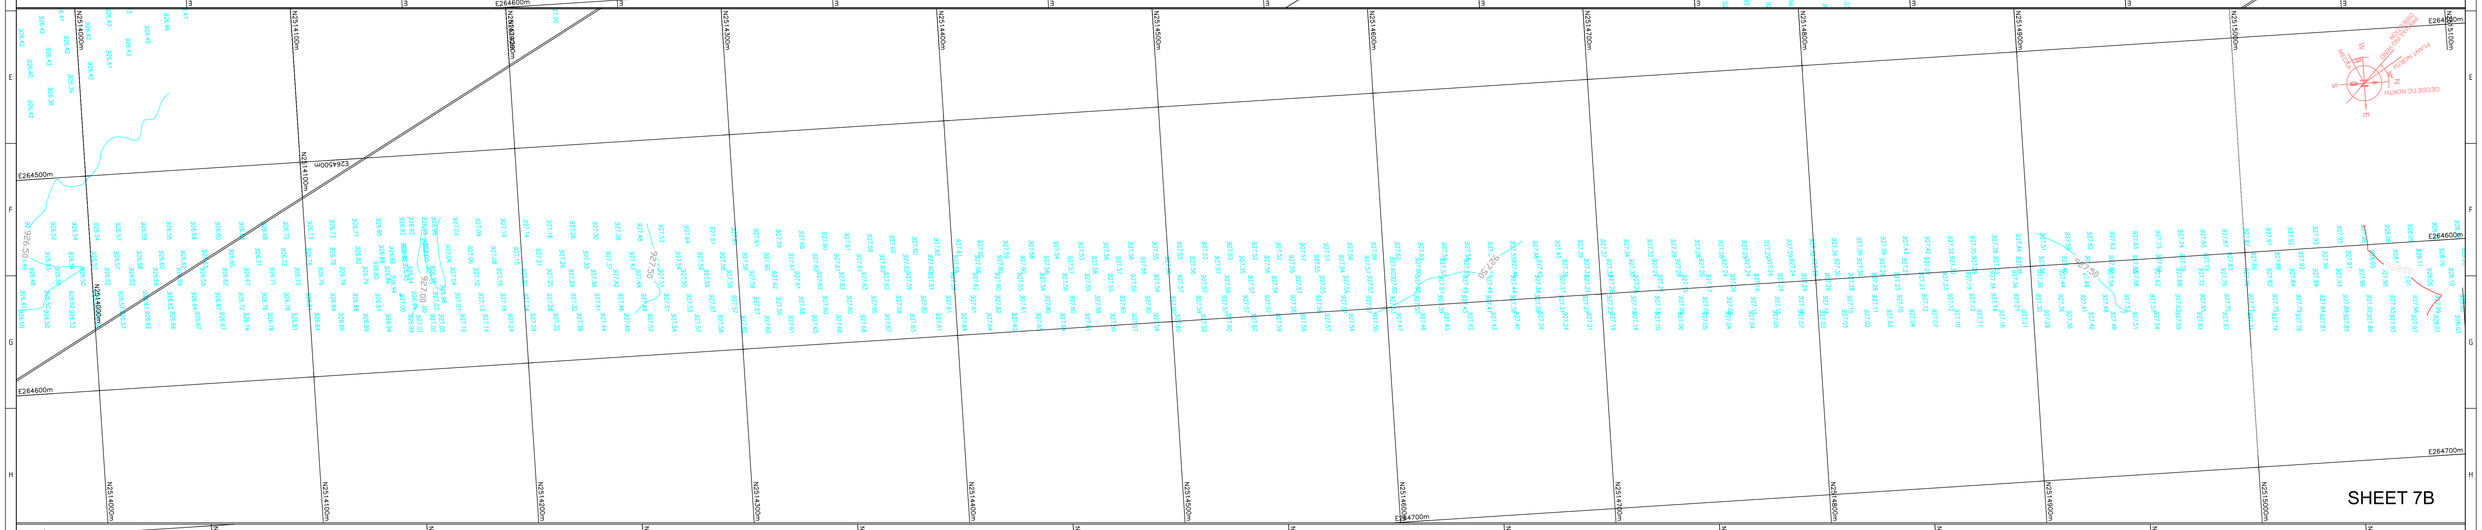

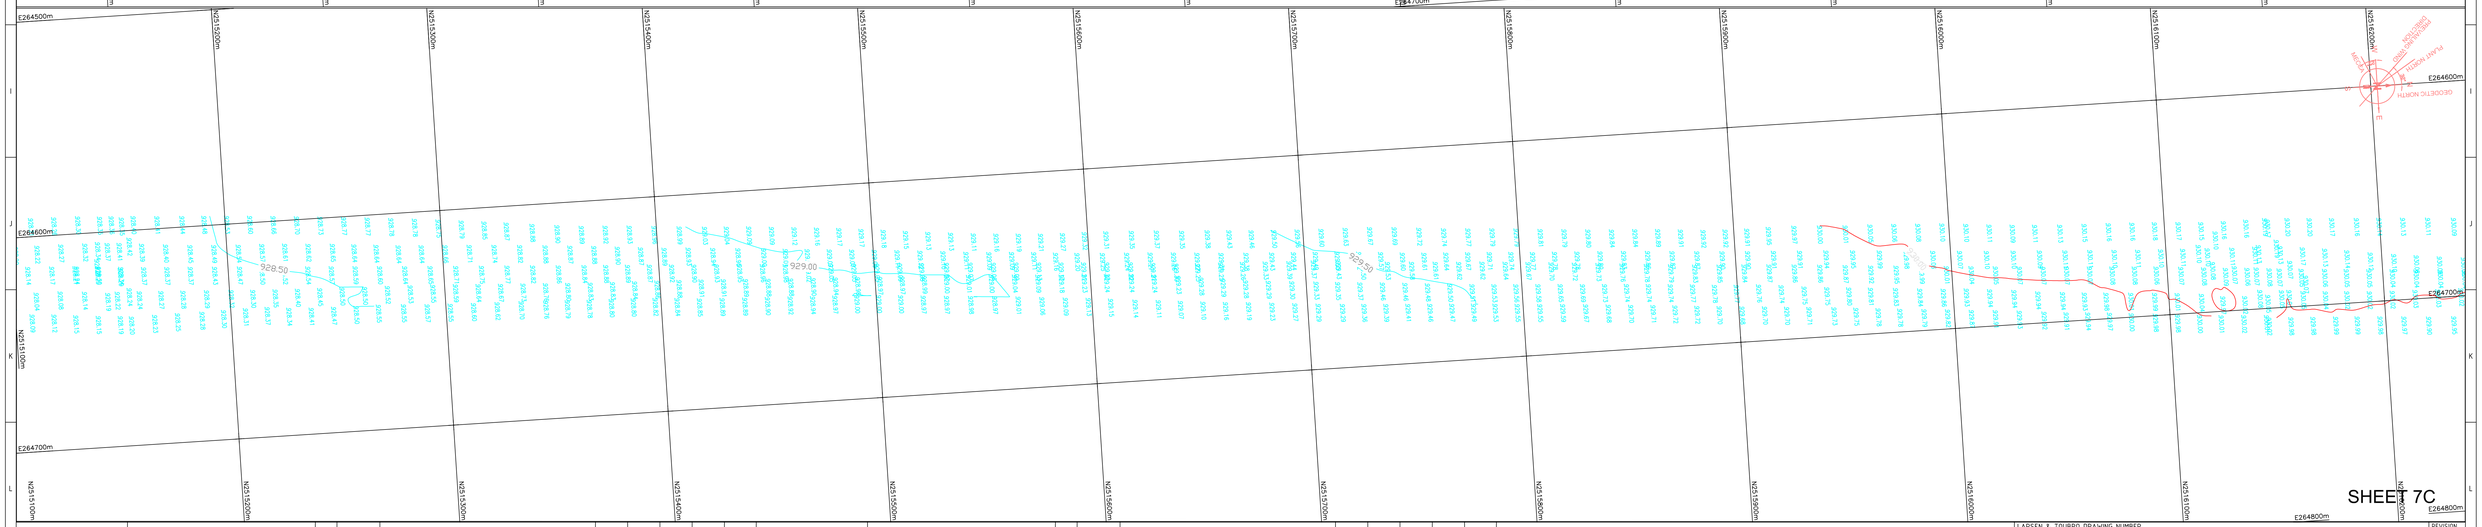

DOCUMENT NUMBER	REFERENCE DOCUMENTS	REV	DATE	REVISION DESCRIPTION	DRN	CHK	ENG	APP	EMP
D01			11/10/2023	AS BUILT	C.P	MLI	M.A	SJM	
C01			03/02/2021	ISSUED FOR CONSTRUCTION	C.P	MLI	M.A	S.M	
A02			11/12/2020	REVISED AS PER EMPLOYER COMMENTS ON 27/01/2020	C.P	MLI	M.A	S.M	
A01			07/12/2019	ISSUED FOR REFERENCE	C.P	M.A	M.A	MUHD/S.JM	

AFC CONSTRUCTION

مؤسسة أشرف محمد فضل خان للمقاولات
A. M. FAZAL CONTRACTING EST.

LARSEN & TOUBRO

This drawing is the property of LARSEN & TOUBRO and must not be passed on to any person or body not authorized by us to receive it nor be copied or otherwise made use either in full or in part by such person or body without our prior permission in writing.

Outotec

The content of these documents are the sole property of Outotec Oyj. Any rights not expressly granted herein are reserved. Reproduction, transfer or distribution of part or all of the contents in any form without prior written permission of Outotec is prohibited.

MA'ADEN معادن
Saudi Arabian Mining Company شركة معادن العربية السعودية

This document and the information contained herein is Ma'aden proprietary know-how. This document or any part thereof should not be reproduced, stored in a retrieval system or transmitted by any means, electronic or otherwise, or divulged without prior written permission of Ma'aden.


LARSEN & TOUBRO DRAWING NUMBER: 019045_001_T_G_24525_001 | REVISION: 3
OUTOTEC DRAWING NUMBER: 900707 __ GAU01 __ ZZ01 __ CLA04 __ 10000 | DOCUMENT ID: OU100666654 | REVISION: 3


DRAWN	C.P	04/12/2019
CHECKED	M.A	05/12/2019
ENGINEER	M.A	06/12/2019
APPROVED	MUHD/S.JM	07/12/2019
EMPLOYER		
SCALE	1:1	A0


MANSOURAH - MASSARAH GOLD PROJECT
TOPOGRAPHICAL SURVEY
BOREWELL STN 3,4 & PERIMETER BOUNDARY FENCE SURVEY DRAWING (SHEET-8 OF 19)

DRAWING NUMBER: MD - 216 - 1000 - EG - CV - TPD - 1005 | REV: D01

DRAWING NUMBER
MD - 216 - 1000 - EG - CV - TPD - 1005
REV
D01

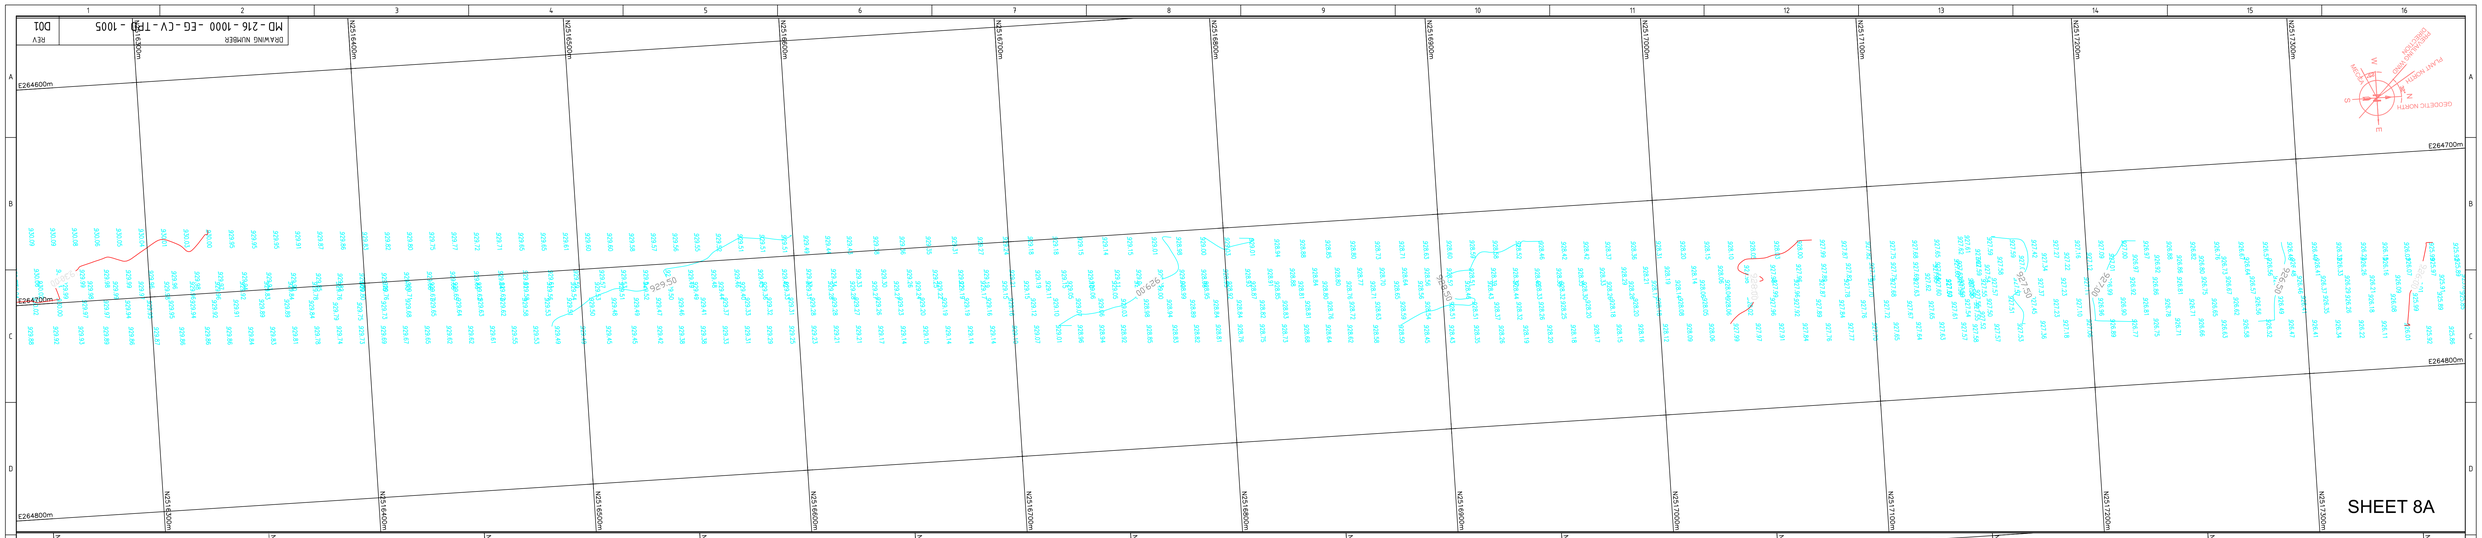

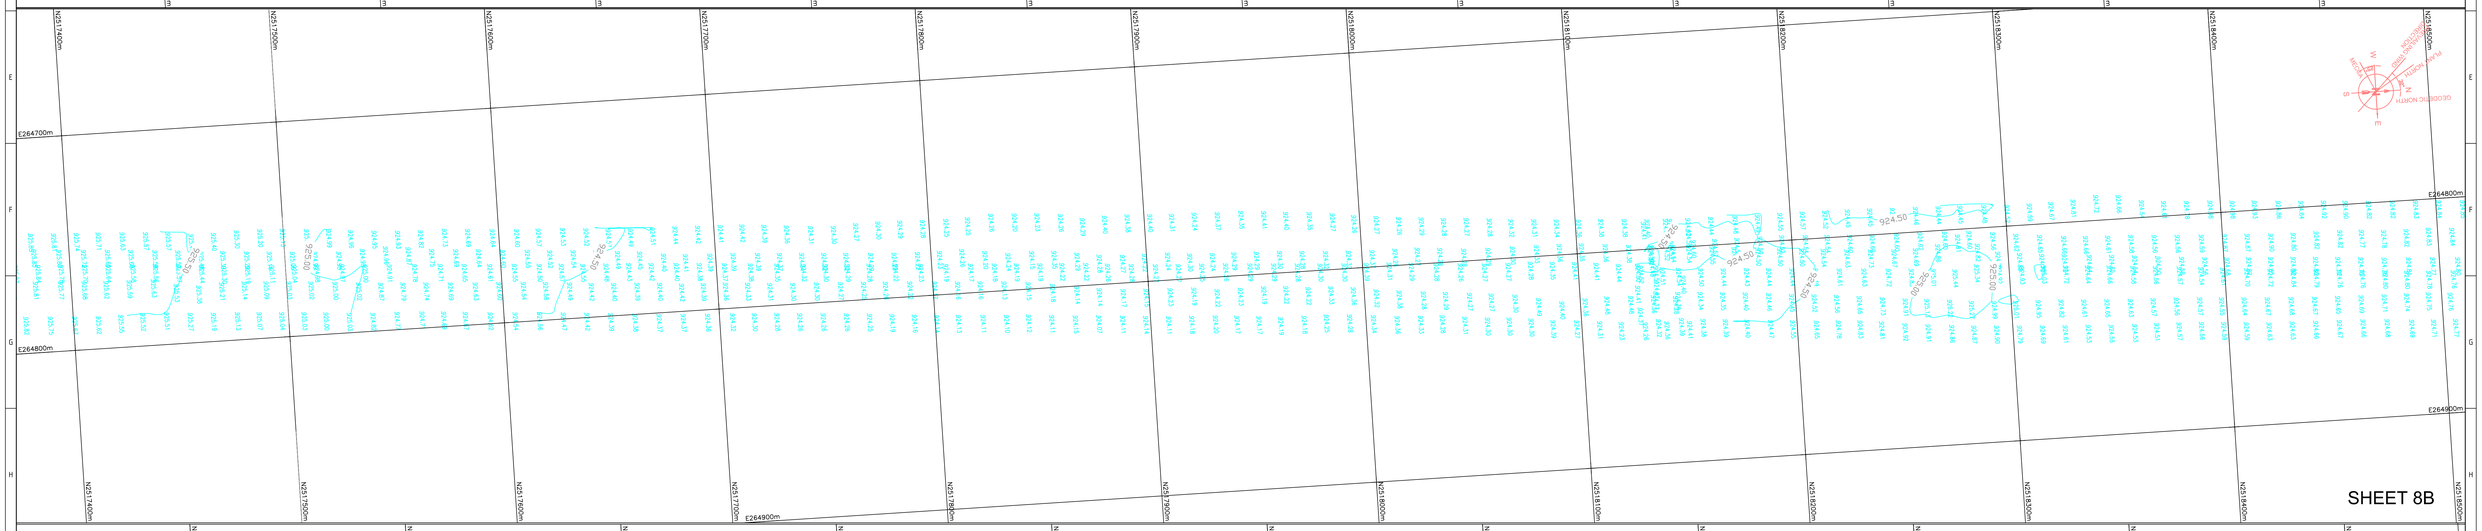

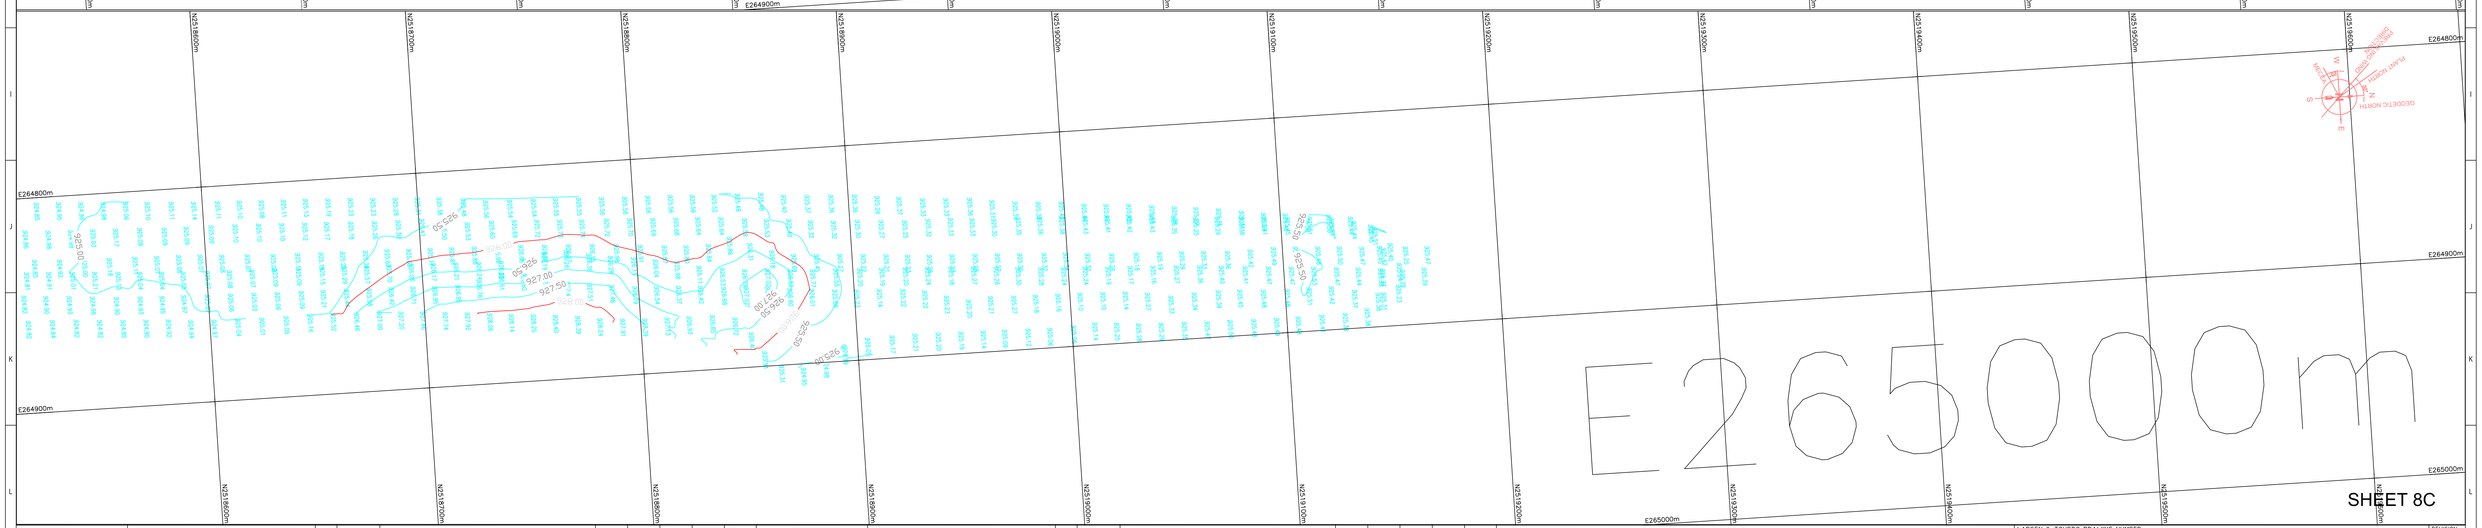

DOCUMENT NUMBER	REFERENCE DOCUMENTS	REV	DATE	REVISION DESCRIPTION	DRN	CHK	ENG	APP	EMP
		D01	11/10/2023	AS BUILT	C.P	MLI	M.A	SJM	
		C01	03/02/2021	ISSUED FOR CONSTRUCTION	C.P	MLI	M.A	S.M	
		A02	11/12/2020	REVISED AS PER EMPLOYER COMMENTS ON 27/01/2020	C.P	MLI	M.A	S.M	
		A01	07/12/2019	ISSUED FOR REFERENCE	C.P	M.A	M.A	MUHD/SJM	

This drawing is the property of LARSEN & TOUBRO and must not be passed on to any person or body not authorised by us to receive it nor be copied or otherwise made use either in full or in part by such person or body without our prior permission in writing.

The content of these documents are the sole property of Outotec Oy. Any rights not expressly granted herein are reserved. Reproduction, transfer or distribution of part or all of the contents in any form without prior written permission of Outotec is prohibited.

This document and the information contained herein is Ma'aden proprietary know-how. This document or any part thereof should not be reproduced, stored in a retrieval system or transmitted by any means, electronic or otherwise, or divulged without prior written permission of Ma'aden.

AFE CONSTRUCTION

مؤسسة أشرف محمد فضل خان للمقاولات
A. M. FAZAL CONTRACTING EST.

LARSEN & TOUBRO

Outotec

MA'ADEN معادن
Saudi Arabian Mining Company شركة معادن العربية السعودية

LARSEN & TOUBRO DRAWING NUMBER: 019045_001_T_G_24525_001 — REVISION: 3
OUTOTEC DRAWING NUMBER: 900707__GAU01__ZZ01__CLA04__10000 — DOCUMENT ID: OU100666654 — REVISION: 3

DRAWN	C.P	04/12/2019
CHECKED	M.A	05/12/2019
ENGINEER	M.A	06/12/2019
APPROVED	MUHD/SJM	07/12/2019
EMPLOYER		
SCALE	1:1	A0

MANSOURAH - MASSARAH GOLD PROJECT
TOPOGRAPHICAL SURVEY
BOREWELL STN 3,4 & PERIMETER BOUNDARY FENCE SURVEY DRAWING (SHEET-9 OF 19)

DRAWING NUMBER: MD - 216 - 1000 - EG - CV - TPD - 1005 — REV: D01

DOCUMENT NUMBER	REFERENCE DOCUMENTS	REV	DATE	REVISION DESCRIPTION	DRN	CHK	ENG	APP	EMP
D01			11/10/2023	AS BUILT	C.P	MLI	M.A	SJM	
C01			03/02/2021	ISSUED FOR CONSTRUCTION	C.P	MLI	M.A	S.M	
A02			11/12/2020	REVISED AS PER EMPLOYER COMMENTS ON 27/01/2020	C.P	MLI	M.A	S.M	
A01			07/12/2019	ISSUED FOR REFERENCE	C.P	M.A	M.A	MUHD/S.JM	

AFC CONSTRUCTION

مؤسسة أشرف محمد فضل خان للمقاولات
A. M. FAZAL CONTRACTING EST.

LARSEN & TOUBRO

This drawing is the property of LARSEN & TOUBRO and must not be passed on to any person or body not authorized by us to receive it nor be copied or otherwise made use either in full or in part by such person or body without our prior permission in writing.

Outotec


The content of these documents are the sole property of Outotec Oyj. Any rights not expressly granted herein are reserved. Reproduction, transfer or distribution of part or all of the contents in any form without prior written permission of Outotec is prohibited.


MA'ADEN معادن
Saudi Arabian Mining Company شركة معادن العربية السعودية


This document and the information contained herein is Ma'aden proprietary know-how. This document or any part thereof should not be reproduced, stored in a retrieval system or transmitted by any means, electronic or otherwise, or divulged without prior written permission of Ma'aden.

LARSEN & TOUBRO DRAWING NUMBER			REVISION
019045_001_T_G_24525_001			3
OUTOTEC DRAWING NUMBER		DOCUMENT ID	REVISION
900707 __ GAU01 __ ZZ01 __ CLA04 __ 10000		OU100666654	3
DRAWN	C.P	04/12/2019	MANSOURAH - MASSARAH GOLD PROJECT
CHECKED	M.A	05/12/2019	TOPOGRAPHICAL SURVEY
ENGINEER	M.A	06/12/2019	BOREWELL STN 3,4 & PERIMETER BOUNDARY FENCE
APPROVED	MUHD/S.JM	07/12/2019	SURVEY DRAWING (SHEET-10 OF 19)
EMPLOYER			
SCALE 1:1	A0	DRAWING NUMBER MD - 216 - 1000 - EG - CV - TPD - 1005	REV D01

DRAWING NUMBER: MD - 216 - 1000 - EG - CV - TPD - 1005 | REV: D01

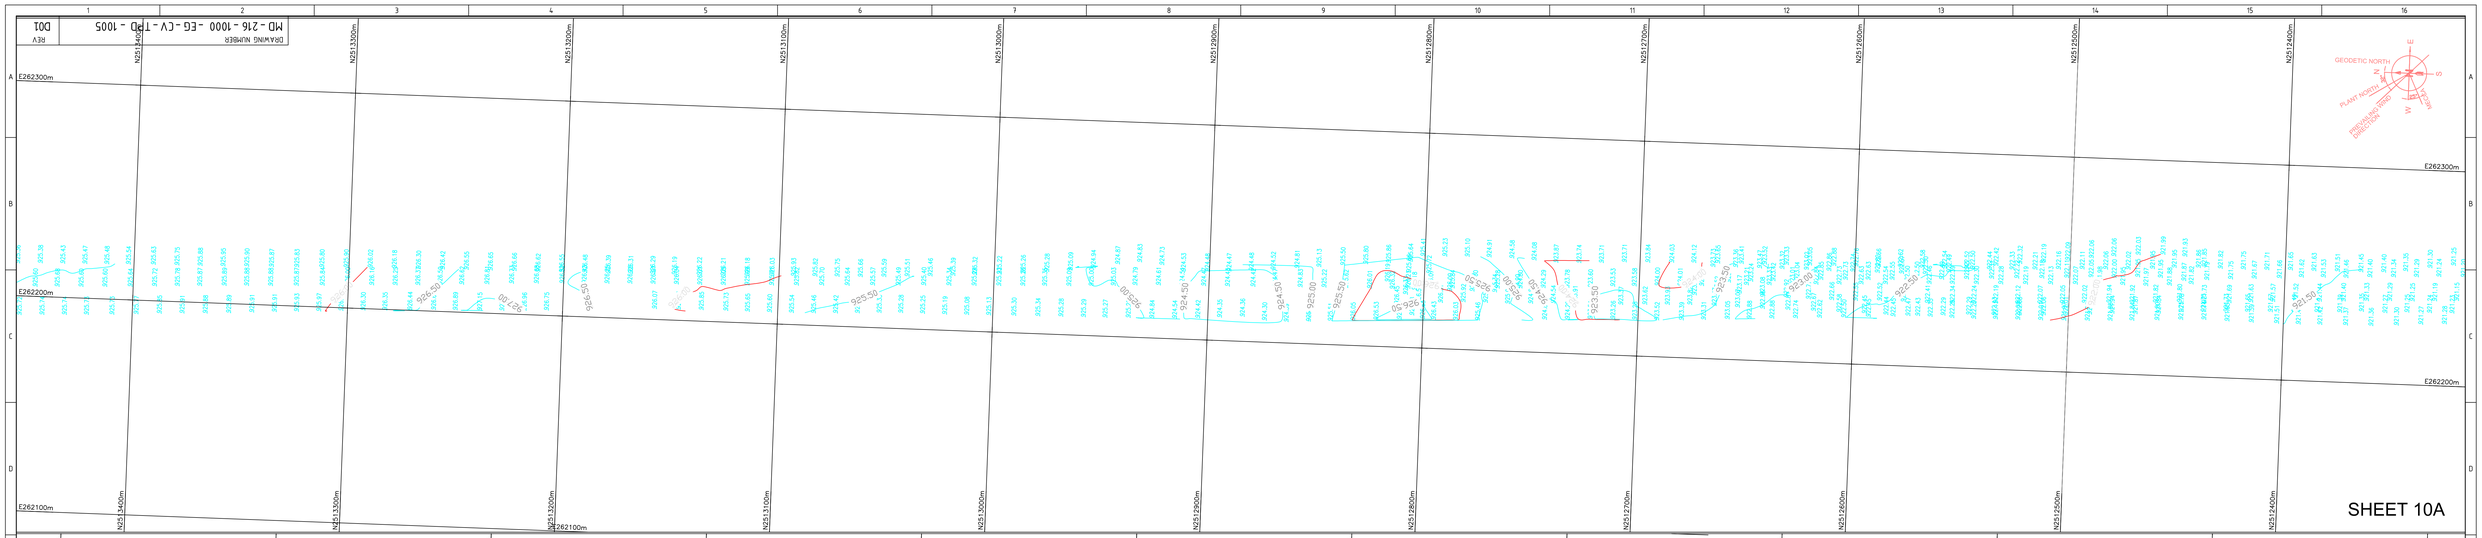

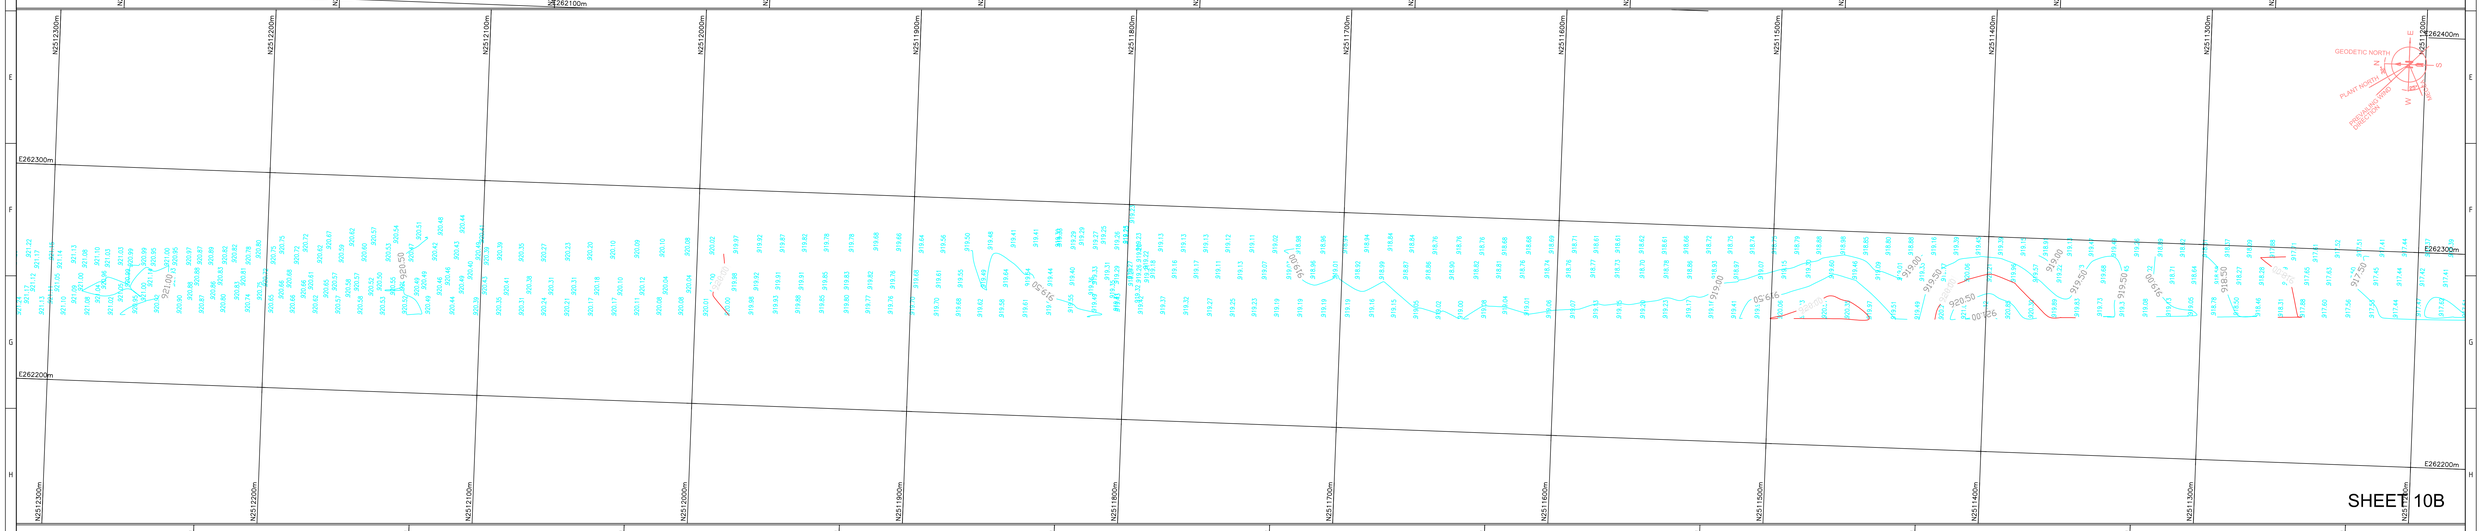

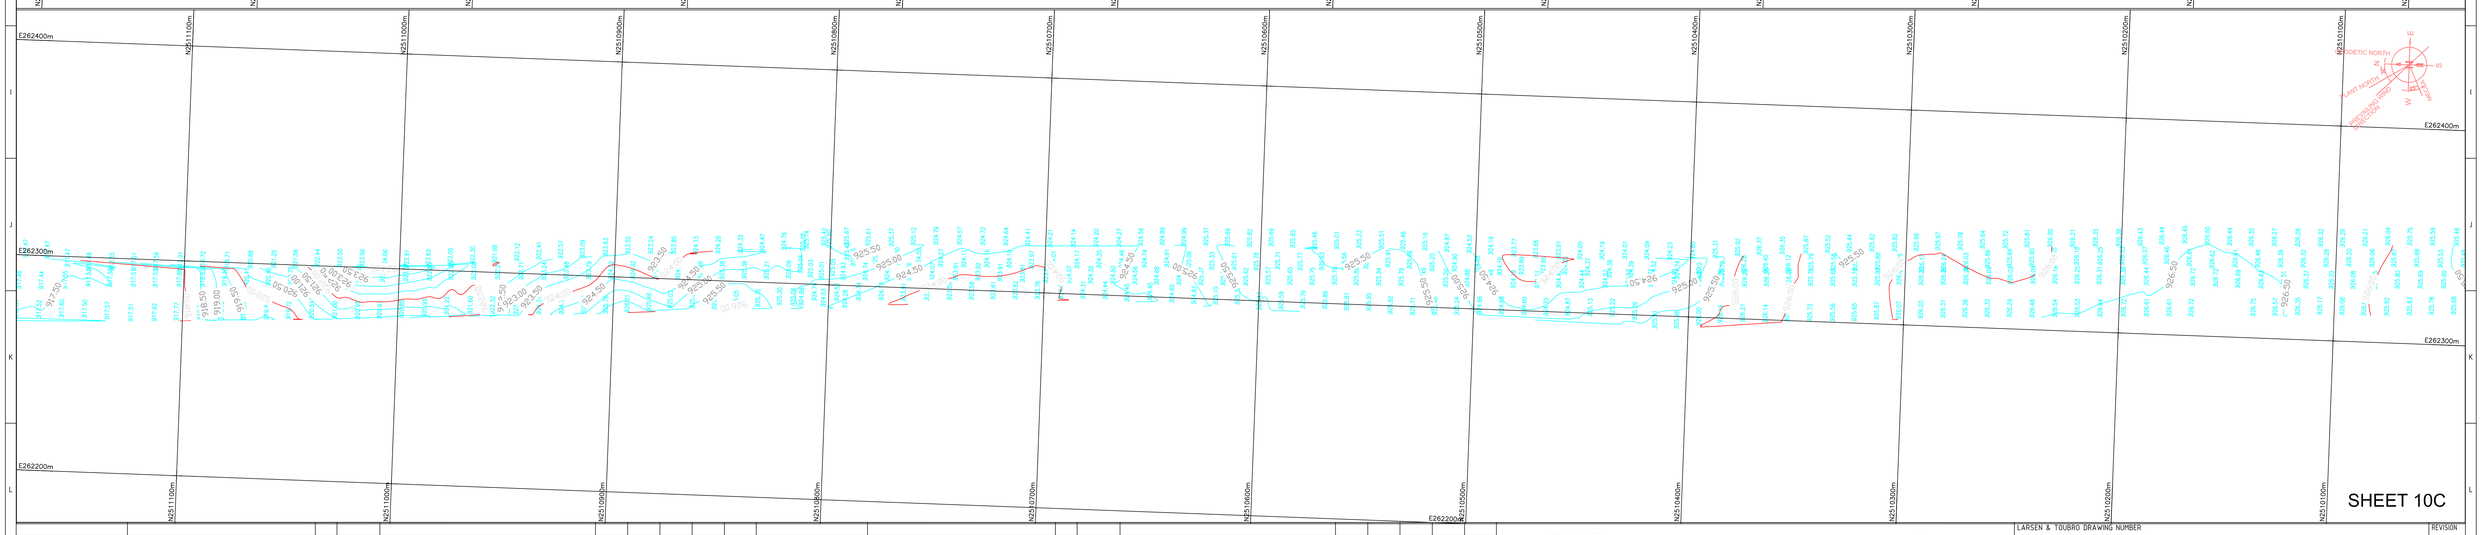

REV	DATE	REVISION DESCRIPTION	DRN	CHK	ENG	APP	EMP
D01	11/10/2023	AS BUILT	C.P	MLI	M.A	S.M	
C01	03/02/2021	ISSUED FOR CONSTRUCTION	C.P	MLI	M.A	S.M	
A02	11/12/2020	REVISED AS PER EMPLOYER COMMENTS ON 27/01/2020	C.P	MLI	M.A	S.M	
A01	07/12/2019	ISSUED FOR REFERENCE	C.P	M.A	M.A	MUHD/S.M	

DOCUMENT NUMBER | REFERENCE DOCUMENTS

AFE CONSTRUCTION

مؤسسة أشرف محمد فضل خان للمقاولات
A. M. FAZAL CONTRACTING EST.

LARSEN & TOUBRO

This drawing is the property of LARSEN & TOUBRO and must not be passed on to any person or body not authorized by us to receive it nor be copied or otherwise made use either in full or in part by such person or body without our prior permission in writing.

Outotec

The content of these documents are the sole property of Outotec Oyj. Any rights not expressly granted herein are reserved. Reproduction, transfer or distribution of part or all of the contents in any form without prior written permission of Outotec is prohibited.

MA'ADEN معادن
Saudi Arabian Mining Company شركة المعادن العربية السعودية

This document and the information contained herein is Ma'aden proprietary know-how. This document or any part thereof should not be reproduced, stored in a retrieval system or transmitted by any means, electronic or otherwise, or divulged without prior written permission of Ma'aden.

LARSEN & TOUBRO DRAWING NUMBER	019045_001_T_G_24525_001		REVISION 3
OUTOTEC DRAWING NUMBER	900707__GAU01__ZZ01__CLA04__10000	DOCUMENT ID OU100666654	REVISION 3
DRAWN	C.P	04/12/2019	MANSOURAH - MASSARAH GOLD PROJECT
CHECKED	M.A	05/12/2019	TOPOGRAPHICAL SURVEY
ENGINEER	M.A	06/12/2019	BOREWELL STN 3,4 & PERIMETER BOUNDARY FENCE
APPROVED	MUHD/S.JM	07/12/2019	SURVEY DRAWING (SHEET-11 OF 19)
EMPLOYER			DRAWING NUMBER: MD - 216 - 1000 - EG - CV - TPD - 1005 REV: D01
SCALE	1:1	A0	

DRAWING NUMBER
MD-216-1000-EG-CV-TPD-1005
REV

SHEET 11A

SHEET 11B

SHEET 11C

DOCUMENT NUMBER	REFERENCE DOCUMENTS	REV	DATE	REVISION DESCRIPTION	DRN	CHK	ENG	APP	EMP
		C01	03/02/2021	ISSUED FOR CONSTRUCTION	C.P	MLI	M.A	S.M	
		A02	11/12/2020	REVISED AS PER EMPLOYER COMMENTS ON 27/01/2020	C.P	MLI	M.A	S.M	
		A01	07/12/2019	ISSUED FOR REFERENCE	C.P	M.A	M.A	MUHD/SJM	

AFE CONSTRUCTION

مؤسسة أشرف محمد فضل خان للمقاولات
A. M. FAZAL CONTRACTING EST.

LARSEN & TOUBRO

This drawing is the property of LARSEN & TOUBRO and must not be passed on to any person or body not authorized by us to receive it nor be copied or otherwise made use either in full or in part by such person or body without our prior permission in writing.

Outotec

The content of these documents are the sole property of Outotec Oy. Any rights not expressly granted herein are reserved. Reproduction, transfer or distribution of part or all of the contents in any form without prior written permission of Outotec is prohibited.

MA'ADEN معادن
Saudi Arabian Mining Company شركة المعادن العربية السعودية

This document and the information contained herein is Ma'aden proprietary know-how. This document or any part thereof should not be reproduced, stored in a retrieval system or transmitted by any means, electronic or otherwise, or divulged without prior written permission of Ma'aden.

LARSEN & TOUBRO DRAWING NUMBER			REVISION
019045_001_T_G_24525_001			2
OUTOTEC DRAWING NUMBER		DOCUMENT ID	REVISION
900707__GAU01__ZZ01__CLA04__10000		OU100666654	2
DRAWN	C.P	04/12/2019	MANSOURAH - MASSARAH GOLD PROJECT
CHECKED	M.A	05/12/2019	TOPOGRAPHICAL SURVEY
ENGINEER	M.A	06/12/2019	BOREWELL STN 3,4 & PERIMETER BOUNDARY FENCE
APPROVED	MUHD/SJM	07/12/2019	SURVEY DRAWING (SHEET-12 OF 19)
EMPLOYER			
SCALE 1:1	A0	DRAWING NUMBER MD-216-1000-EG-CV-TPD-1005	REV C01

DRAWING NUMBER
MD - 216 - 1000 - EG - CV - TPD - 1005
D01

DOCUMENT NUMBER	REFERENCE DOCUMENTS	REV	DATE	REVISION DESCRIPTION	DRN	CHK	ENG	APP	EMP
D01			11/10/2023	AS BUILT	C.P	MLI	M.A	SJM	
C01			03/02/2021	ISSUED FOR CONSTRUCTION	C.P	MLI	M.A	SJM	
A02			11/12/2020	REVISED AS PER EMPLOYER COMMENTS ON 27/01/2020	C.P	MLI	M.A	SJM	
A01			07/12/2019	ISSUED FOR REFERENCE	C.P	M.A	M.A	MUHD/SJM	

AFE CONSTRUCTION

مؤسسة أشرف محمد فضل خان للمقاولات
A. M. FAZAL CONTRACTING EST.

LARSEN & TOUBRO

This drawing is the property of LARSEN & TOUBRO and must not be passed on to any person or body not authorised by us to receive it nor be copied or otherwise made use either in full or in part by such person or body without our prior permission in writing.

Outotec


The content of these documents are the sole property of Outotec Oy. Any rights not expressly granted herein are reserved. Reproduction, transfer or distribution of part or all of the contents in any form without prior written permission of Outotec is prohibited.


MA'ADEN معادن
Saudi Arabian Mining Company شركة معادن العربية السعودية


This document and the information contained herein is Ma'aden proprietary know-how. This document or any part thereof should not be reproduced, stored in a retrieval system or transmitted by any means, electronic or otherwise, or divulged without prior written permission of Ma'aden.

LARSEN & TOUBRO DRAWING NUMBER			REVISION
019045_001_T_G_24525_001			3
OUTOTEC DRAWING NUMBER		DOCUMENT ID	REVISION
900707__GAU01__ZZ01__CLA04__10000		OU100666654	3
DRAWN	C.P	04/12/2019	MANSOURAH - MASSARAH GOLD PROJECT
CHECKED	M.A	05/12/2019	TOPOGRAPHICAL SURVEY
ENGINEER	M.A	06/12/2019	BOREWELL STN 3,4 & PERIMETER BOUNDARY FENCE
APPROVED	MUHD/SJM	07/12/2019	SURVEY DRAWING (SHEET-13 OF 19)
EMPLOYER			DRAWING NUMBER / REV
SCALE 1:1	A0		MD - 216 - 1000 - EG - CV - TPD - 1005 / D01

DRAWING NUMBER
MD - 216 - 1000 - EG - CV - TPD - 1005
REV
D01

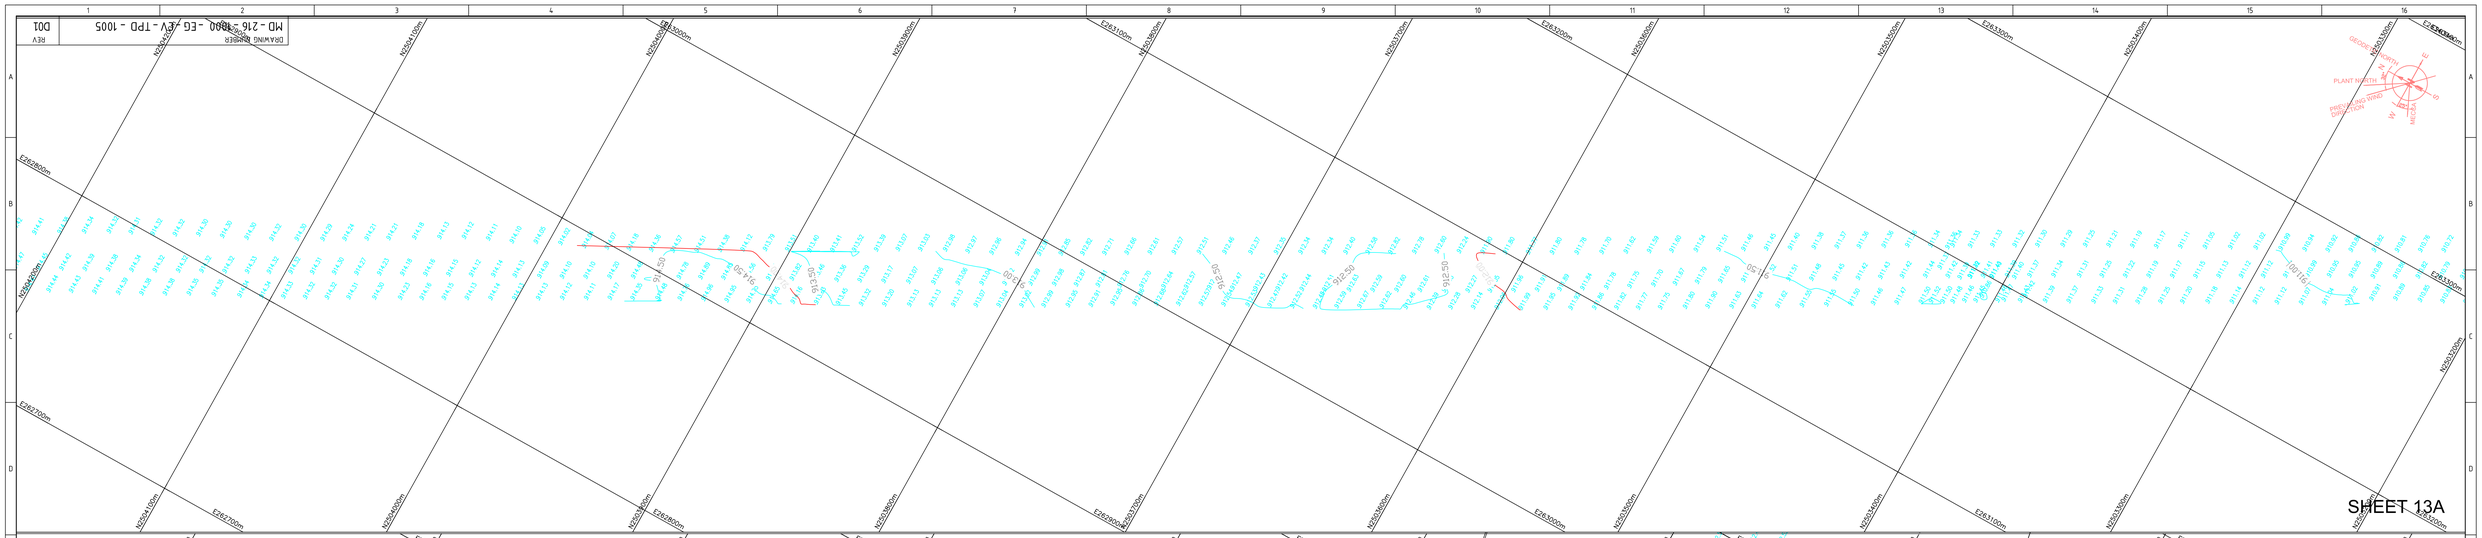

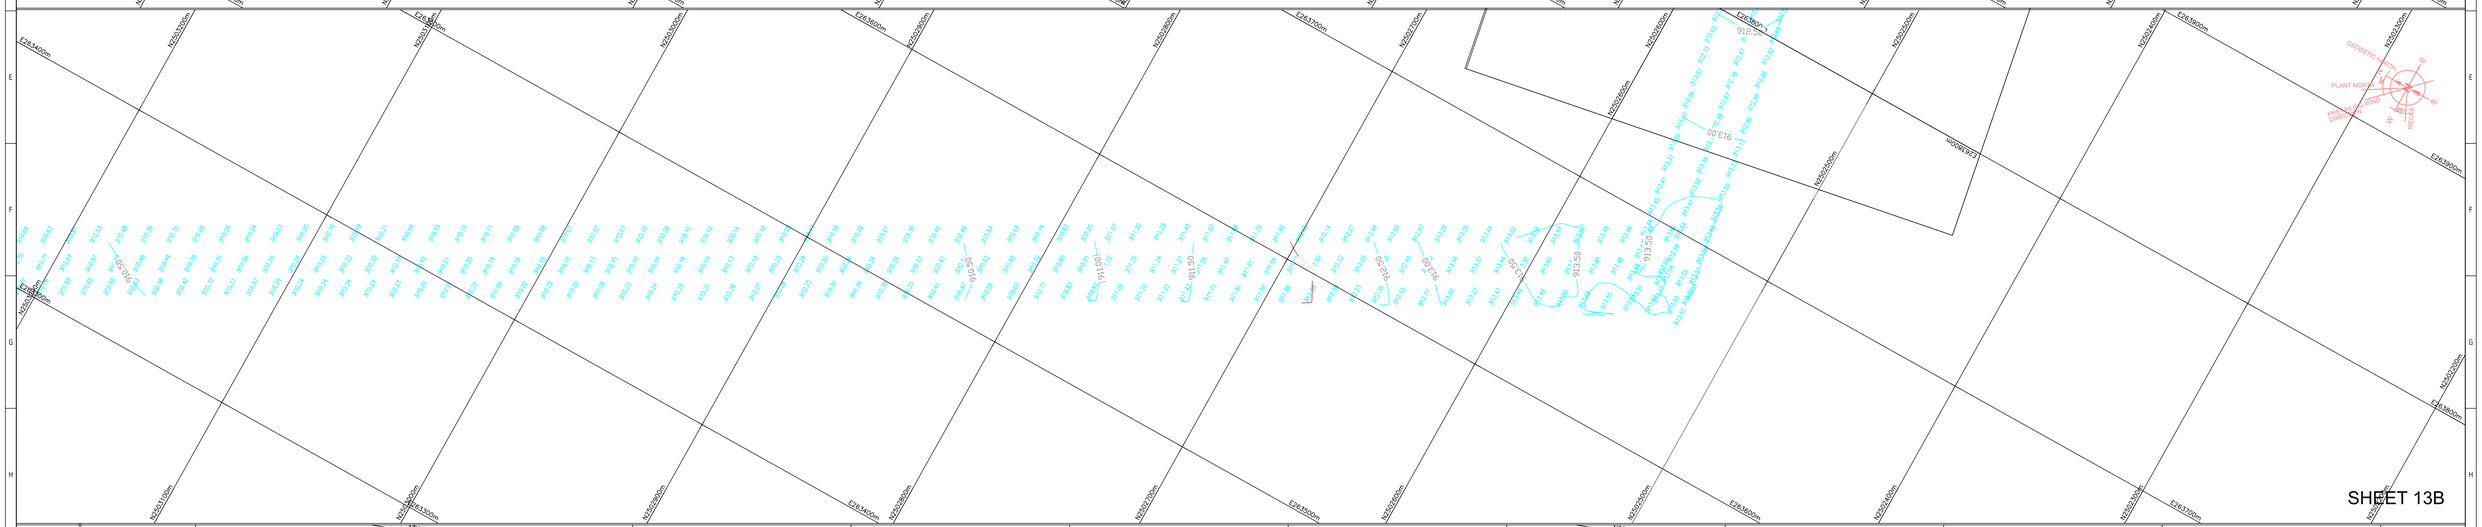

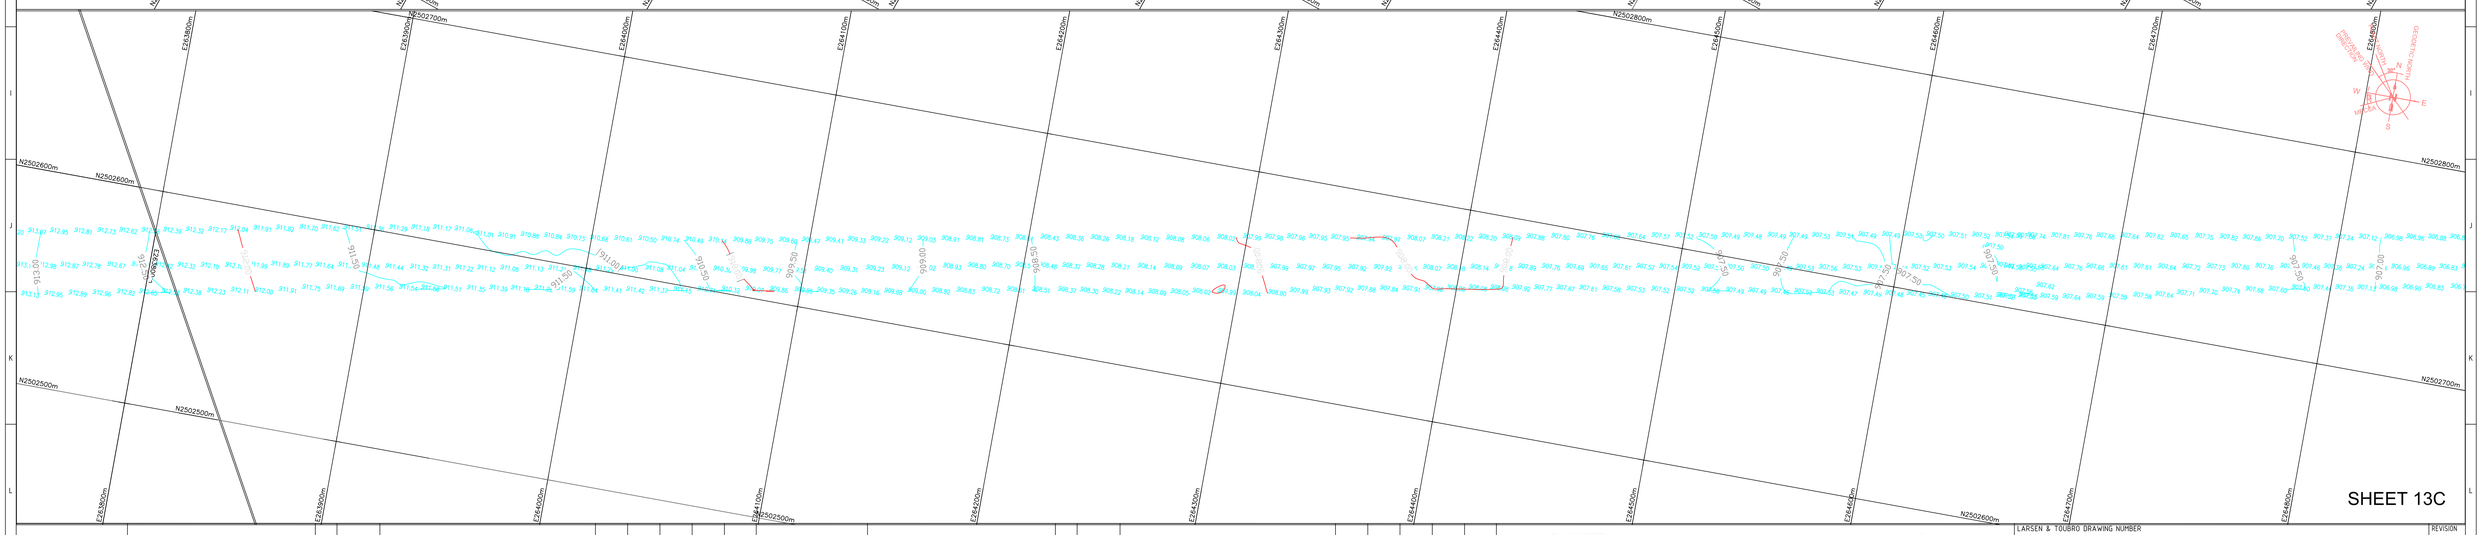

DOCUMENT NUMBER	REFERENCE DOCUMENTS	REV	DATE	REVISION DESCRIPTION	DRN	CHK	ENG	APP	EMP
D01		D01	11/10/2023	AS BUILT	C.P	MLI	M.A	SJM	
C01		C01	03/02/2021	ISSUED FOR CONSTRUCTION	C.P	MLI	M.A	S.M	
A02		A02	11/12/2020	REVISED AS PER EMPLOYER COMMENTS ON 27/01/2020	C.P	MLI	M.A	S.M	
A01		A01	07/12/2019	ISSUED FOR REFERENCE	C.P	M.A	M.A	MUHD/S.JM	

AFE CONSTRUCTION

مؤسسة أشرف محمد فضل خان للمقاولات
A. M. FAZAL CONTRACTING EST.

LARSEN & TOUBRO

This drawing is the property of LARSEN & TOUBRO and must not be passed on to any person or body not authorized by us to receive it nor be copied or otherwise made use either in full or in part by such person or body without our prior permission in writing.

Outotec

The content of these documents are the sole property of Outotec Oyj. Any rights not expressly granted herein are reserved. Reproduction, transfer or distribution of part or all of the contents in any form without prior written permission of Outotec is prohibited.

MA'ADEN معادن
Saudi Arabian Mining Company شركة معادن العربية السعودية

This document and the information contained herein is Ma'aden proprietary know-how. This document or any part thereof should not be reproduced, stored in a retrieval system or transmitted by any means, electronic or otherwise, or divulged without prior written permission of Ma'aden.

LARSEN & TOUBRO DRAWING NUMBER	019045_001_T_G_24525_001		REVISION 3
OUTOTEC DRAWING NUMBER	900707 __ GAU01 __ ZZ01 __ CLA04 __ 10000	DOCUMENT ID OU100666654	REVISION 3
DRAWN	C.P	04/12/2019	MANSOURAH - MASSARAH GOLD PROJECT
CHECKED	M.A	05/12/2019	TOPOGRAPHICAL SURVEY
ENGINEER	M.A	06/12/2019	BOREWELL STN 3,4 & PERIMETER BOUNDARY FENCE
APPROVED	MUHD/S.JM	07/12/2019	SURVEY DRAWING (SHEET-14 OF 19)
EMPLOYER			
SCALE	1:1	A0	DRAWING NUMBER MD - 216 - 1000 - EG - CV - TPD - 1005 REV D01

DRAWING NUMBER
MD - 216 - 1000 - EG - CV - TPD - 1005
REV
D01

SHEET 14A

SHEET 14B

SHEET 14C

DOCUMENT NUMBER	REFERENCE DOCUMENTS	REV	DATE	REVISION DESCRIPTION	DRN	CHK	ENG	APP	EMP
		D01	11/10/2023	AS BUILT	C.P	MLI	M.A	SJM	
		C01	03/02/2021	ISSUED FOR CONSTRUCTION	C.P	MLI	M.A	S.M	
		A02	11/12/2020	REVISED AS PER EMPLOYER COMMENTS ON 27/01/2020	C.P	MLI	M.A	S.M	
		A01	07/12/2019	ISSUED FOR REFERENCE	C.P	M.A	M.A	MUHD/SJM	

AFE CONSTRUCTION

مؤسسة أشرف محمد فضل خان للمقاولات
A. M. FAZAL CONTRACTING EST.

LARSEN & TOUBRO

This drawing is the property of LARSEN & TOUBRO and must not be passed on to any person or body not authorized by us to receive it nor be copied or otherwise made use either in full or in part by such person or body without our prior permission in writing.

Outotec

The content of these documents are the sole property of Outotec Oy. Any rights not expressly granted herein are reserved. Reproduction, transfer or distribution of part or all of the contents in any form without prior written permission of Outotec is prohibited.

MA'ADEN معادن
Saudi Arabian Mining Company شركة المعادن العربية السعودية

This document and the information contained herein is Ma'aden proprietary know-how. This document or any part thereof should not be reproduced, stored in a retrieval system or transmitted by any means, electronic or otherwise, or divulged without prior written permission of Ma'aden.

LARSEN & TOUBRO DRAWING NUMBER			REVISION
019045_001_T_G_24525_001			3
OUTOTEC DRAWING NUMBER		DOCUMENT ID	REVISION
900707__GAU01__ZZ01__CLA04__10000		OU100666654	3
DRAWN	C.P	04/12/2019	MANSOURAH - MASSARAH GOLD PROJECT
CHECKED	M.A	05/12/2019	TOPOGRAPHICAL SURVEY
ENGINEER	M.A	06/12/2019	BOREWELL STN 3,4 & PERIMETER BOUNDARY FENCE
APPROVED	MUHD/SJM	07/12/2019	SURVEY DRAWING (SHEET-15 OF 19)
EMPLOYER			
SCALE 1:1	A0	DRAWING NUMBER	MD - 216 - 1000 - EG - CV - TPD - 1005 REV D01

MD-216-1000-EG-CV-TPD-1005 D01

DRAWING NUMBER REV

SHEET 15A

SHEET 15B

SHEET 15C

DOCUMENT NUMBER	REFERENCE DOCUMENTS	REV	DATE	REVISION DESCRIPTION	DRN	CHK	ENG	APP	EMP
DOCUMENT NUMBER	REFERENCE DOCUMENTS	REV	DATE	REVISION DESCRIPTION	DRN	CHK	ENG	APP	EMP
		D01	11/10/2023	AS BUILT	C.P	MLI	M.A	SJM	
		C01	03/02/2021	ISSUED FOR CONSTRUCTION	C.P	MLI	M.A	S.M	
		A02	11/12/2020	REVISED AS PER EMPLOYER COMMENTS ON 27/01/2020	C.P	MLI	M.A	S.M	
		A01	07/12/2019	ISSUED FOR REFERENCE	C.P	M.A	M.A	MUHD/S.JM	

AFE CONSTRUCTION

مؤسسة أشرف محمد فضل خان للمقاولات
A. M. FAZAL CONTRACTING EST.

LARSEN & TOUBRO

This drawing is the property of LARSEN & TOUBRO and must not be passed on to any person or body not authorized by us to receive it nor be copied or otherwise made use either in full or in part by such person or body without our prior permission in writing.

Outotec


The content of these documents are the sole property of Outotec Oy. Any rights not expressly granted herein are reserved. Reproduction, transfer or distribution of part or all of the contents in any form without prior written permission of Outotec is prohibited.


MA'ADEN معادن
Saudi Arabian Mining Company شركة المعادن العربية السعودية


This document and the information contained herein is Ma'aden proprietary know-how. This document or any part thereof should not be reproduced, stored in a retrieval system or transmitted by any means, electronic or otherwise, or divulged without prior written permission of Ma'aden.

LARSEN & TOUBRO DRAWING NUMBER			REVISION
019045_001_T_G_24525_001			3
OUTOTEC DRAWING NUMBER		DOCUMENT ID	REVISION
900707__GAU01__ZZ01__CLA04__10000		OU100666654	3
DRAWN	C.P	04/12/2019	MANSOURAH - MASSARAH GOLD PROJECT
CHECKED	M.A	05/12/2019	TOPOGRAPHICAL SURVEY
ENGINEER	M.A	06/12/2019	BOREWELL STN 3,4 & PERIMETER BOUNDARY FENCE
APPROVED	MUHD/S.JM	07/12/2019	SURVEY DRAWING (SHEET-16 OF 19)
EMPLOYER			DRAWING NUMBER / REV
SCALE 1:1	A0		MD-216-1000-EG-CV-TPD-1005 / D01

DRAWING NUMBER
MD - 216 - 1000 - EG-CV-TPD - 1005
REV
D01

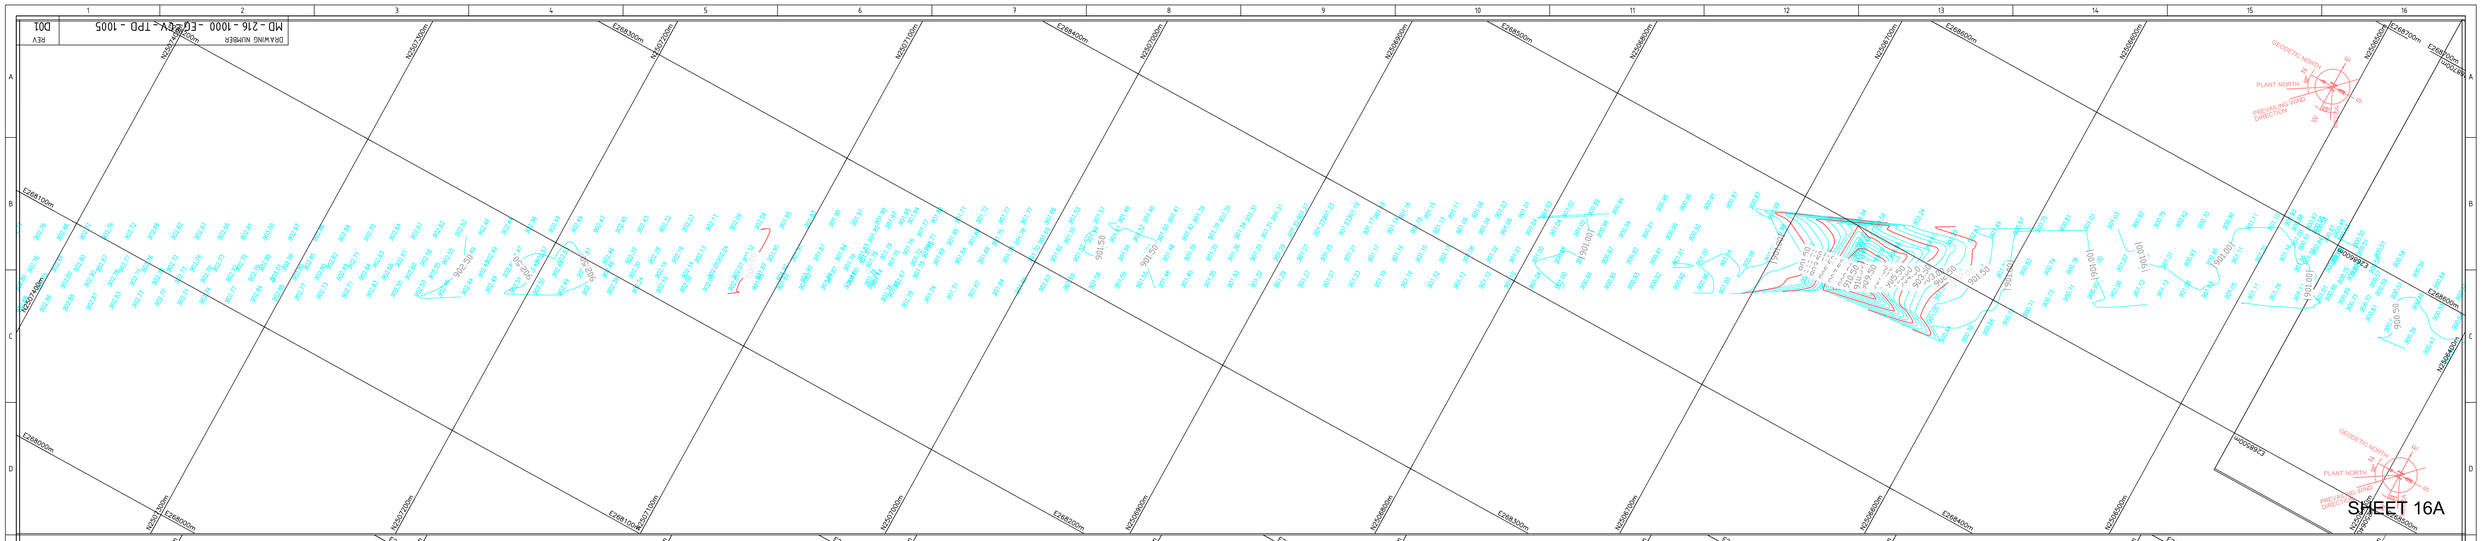

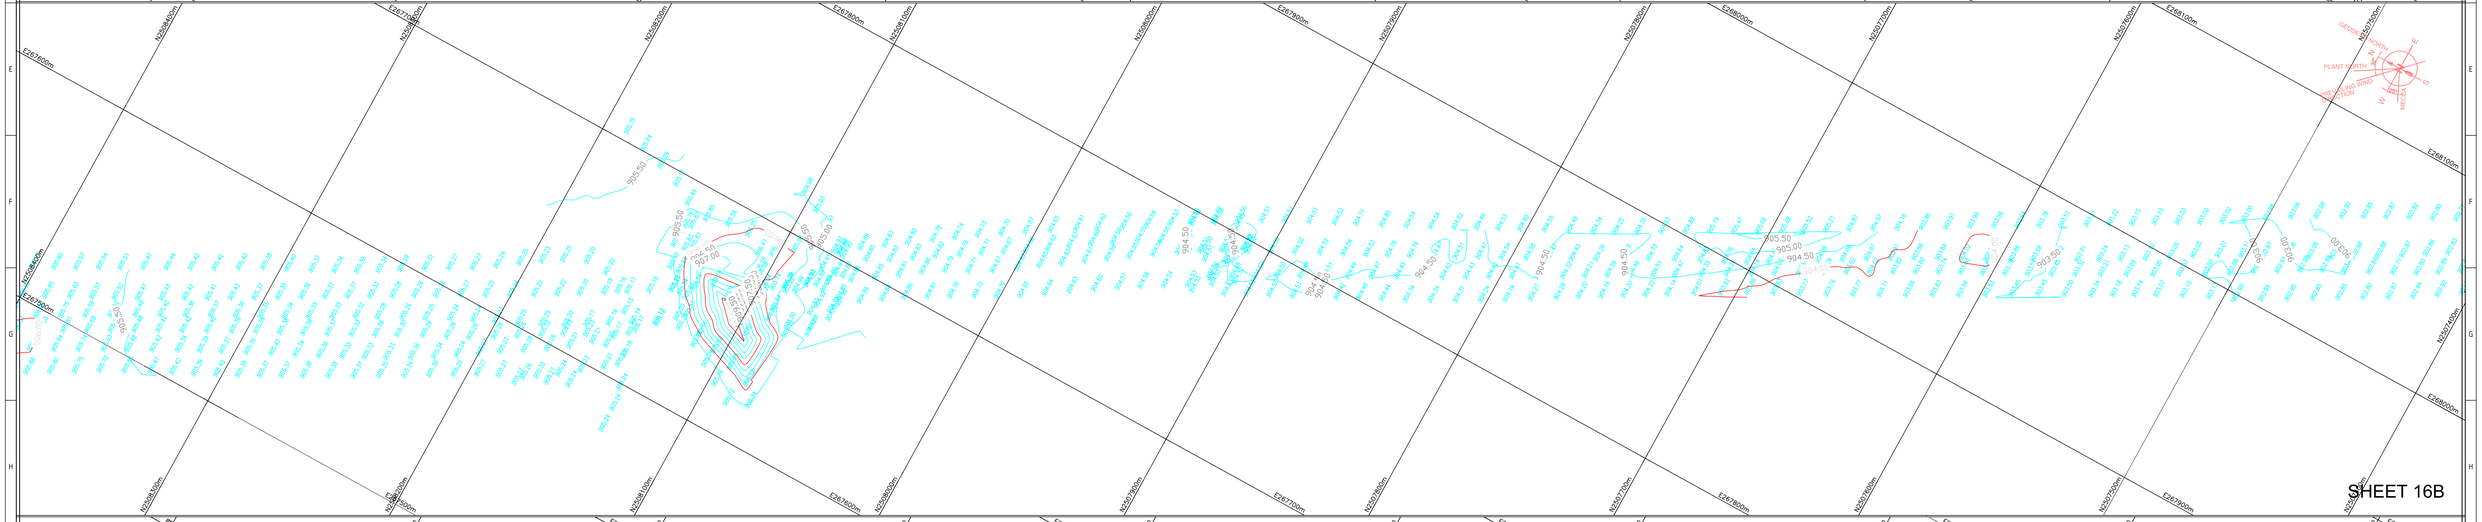

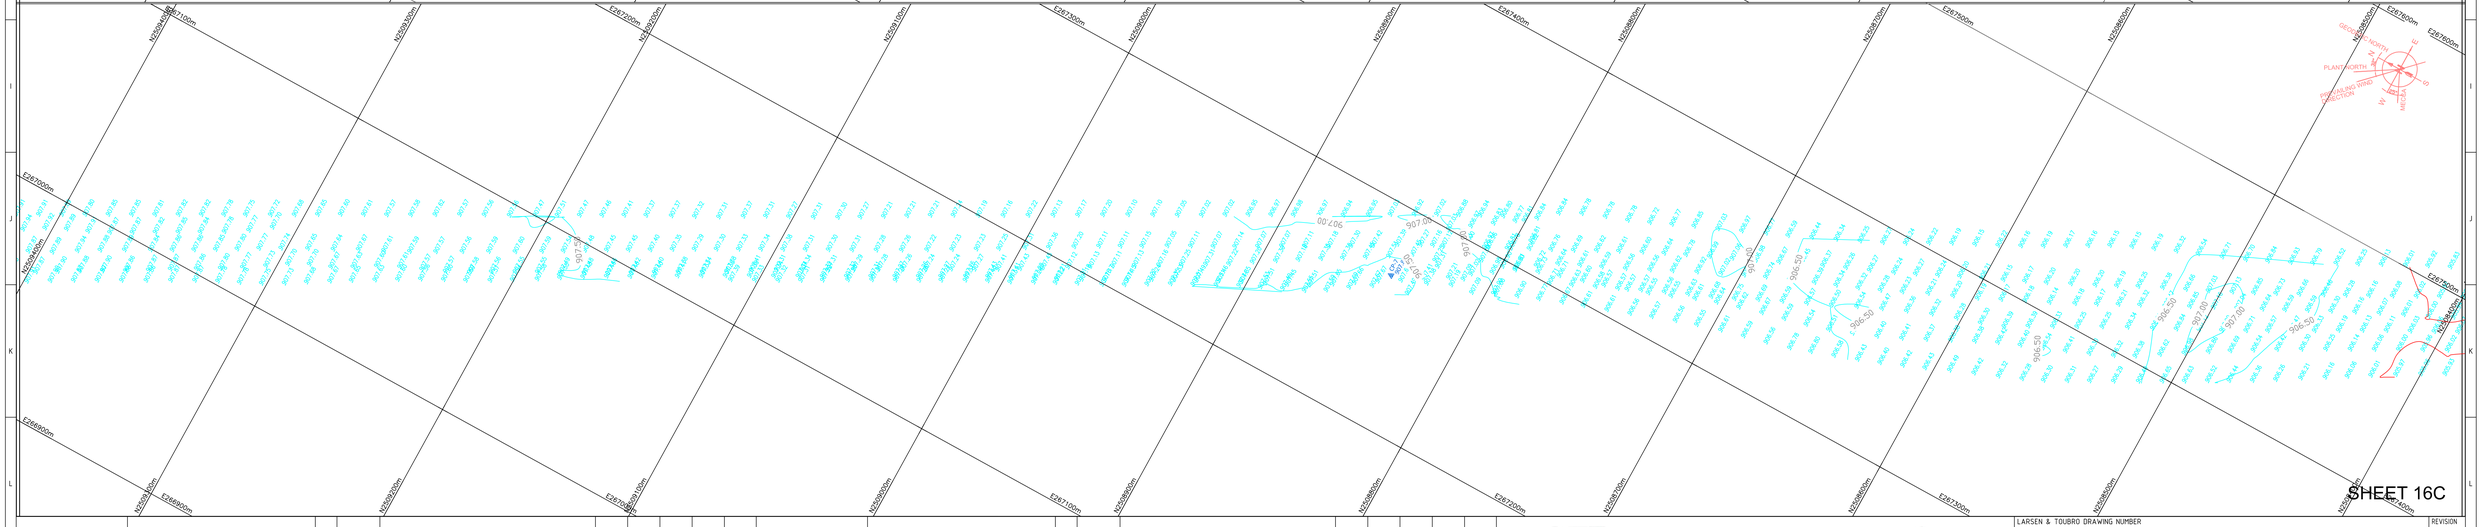

DOCUMENT NUMBER	REFERENCE DOCUMENTS	REV	DATE	REVISION DESCRIPTION	DRN	CHK	ENG	APP	EMP
D01			11/10/2023	AS BUILT	C.P	MLI	M.A	SJM	
C01			03/02/2021	ISSUED FOR CONSTRUCTION	C.P	MLI	M.A	SJM	
A02			11/12/2020	REVISED AS PER EMPLOYER COMMENTS ON 27/01/2020	C.P	MLI	M.A	SJM	
A01			07/12/2019	ISSUED FOR REFERENCE	C.P	M.A	M.A	MUHD/SJM	

AFE CONSTRUCTION

مؤسسة أشرف محمد فضل خان للمقاولات
A. M. FAZAL CONTRACTING EST.

LARSEN & TOUBRO

This drawing is the property of LARSEN & TOUBRO and must not be passed on to any person or body not authorized by us to receive it nor be copied or otherwise made use either in full or in part by such person or body without our prior permission in writing.

Outotec

The content of these documents are the sole property of Outotec Oyj. Any rights not expressly granted herein are reserved. Reproduction, transfer or distribution of part or all of the contents in any form without prior written permission of Outotec is prohibited.

MA'ADEN معادن
Saudi Arabian Mining Company شركة المعادن العربية السعودية

This document and the information contained herein is Ma'aden proprietary know-how. This document or any part thereof should not be reproduced, stored in a retrieval system or transmitted by any means, electronic or otherwise, or divulged without prior written permission of Ma'aden.

LARSEN & TOUBRO DRAWING NUMBER			REVISION
019045_001_T_G_24525_001			3
OUTOTEC DRAWING NUMBER		DOCUMENT ID	REVISION
900707__GAU01__ZZ01__CLA04__10000		OU100666654	3
DRAWN	C.P	04/12/2019	MANSOURAH - MASSARAH GOLD PROJECT
CHECKED	M.A	05/12/2019	TOPOGRAPHICAL SURVEY
ENGINEER	M.A	06/12/2019	BOREWELL STN 3,4 & PERIMETER BOUNDARY FENCE
APPROVED	MUHD/SJM	07/12/2019	SURVEY DRAWING (SHEET-17 OF 19)
EMPLOYER			
SCALE 1:1	A0		DRAWING NUMBER: MD - 216 - 1000 - EG - CV - TPD - 1005 REV: D01

DRAWING NUMBER
MD - 216 - 1000 - EG - CV - TPD - 1005
REV
D01

SHEET 17A

SHEET 17B

SHEET 17C

DOCUMENT NUMBER	REFERENCE DOCUMENTS	REV	DATE	REVISION DESCRIPTION	DRN	CHK	ENG	APP	EMP
		D01	11/10/2023	AS BUILT	C.P	MLI	M.A	SJM	
		C01	03/02/2021	ISSUED FOR CONSTRUCTION	C.P	MLI	M.A	SJM	
		A02	11/12/2020	REVISED AS PER EMPLOYER COMMENTS ON 27/01/2020	C.P	MLI	M.A	SJM	
		A01	07/12/2019	ISSUED FOR REFERENCE	C.P	M.A	M.A	MUHD/SJM	

DOCUMENT NUMBER	REFERENCE DOCUMENTS	REV	DATE	REVISION DESCRIPTION	DRN	CHK	ENG	APP	EMP

AFE CONSTRUCTION

مؤسسة أشرف محمد فضل خان للمقاولات
A. M. FAZAL CONTRACTING EST.

LARSEN & TOUBRO

This drawing is the property of LARSEN & TOUBRO and must not be passed on to any person or body not authorized by us to receive it nor be copied or otherwise made use either in full or in part by such person or body without our prior permission in writing.

Outotec

The content of these documents are the sole property of Outotec Oy. Any rights not expressly granted herein are reserved. Reproduction, transfer or distribution of part or all of the contents in any form without prior written permission of Outotec is prohibited.

MA'ADEN معادن
Saudi Arabian Mining Company شركة المعادن العربية السعودية

This document and the information contained herein is Ma'aden proprietary know-how. This document or any part thereof should not be reproduced, stored in a retrieval system or transmitted by any means, electronic or otherwise, or divulged without prior written permission of Ma'aden.

LARSEN & TOUBRO DRAWING NUMBER			REVISION
019045_001_T_G_24525_001			3
OUTOTEC DRAWING NUMBER		DOCUMENT ID	REVISION
900707 _ GAU01 _ ZZ01 _ CLA04 _ 10000		OU100666654	3
DRAWN	C.P	04/12/2019	MANSOURAH - MASSARAH GOLD PROJECT
CHECKED	M.A	05/12/2019	TOPOGRAPHICAL SURVEY
ENGINEER	M.A	06/12/2019	BOREWELL STN 3,4 & PERIMETER BOUNDARY FENCE
APPROVED	MUHD/SJM	07/12/2019	SURVEY DRAWING (SHEET-18 OF 19)
EMPLOYER			
SCALE	1:1	A0	DRAWING NUMBER: MD - 216 - 1000 - EG - CV - TPD - 1005
			REV: D01

DRAWING NUMBER
MD - 216 - 1000 - EG - CV - TPD - 1005
REV
D01

DOCUMENT NUMBER	REFERENCE DOCUMENTS	REV	DATE	REVISION DESCRIPTION	DRN	CHK	ENG	APP	EMP
D01			11/10/2023	AS BUILT	C.P	MLI	M.A	SJM	
C01			03/02/2021	ISSUED FOR CONSTRUCTION	C.P	MLI	M.A	S.M	
A02			11/12/2020	REVISED AS PER EMPLOYER COMMENTS ON 27/01/2020	C.P	MLI	M.A	S.M	
A01			07/12/2019	ISSUED FOR REFERENCE	C.P	M.A	M.A	MUHD/SJM	

DOCUMENT NUMBER	REFERENCE DOCUMENTS	REV	DATE	REVISION DESCRIPTION	DRN	CHK	ENG	APP	EMP

AFE CONSTRUCTION

مؤسسة أشرف محمد فضل خان للمقاولات
A. M. FAZAL CONTRACTING EST.

LARSEN & TOUBRO

This drawing is the property of LARSEN & TOUBRO and must not be passed on to any person or body not authorized by us to receive it nor be copied or otherwise made use either in full or in part by such person or body without our prior permission in writing.

Outotec

The content of these documents are the sole property of Outotec Oyj. Any rights not expressly granted herein are reserved. Reproduction, transfer or distribution of part or all of the contents in any form without prior written permission of Outotec is prohibited.

MA'ADEN معادن
Saudi Arabian Mining Company شركة معادن العربية السعودية

This document and the information contained herein is Ma'aden proprietary know-how. This document or any part thereof should not be reproduced, stored in a retrieval system or transmitted by any means, electronic or otherwise, or divulged without prior written permission of Ma'aden.

LARSEN & TOUBRO DRAWING NUMBER			REVISION
019045_001_T_G_24525_001			3
OUTOTEC DRAWING NUMBER		DOCUMENT ID	REVISION
900707__GAU01__ZZ01__CLA04__10000		OU100666654	3
DRAWN	C.P	04/12/2019	MANSOURAH - MASSARAH GOLD PROJECT
CHECKED	M.A	05/12/2019	TOPOGRAPHICAL SURVEY
ENGINEER	M.A	06/12/2019	BOREWELL STN 3,4 & PERIMETER BOUNDARY FENCE
APPROVED	MUHD/SJM	07/12/2019	SURVEY DRAWING (SHEET-19 OF 19)
EMPLOYER			
SCALE 1:1	A0	DRAWING NUMBER	REV
		MD - 216 - 1000 - EG - CV - TPD - 1005	D01