



DRAWING NUMBER
MD-216-49PQ-EG-CV-GAD-1607
REV D01

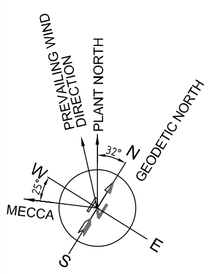

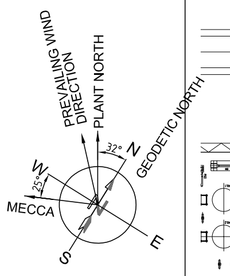

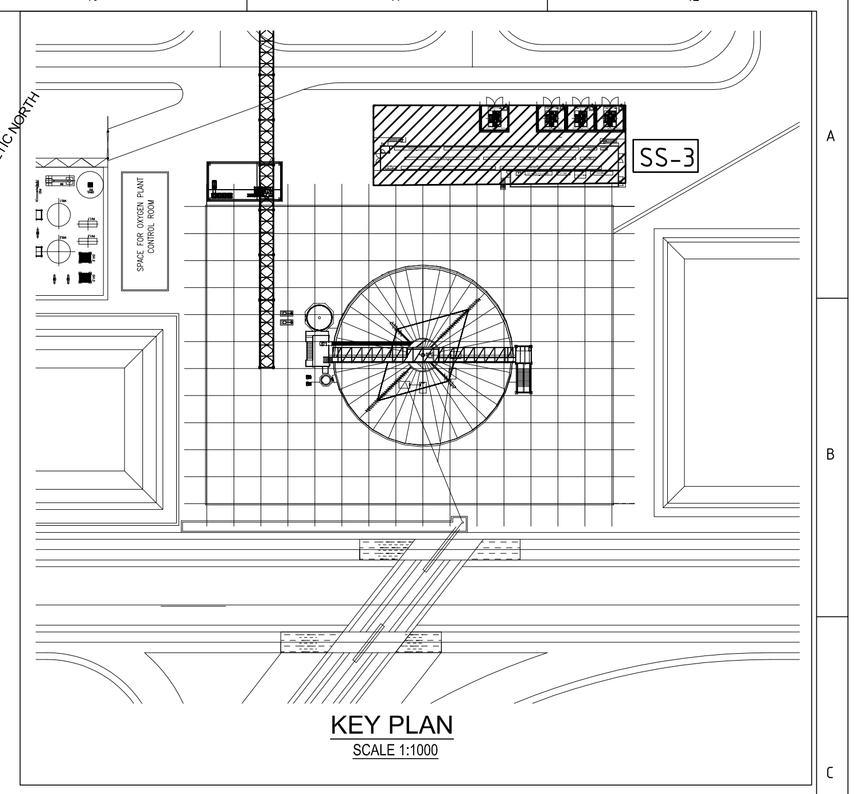

KEY PLAN
SCALE 1:1000

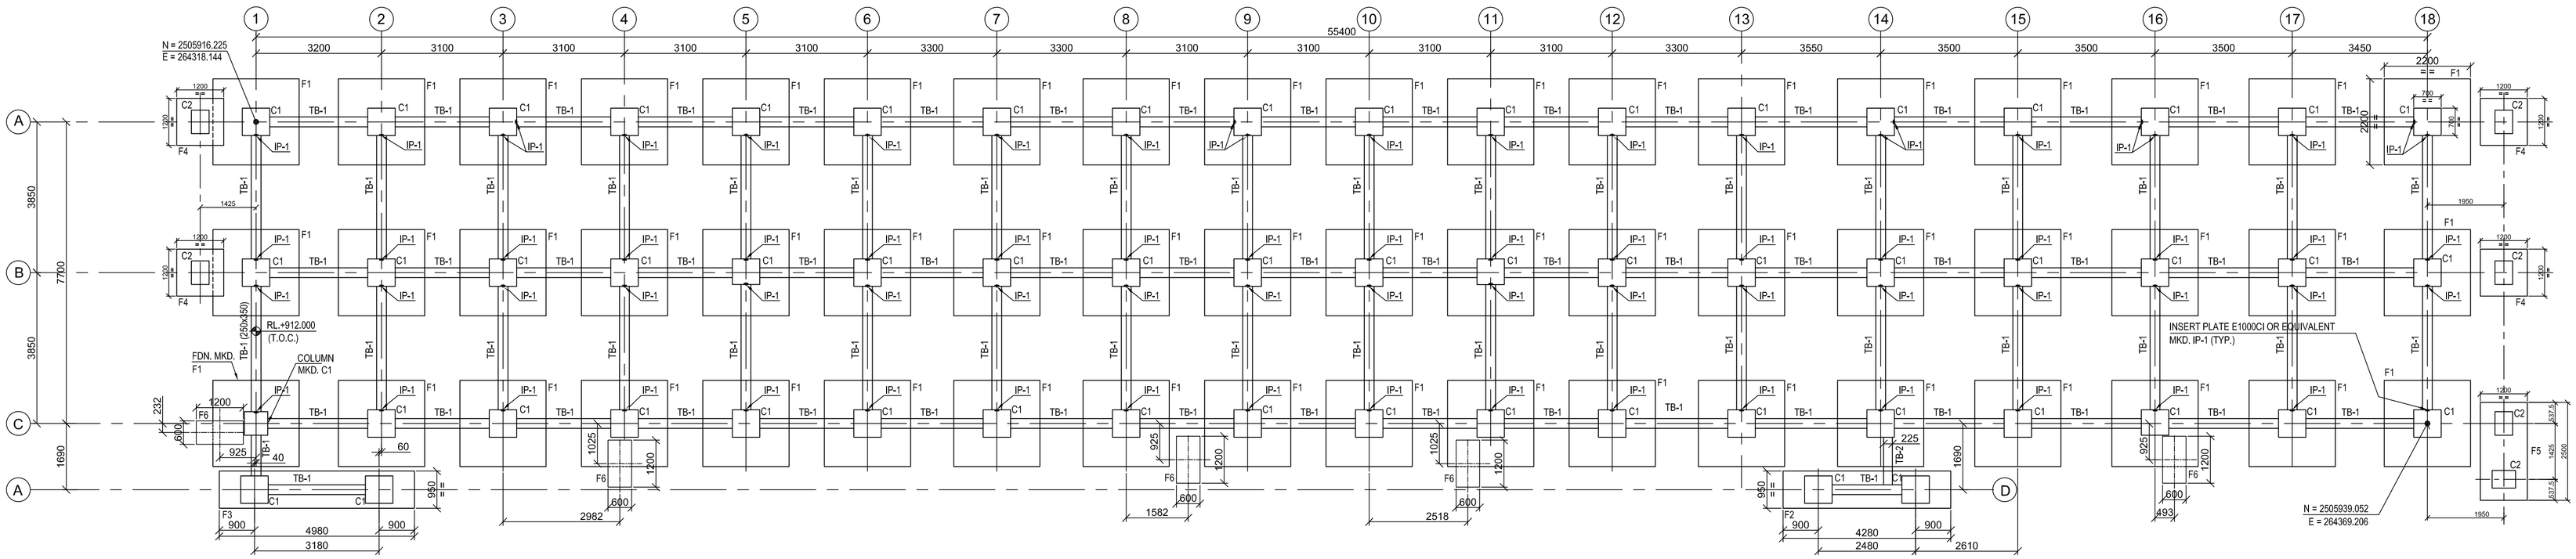

LAYOUT OF FOUNDATION
SCALE 1:75

LEGENDS :-

R.L. - REDUCED LEVEL
℄ - CENTRE LINE
T.O.C. - TOP OF CONCRETE
TYP. - TYPICAL
T.O.G. - TOP OF GROUT
B.O.F. - BOTTOM OF FOUNDATION
F.G.L. - FINISHED GROUND LEVEL.
F.F.L. - FINISHED FLOOR LEVEL
P.C.C - PLAIN CEMENT CONCRETE
DET. - DETAIL
FDN. - FOUNDATION
THK. - THICK
R.C. - REINFORCED CONCRETE
MKD. - MARKED

NOTES:-

1. ALL DIMENSIONS ARE IN MILLIMETRES AND LEVELS AND CO-ORDINATES ARE IN METRES UNLESS OTHERWISE STATED.
2. NET SAFE BEARING CAPACITY OF SOIL AT BOTTOM OF FOUNDATION IS CONSIDERED AS 450KN/ SQ. M.
3. GRADE OF CONCRETE SHALL BE C35 (35Mpa) FOR FOUNDATION, C30 (30Mpa) FOR GRADE SLAB & C15 (15Mpa) FOR BLINDING CONCRETE.

DOCUMENT NUMBER	REFERENCE DOCUMENTS	REV	DATE	REVISION DESCRIPTION	DRN	CHK	ENG	APP	EMP
		D01	27/03/2023	AS-BUILT	AMJ	SJM	AVG	AG	
		C03	03/03/2022	ISSUED FOR CONSTRUCTION & REVISED AS MKD. C03	AMJ	SJM	AVG	AG	
		C02	17/11/2020	ISSUED FOR CONSTRUCTION AND REVISED AS MKD. C02	MNS	SJM	AVG	AG	
MD-216-49PQ-EG-CV-GAD-1608	DETAIL OF FOUNDATIONS	C01	27/07/2020	ISSUED FOR CONSTRUCTION AND REVISED AS MKD. C01	ABS	SJM	AVG	AG	
MD-216-1000-EG-ST-CRT-1001	CIVIL, STRUCTURAL & ARCHITECTURAL - DESIGN CRITERIA	A01	19/06/2020	ISSUED FOR REFERENCE	ABS	SJM	AVG	AG	

RESERVED FOR VENDOR LOGO AND DRAWING NUMBER

LARSEN & TOUBRO

This drawing is the property of LARSEN & TOUBRO and must not be passed on to any person or body not authorized by us to receive it nor be copied or otherwise made use either in full or in part by such person or body without our prior permission in writing.

Outotec

The content of these documents are the sole property of Outotec Oyj. Any rights not expressly granted herein are reserved. Reproduction, transfer or distribution of part or all of the contents in any form without prior written permission of Outotec is prohibited.

MA'ADEN معادن
Saudi Arabian Mining Company شركة التعدين العربية السعودية

This document and the information contained herein is Ma'aden proprietary know-how. This document or any part thereof should not be reproduced, stored in a retrieval system or transmitted by any means, electronic or otherwise, or divulged without prior written permission of Ma'aden.

LARSEN & TOUBRO DRAWING NUMBER		REVISION
019045_950_C_G_24301_003		4
OUTOTEC DRAWING NUMBER	DOCUMENT ID	REVISION
900707__GAU01__WD01__MTL01__45021	OU100684598	4

DRAWN	ABS	05/06/2020
CHECKED	SJM	18/06/2020
ENGINEER	AVG	16/06/2020
APPROVED	AG	19/06/2020
EMPLOYER		
SCALE	1:75	A1

MANSOURAH - MASSARAH GOLD PROJECT
GENERAL ARRANGEMENT DRAWING
PROCESS PLANT SUBSTATION 03
LAYOUT OF FOUNDATIONS

DRAWING NUMBER: MD-216-49PQ-EG-CV-GAD-1607
REV: D01