


DRAWING NUMBER
MD - 216 - 49PQ - EG - CV - GAD - 1610
REV
D01

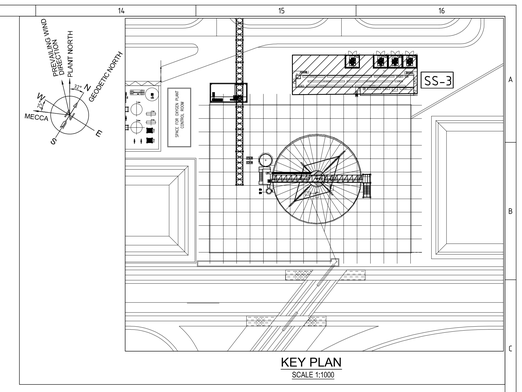


KEY PLAN
SCALE 1:1000

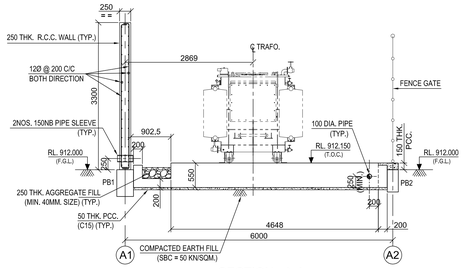


SECTION : A-A
SCALE 1:50

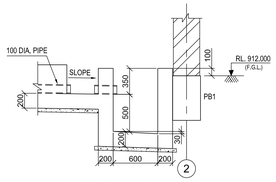


SECTION : C-C
SCALE 1:30

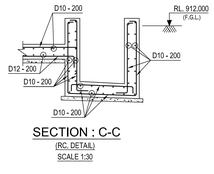


SECTION : C-C
(RC. DETAIL)
SCALE 1:30

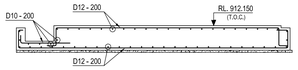


SECTION : A-A
(RC. DETAIL)
SCALE 1:50

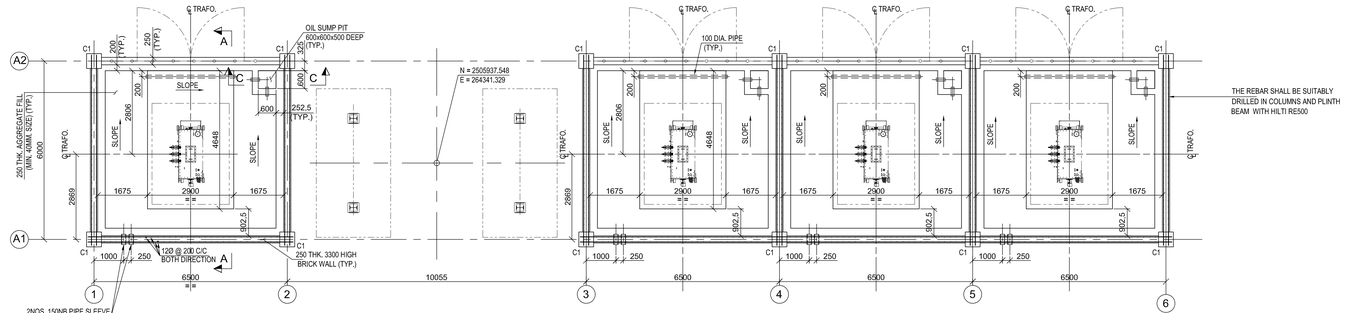


LAYOUT OF TRANSFORMER AREA
SCALE 1:75

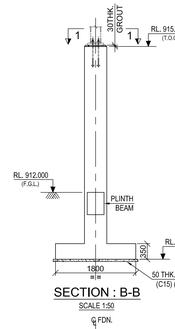


SECTION : B-B
SCALE 1:50

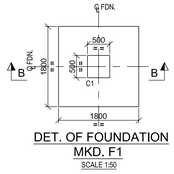


DET. OF FOUNDATION
MKD. F1
SCALE 1:50

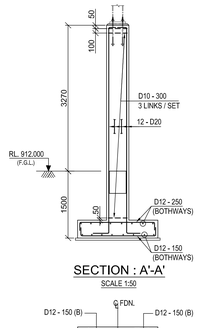


SECTION : A'-A'
SCALE 1:50

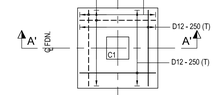


RC. DET. OF FOUNDATION
MKD. F1
SCALE 1:50

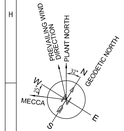


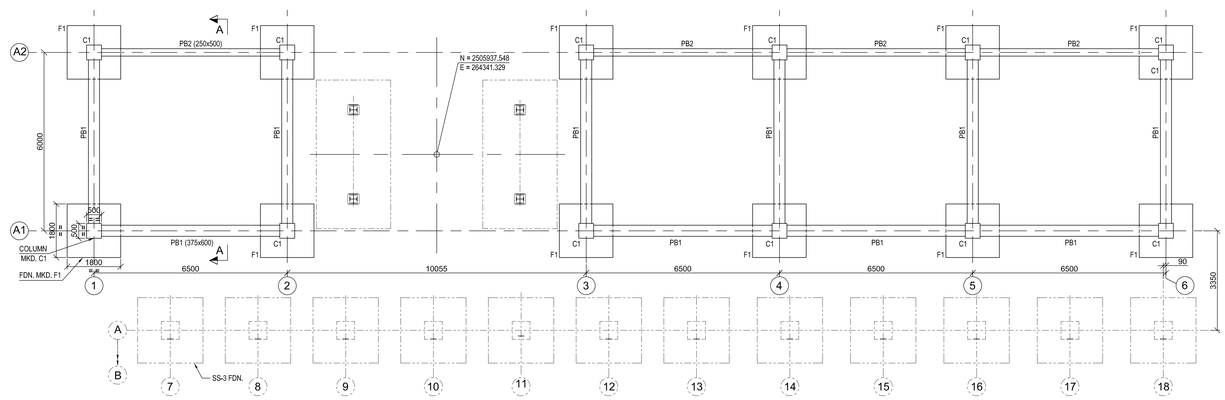


LAYOUT OF FOUNDATION
SCALE 1:75

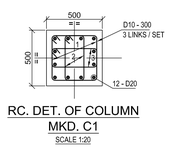

RC. DET. OF COLUMN
MKD. C1
SCALE 1:20

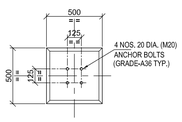

VIEW : 1-1
(DETAIL OF COL. MKD. C1)
SCALE 1:20

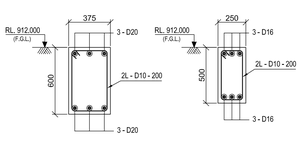

RC. DET. OF PB1
SCALE 1:20

RC. DET. OF PB2
SCALE 1:20

ALL CABLE CONDUITS SHALL BE LAID AS PER ELECTRICAL DWG. MD-216-49PQ-EG-EL-LAD-1015

LEGENDS :-

R.L. - REDUCED LEVEL
℄ - CENTRE LINE
T.O.C. - TOP OF CONCRETE
TYP. - TYPICAL
T.O.G. - TOP OF GROUT
B.O.F. - BOTTOM OF FOUNDATION
F.G.L. - FINISHED GROUND LEVEL.
F.F.L. - FINISHED FLOOR LEVEL
P.C.C - PLAIN CEMENT CONCRETE
DET. - DETAIL
FDN. - FOUNDATION
THK. - THICK
R.C. - REINFORCED CONCRETE
MKD. - MARKED
TRAFO. - TRANSFORMER
MIN. - MINIMUM
DIA. - DIAMETER
BOTTOM REINFORCEMENT (B) - - - - - - -
TOP REINFORCEMENT (T) - ———

NOTES:-

1. ALL DIMENSIONS ARE IN MILLIMETRES AND LEVELS AND CO-ORDINATES ARE IN METRES UNLESS OTHERWISE STATED.
2. NET SAFE BEARING CAPACITY OF SOIL AT BOTTOM OF FOUNDATION IS CONSIDERED AS 450KN/ SQ. M.
3. GRADE OF CONCRETE SHALL BE C35 (35Mpa) FOR FOUNDATION, C30 (30Mpa) FOR GRADE SLAB & C15 (15Mpa) FOR BLINDING CONCRETE.
4. GRADE OF REINFORCEMENT SHALL BE DEFORMED BAR 420 MPa (GRADE 60) - ASTM A615/A615M.
5. CLEAR COVER TO REINFORCEMENT SHALL BE FOUNDATIONS = 50 MM., COLUMNS = 50 MM., BEAM = 25 MM.
6. FOR STANDARD REINFORCEMENT DETAIL & GENERAL NOTES FOR CIVIL WORKS REFER DRAWING NO. MD-216-1000-EG-CV-DED-1005 & 1001.

DOCUMENT NUMBER	REFERENCE DOCUMENTS	REV	DATE	REVISION DESCRIPTION	DRN	CHK	ENG	APP	EMP
		D01	10/04/2023	AS-BUILT	ABS	SJM	AVG	AG	
		C02	23/02/2021	ISSUED FOR CONSTRUCTION & REVISED AS MKD.	ABS	SJM	AVG	AG	
		C01	27/11/2020	ISSUED FOR CONSTRUCTION & REVISED AS MKD.	ABS	SJM	AVG	AG	
MD-216-49PQ-EG-CV-GAD-1607	LAYOUT OF FOUNDATIONS	A01	07/08/2020	ISSUED FOR REFERENCE	ABS	SJM	AVG	AG	
MD-216-1000-EG-ST-CRT-1001	CIVIL, STRUCTURAL & ARCHITECTURAL - DESIGN CRITERIA								

RESERVED FOR VENDOR LOGO AND DRAWING NUMBER

This drawing is the property of LARSEN & TOUBRO and must not be passed on to any person or body not authorised by us to receive it nor be copied or otherwise made use either in full or in part by such person or body without our prior permission in writing.

The content of these documents are the sole property of Outotec Oy. Any rights not expressly granted herein are reserved. Reproduction, transfer or distribution of part or all of the contents in any form without prior written permission of Outotec is prohibited.

This document and the information contained herein is Ma'aden proprietary know-how. This document or any part thereof should not be reproduced, stored in a retrieval system or transmitted by any means, electronic or otherwise, or divulged without prior written permission of Ma'aden.

LARSEN & TOUBRO DRAWING NUMBER: 01904 5_950_C_G_24302_002 — REVISION: 3
OUTOTEC DRAWING NUMBER: 900707 _ GAU01 _ WD01 _ MTL01 _ 45024 — DOCUMENT ID: 0U100684601 — REVISION: 3

DRAWN	ABS	20/07/2020
CHECKED	SJM	21/07/2020
ENGINEER	AVG	20/07/2020
APPROVED	AG	07/08/2020
EMPLOYER		
SCALE	1:20, 1:30, 1:50, 1:75	A0

MANSOURAH - MASSARAH GOLD PROJECT
GENERAL ARRANGEMENT DRAWING
PROCESS PLANT SUBSTATION 03
DETAIL OF TRANSFORMER AREA

DRAWING NUMBER: MD - 216 - 49PQ - EG - CV - GAD - 1610 — REV: D01