


DRAWING NUMBER MD-216-49PQ-EG-CV-GAD-1611 REV D01

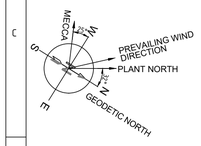

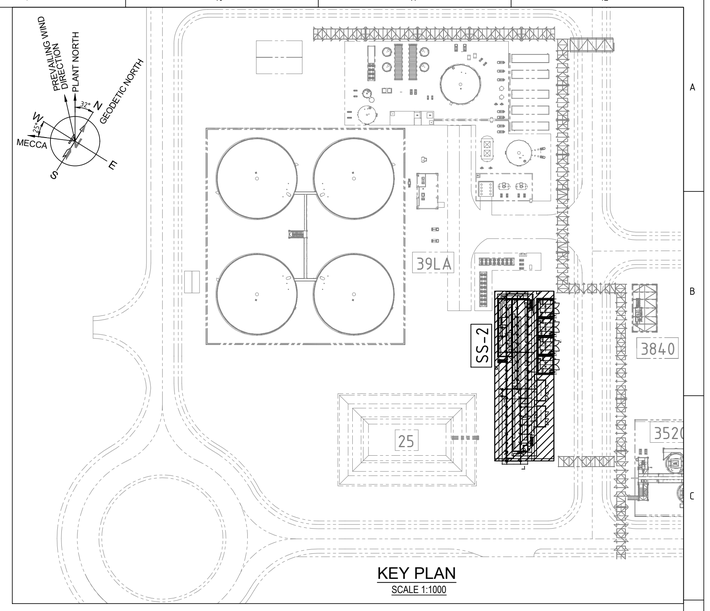

KEY PLAN
SCALE 1:1000

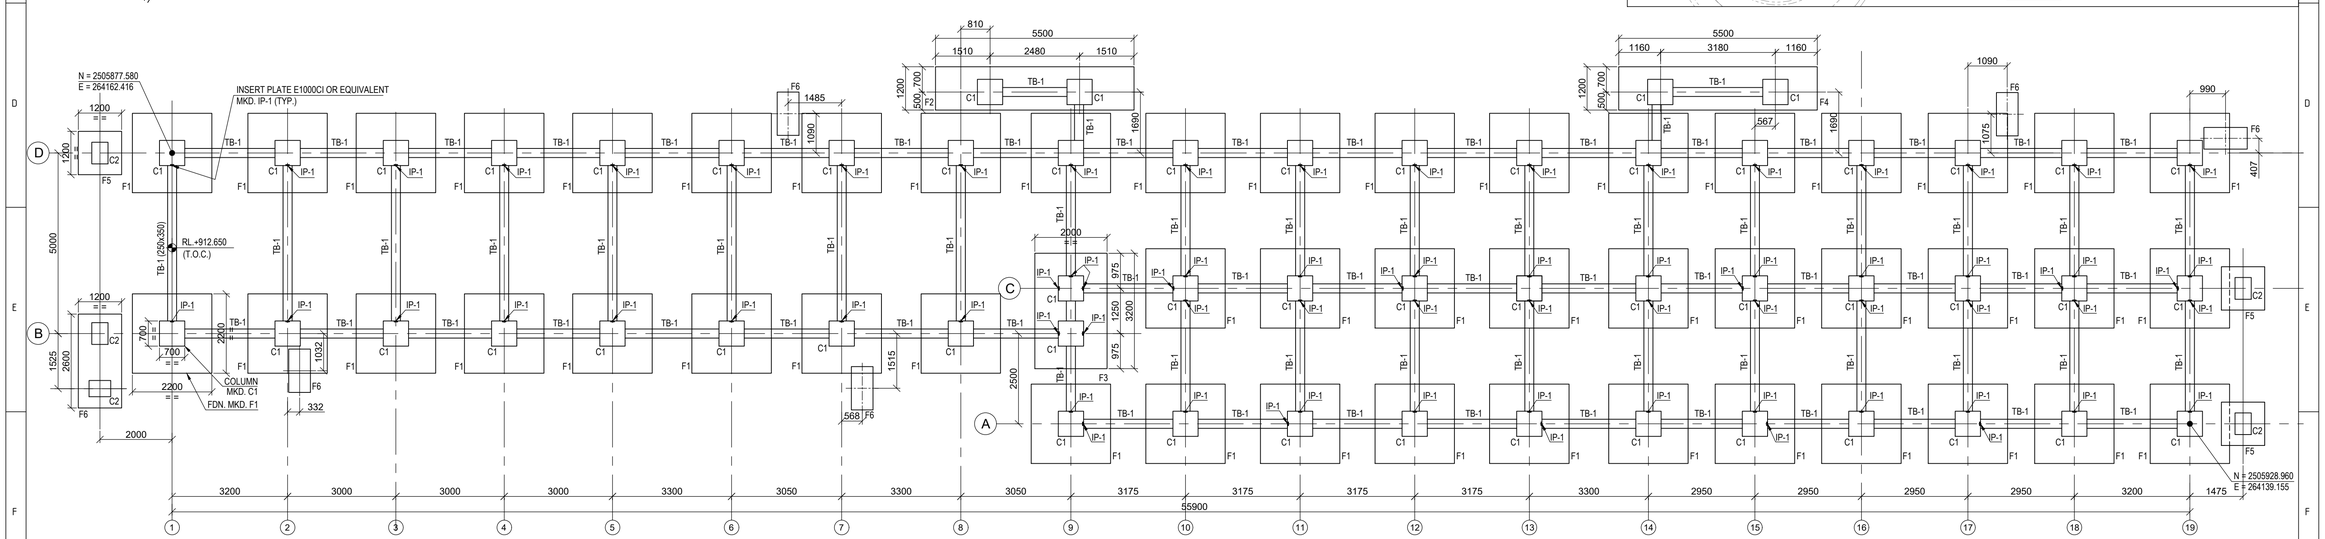

LAYOUT OF FOUNDATION
SCALE 1:75

ALL CABLE CONDUITS SHALL BE LAID AS PER ELECTRICAL DWG. MD-216-49PQ-EG-EL-LAD-1014

LEGEND :-

R.L. - REDUCED LEVEL
℄ - CENTRE LINE
T.O.C. - TOP OF CONCRETE
TYP. - TYPICAL
T.O.G. - TOP OF GROUT
B.O.F. - BOTTOM OF FOUNDATION
F.G.L. - FINISHED GROUND LEVEL.
F.F.L. - FINISHED FLOOR LEVEL
P.C.C - PLAIN CEMENT CONCRETE
DET. - DETAIL
FDN. - FOUNDATION
THK. - THICK
R.C.C - REINFORCED CEMENT CONCRETE
MKD. - MARKED

NOTES:-

1. ALL DIMENSIONS ARE IN MILLIMETRES AND LEVELS AND CO-ORDINATES ARE IN METRES UNLESS OTHERWISE STATED.
2. NET SAFE BEARING CAPACITY OF SOIL AT BOTTOM OF FOUNDATION IS CONSIDERED AS 450KN/ SQ. M.
3. GRADE OF CONCRETE SHALL BE C35 (35Mpa) FOR FOUNDATION AND C15 (15Mpa) FOR BLINDING CONCRETE.

DOCUMENT NUMBER	REFERENCE DOCUMENTS	REV	DATE	REVISION DESCRIPTION	DRN	CHK	ENG	APP	EMP
		D01	14/03/2023	AS-BUILT	MNS	SJM	AVG	AG	
		C04	23/02/2021	ISSUED FOR CONSTRUCTION AND REVISED AS MKD. C04	MNS	SJM	AVG	AG	
		C03	09/01/2021	ISSUED FOR CONSTRUCTION AND REVISED AS MKD. C03	ABS	SJM	AVG	AG	
		C02	06/01/2021	ISSUED FOR CONSTRUCTION AND REVISED AS MKD. C02	ABS	SJM	AVG	AG	
MD-216-49PQ-EG-CV-GAD-1612	DETAIL OF FOUNDATIONS	C01	12/10/2020	ISSUED FOR CONSTRUCTION AND REVISED AS MKD. C01	MNS	SJM	AVG	AG	
MD-216-1000-EG-ST-CRT-1001	CIVIL, STRUCTURAL & ARCHITECTURAL - DESIGN CRITERIA	A01	28/08/2020	ISSUED FOR REFERENCE	ABS	SJM	AVG	AG	

RESERVED FOR VENDOR LOGO AND DRAWING NUMBER

LARSEN & TOUBRO
This drawing is the property of LARSEN & TOUBRO and must not be passed on to any person or body not authorized by us to receive it nor be copied or otherwise made use either in full or in part by such person or body without our prior permission in writing.

Outotec
The content of these documents are the sole property of Outotec Oyj. Any rights not expressly granted herein are reserved. Reproduction, transfer or distribution of part or all of the contents in any form without prior written permission of Outotec is prohibited.

MA'ADEN معادن
Saudi Arabian Mining Company شركة معادن العربية السعودية
This document and the information contained herein is Ma'aden proprietary know-how. This document or any part thereof should not be reproduced, stored in a retrieval system or transmitted by any means, electronic or otherwise, or divulged without prior written permission of Ma'aden.

LARSEN & TOUBRO DRAWING NUMBER	019045_950_C_G_24303_001	REVISION 5
OUTOTEC DRAWING NUMBER	900707 _GAU01 _WD01_ MTL01 _45025	DOCUMENT ID OU100684602 / REVISION 5

DRAWN	ABS	10/08/2020
CHECKED	SJM	26/08/2020
ENGINEER	AVG	11/08/2020
APPROVED	AG	28/08/2020
EMPLOYER		
SCALE	1:75	A1

MANSOURAH - MASSARAH GOLD PROJECT
GENERAL ARRANGEMENT DRAWING
PROCESS PLANT SUBSTATION 02
LAYOUT OF FOUNDATIONS

DRAWING NUMBER MD-216-49PQ-EG-CV-GAD-1611 REV D01