


DRAWING NUMBER MD-216-49PQ-EG-CV-GAD-1612 REV D01

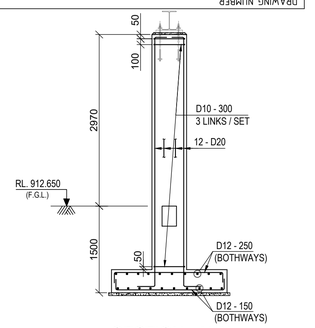


SECTION : A'-A'
SCALE 1:50

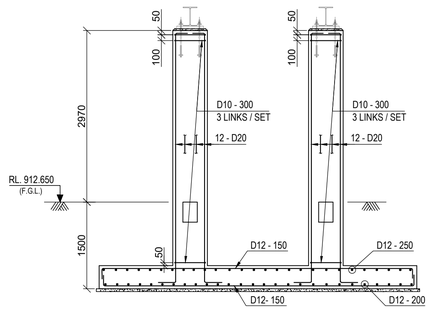


SECTION : B'-B'
SCALE 1:50

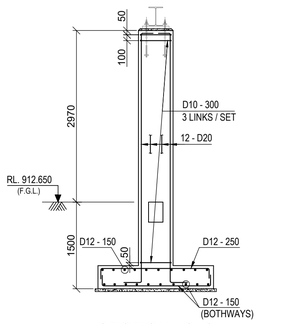


SECTION : C'-C'
SCALE 1:50

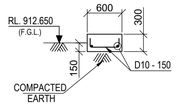


SECTION : F-F

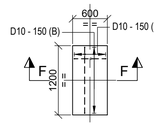


DET. OF FOUNDATION
MKD. F7
SCALE 1:50

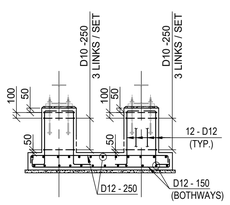


SECTION : E'-E'
SCALE 1:50

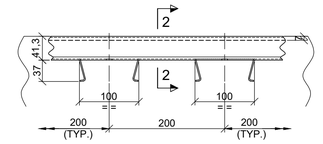


TYP. DET. OF INSERT MKD. IP-1 CHANNEL
TYPE E1000CI OR EQUIVALENT
SCALE - 1:5

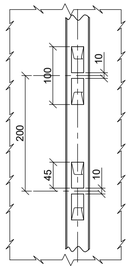


SECTION : 3-3
SCALE - 1:5

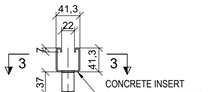


PLAN : 2-2
SCALE - 1:5

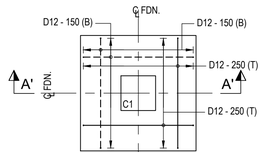


RC. DET. OF FOUNDATION
MKD. F1
SCALE 1:50

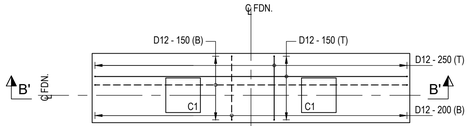


RC. DET. OF FOUNDATION
MKD. F2
SCALE 1:50

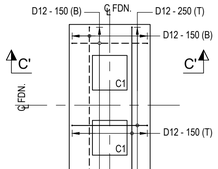


RC. DET. OF FOUNDATION
MKD. F3
SCALE 1:50

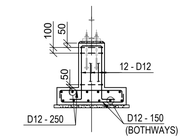


SECTION : D'-D'
SCALE 1:50

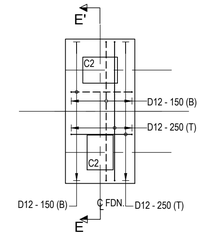


R.C DET. OF FOUNDATION
MKD. F6
SCALE 1:50

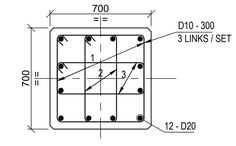


RC. DET. OF COLUMN
MKD. C1
SCALE 1:20

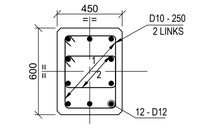


RC. DET. OF COLUMN
MKD. C2
SCALE 1:20

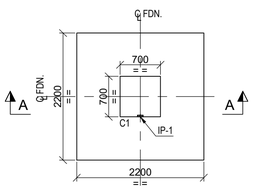


DET. OF FOUNDATION
MKD. F1
SCALE 1:50

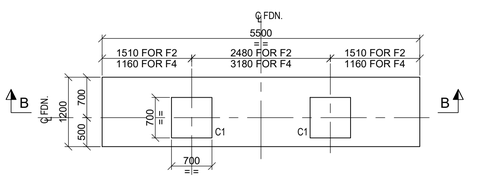


DET. OF FOUNDATION
MKD. F2 & F4
SCALE 1:50

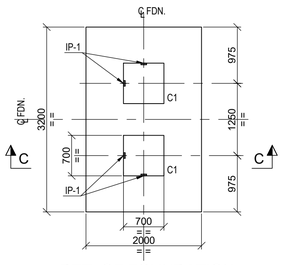


DET. OF FOUNDATION
MKD. F3
SCALE 1:50

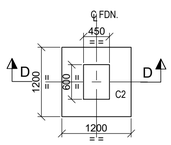


DET. OF FOUNDATION
MKD. F5
SCALE 1:50

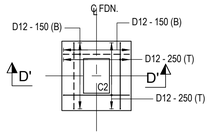


R.C DET. OF FOUNDATION
MKD. F5
SCALE 1:50

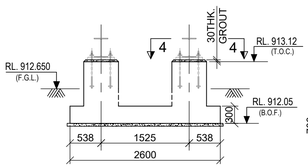


SECTION : E-E
SCALE 1:50

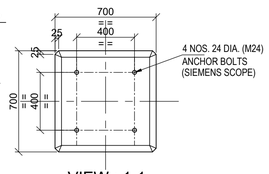


VIEW : 1-1
(DETAIL OF COL. MKD. C1)
SCALE 1:20

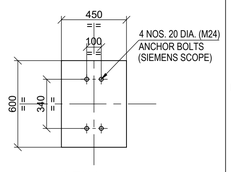


VIEW : 4-4
(DETAIL OF COL. MKD. C2)
SCALE 1:20

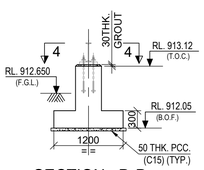


SECTION : D-D
SCALE 1:50

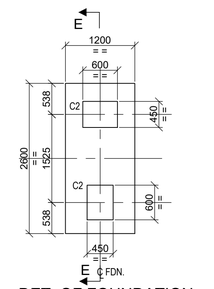


DET. OF FOUNDATION
MKD. F6
SCALE 1:50

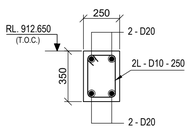


RC. DET. OF TB-1
SCALE 1:20

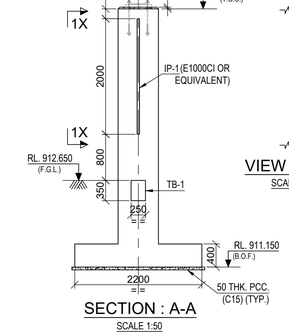


SECTION : A-A
SCALE 1:50

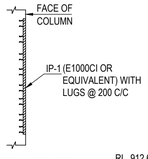

VIEW : 1X-1X
SCALE 1:50

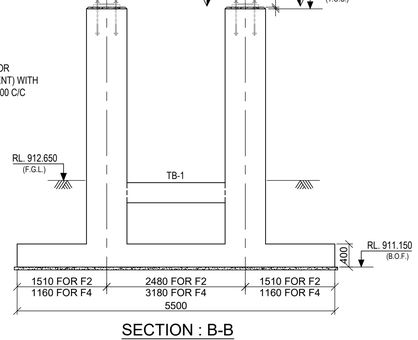

SECTION : B-B
SCALE 1:50

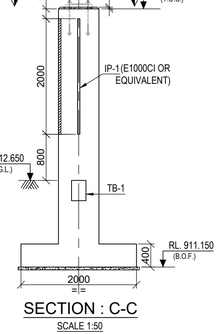

SECTION : C-C
SCALE 1:50

RESERVED FOR VENDOR LOGO AND DRAWING NUMBER

DOCUMENT NUMBER	REFERENCE DOCUMENTS	REV	DATE	REVISION DESCRIPTION	DRN	CHK	ENG	APP	EMP
		D01	14/03/2023	AS-BUILT	MNS	SJM	AVG	AG	
		C03	23/02/2021	ISSUED FOR CONSTRUCTION AND REVISED AS MKD. C03	MNS	SJM	AVG	AG	
		C02	09/01/2021	ISSUED FOR CONSTRUCTION AND REVISED AS MKD. C02	ABS	SJM	AVG	AG	
MD-216-49PQ-EG-CV-GAD-1611	LAYOUT OF FOUNDATIONS	C01	12/10/2020	ISSUED FOR CONSTRUCTION AND REVISED AS MKD. C01	MNS	SJM	AVG	AG	
MD-216-1000-EG-ST-CRT-1001	CIVIL, STRUCTURAL & ARCHITECTURAL - DESIGN CRITERIA	A01	29/08/2020	ISSUED FOR REFERENCE	ABS	SJM	AVG	AG	

LARSEN & TOUBRO

This drawing is the property of LARSEN & TOUBRO and must not be passed on to any person or body not authorized by us to receive it nor be copied or otherwise made use either in full or in part by such person or body without our prior permission in writing.

Outotec

The content of these documents are the sole property of Outotec Oyj. Any rights not expressly granted herein are reserved. Reproduction, transfer or distribution of part or all of the contents in any form without prior written permission of Outotec is prohibited.

MA'ADEN معادن
Saudi Arabian Mining Company شركة المعادن العربية السعودية

This document and the information contained herein is Ma'aden proprietary know-how. This document or any part thereof should not be reproduced, stored in a retrieval system or transmitted by any means, electronic or otherwise, or divulged without prior written permission of Ma'aden.

DRAWN	ABS	10/08/2020
CHECKED	SJM	26/08/2020
ENGINEER	AVG	11/08/2020
APPROVED	AG	29/08/2020
EMPLOYER		
SCALE	1:50, 1:20, 1:5	A1

LARSEN & TOUBRO DRAWING NUMBER: 019045_950_C_G_24303_002 — REVISION: 4
OUTOTEC DRAWING NUMBER: 900707 __GAU01 __WD01__MTL01 __45026 — DOCUMENT ID: OU100684603 — REVISION: 4

MANSOURAH - MASSARAH GOLD PROJECT
GENERAL ARRANGEMENT DRAWING
PROCESS PLANT SUBSTATION 02
DETAIL OF FOUNDATIONS

DRAWING NUMBER: MD-216-49PQ-EG-CV-GAD-1612 — REV: D01

NOTES:-

1. ALL DIMENSIONS ARE IN MILLIMETRES AND LEVELS AND CO-ORDINATES ARE IN METRES UNLESS OTHERWISE STATED.
2. GRADE OF CONCRETE SHALL BE C35 (35MPa) FOR FOUNDATION & C15 (15MPa) FOR BLINDING CONCRETE.
3. GRADE OF REINFORCEMENT SHALL BE DEFORMED BAR 420 MPa (GRADE 60) - ASTM A615/A615M.
4. NET SAFE BEARING CAPACITY OF SOIL AT BOTTOM OF FOUNDATION CONSIDERED AS 450KN/ SQ. M
5. CLEAR COVER TO REINFORCEMENT SHALL BE FOUNDATIONS = 50 MM., COLUMNS = 50 MM.
6. FOR STANDARD REINFORCEMENT DETAIL & GENERAL NOTES FOR CIVIL WORKS REFER DRAWING NO. MD-216-1000-EG-CV-DED-1005 & 1001.

LEGEND :-

R.L. - REDUCED LEVEL
℄ - CENTRE LINE
T.O.C. - TOP OF CONCRETE
T.O.G. - TOP OF GROUT
TYP. - TYPICAL
F.G.L. - FINISHED GROUND LEVEL
F.F.L. - FINISHED FLOOR LEVEL
B.O.F. - BOTTOM OF FOUNDATION
MKD. - MARKED
THK. - THICK
BOTTOM REINFORCEMENT (B) - - - - - - -
TOP REINFORCEMENT (T) - ———
R.C. - REINFORCED CONCRETE
P.C.C - PLAIN CEMENT CONCRETE
FDN. - FOUNDATION
DET. - DETAIL
COL. - COLUMN
DIA. - DIAMETER