

DRAWING NUMBER: MD-216-49PQ-EG-CV-GAD-1613 | REV: D01

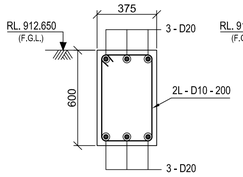


RC. DET. OF PB1

SCALE 1:20

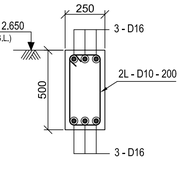


RC. DET. OF PB2

SCALE 1:20

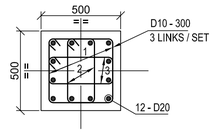

RC. DET. OF COLUMN MKD. C1


SCALE 1:20

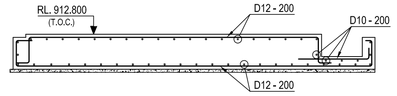

SECTION : A-A

(RC. DETAIL)


SCALE 1:50

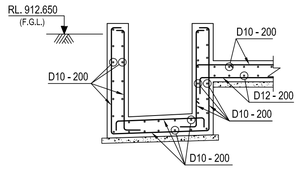

SECTION : C-C


(RC. DETAIL)

SCALE 1:30

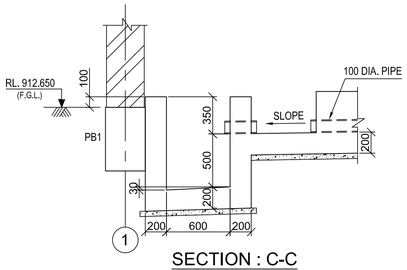

SECTION : C-C


SCALE 1:30

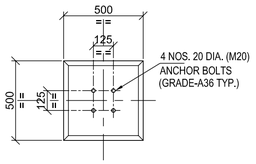

VIEW : 1-1


(DETAIL OF COLUMN MKD. C1)

SCALE 1:20

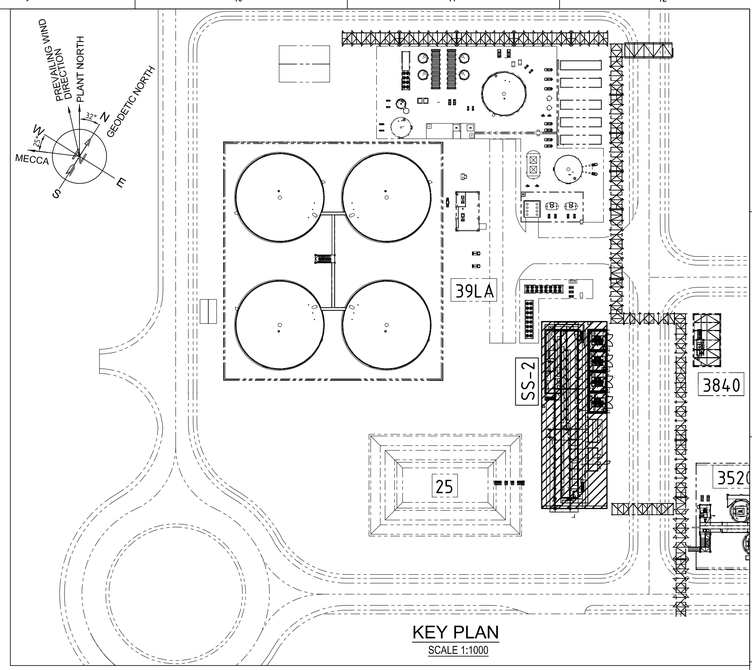

KEY PLAN


SCALE 1:1000

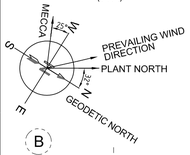

LAYOUT OF TRANSFORMER AREA


SCALE 1:75

ALL CABLE CONDUITS SHALL BE LAID AS PER ELECTRICAL DWG. MD-216-49PQ-EG-EL-LAD-1014

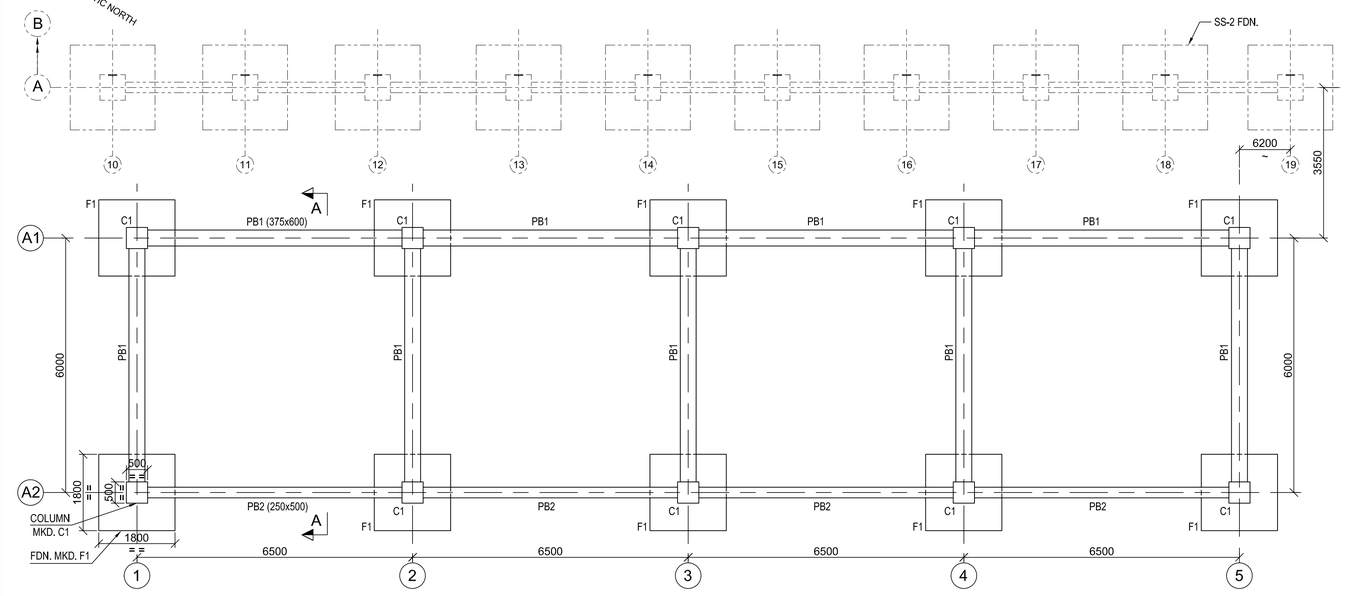


LAYOUT OF FOUNDATION

SCALE 1:75

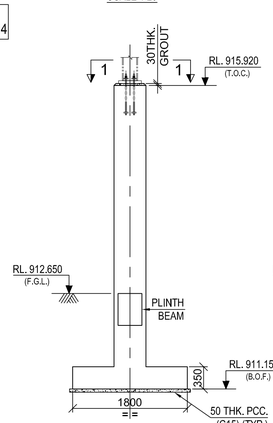


SECTION : B-B

SCALE 1:50

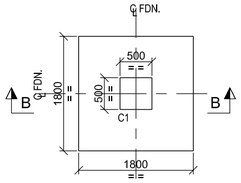


DET. OF FOUNDATION MKD. F1

SCALE 1:50

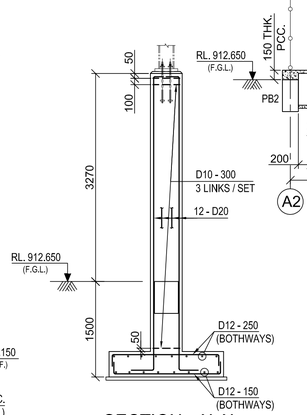


SECTION : A'-A'

SCALE 1:50

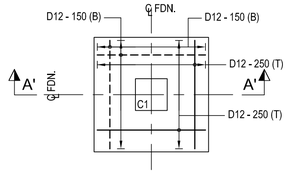

RC. DET. OF FOUNDATION MKD. F1

SCALE 1:50

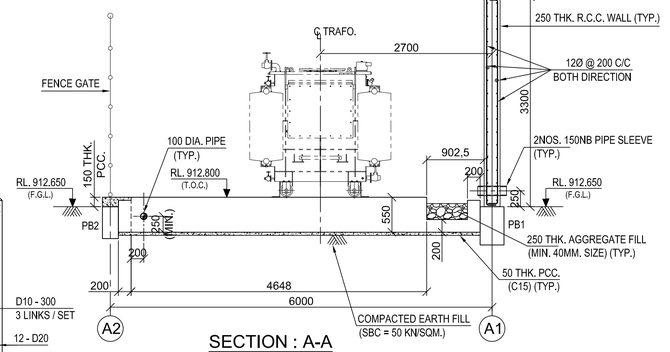

SECTION : A-A

SCALE 1:50

LEGEND :-

R.L. - REDUCED LEVEL
℄ - CENTRE LINE
T.O.C. - TOP OF CONCRETE
TYP. - TYPICAL
T.O.G. - TOP OF GROUT
B.O.F. - BOTTOM OF FOUNDATION
F.G.L. - FINISHED GROUND LEVEL.
F.F.L. - FINISHED FLOOR LEVEL
P.C.C - PLAIN CEMENT CONCRETE
DET. - DETAIL
FDN. - FOUNDATION
THK. - THICK
R.C. - REINFORCED CONCRETE
MKD. - MARKED
DIA. - DIAMETER
BOTTOM REINFORCEMENT (B) - - - - - - -
TOP REINFORCEMENT (T) - ———
TRAFO. - TRANSFORMER

NOTES:-

1. ALL DIMENSIONS ARE IN MILLIMETRES AND LEVELS AND CO-ORDINATES ARE IN METRES UNLESS OTHERWISE STATED.
2. NET SAFE BEARING CAPACITY OF SOIL AT BOTTOM OF FOUNDATION IS CONSIDERED AS 450KN/ SQ. M.
3. GRADE OF CONCRETE SHALL BE C35 (35Mpa) FOR FOUNDATION AND C15 (15Mpa) FOR BLINDING CONCRETE.
4. GRADE OF REINFORCEMENT SHALL BE DEFORMED BAR 420 MPa (GRADE 60) - ASTM A615/A615M.
5. CLEAR COVER TO REINFORCEMENT SHALL BE FOUNDATIONS = 50 MM., COLUMNS = 50 MM., BEAM = 25 MM.
6. FOR STANDARD REINFORCEMENT DETAIL & GENERAL NOTES FOR CIVIL WORKS REFER DRAWING NO. MD-216-1000-EG-CV-DED-1005 & 1001.

DOCUMENT NUMBER	REFERENCE DOCUMENTS	REV	DATE	REVISION DESCRIPTION	DRN	CHK	ENG	APP	EMP
		D01	11/04/2023	AS-BUILT	ABS	SJM	AVG	AG	
		C02	23/02/2021	ISSUED FOR CONSTRUCTION & REVISED AS MKD.	ABS	SJM	AVG	AG	
MD-216-49PQ-EG-CV-GAD-1611	LAYOUT OF FOUNDATIONS	C01	27/11/2020	ISSUED FOR CONSTRUCTION & REVISED AS MKD.	ABS	SJM	AVG	AG	
MD-216-1000-EG-ST-CRT-1001	CIVIL, STRUCTURAL & ARCHITECTURAL - DESIGN CRITERIA	A01	28/08/2020	ISSUED FOR REFERENCE	ABS	SJM	AVG	AG	

RESERVED FOR VENDOR LOGO AND DRAWING NUMBER

LARSEN & TOUBRO

This drawing is the property of LARSEN & TOUBRO and must not be passed on to any person or body not authorized by us to receive it nor be copied or otherwise made use either in full or in part by such person or body without our prior permission in writing.

Outotec

The content of these documents are the sole property of Outotec Oyj. Any rights not expressly granted herein are reserved. Reproduction, transfer or distribution of part or all of the contents in any form without prior written permission of Outotec is prohibited.

MA'ADEN معادن
Saudi Arabian Mining Company شركة معادن العربية السعودية

This document and the information contained herein is Ma'aden proprietary know-how. This document or any part thereof should not be reproduced, stored in a retrieval system or transmitted by any means, electronic or otherwise, or divulged without prior written permission of Ma'aden.

LARSEN & TOUBRO DRAWING NUMBER	019045_950_C_G_24304_001		REVISION 3
OUTOTEC DRAWING NUMBER	900707__GAU01__WD01__MTL01__45027	DOCUMENT ID OU100684604	REVISION 3
DRAWN	ABS	14/08/2020	
CHECKED	SJM	26/08/2020	
ENGINEER	AVG	17/08/2020	
APPROVED	AG	28/08/2020	
EMPLOYER			
SCALE	1:75, 1:50, 1:20	A1	

MANSOURAH - MASSARAH GOLD PROJECT
GENERAL ARRANGEMENT DRAWING
PROCESS PLANT SUBSTATION 02
DETAIL OF TRANSFORMER AREA

DRAWING NUMBER: MD-216-49PQ-EG-CV-GAD-1613 | REV: D01