


DRAWING NUMBER: MD-216-49PQ-EG-CV-GAD-1623
REV: D01

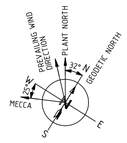

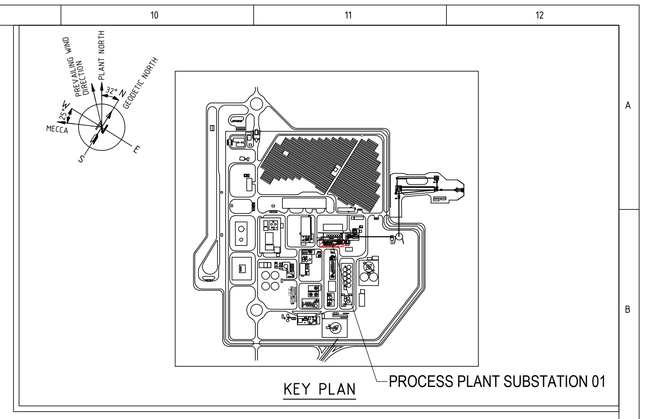

KEY PLAN

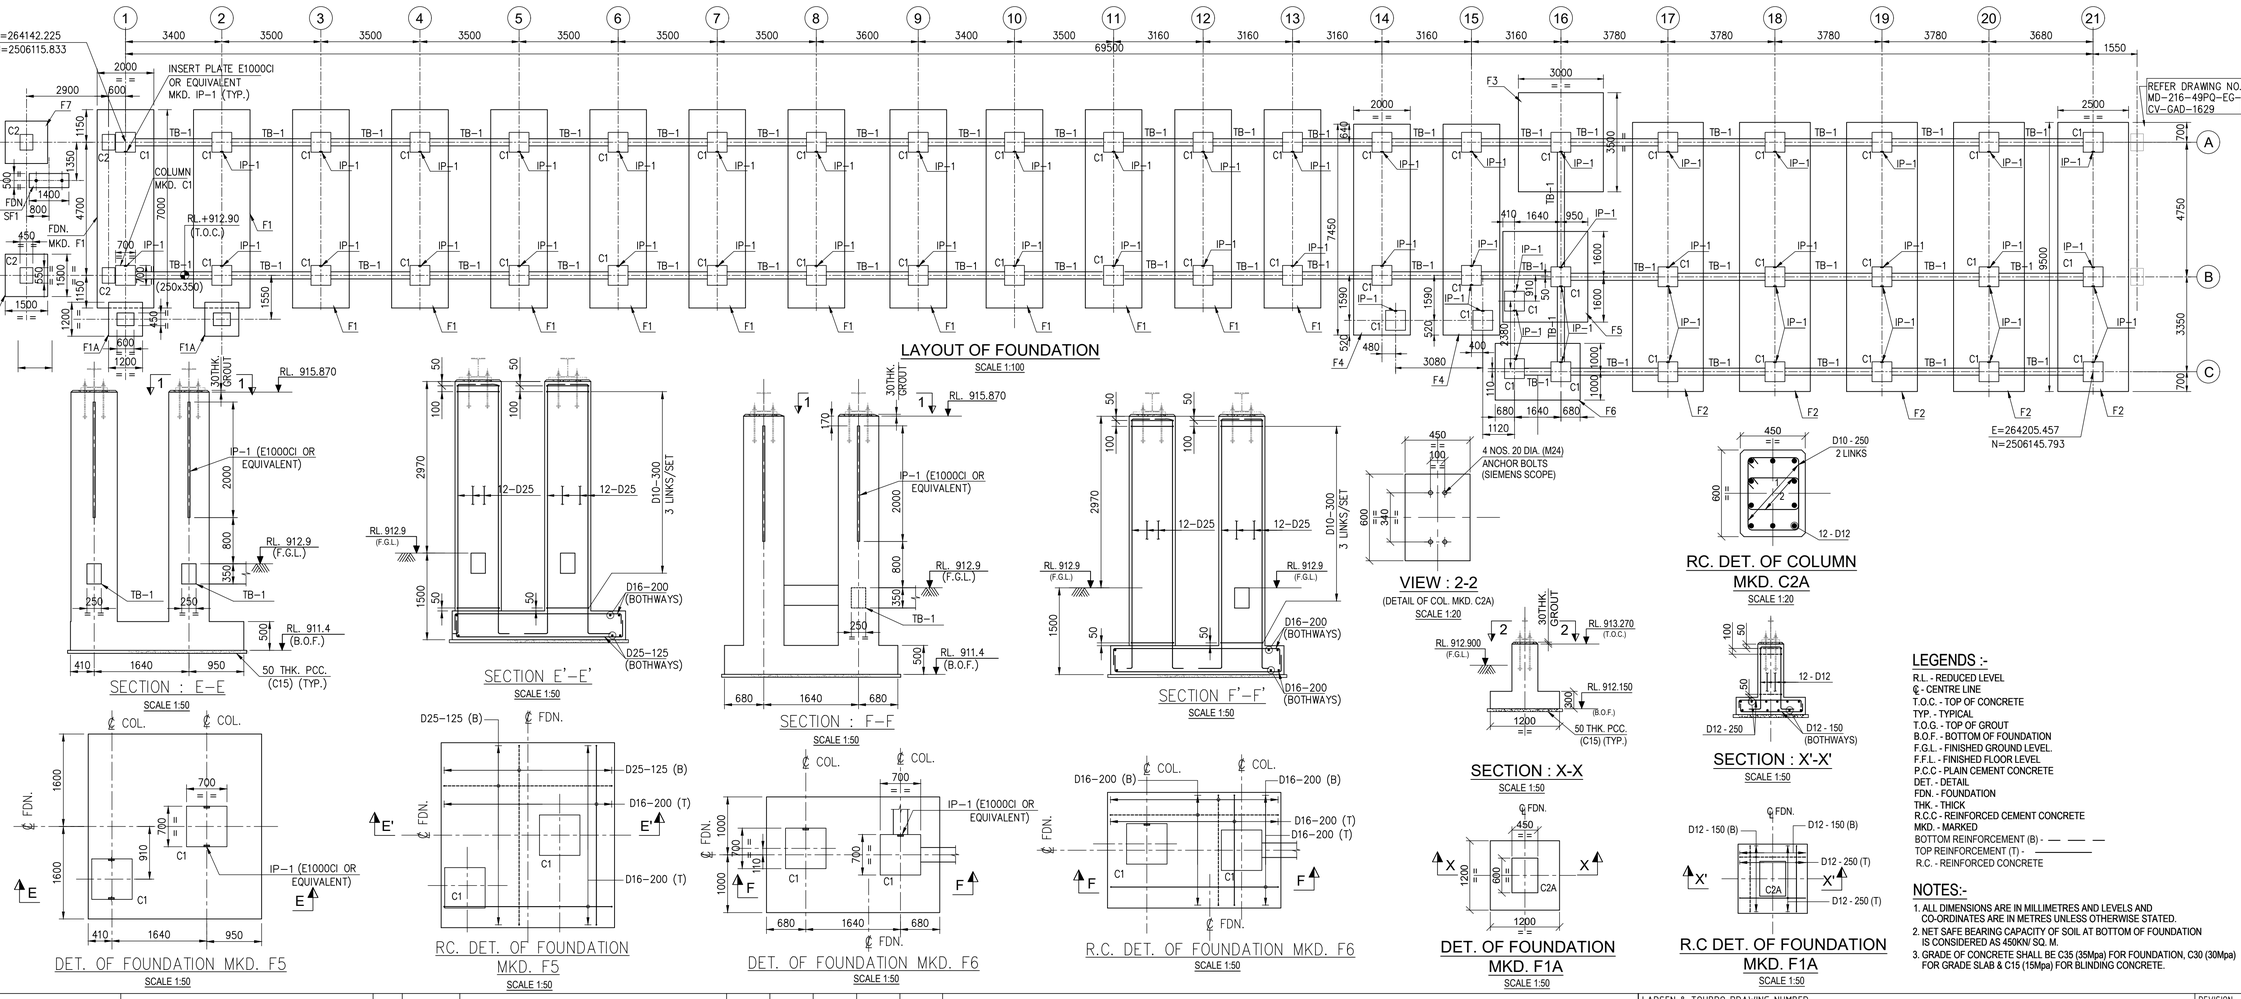

LAYOUT OF FOUNDATION
SCALE 1:100

SECTION : E-E
SCALE 1:50

SECTION E'-E'
SCALE 1:50

SECTION : F-F
SCALE 1:50

SECTION F'-F'
SCALE 1:50

VIEW : 2-2
(DETAIL OF COL. MKD. C2A)
SCALE 1:20

RC. DET. OF COLUMN MKD. C2A
SCALE 1:20

SECTION : X-X
SCALE 1:50

SECTION : X'-X'
SCALE 1:50

DET. OF FOUNDATION MKD. F5
SCALE 1:50

RC. DET. OF FOUNDATION MKD. F5
SCALE 1:50

DET. OF FOUNDATION MKD. F6
SCALE 1:50

R.C. DET. OF FOUNDATION MKD. F6
SCALE 1:50

DET. OF FOUNDATION MKD. F1A
SCALE 1:50

R.C DET. OF FOUNDATION MKD. F1A
SCALE 1:50

LEGENDS :-

R.L. - REDUCED LEVEL
℄ - CENTRE LINE
T.O.C. - TOP OF CONCRETE
TYP. - TYPICAL
T.O.G. - TOP OF GROUT
B.O.F. - BOTTOM OF FOUNDATION
F.G.L. - FINISHED GROUND LEVEL.
F.F.L. - FINISHED FLOOR LEVEL
P.C.C - PLAIN CEMENT CONCRETE
DET. - DETAIL
FDN. - FOUNDATION
THK. - THICK
R.C.C - REINFORCED CEMENT CONCRETE
MKD. - MARKED
BOTTOM REINFORCEMENT (B) - — — —
TOP REINFORCEMENT (T) - ————
R.C. - REINFORCED CONCRETE

NOTES:-

1. ALL DIMENSIONS ARE IN MILLIMETRES AND LEVELS AND CO-ORDINATES ARE IN METRES UNLESS OTHERWISE STATED.
2. NET SAFE BEARING CAPACITY OF SOIL AT BOTTOM OF FOUNDATION IS CONSIDERED AS 450KN/ SQ. M.
3. GRADE OF CONCRETE SHALL BE C35 (35Mpa) FOR FOUNDATION, C30 (30Mpa) FOR GRADE SLAB & C15 (15Mpa) FOR BLINDING CONCRETE.

DOCUMENT NUMBER	REFERENCE DOCUMENTS		DATE	REVISION DESCRIPTION	DRN	CHK	ENG	APP	EMP
		D01	14/03/2023	AS-BUILT	SYA	SJM	AVG	AG	
		C03	07/08/2021	ISSUED FOR CONSTRUCTION & REVISED AS MARKED. (C03)	SYA	SJM	AVG	AG	
		C02	08/03/2021	ISSUED FOR CONSTRUCTION & REVISED AS MARKED. (C02)	ABS	SJM	AVG	AG	
MD-216-49PQ-EG-CV-GAD-1624	DETAIL OF FOUNDATIONS	C01	10/12/2020	ISSUED FOR CONSTRUCTION & REVISED AS MARKED. (C01)	TEC	SJM	AVG	AG	
MD-216-1000-EG-ST-CRT-1001	CIVIL, STRUCTURAL & ARCHITECTURAL - DESIGN CRITERIA	A01	20/10/2020	ISSUED FOR REFERENCE	TEC	SJM	AVG	AG	

LARSEN & TOUBRO
This drawing is the property of LARSEN & TOUBRO and must not be passed on to any person or body not authorized by us to receive it nor be copied or otherwise made use either in full or in part by such person or body without our prior permission in writing.

Outotec
The content of these documents are the sole property of Outotec Oyj. Any rights not expressly granted herein are reserved. Reproduction, transfer or distribution of part or all of the contents in any form without prior written permission of Outotec is prohibited.

MA'ADEN معادن
Saudi Arabian Mining Company شركة معادن العربية السعودية
This document and the information contained herein is Ma'aden proprietary know-how. This document or any part thereof should not be reproduced, stored in a retrieval system or transmitted by any means, electronic or otherwise, or divulged without prior written permission of Ma'aden.

DRAWN	SAIKAT	17/10/2020	
CHECKED	SJM	19/10/2020	
ENGINEER	AVG	17/10/2020	
APPROVED	AG	20/10/2020	
EMPLOYER			
SCALE	1:100	A1	

LARSEN & TOUBRO DRAWING NUMBER: 019045_950_C_G_24438_001 — REVISION: 4
OUTOTEC DRAWING NUMBER: 900707__GAU01__WD01__MTL01__45076 — DOCUMENT ID: OU100704414 — REVISION: 4

MANSOURAH - MASSARAH GOLD PROJECT
GENERAL ARRANGEMENT DRAWING
PROCESS PLANT SUBSTATION 01
LAYOUT OF FOUNDATIONS

DRAWING NUMBER: MD-216-49PQ-EG-CV-GAD-1623 — REV: D01