

DRAWING NUMBER: MD-216-49PQ-EG-CV-GAD-1624 | REV: D01

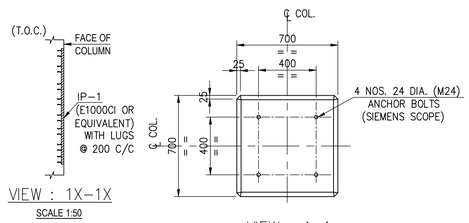


VIEW : 1X-1X
SCALE 1:50


VIEW : 1-1
(DETAIL OF COL. MKD. C1)
SCALE 1:20

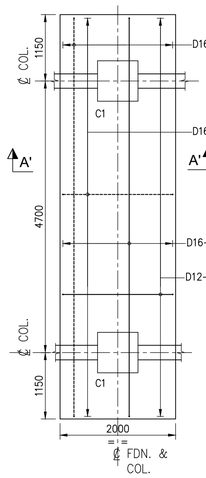


DET. OF FOUNDATION MKD. F1
SCALE 1:50

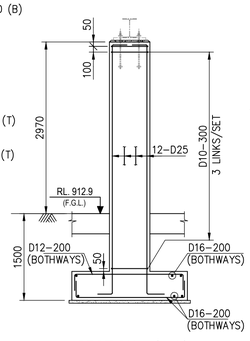


SECTION A'-A'
SCALE 1:50

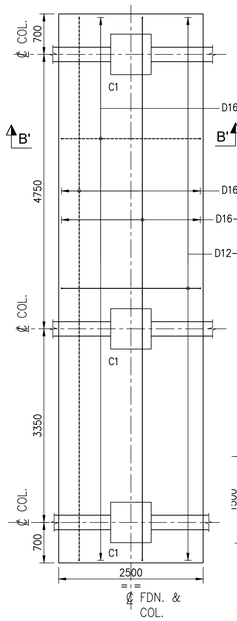


DET. OF FOUNDATION MKD. F2
SCALE 1:50

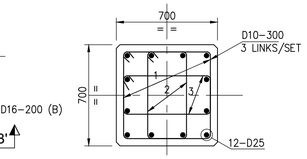


RC. DET. OF COLUMN MKD. C1
SCALE 1:20

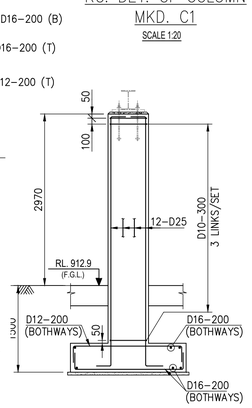


SECTION B'-B'
SCALE 1:50

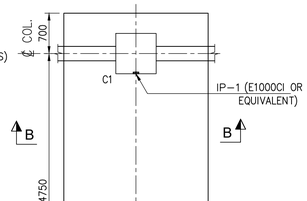


DET. OF FOUNDATION MKD. F2
SCALE 1:50

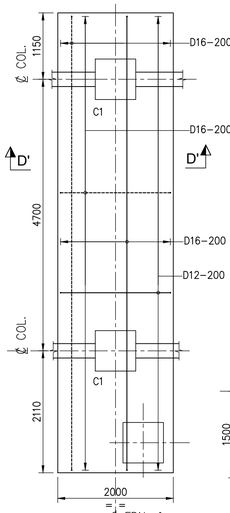


DET. OF FOUNDATION MKD. F4
SCALE 1:50

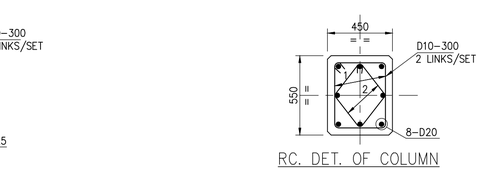


RC. DET. OF COLUMN MKD. C2
SCALE 1:20

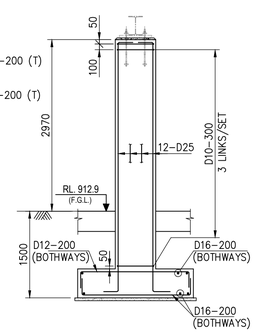


SECTION D'-D'
SCALE 1:50

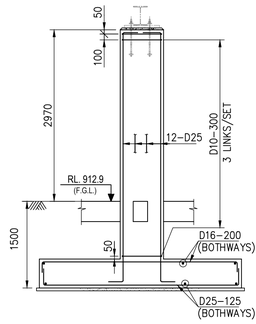


SECTION C'-C'
SCALE 1:50

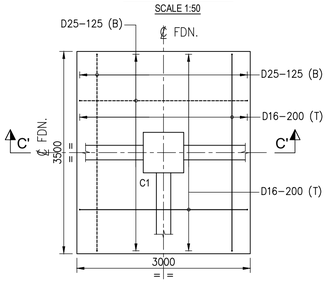


RC. DET. OF FOUNDATION MKD. F3
SCALE 1:50

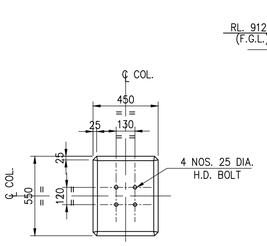


VIEW : 2-2
(DETAIL OF COL. MKD. C2)
SCALE 1:20

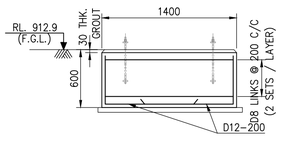


TYP. C/S OF STAIR FOUNDATION MKD. SF1
SCALE 1:30

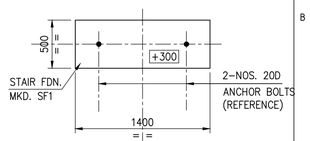


BOLT PLAN
(FOR STAIR PEDESTAL)
SCALE 1:30

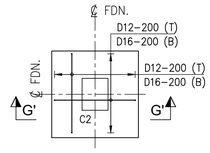


DET. OF FOUNDATION MKD. F7
SCALE 1:50

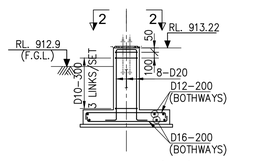


SECTION : G'-G'
SCALE 1:50

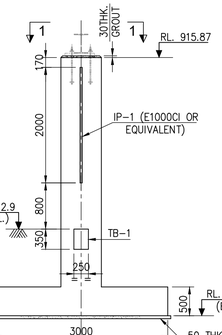


SECTION : C-C
SCALE 1:50

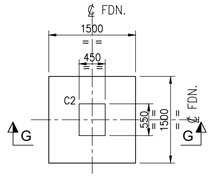


DET. OF FOUNDATION MKD. F7
SCALE 1:50

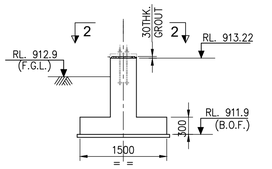


SECTION : G-G
SCALE 1:50

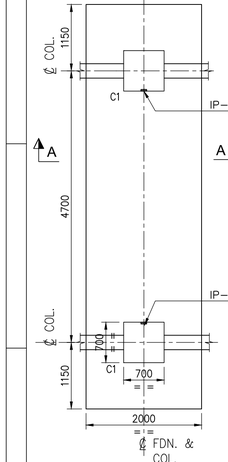


DET. OF FOUNDATION MKD. F1
SCALE 1:50

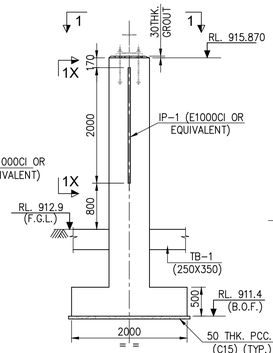


SECTION : A-A
SCALE 1:50

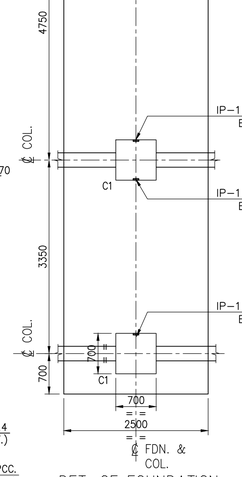


DET. OF FOUNDATION MKD. F2
SCALE 1:50

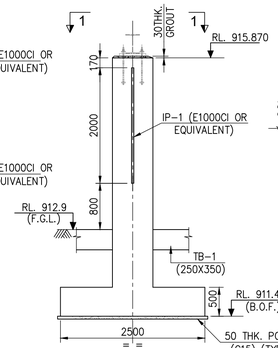


SECTION : B-B
SCALE 1:50

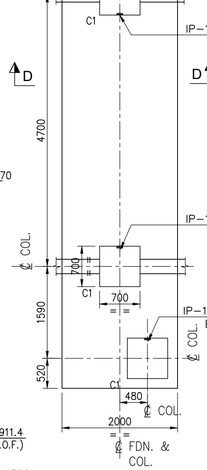


DET. OF FOUNDATION MKD. F4
SCALE 1:50

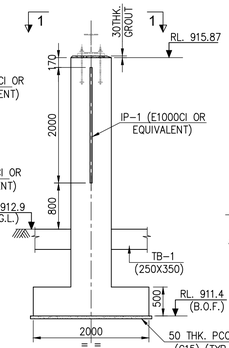

SECTION : D-D
SCALE 1:50

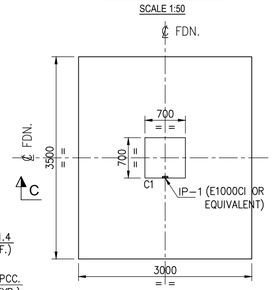

DET. OF FOUNDATION MKD. F3
SCALE 1:50

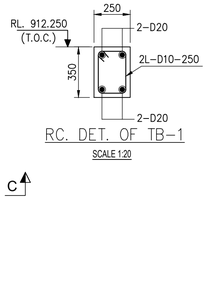

RC. DET. OF TB-1
SCALE 1:20

LEGENDS :-

R.L. - REDUCED LEVEL
℄ - CENTRE LINE
T.O.C. - TOP OF CONCRETE
T.O.G. - TOP OF GROUT
TYP. - TYPICAL
F.G.L. - FINISHED GROUND LEVEL
F.F.L. - FINISHED FLOOR LEVEL
B.O.F. - BOTTOM OF FOUNDATION
MKD. - MARKED
THK. - THICK
BOTTOM REINFORCEMENT (B) - - - - - -
TOP REINFORCEMENT (T) - ———
R.C. - REINFORCED CONCRETE
P.C.C - PLAIN CEMENT CONCRETE
FDN. - FOUNDATION
DET. - DETAIL
COL. - COLUMN
DIA. - DIAMETER
C/C- CENTRE TO CENTRE

NOTES:-

1. ALL DIMENSIONS ARE IN MILLIMETRES AND LEVELS AND CO-ORDINATES ARE IN METRES UNLESS OTHERWISE STATED.
2. GRADE OF CONCRETE SHALL BE C35 (35MPa) FOR FOUNDATION & C15 (15MPa) FOR BLINDING CONCRETE.
3. GRADE OF REINFORCEMENT SHALL BE DEFORMED BAR 420 MPa (GRADE 60) - ASTM A615/A615M.
4. NET SAFE BEARING CAPACITY OF SOIL AT BOTTOM OF FOUNDATION CONSIDERED AS 450KN/ SQ. M
5. CLEAR COVER TO REINFORCEMENT SHALL BE FOUNDATIONS = 50 MM., COLUMNS = 50 MM.
6. FOR STANDARD REINFORCEMENT DETAIL & GENERAL NOTES FOR CIVIL WORKS REFER DRAWING NO. MD-216-1000-EG-CV-DED-1005 & 1001.

DOCUMENTS NUMBER	REFERENCE DOCUMENTS	REV	DATE	REVISION DESCRIPTION	DRN	CHK	ENG	APP	EMP
		D01	14/03/2023	AS-BUILT	TEC	SJM	AVG	AG	
		C01	10/12/2020	ISSUED FOR CONSTRUCTION	TEC	SJM	AVG	AG	
MD-216-49FE-EG-GAD-1623	LAYOUT OF FOUNDATIONS	A01	20/10/2020	ISSUED FOR REFERENCE	TEC	SJM	AVG	AG	

LARSEN & TOUBRO

This drawing is the property of LARSEN & TOUBRO and must not be passed on to any person or body not authorized by us to receive it nor be copied or otherwise made use either in full or in part by such person or body without our prior permission in writing.

Outotec

The content of these documents are the sole property of Outotec Oyj. Any rights not expressly granted herein are reserved. Reproduction, transfer or distribution of part or all of the contents in any form without prior written permission of Outotec is prohibited.

MA'ADEN معادن
Saudi Arabian Mining Company شركة معادن العربية السعودية

This document and the information contained herein is Ma'aden proprietary know-how. This document or any part thereof should not be reproduced, stored in a retrieval system or transmitted by any means, electronic or otherwise, or divulged without prior written permission of Ma'aden.

LARSEN & TOUBRO DRAWING NUMBER: 019045_950_C_G_24438_002 | REVISION: 2
OUTOTEC DRAWING NUMBER: 900707__GAU01__WD01__MTL01__45077 | DOCUMENT ID: OU100704415 | REVISION: 2

DRAWN	SAIKAT	17/10/2020
CHECKED	SJM	19/10/2020
ENGINEER	AVG	17/10/2020
APPROVED	AG	20/10/2020
EMPLOYER		
SCALE	1:50,10	A1

MANSOURAH - MASSARAH GOLD PROJECT
GENERAL ARRANGEMENT DRAWING
PROCESS PLANT SUBSTATION 01
DETAIL OF FOUNDATIONS

DRAWING NUMBER: MD-216-49PQ-EG-CV-GAD-1624 | REV: D01