


DRAWING NUMBER: MD-216-49PQ-EG-CV-GAD-1625 | REV: D01

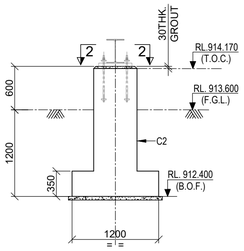

SECTION : B-B
SCALE 1:40

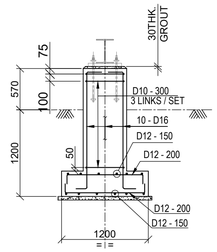


SECTION : B-B
(R.C DETAILS)
SCALE 1:40

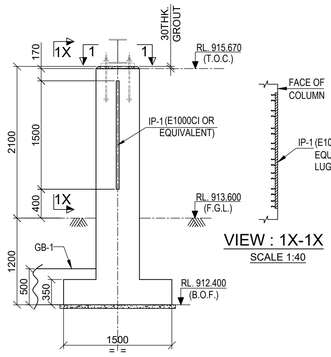


VIEW : 1X-1X
SCALE 1:40


SECTION : A-A
SCALE 1:40

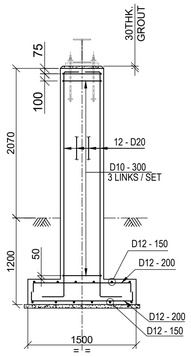


SECTION : A-A
(R.C DETAILS)
SCALE 1:40

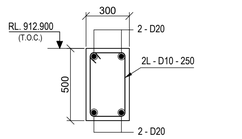


RC. DET. OF GB-1
SCALE 1:20

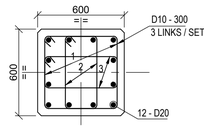


RC. DET. OF COLUMN MKD. C1
SCALE 1:20

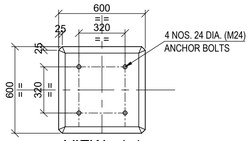



VIEW : 1-1
(DETAIL OF COL. MKD. C1)
SCALE 1:20

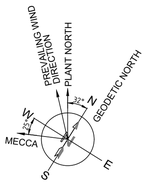

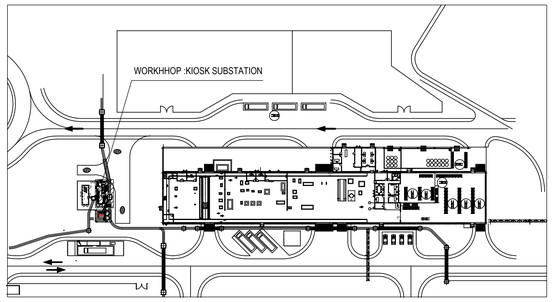


KEY PLAN
SCALE-1:500

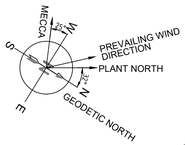


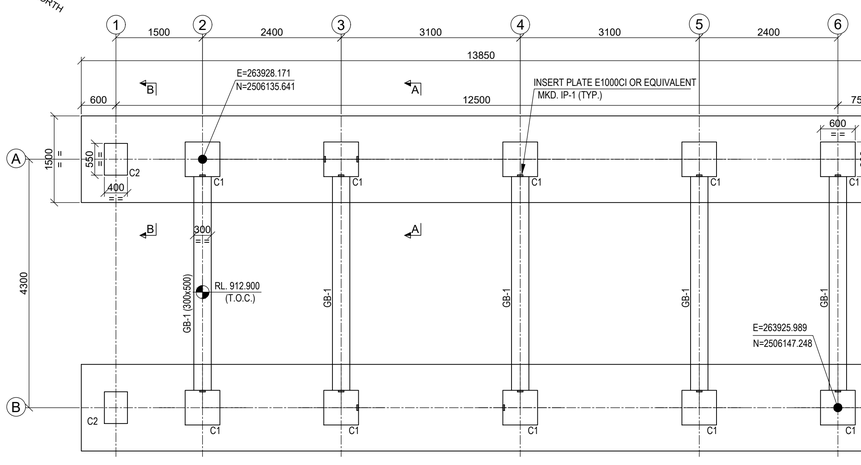


LAYOUT OF FOUNDATION
SCALE 1:50

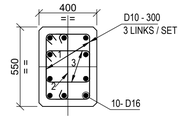


RC. DET. OF COLUMN MKD. C2
SCALE 1:20

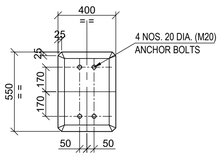


VIEW : 2-2
(DETAIL OF COL. MKD. C2)
SCALE 1:20

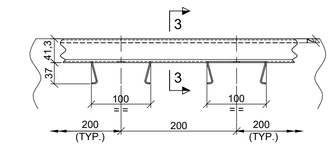

TYP. DET. OF INSERT MKD. IP-1 CHANNEL TYPE E1000CI OR EQUIVALENT
SCALE - 1:5

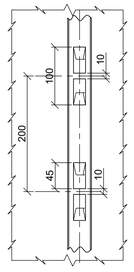

SECTION : 4-4
SCALE - 1:5

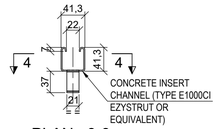

PLAN : 3-3
SCALE - 1:5

LEGENDS :-

R.L. - REDUCED LEVEL
℄ - CENTRE LINE
T.O.C. - TOP OF CONCRETE
TYP. - TYPICAL
T.O.G. - TOP OF GROUT
B.O.F. - BOTTOM OF FOUNDATION
F.G.L. - FINISHED GROUND LEVEL.
F.F.L. - FINISHED FLOOR LEVEL
P.C.C - PLAIN CEMENT CONCRETE
DET. - DETAIL
FDN. - FOUNDATION
THK. - THICK
R.C.C - REINFORCED CEMENT CONCRETE
MKD. - MARKED
BOTTOM REINFORCEMENT (B) - – – – – –
TOP REINFORCEMENT (T) - ————
R.C. - REINFORCED CONCRETE
SS. - SUBSTATION
DIA.-DIAMETER
MIN.-MINIMUM
C/C- CENTRE TO CENTRE
COL.-COLUMN

NOTES:-

1. ALL DIMENSIONS ARE IN MILLIMETRES AND LEVELS AND CO-ORDINATES ARE IN METRES UNLESS OTHERWISE STATED.
2. NET SAFE BEARING CAPACITY OF SOIL AT BOTTOM OF FOUNDATION IS CONSIDERED AS 250KN/ SQ. M.
3. GRADE OF CONCRETE SHALL BE C35 (35Mpa) FOR FOUNDATION, C30 (30Mpa) FOR GRADE SLAB & C15 (15Mpa) FOR BLINDING CONCRETE.

DOCUMENT NUMBER	REFERENCE DOCUMENTS	REV	DATE	REVISION DESCRIPTION	DRN	CHK	ENG	APP	EMP
MD-216-49PQ-EG-CV-GAD-1640	POWER DISTRIBUTION : WORKSHOP KIOSK SS.								
	DETAILS OF GRADE SLAB & ELECTRICAL CONDUITS	D01	14/03/2023	AS-BUILT	SYA	SJM	AVG	AG	
MD-216-49PQ-EG-CV-GAD-1639	POWER DISTRIBUTION : WORKSHOP KIOSK SS.	C02	05/10/2021	ISSUED FOR CONSTRUCTION & REVISED AS MARKED △C02	SYA	SJM	AVG	AG	
	LAYOUT & DETAIL OF GRADE SLAB & ELECTRICAL CONDUITS	C01	10/03/2021	ISSUED FOR CONSTRUCTION	ANI	SJM	AVG	AG	
MD-216-4000-EG-EL-LAD-1019	CABLE ROUTE LAYOUT-EMBEDED PART	A01	27/01/2021	ISSUED FOR APPROVAL	ANI	SJM	AVG	AG	

LARSEN & TOUBRO

This drawing is the property of LARSEN & TOUBRO and must not be passed on to any person or body not authorized by us to receive it nor be copied or otherwise made use either in full or in part by such person or body without our prior permission in writing.

Outotec

The content of these documents are the sole property of Outotec Oy). Any rights not expressly granted herein are reserved. Reproduction, transfer or distribution of part or all of the contents in any form without prior written permission of Outotec is prohibited.

MA'ADEN معادن
Saudi Arabian Mining Company شركة معادن العربية السعودية

This document and the information contained herein is Ma'aden proprietary know-how. This document or any part thereof should not be reproduced, stored in a retrieval system or transmitted by any means, electronic or otherwise, or divulged without prior written permission of Ma'aden.

LARSEN & TOUBRO DRAWING NUMBER	019045_950_C_G_24593_001		REVISION 3
OUTOTEC DRAWING NUMBER	900707__GAU01__WD01__MTL01__45080	DOCUMENT ID OU100712210	REVISION 3

DRAWN	ANI	06/01/2021
CHECKED	SJM	12/01/2021
ENGINEER	AVG	06/01/2021
APPROVED	AG	27/01/2021
EMPLOYER		
SCALE	1:50,20	A1

MANSOURAH - MASSARAH GOLD PROJECT
GENERAL ARRANGEMENT DRAWING
POWER DISTRIBUTION:WORKSHOP KIOSK SS.
LAYOUT & DETAILS OF FOUNDATIONS

DRAWING NUMBER: MD-216-49PQ-EG-CV-GAD-1625 | REV: D01