DRAWING NUMBER: MD-216-49PQ-EG-CV-GAD-1629 | REV: D01

CONDUIT MARKING TABLE		
CONDUIT TAG	CL. OF ELEVATION	DIA. OF CONDUIT
C001	RL. 912.250	150
C002	RL. 912.250	150
C003	RL. 912.250	150
C004	RL. 912.250	150
C005	RL. 912.250	150
C006	RL. 912.250	150
C007	RL. 912.250	150
C008	RL. 912.250	150
C009	RL. 912.250	150
C010	RL. 912.000	150
C011	RL. 912.000	150
C012	RL. 912.000	150
C013	RL. 912.000	150
C014	RL. 912.000	150
C015	RL. 912.000	150


CONDUIT MARKING TABLE		
CONDUIT TAG	CL. OF ELEVATION	DIA. OF CONDUIT
C016	RL. 912.000	150
C017	RL. 912.000	150
C018	RL. 912.000	150
C052	RL. 912.250	150
C053	RL. 912.250	150
C054	RL. 912.250	150
C055	RL. 912.250	150
C056	RL. 912.000	150
C057	RL. 912.000	150
C058	RL. 912.000	150
C059	RL. 912.000	150
C100	RL. 911.450	200
C101	RL. 911.450	200
C102	RL. 911.150	200
C103	RL. 911.150	200

CONDUIT MARKING TABLE		
CONDUIT TAG	CL. OF ELEVATION	DIA. OF CONDUIT
C104	RL. 912.050	200
C105	RL. 911.450	200
C106	RL. 912.050	200
C107	RL. 912.050	200
C108	RL. 911.750	200
C109	RL. 911.750	200
C110	RL. 911.450	200
C111	RL. 911.450	200
C112	RL. 911.150	200
C113	RL. 912.050	200
C114	RL. 911.450	200
C115	RL. 912.050	200
C116	RL. 912.050	200
C117	RL. 911.750	200
C118	RL. 911.750	200


CONDUIT MARKING TABLE		
CONDUIT TAG	CL. OF ELEVATION	DIA. OF CONDUIT
C119	RL. 911.450	200
C120	RL. 911.450	200
C121	RL. 911.150	200
C122	RL. 912.050	200
C123	RL. 911.450	200
C124	RL. 912.050	200
C125	RL. 912.050	200
C126	RL. 911.750	200
C127	RL. 911.750	200
C128	RL. 911.450	200
C129	RL. 911.450	200
C130	RL. 911.150	200
C131	RL. 912.050	200
C132	RL. 911.450	200
C133	RL. 912.050	200

CONDUIT MARKING TABLE		
CONDUIT TAG	CL. OF ELEVATION	DIA. OF CONDUIT
C134	RL. 912.050	200
C135	RL. 911.750	200
C136	RL. 911.750	200
C137	RL. 911.450	200
C138	RL. 911.450	200
C139	RL. 911.150	200
C140	RL. 912.050	200
C141	RL. 911.450	200
C142	RL. 912.050	200
C143	RL. 912.050	200
C144	RL. 911.750	200
C145	RL. 911.750	200
C146	RL. 911.450	200
C147	RL. 911.450	200
C148	RL. 911.450	200
C149	RL. 911.450	200


CONDUIT MARKING TABLE		
CONDUIT TAG	CL. OF ELEVATION	DIA. OF CONDUIT
C150	RL. 911.150	200
C151	RL. 911.150	200
C152	RL. 911.150	200
C153	RL. 911.150	200
C154	RL. 911.450	200
C155	RL. 911.450	200
C156	RL. 911.450	200
C157	RL. 911.450	200
C158	RL. 911.150	200
C159	RL. 911.150	200
C160	RL. 911.150	200
C161	RL. 911.150	200

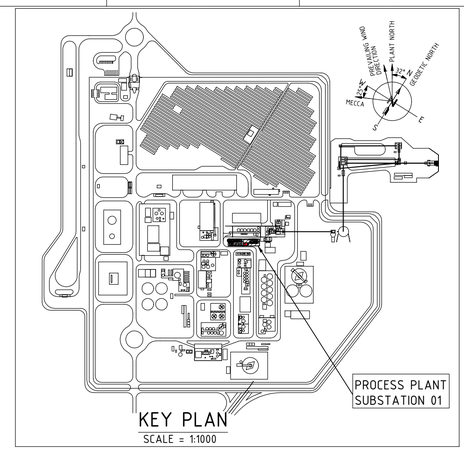


KEY PLAN
SCALE = 1:1000

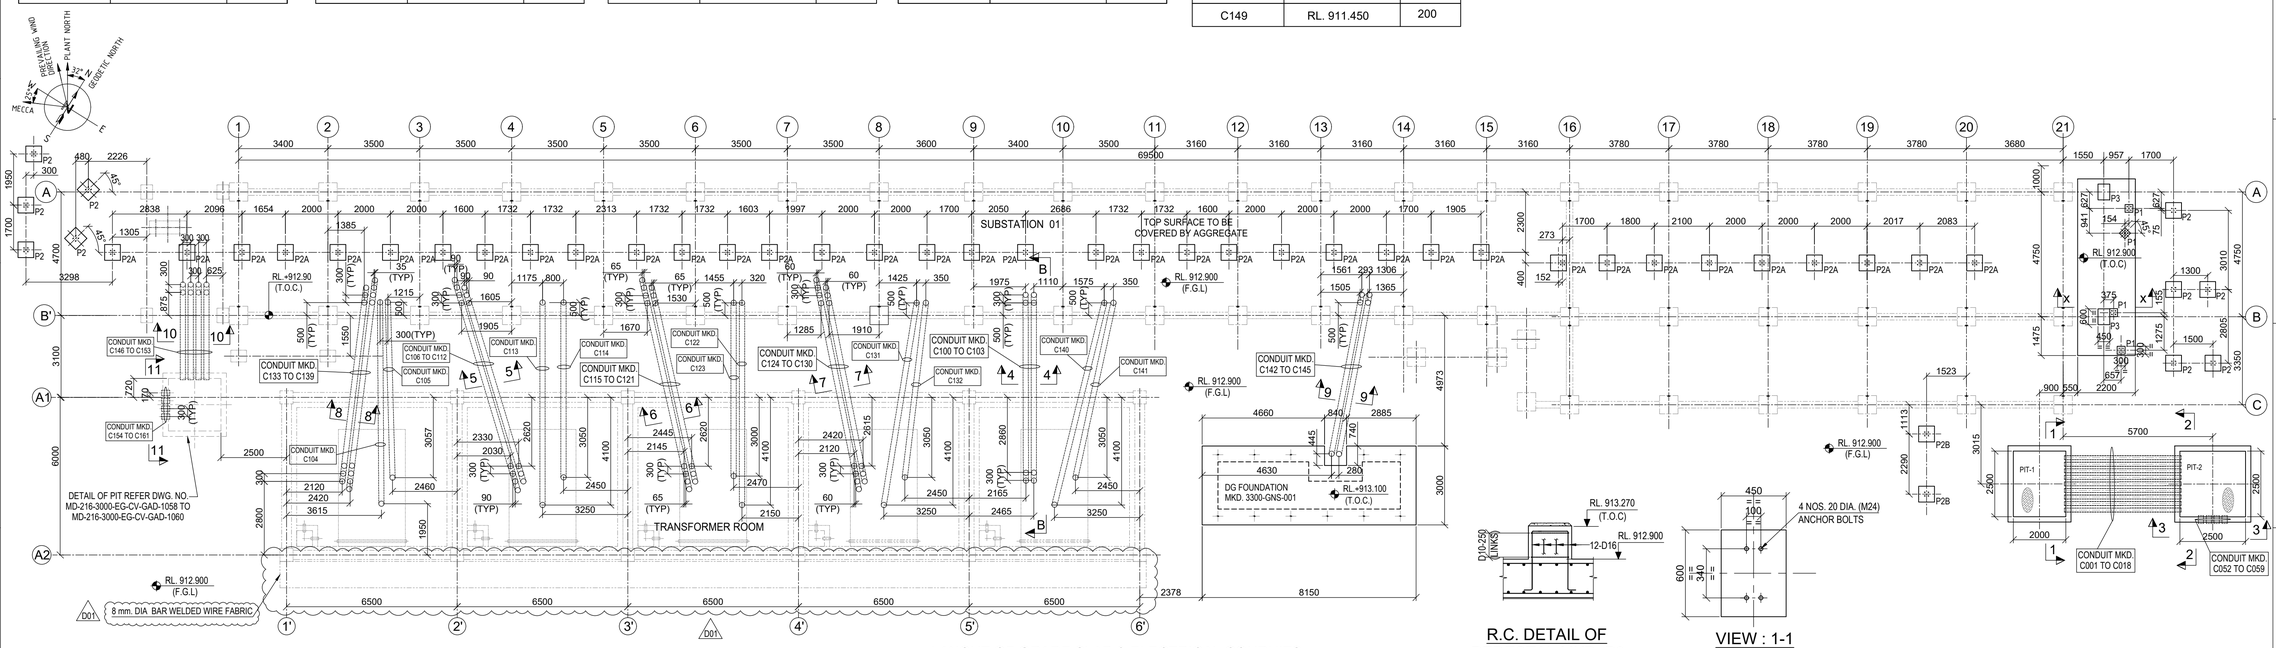


LAYOUT OF GRADE SLAB & ELECTRICAL CONDUITS
SCALE 1:100

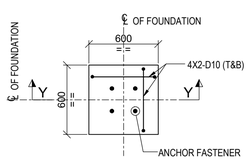


TYP. DETAIL OF FOUNDATION MKD. P2 FOR CABLE TRAY SUPPORT
(50 NOS. REQUIRED)
(SCALE - 1:25

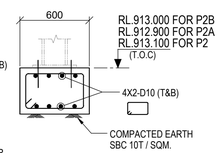


SECTION Y-Y
(SCALE - 1:25)

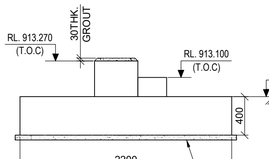

SECTION X-X
SCALE 1:30

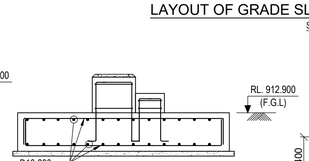


SECTION X-X
(R.C DETAIL)
SCALE 1:30

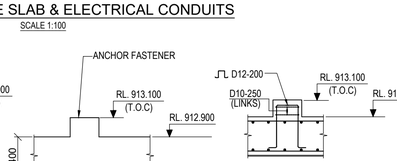

TYP. DETAIL OF PEDESTAL MKD. P1
SCALE 1:30

R.C. DETAIL OF PEDESTAL MKD. P1
SCALE 1:30

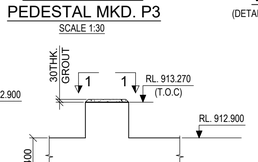

TYP. DETAIL OF PEDESTAL MKD. P3
SCALE 1:30

R.C. DETAIL OF PEDESTAL MKD. P3
SCALE 1:30

VIEW : 1-1
(DETAIL OF PEDESTAL MKD. P3)
SCALE 1:20

LEGENDS :-

R.L - REDUCED LEVEL
CL. - CENTRE LINE
T.O.C. - TOP OF CONCRETE
TYP. - TYPICAL
T.O.G. - TOP OF GROUT
B.O.F. - BOTTOM OF FOUNDATION
F.G.L. - FINISHED GROUND LEVEL.
F.F.L. - FINISHED FLOOR LEVEL
P.C.C - PLAIN CEMENT CONCRETE
DET. - DETAIL
FDN. - FOUNDATION
THK. - THICK
R.C.C - REINFORCED CEMENT CONCRETE
MKD. - MARKED
DWG. - DRAWING

NOTES:-

1. ALL DIMENSIONS ARE IN MILLIMETRES AND LEVELS AND CO-ORDINATES ARE IN METRES UNLESS OTHERWISE STATED.
2. NET SAFE BEARING CAPACITY OF SOIL AT BOTTOM OF FOUNDATION IS CONSIDERED AS 50 KN/ SQM.
3. GRADE OF CONCRETE SHALL BE C35 (35Mpa) FOR FOUNDATION, C30 (30Mpa) FOR GRADE SLAB & C15 (15Mpa) FOR BLINDING CONCRETE.
4. GRADE OF REINFORCEMENT SHALL BE DEFORMED BAR 420 MPa (GRADE 60) - ASTM A615/A615M.
5. FOR STANDARD REINFORCEMENT DETAIL & GENERAL NOTES FOR CIVIL WORKS REFER DRAWING NO. MD-216-1000-EG-CV-DED-1005 & 1001.
6. STRUCTURAL FILL SHALL CONFORM TO PROVISIONS OF DOCUMENT MD-216-1000-EG-CV-MST-1698.
7. CLEAR COVER TO REINFORCEMENT SHALL BE SLAB = 25 MM.

DOCUMENT NUMBER	REFERENCE DOCUMENTS	REV	DATE	REVISION DESCRIPTION	DRN	CHK	ENG	APP	EMP
MD-216-49PQ-EG-CV-GAD-1630	PROCESS PLANT SUBSTATION 01								
	DETAIL OF GRADE SLAB & ELECTRICAL CONDUITS	D01	13-04-2023	AS-BUILT - REVISED AS MARKED (D01)	SYA	SJM	AVG	AG	
MD-216-49PQ-EG-EL-LAD-1013	POWER DISTRIBUTION-CABLE ROUTE LAYOUT - SUBSTATION-01	C03	07/08/2021	ISSUED FOR CONSTRUCTION & REVISED AS MARKED (C03)	SYA	SJM	AVG	AG	
MD-216-49PQ-EG-EL-LAD-1034	POWER DISTRIBUTION-CABLE ROUTE LAYOUT - SUBSTATION-01	C02	28/07/2021	ISSUED FOR CONSTRUCTION & REVISED AS MARKED (C02)	SYA	SJM	AVG	AG	
MD-216-49PQ-EG-EL-LAD-1033	POWER DISTRIBUTION-CABLE ROUTE LAYOUT - SUBSTATION-01	C01	06/05/2021	ISSUED FOR CONSTRUCTION & REVISED AS PER EMPLOYER	AMJ	SJM	AVG	AG	
MD-216-49PQ-EG-CV-GAD-1623	PROCESS PLANT SUBSTATION 01-LAYOUT OF FOUNDATIONS			COMMENTS ON DATED 04/05/2021					
MD-216-1000-EG-ST-CRT-1001	CIVIL, STRUCTURAL & ARCHITECTURAL - DESIGN CRITERIA	A01	01/04/2021	ISSUED FOR REVIEW	AMJ	SJM	AVG	AG	

LARSEN & TOUBRO

This drawing is the property of LARSEN & TOUBRO and must not be passed on to any person or body not authorized by us to receive it nor be copied or otherwise made use either in full or in part by such person or body without our prior permission in writing.

Outotec

The content of these documents are the sole property of Outotec Oy. Any rights not expressly granted herein are reserved. Reproduction, transfer or distribution of part or all of the contents in any form without prior written permission of Outotec is prohibited.

MA'ADEN معادن
Saudi Arabian Mining Company شركة معادن العربية السعودية

This document and the information contained herein is Ma'aden proprietary know-how. This document or any part thereof should not be reproduced, stored in a retrieval system or transmitted by any means, electronic or otherwise, or divulged without prior written permission of Ma'aden.

LARSEN & TOUBRO DRAWING NUMBER	019045_950_C_G_24610_001	REVISION 4
OUTOTEC DRAWING NUMBER	900707__GAU01__WD01__MTL01__45092	DOCUMENT ID 0U100717974 / REVISION 4

DRAWN	AMJ	27/03/2021	MANSOURAH - MASSARAH GOLD PROJECT
CHECKED	SJM	30/03/2021	GENERAL ARRANGEMENT DRAWING
ENGINEER	AVG	27/03/2021	PROCESS PLANT SUBSTATION 01
APPROVED	AG	01/04/2021	LAYOUT & DET. OF GRADE SLAB & ELECTRICAL CONDUITS
EMPLOYER			
SCALE	1:100	A1	DRAWING NUMBER: MD-216-49PQ-EG-CV-GAD-1629 / REV: D01