


DRAWING NUMBER MD-216-49PQ-EG-CV-GAD-1630 REV D01

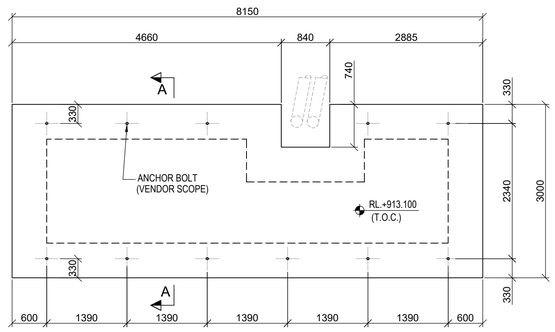

DETAIL OF DG FOUNDATION MKD. 3300-GNS-001


SCALE 1:50

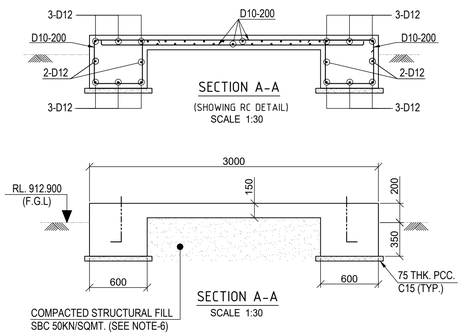

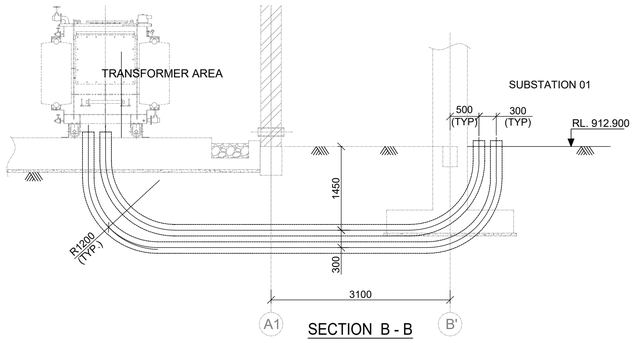


SECTION B - B

SCALE 1 : 50

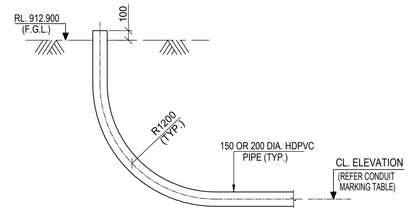

TYP. DET. OF CONDUIT


SCALE 1:30

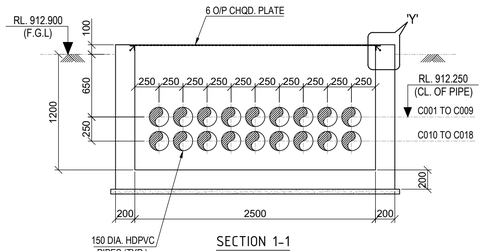

SECTION 1-1

(TYP. DETAIL OF PIT-1)


SCALE 1:30

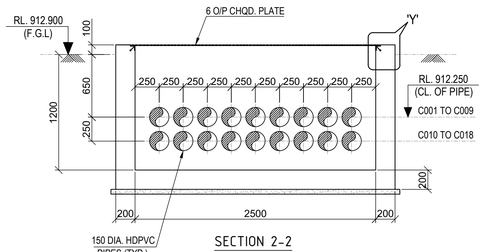

SECTION 2-2

(TYP. DETAIL OF PIT-2)


SCALE 1:30

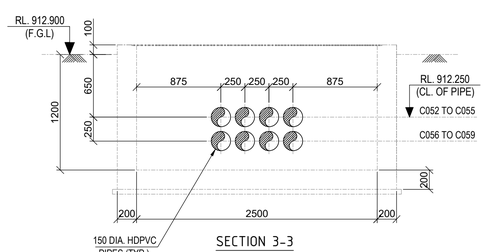

SECTION 3-3


(TYP. DETAIL OF PIT-2)

SCALE 1:30

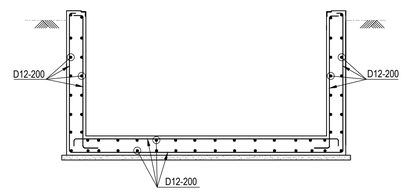


RC. DETAIL OF PIT MKD. PIT-1 & PIT-2

SCALE 1:30

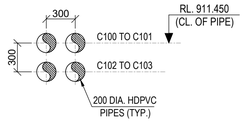


SECTION 4-4

SCALE 1:30

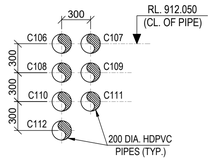


SECTION 5-5

SCALE 1:30

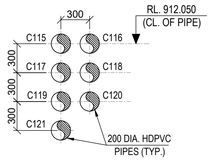


SECTION 6-6

SCALE 1:30

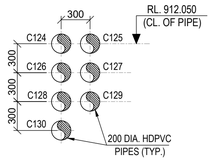


SECTION 7-7

SCALE 1:30

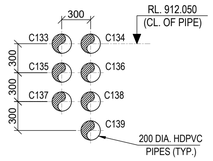


SECTION 8-8

SCALE 1:30

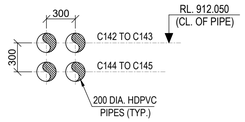


SECTION 9-9

SCALE 1:30

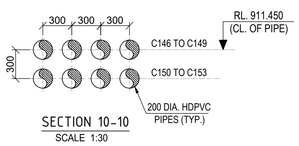


SECTION 10-10

SCALE 1:30

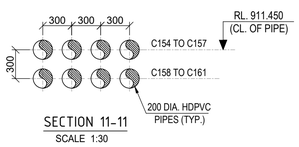


SECTION 11-11

SCALE 1:30

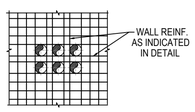

TYP. DETAIL OF WALL REINF.
NEAR PIPES

SCALE 1:50

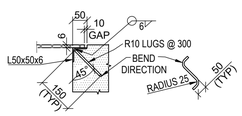

DETAIL - Y

(SCALE 1:10)

LEGENDS :-

R.L. - REDUCED LEVEL
CL. - CENTRE LINE
T.O.C. - TOP OF CONCRETE
TYP. - TYPICAL
T.O.G. - TOP OF GROUT
B.O.F. - BOTTOM OF FOUNDATION
F.G.L. - FINISHED GROUND LEVEL.
F.F.L. - FINISHED FLOOR LEVEL
P.C.C - PLAIN CEMENT CONCRETE
DET. - DETAIL
FDN. - FOUNDATION
THK. - THICK
R.C.C - REINFORCED CEMENT CONCRETE
MKD. - MARKED
DIA. - DIAMETER
RC - REINFORCED CONCRETE
CHQD. - CHEQUERED

NOTES:-

1. ALL DIMENSIONS ARE IN MILLIMETRES AND LEVELS AND CO-ORDINATES ARE IN METRES UNLESS OTHERWISE STATED.
2. NET SAFE BEARING CAPACITY OF SOIL AT BOTTOM OF FOUNDATION IS CONSIDERED AS 50 KN/ SQM.
3. GRADE OF CONCRETE SHALL BE C35 (35Mpa) FOR FOUNDATION, C30 (30Mpa) FOR GRADE SLAB & C15 (15Mpa) FOR BLINDING CONCRETE.
4. GRADE OF REINFORCEMENT SHALL BE DEFORMED BAR 420 MPa (GRADE 60) - ASTM A615/A615M.
5. FOR STANDARD REINFORCEMENT DETAIL & GENERAL NOTES FOR CIVIL WORKS REFER DRAWING NO. MD-216-1000-EG-CV-DED-1005 & 1001.
6. STRUCTURAL FILL SHALL CONFORM TO PROVISIONS OF DOCUMENT MD-216-1000-EG-CV-MST-1698.
7. CLEAR COVER TO REINFORCEMENT SHALL BE SLAB = 25 MM.

DOCUMENT NUMBER	REFERENCE DOCUMENTS	REV	DATE	REVISION DESCRIPTION	DRN	CHK	ENG	APP	EMP
MD-216-49PQ-EG-CV-GAD-1629	PROCESS PLANT SUBSTATION 01								
	LAYOUT & DET. OF GRADE SLAB & ELECTRICAL CONDUITS								
MD-216-49PQ-EG-EL-LAD-1013	POWER DISTRIBUTION-CABLE ROUTE LAYOUT - SUBSTATION-01								
MD-216-49PQ-EG-EL-LAD-1034	POWER DISTRIBUTION-CABLE ROUTE LAYOUT - SUBSTATION-01	D01	14/03/2023	AS-BUILT	AMJ	SJM	AVG	AG	
MD-216-49PQ-EG-EL-LAD-1033	POWER DISTRIBUTION-CABLE ROUTE LAYOUT - SUBSTATION-01	C01	06/05/2021	ISSUED FOR CONSTRUCTION & REVISED AS PER EMPLOYER	AMJ	SJM	AVG	AG	
MD-216-49PQ-EG-CV-GAD-1623	PROCESS PLANT SUBSTATION 01-LAYOUT OF FOUNDATIONS			COMMENTS ON DATED 04/05/2021					
MD-216-1000-EG-ST-CRT-1001	CIVIL, STRUCTURAL & ARCHITECTURAL - DESIGN CRITERIA	A01	01/04/2021	ISSUED FOR REVIEW	AMJ	SJM	AVG	AG	

RESERVED FOR VENDOR LOGO AND DRAWING NUMBER

LARSEN & TOUBRO

This drawing is the property of LARSEN & TOUBRO and must not be passed on to any person or body not authorized by us to receive it nor be copied or otherwise made use either in full or in part by such person or body without our prior permission in writing.

Outotec

The content of these documents are the sole property of Outotec Oyj. Any rights not expressly granted herein are reserved. Reproduction, transfer or distribution of part or all of the contents in any form without prior written permission of Outotec is prohibited.

MA'ADEN معادن
Saudi Arabian Mining Company شركة معادن العربية السعودية

This document and the information contained herein is Ma'aden proprietary know-how. This document or any part thereof should not be reproduced, stored in a retrieval system or transmitted by any means, electronic or otherwise, or divulged without prior written permission of Ma'aden.

LARSEN & TOUBRO DRAWING NUMBER: 019045_950_C_G_24610_002 — REVISION: 2

OUTOTEC DRAWING NUMBER: 900707__GAU01__WD01__MTL01__45093 — DOCUMENT ID: 0U100717975 — REVISION: 2

DRAWN	AMJ	27/03/2021
CHECKED	SJM	30/03/2021
ENGINEER	AVG	27/03/2021
APPROVED	AG	01/04/2021
EMPLOYER		
SCALE	1:50, 1:20	A1

MANSOURAH - MASSARAH GOLD PROJECT
GENERAL ARRANGEMENT DRAWING
PROCESS PLANT SUBSTATION 01
DETAIL OF GRADE SLAB & ELECTRICAL CONDUITS

DRAWING NUMBER: MD-216-49PQ-EG-CV-GAD-1630 — REV: D01