


DRAWING NUMBER: MD - 216 - 39MA-EG - CV - GAD - 1016
REV: D01

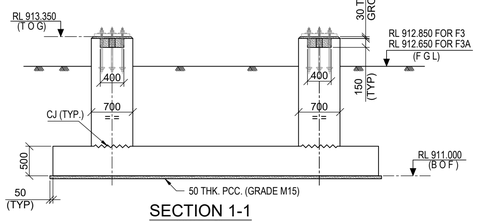


SECTION 1-1
(SCALE-1:50)

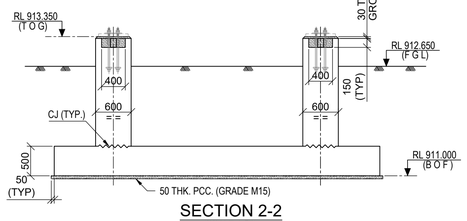


SECTION 2-2
(SCALE-1:50)

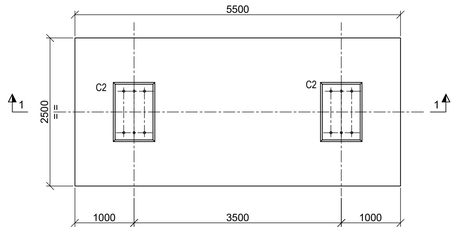


FOUNDATION PLAN MARKED F3 & F3A
(5 NOS. REQD.)
SCALE-1:50

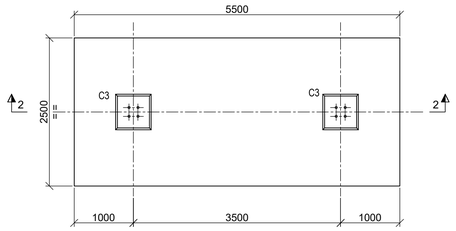


FOUNDATION PLAN MARKED F4
(2 NOS. REQD.)
SCALE-1:50

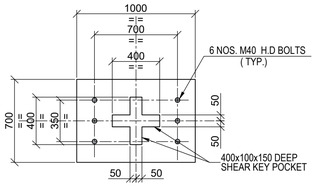


DETAIL OF COLUMN MARKED C2
(SCALE-1:25)

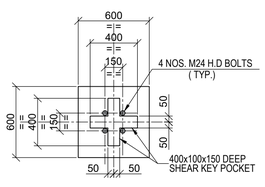

DETAIL OF COLUMN MARKED C3
(SCALE-1:25)

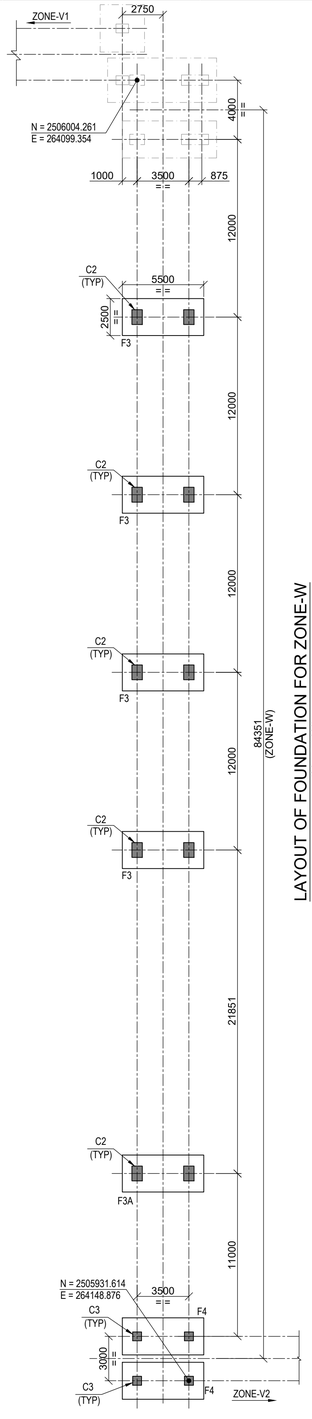

LAYOUT OF FOUNDATION FOR ZONE-W
84351 (ZONE-W)
(SCALE-1:200)

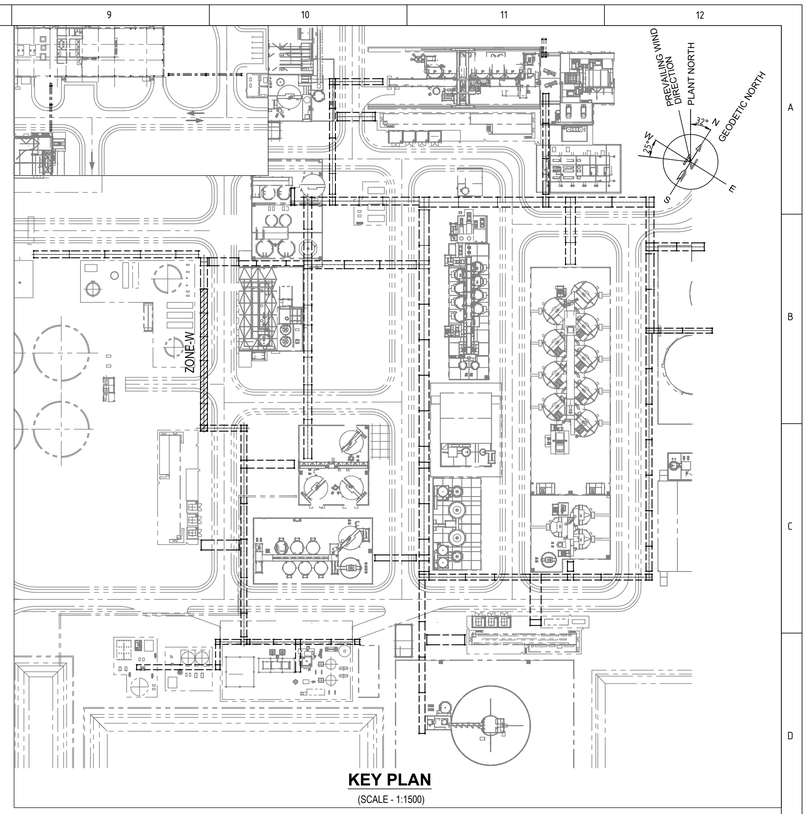

KEY PLAN
(SCALE - 1:1500)

LEGEND :-

R L - REDUCED LEVEL
T O G - TOP OF GROUT
CJ - CONSTRUCTION JOINT
F G L - FINISHED GROUND LEVEL
P C C - PLAIN CEMENT CONCRETE
FDN. - FOUNDATION
B O F - BOTTOM OF FOUNDATION
THK. - THICK
TYP. - TYPICAL
DIA. - DIAMETER
REQD. - REQUIRED

NOTES:-

1. FOR DETAIL OF ANCHOR BOLTS, REFER DRAWING NO. MD-216-1000-EG-CV-DED-1003.
2. FOR ALL OTHER NOTES, REFER DRAWING NO. MD-216-39MA-EG-CV-GAD-1015.

DOCUMENT NUMBER	REFERENCE DOCUMENTS	REV	DATE	REVISION DESCRIPTION	DRN	CHK	ENG	APP	EMP
		D01	10/03/2023	AS-BUILT	AMT	BDA	SML	AG	
		C03	04/01/2021	ISSUED FOR CONSTRUCTION & REVISED AS MKD. C03	AMT	BDA	SML	AG	
MD-216-1000-EG-CV-DED-1003	STANDARD DETAILS	C02	08/10/2020	ISSUED FOR CONSTRUCTION & REVISED AS MKD. C02	AMT	BDA	SML	AG	
MD-216-39MA-EG-ME-GAD-1001	LAYOUT WITH ZONE MARKINGS	C01	28/04/2020	ISSUED FOR CONSTRUCTION & REVISED AS PER EMPLOYER'S	AMT	BDA	SML	AG	
MD-216-39MA-EG-ST-GAD-2003	PROCESS PLANT PIPE RACK CUM CABLE RACK			COMMENTS ON 24/04/2020 & REVISED AS MKD. C01					
MD-216-39MA-EG-ST-GAD-2001	PROCESS PLANT PIPE RACK CUM CABLE RACK	A01	17/03/2020	ISSUED FOR REFERENCE	AMT	BDA	SML	AG	

RESERVED FOR VENDOR LOGO AND DRAWING NUMBER

LARSEN & TOUBRO

This drawing is the property of LARSEN & TOUBRO and must not be passed on to any person or body not authorized by us to receive it nor be copied or otherwise made use either in full or in part by such person or body without our prior permission in writing.

Outotec

The content of these documents are the sole property of Outotec Oy). Any rights not expressly granted herein are reserved. Reproduction, transfer or distribution of part or all of the contents in any form without prior written permission of Outotec is prohibited.

MA'ADEN معادن
Saudi Arabian Mining Company شركة التعدين العربية السعودية

This document and the information contained herein is Ma'aden proprietary know-how. This document or any part thereof should not be reproduced, stored in a retrieval system or transmitted by any means, electronic or otherwise, or divulged without prior written permission of Ma'aden.

LARSEN & TOUBRO DRAWING NUMBER: 019045_080_C_G_24012_002 — REVISION: 4
OUTOTEC DRAWING NUMBER: 900707 _GAU01 _ZZ01 _MTL01 _00089 — DOCUMENT ID: OU100675359 — REVISION: 4

DRAWN	AMT	11/03/2020
CHECKED	BDA	12/03/2020
ENGINEER	SML	10/03/2020
APPROVED	AG	17/03/2020
EMPLOYER		
SCALE	1:200,1:50,1:25	A1

MANSOURAH - MASSARAH GOLD PROJECT
GENERAL ARRANGEMENT
PROCESS PLANT PIPE RACK CUM CABLE RACK
PLAN & SECTIONS

DRAWING NUMBER: MD - 216 - 39MA- EG- CV - GAD - 1016 — REV: D01