


DRAWING NUMBER MD-216-39MA-EG-CV-GAD-1018 REV D01

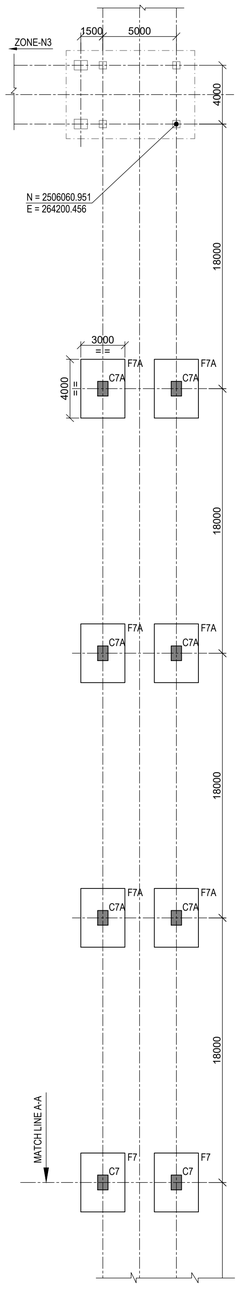


LAYOUT OF FOUNDATION FOR ZONE-P1 & P

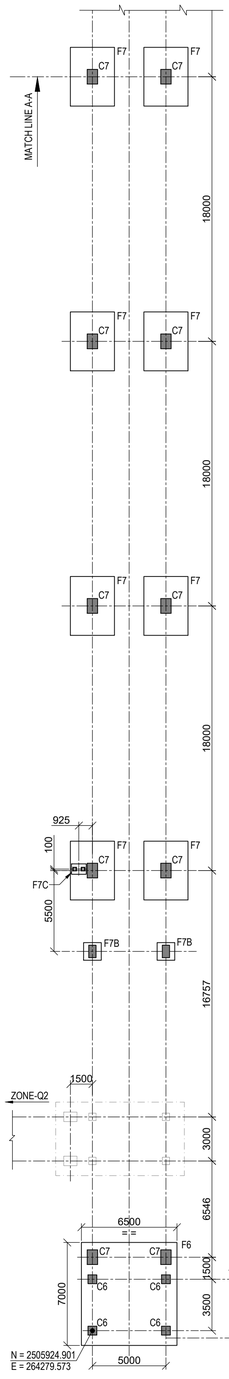


LAYOUT OF FOUNDATION FOR ZONE-P1 & P

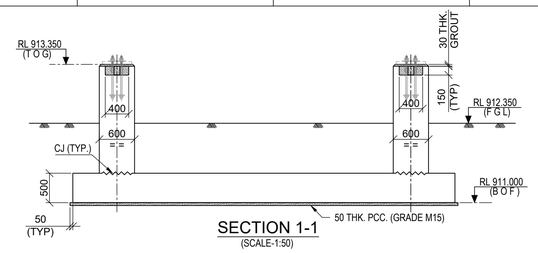


SECTION 1-1
(SCALE-1:50)

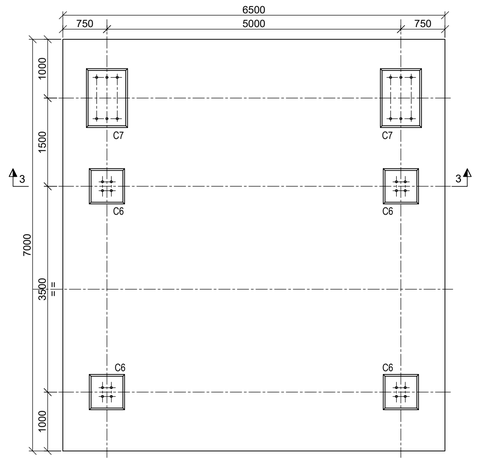


FOUNDATION PLAN MKD. F6
(1 NOS. REQD.)
SCALE-1:50

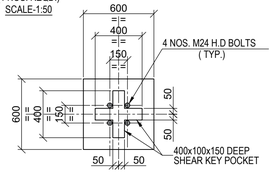


DETAIL OF COLUMN MKD. C6
(SCALE-1:25)

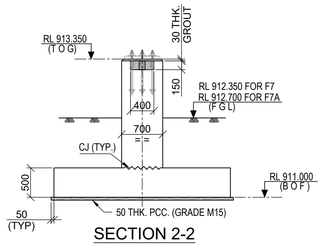


SECTION 2-2
(SCALE-1:50)

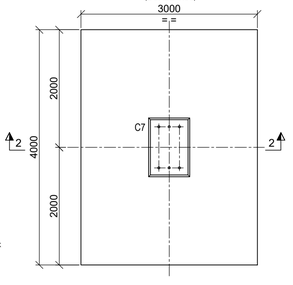


FOUNDATION PLAN MKD. F7 & F7A
(14 NOS. REQD.)
SCALE-1:50

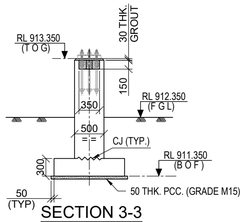


SECTION 3-3
(SCALE-1:50)

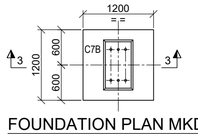


FOUNDATION PLAN MKD. F7B
(2 NOS. REQD.)
SCALE-1:50

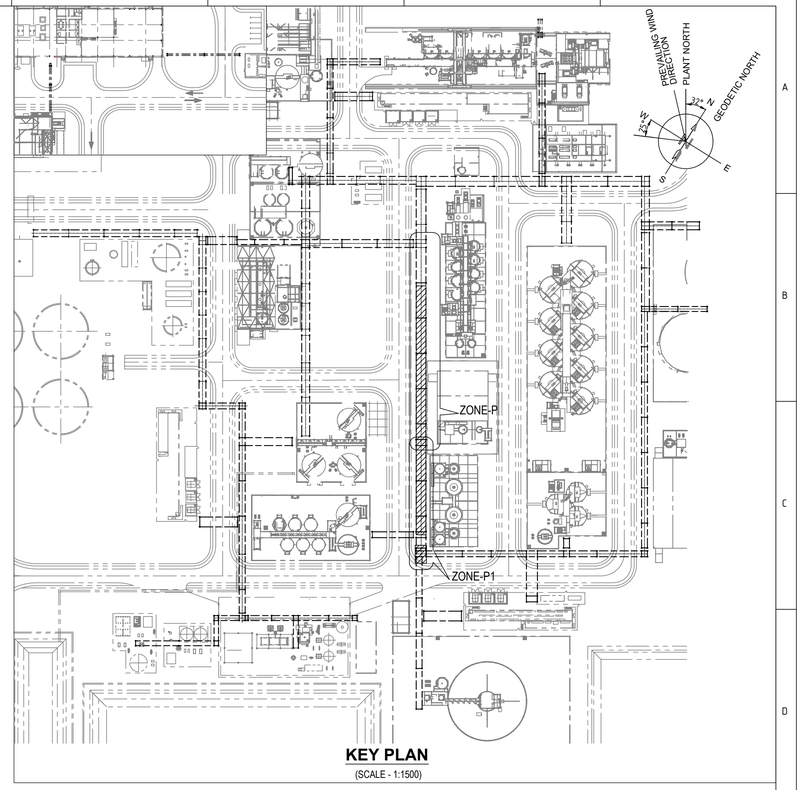

KEY PLAN
(SCALE - 1:1500)

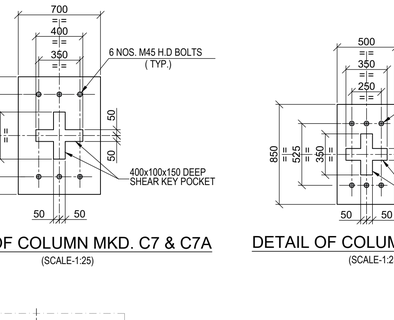


DETAIL OF COLUMN MKD. C7 & C7A
(SCALE-1:25)

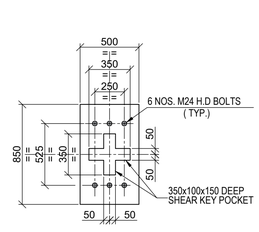


DETAIL OF COLUMN MKD. C7B
(SCALE-1:25)



DETAIL OF COLUMN MKD. C7C
(SCALE-1:25)

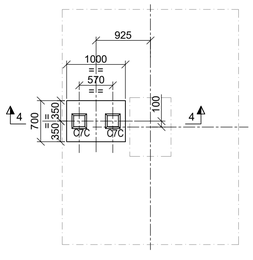

FOUNDATION PLAN MKD. F7C
(1 NO REQD.)
SCALE-1:50

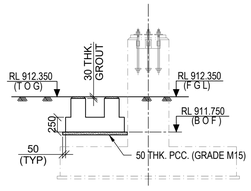

SECTION 4-4
(SCALE-1:50)

LEGEND :-

R L - REDUCED LEVEL
T O G - TOP OF GROUT
CJ - CONSTRUCTION JOINT
F G L - FINISHED GROUND LEVEL
P C C - PLAIN CEMENT CONCRETE
FDN. - FOUNDATION
B O F - BOTTOM OF FOUNDATION
THK. - THICK
MKD. - MARKED
TYP. - TYPICAL
DIA. - DIAMETER
REQD. - REQUIRED
DOC. - DOCUMENT

NOTES:-

1. ALL DIMENSIONS ARE IN MILLIMETRES AND LEVELS AND CO-ORDINATES ARE IN METRES UNLESS OTHERWISE STATED.
2. NET SAFE BEARING CAPACITY OF SOIL AT BOTTOM OF FOUNDATION CONSIDERED 450KN/ SQ. M
3. IF ANY PART OF FOUNDATION COMES ON BACKFILL ZONE OF ADJACENT FOUNDATION OR ANY LOOSE SOIL ARE ENCOUNTERED BELOW FOUNDATION LEVEL THE SAME SHALL BE REMOVED AND FILLED WITH PCC (M15).
4. THE CONTENT OF THIS DRAWING SHALL CONFORM TO THE PROVISIONS OF CIVIL, STRUCTURAL AND ARCHITECTURAL DESIGN CRITERIA DOC. NO. MD-216-1000-EG-ST-CRT-1001.
5. FOR FOUNDATION BOLT DETAILS REFER DRAWING NO : MD-216-1000-EG-CV-DED-1003.

DOCUMENT NUMBER	REFERENCE DOCUMENTS	REV	DATE	REVISION DESCRIPTION	DRN	CHK	ENG	APP	EMP
MD-216-39MA-EG-ST-GAD-2001	PROCESS PLANT PIPE RACK CUM CABLE RACK	A01	30/03/2020	ISSUED FOR REFERENCE	AMT	BDA	SML	AG	
MD-216-39MA-EG-ST-GAD-2012	PROCESS PLANT PIPE RACK CUM CABLE RACK			EMPLOYER'S COMMENTS DATED 20/04/2020					
MD-216-39MA-EG-ST-GAD-2013	PROCESS PLANT PIPE RACK CUM CABLE RACK	C01	25/04/2020	ISSUED FOR CONSTRUCTION & REVISED AS PER	AMT	BDA	SML	AG	
MD-216-39MA-EG-ST-GAD-2025	PROCESS PLANT PIPE RACK CUM CABLE RACK	C02	09/09/2020	ISSUED FOR CONSTRUCTION & REVISED AS MKD. C02	AMT	BDA	SML	AG	
MD-216-39MA-EG-ME-GAD-1001	LAYOUT WITH ZONE MARKINGS	C03	14/12/2020	ISSUED FOR CONSTRUCTION & REVISED AS MKD. C03	AMT	BDA	SML	AG	
		C04	06/01/2021	ISSUED FOR CONSTRUCTION & REVISED AS MKD. C04	AMT	BDA	SML	AG	
		D01	10/03/2023	AS-BUILT	AMT	BDA	SML	AG	

RESERVED FOR VENDOR LOGO AND DRAWING NUMBER

LARSEN & TOUBRO

This drawing is the property of LARSEN & TOUBRO and must not be passed on to any person or body not authorized by us to receive it nor be copied or otherwise made use either in full or in part by such person or body without our prior permission in writing.

Outotec

The content of these documents are the sole property of Outotec Oyj. Any rights not expressly granted herein are reserved. Reproduction, transfer or distribution of part or all of the contents in any form without prior written permission of Outotec is prohibited.

MA'ADEN معادن
Saudi Arabian Mining Company شركة المعادن العربية السعودية

This document and the information contained herein is Ma'aden proprietary know-how. This document or any part thereof should not be reproduced, stored in a retrieval system or transmitted by any means, electronic or otherwise, or divulged without prior written permission of Ma'aden.

DRAWN	AMT	19/03/2020
CHECKED	BDA	20/03/2020
ENGINEER	SML	19/03/2020
APPROVED	AG	30/03/2020
EMPLOYER		
SCALE	1:200,1:50,1:25	A1

LARSEN & TOUBRO DRAWING NUMBER: O19045_080_C_G_24012_004 — REVISION: 5
OUTOTEC DRAWING NUMBER: 900707__GAU01__ZZ01__MTL01__00091 — DOCUMENT ID: OU100675361 — REVISION: 5

MANSOURAH - MASSARAH GOLD PROJECT
GENERAL ARRANGEMENT
PROCESS PLANT PIPE RACK CUM CABLE RACK
PLAN & SECTIONS

DRAWING NUMBER: MD-216-39MA-EG-CV-GAD-1018 — REV: D01