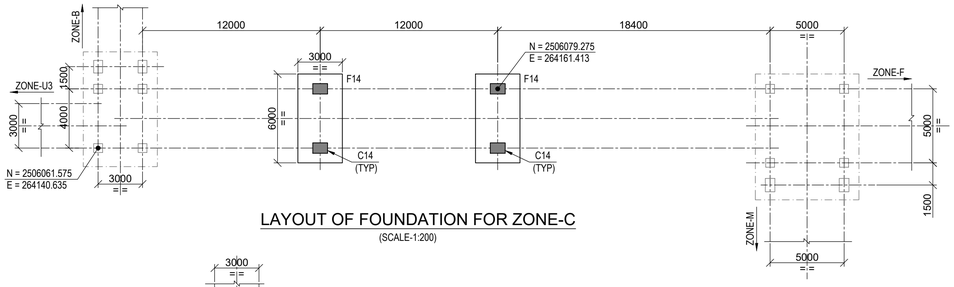
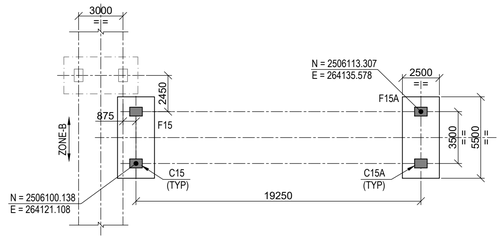
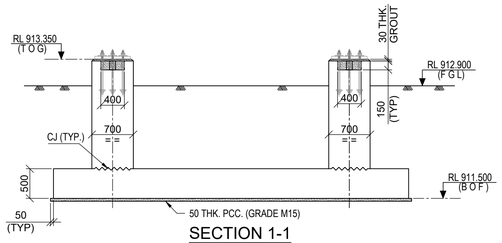
DRAWING NUMBER MD - 216 - 39MA - EG - CV - GAD - 1023 REV D01



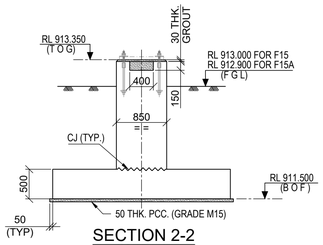

## LAYOUT OF FOUNDATION FOR ZONE-C
(SCALE-1:200)



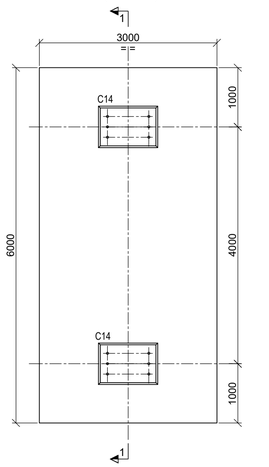

## LAYOUT OF FOUNDATION FOR ZONE-E
(SCALE-1:200)



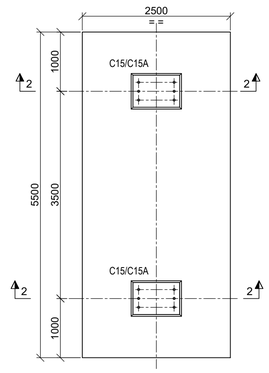

## SECTION 1-1
(SCALE-1:50)



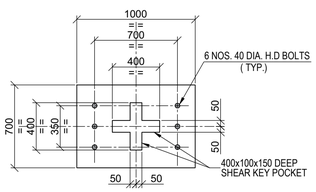

## SECTION 2-2
(SCALE-1:50)



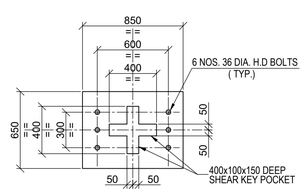

## FOUNDATION PLAN MARKED F14
(2 NOS. REQD.)
SCALE-1:50



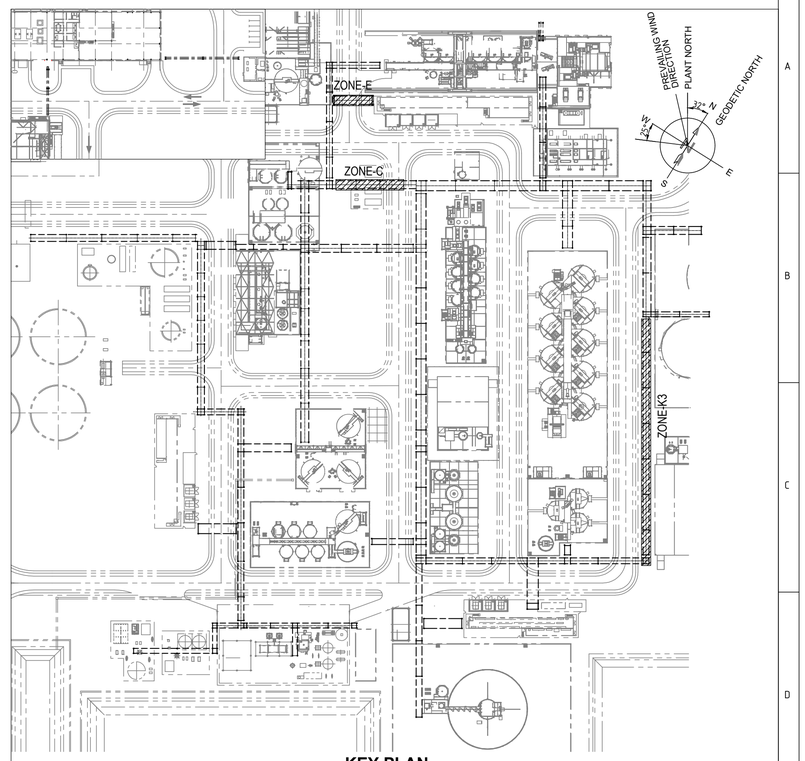

## FOUNDATION PLAN MARKED F15 & F15A
(2 NOS. REQD.)
SCALE-1:50




## DETAIL OF COLUMN MARKED C14
(SCALE-1:25)




## DETAIL OF COLUMN MARKED C15 & C15A
(SCALE-1:25)




## KEY PLAN
(SCALE - 1:1500)

## LEGEND :-

R L - REDUCED LEVEL
T O G - TOP OF GROUT
CJ - CONSTRUCTION JOINT
F G L - FINISHED GROUND LEVEL
P C C - PLAIN CEMENT CONCRETE
FDN. - FOUNDATION
B O F - BOTTOM OF FOUNDATION
THK. - THICK
N T S - NOT TO SCALE
MKD. - MARKED
TYP. - TYPICAL
DIA. - DIAMETER
REQD. - REQUIRED
DOC. - DOCUMENT

## NOTES:-

1. ALL DIMENSIONS ARE IN MILLIMETRES AND LEVELS AND CO-ORDINATES ARE IN METRES UNLESS OTHERWISE STATED.
2. NET SAFE BEARING CAPACITY OF SOIL AT BOTTOM OF FOUNDATION CONSIDER 450KN/ SQ. M
3. IF ANY PART OF FOUNDATION COMES ON BACKFILL ZONE OF ADJACENT FOUNDATION OR ANY LOOSE SOIL ARE ENCOUNTERED BELOW FOUNDATION LEVEL THE SAME SHALL BE REMOVED AND FILLED WITH PCC (M15).
4. THE CONTENT OF THIS DRAWING SHALL CONFORM TO THE PROVISIONS OF CIVIL, STRUCTURAL AND ARCHITECTURAL DESIGN CRITERIA DOC. NO. MD-216-1000-EG-ST-CRT-1001.
5. FOR FOUNDATION BOLT DETAILS REFER DRAWING NO : MD-216-1000-EG-CV-DED-1003.

| DOCUMENT NUMBER | REFERENCE DOCUMENTS | REV | DATE | REVISION DESCRIPTION | DRN | CHK | ENG | APP | EMP |
|---|---|---|---|---|---|---|---|---|---|
| | | D01 | 10/03/2023 | AS-BUILT | AMT | BDA | SML | AG | |
| | | C02 | 12/10/2020 | ISSUED FOR CONSTRUCTION & REVISED AS MKD. C02 | AMT | BDA | SML | AG | |
| MD-216-39MA-EG-ME-GAD-1001 | LAYOUT WITH ZONE MARKINGS | C01 | 20/08/2020 | ISSUED FOR CONSTRUCTION & REVISED AS MKD. C01 | AMT | BDA | SML | AG | |
| MD-216-39MA-EG-ST-GAD-2001 | PROCESS PLANT PIPE RACK CUM CABLE RACK | A01 | 02/06/2020 | ISSUED FOR REFERENCE | AMT | BDA | SML | AG | |

RESERVED FOR VENDOR LOGO AND DRAWING NUMBER

LARSEN & TOUBRO

This drawing is the property of *LARSEN & TOUBRO* and must not be passed on to any person or body not authorized by us to receive it nor be copied or otherwise made use either in full or in part by such person or body without our prior permission in writing.

Outotec

The content of these documents are the sole property of Outotec Oyj. Any rights not expressly granted herein are reserved. Reproduction, transfer or distribution of part or all of the contents in any form without prior written permission of Outotec is prohibited.

MA'ADEN معادن Saudi Arabian Mining Company شركة معادن العربية السعودية

This document and the information contained herein is Ma'aden proprietary know-how. This document or any part thereof should not be reproduced, stored in a retrieval system or transmitted by any means, electronic or otherwise, or divulged without prior written permission of Ma'aden.

LARSEN & TOUBRO DRAWING NUMBER: 019045_080_C_G_24012_009 — REVISION: 3

OUTOTEC DRAWING NUMBER: 900707 __GAU01 __ZZ01__MTL01 __00096 — DOCUMENT ID: OU100675366 — REVISION: 3

| | | |
|---|---|---|
| DRAWN | AMT | 30/05/2020 |
| CHECKED | BDA | 01/06/2020 |
| ENGINEER | SML | 30/05/2020 |
| APPROVED | AG | 02/06/2020 |
| EMPLOYER | | |
| SCALE | 1:200,1:50,1:25 | A1 |

MANSOURAH - MASSARAH GOLD PROJECT
GENERAL ARRANGEMENT
PROCESS PLANT PIPE RACK CUM CABLE RACK
PLAN & SECTIONS

DRAWING NUMBER: MD - 216 - 39MA - EG - CV - GAD - 1023 — REV: D01