
DRAWING NUMBER: MD-216-39MA-EG-CV-GAD-1025 | REV: D01

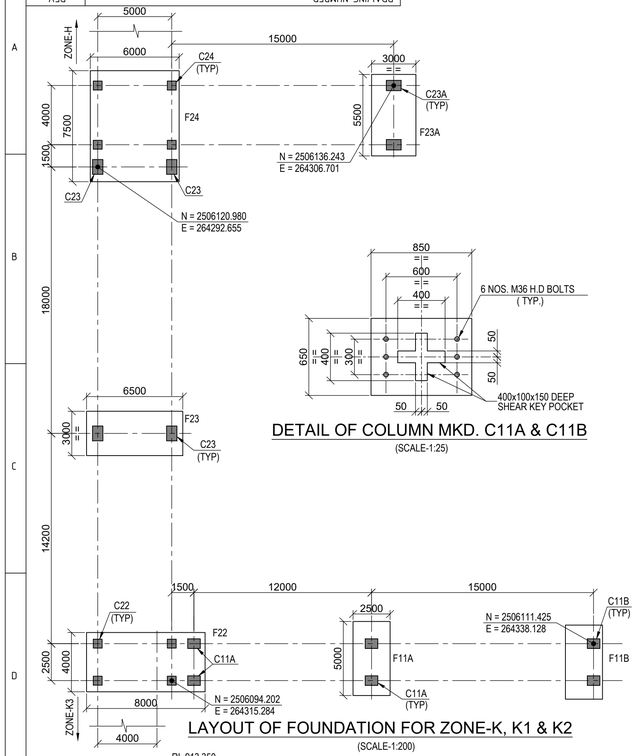


LAYOUT OF FOUNDATION FOR ZONE-K, K1 & K2

(SCALE-1:200)


DETAIL OF COLUMN MKD. C11A & C11B

(SCALE-1:25)

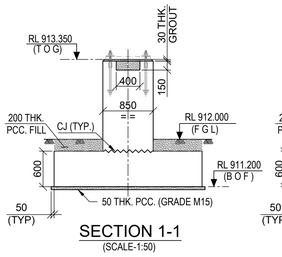


SECTION 1-1

(SCALE-1:50)

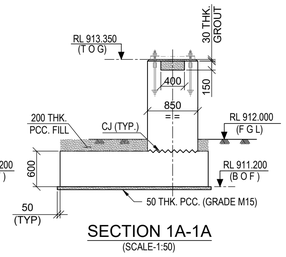


SECTION 1A-1A

(SCALE-1:50)

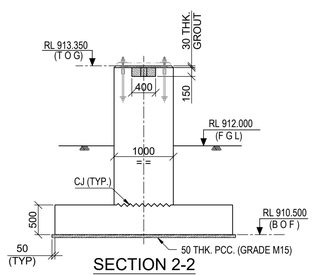


SECTION 2-2

(SCALE-1:50)

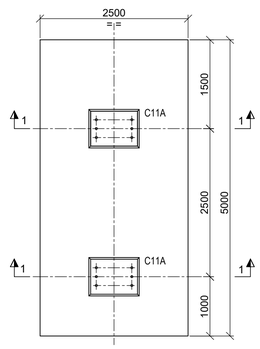


FOUNDATION PLAN MKD. F11A

(1 NO. REQD.)
SCALE-1:50

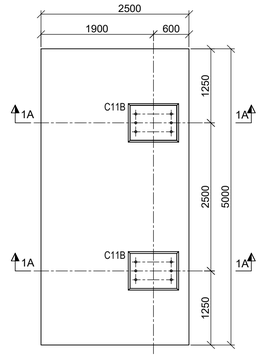


FOUNDATION PLAN MKD. F11B

(1 NO. REQD.)
SCALE-1:50

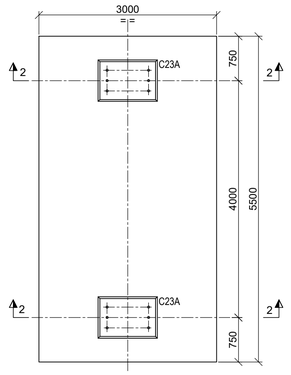


FOUNDATION PLAN MKD. F23A

(1 NO. REQD.)
SCALE-1:50

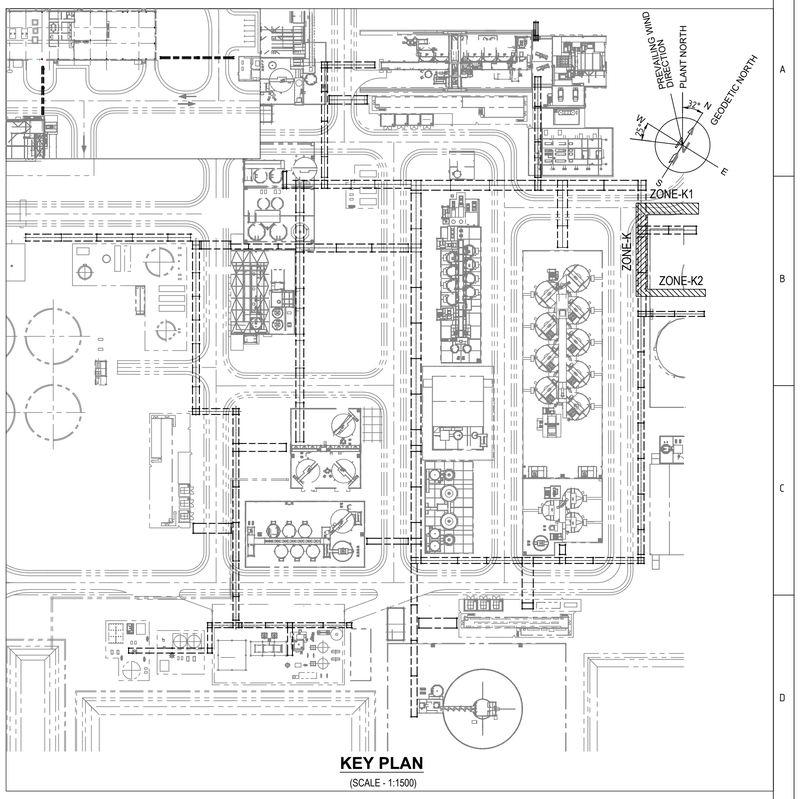


KEY PLAN

(SCALE - 1:1500)

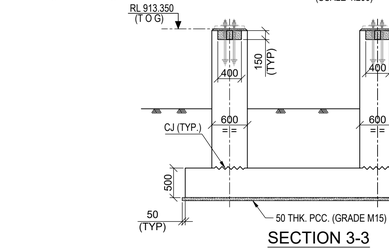


SECTION 3-3

(SCALE-1:50)

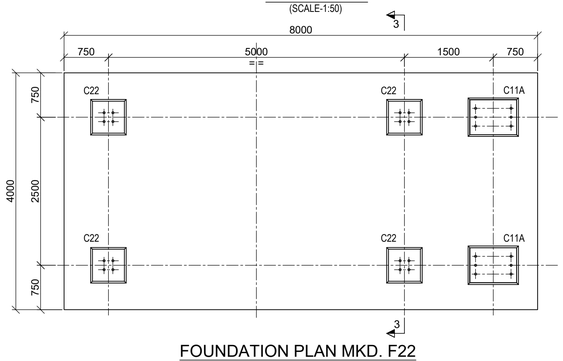


FOUNDATION PLAN MKD. F22

(1 NO. REQD.)
SCALE-1:50

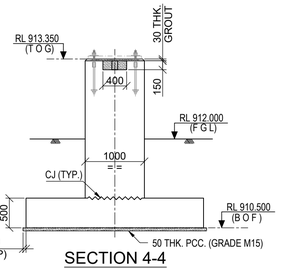


SECTION 4-4

(SCALE-1:50)

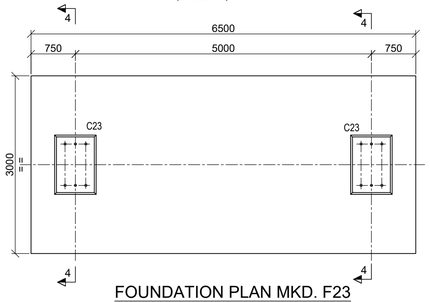


FOUNDATION PLAN MKD. F23

(1 NO. REQD.)
SCALE-1:50

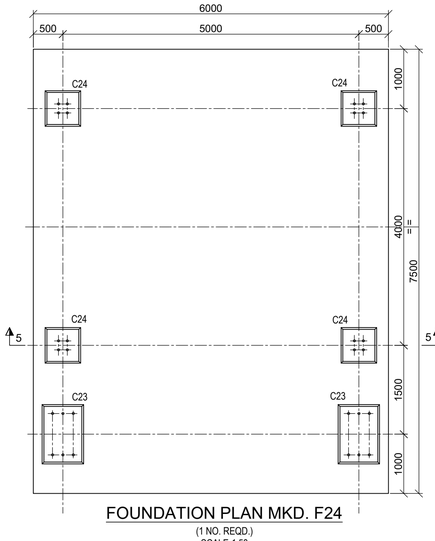


FOUNDATION PLAN MKD. F24

(1 NO. REQD.)
SCALE-1:50

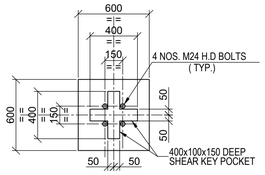

DETAIL OF COLUMN MKD. C22 & C24

(SCALE-1:25)

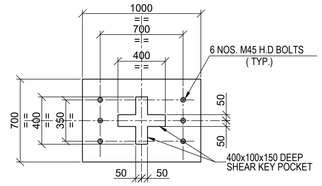


DETAIL OF COLUMN MKD. C23 & C23A

(SCALE-1:25)

LEGEND :-

R L - REDUCED LEVEL
T O G - TOP OF GROUT
CJ - CONSTRUCTION JOINT
F G L - FINISHED GROUND LEVEL
P C C - PLAIN CEMENT CONCRETE
FDN. - FOUNDATION
B O F - BOTTOM OF FOUNDATION
THK. - THICK
N T S - NOT TO SCALE
MKD. - MARKED
TYP. - TYPICAL
DIA. - DIAMETER
REQD. - REQUIRED
DOC. - DOCUMENT

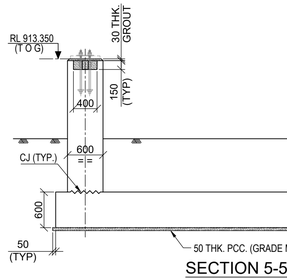

SECTION 5-5

(SCALE-1:50)

NOTES:-

1. ALL DIMENSIONS ARE IN MILLIMETRES AND LEVELS AND CO-ORDINATES ARE IN METRES UNLESS OTHERWISE STATED.
2. NET SAFE BEARING CAPACITY OF SOIL AT BOTTOM OF FOUNDATION CONSIDERED 325KN/ SQ. M
3. IF ANY PART OF FOUNDATION COMES ON BACKFILL ZONE OF ADJACENT FOUNDATION OR ANY LOOSE SOIL ARE ENCOUNTERED BELOW FOUNDATION LEVEL THE SAME SHALL BE REMOVED AND FILLED WITH PCC (M15).
4. THE CONTENT OF THIS DRAWING SHALL CONFORM TO THE PROVISIONS OF CIVIL, STRUCTURAL AND ARCHITECTURAL DESIGN CRITERIA DOC. NO. MD-216-1000-EG-ST-CRT-1001.
5. CO-ORDINATE TO BE CHECKED & VERIFIED FROM 3D MODEL & DRAWING NO. MD-216-39MA-EG-ST-GAD-2001 BEFORE CONSTRUCTION
6. FOR FOUNDATION BOLT DETAILS REFER DRAWING NO : MD-216-1000-EG-CV-DED-1003.

DOCUMENT NUMBER	REFERENCE DOCUMENTS	REV	DATE	REVISION DESCRIPTION	DRN	CHK	ENG	APP	EMP
		D01	10/03/2023	AS-BUILT	AMT	BDA	SML	AG	
		C03	20/01/2021	ISSUED FOR CONSTRUCTION & REVISED AS MKD. C03	AMT	BDA	SML	AG	
		C02	04/01/2021	ISSUED FOR CONSTRUCTION & REVISED AS MKD. C02	AMT	BDA	SML	AG	
MD-216-39MA-EG-ME-GAD-1001	LAYOUT WITH ZONE MARKINGS	C01	14/10/2020	ISSUED FOR CONSTRUCTION	AMT	BDA	SML	AG	
MD-216-3000-EG-CV-GAD-1001	PROCESS PLANT EARTHWORKS	A02	19/09/2020	REVISED AS MKD. A02	AMT	BDA	SML	AG	
MD-216-39MA-EG-ST-GAD-2001	PROCESS PLANT PIPE RACK CUM CABLE RACK	A01	19/08/2020	ISSUED FOR REFERENCE	AMT	BDA	SML	AG	

RESERVED FOR VENDOR LOGO AND DRAWING NUMBER

LARSEN & TOUBRO

This drawing is the property of LARSEN & TOUBRO and must not be passed on to any person or body not authorized by us to receive it nor be copied or otherwise made use either in full or in part by such person or body without our prior permission in writing.

Outotec

The content of these documents are the sole property of Outotec Oyj. Any rights not expressly granted herein are reserved. Reproduction, transfer or distribution of part or all of the contents in any form without prior written permission of Outotec is prohibited.

MA'ADEN معادن
Saudi Arabian Mining Company شركة معادن العربية السعودية

This document and the information contained herein is Ma'aden proprietary know-how. This document or any part thereof should not be reproduced, stored in a retrieval system or transmitted by any means, electronic or otherwise, or divulged without prior written permission of Ma'aden.

LARSEN & TOUBRO DRAWING NUMBER	019045_080_C_G_24012_011	REVISION 5
OUTOTEC DRAWING NUMBER	900707__GAU01__ZZ01__MTL01__00098	DOCUMENT ID OU100675368 / REVISION 5

DRAWN	AMT	13/08/2020
CHECKED	BDA	17/08/2020
ENGINEER	SML	13/08/2020
APPROVED	AG	19/08/2020
EMPLOYER		
SCALE	1:200,1:50,1:25	A1

MANSOURAH - MASSARAH GOLD PROJECT
GENERAL ARRANGEMENT
PROCESS PLANT PIPE RACK CUM CABLE RACK
PLAN & SECTIONS

DRAWING NUMBER: MD-216-39MA-EG-CV-GAD-1025 | REV: D01