


DRAWING NUMBER: MD-216-39WL-EG-CV-DED-1003 | REV: D01

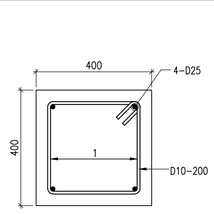


TYP DETAIL OF COL. MKD. C1
(SCALE 1:10)

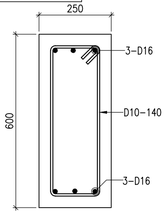


GB1 @ MIDSPAN & ENDSPAN
(SCALE 1:10)

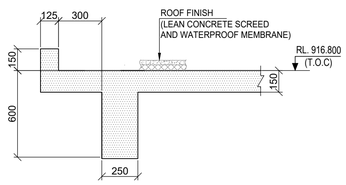


SECTION 2-2
(SCALE 1:20)

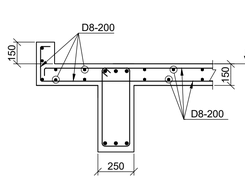


SECTION 2-2
(SHOWING RC DETAIL)
(SCALE 1:20)

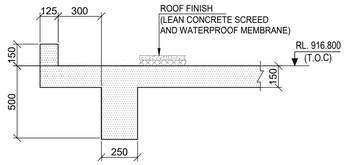

SECTION 1-1
(SCALE 1:20)

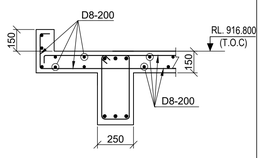



SECTION 1-1
(SHOWING RC DETAIL)
(SCALE 1:20)

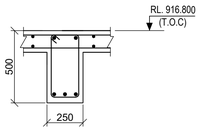


SECTION 3-3
(SHOWING RC DETAIL)
(SCALE 1:20)

KEYPLAN

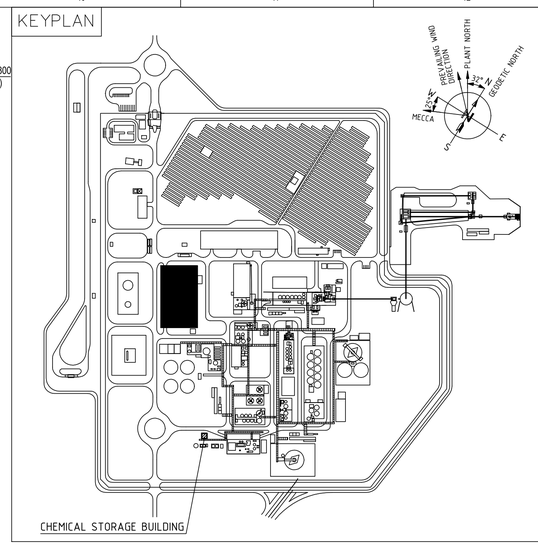


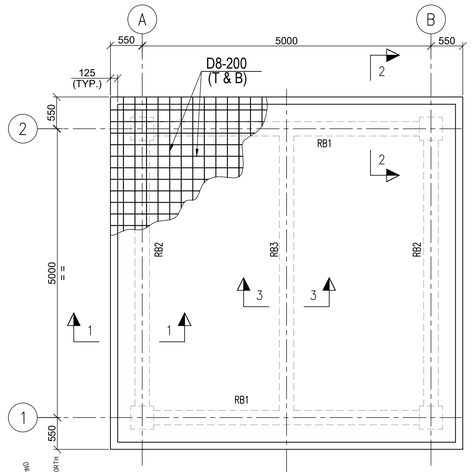


ROOF HOLLOW CORE SLAB LAYOUT
(SCALE 1:50)

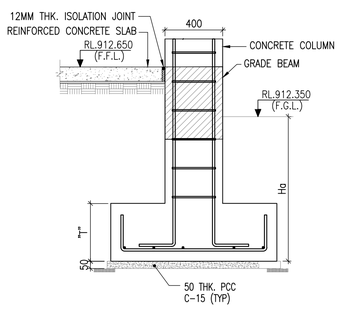

FOUNDATION SECTION
(SCALE 1:20)

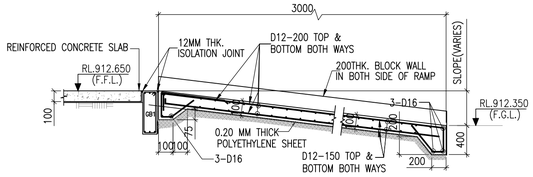

TYPICAL RAMP SECTION
(SCALE 1:20)

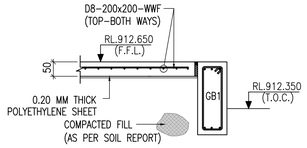

TYP SECTION FOR GRADE SLAB
(SCALE 1:10)

SCHEDULE OF FOOTINGS


FOOTING MARK	PLAIN CONCRETE			REINFORCED CONCRETE			BOTTOM REINFORCEMENT		TOP REINFORCEMENT		Ha	REMARKS
	L	W	T	L	W	T	SHORT BARS	LONG BARS	SHORT BARS	LONG BARS		
F1	2200	2200	50	2000	2000	400	D12-150	D12-150	D10-250	D10-250	1500	

SCHEDULE OF GRADE BEAMS


BEAM MARK	DIMENSIONS		STEEL REINFORCEMENT				STIRRUPS
			BOTTOM		TOP		
	WIDTH	DEPTH	STRAIGHT	ADD.	STRAIGHT	ADD.	
GB1	250	600	3-16	–	3-16	–	PROVIDE AT THE @DISTANCE OF L/3 FROM THE SUPPORT IN D10-200 IN THE END SPAN & MID SPAN

SCHEDULE OF ROOF BEAMS


BEAM MARK	DIMENSIONS		STEEL REINFORCEMENT				STIRRUPS	REMARKS
			TOP		BOTTOM			
	WIDTH	DEPTH	STRAIGHT	ADD.	STRAIGHT	ADD.		
RB1	250	600	3-16	–	3-16	–	PROVIDE AT THE @DISTANCE OF L/3 FROM THE SUPPORT IN D10-200 IN THE END SPAN & MID SPAN	REFER SECTION 1-1
RB2	250	500	3-16	–	3-16	–	PROVIDE AT THE @DISTANCE OF L/3 FROM THE SUPPORT IN D10-200 IN THE END SPAN & MID SPAN	REFER SECTION 2-2
RB2	250	500	2-16	–	2-16	1-20	PROVIDE AT THE @DISTANCE OF L/3 FROM THE SUPPORT IN D10-200 IN THE END SPAN & MID SPAN	REFER SECTION 3-3

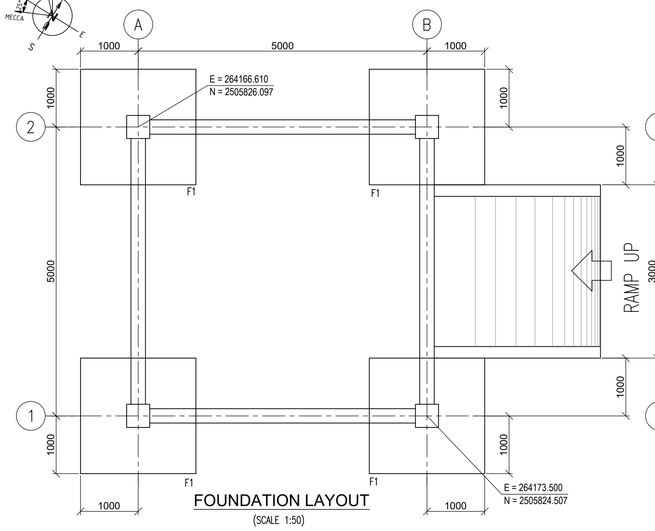

FOUNDATION LAYOUT
(SCALE 1:50)

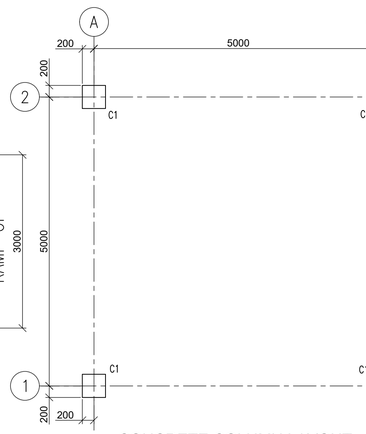

CONCRETE COLUMN LAYOUT
(SCALE 1:50)

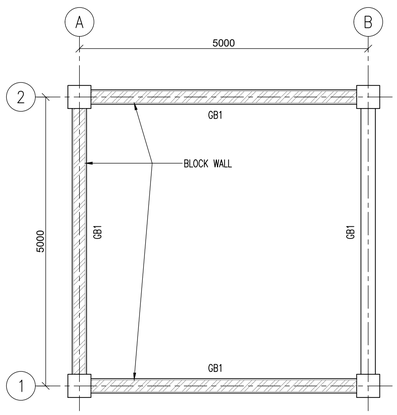

GRADE BEAM LAYOUT
(SCALE 1:50)

LEGEND :-

R.L. – REDUCED LEVEL
℄ – CENTRE LINE
T.O.C. – TOP OF CONCRETE
TYP. – TYPICAL
F.G.L. – FINISHED GROUND LEVEL
F.F.L. – FINISHED FLOOR LEVEL
B.O.F. – BOTTOM OF FOUNDATION
P.C.C – PLAIN CEMENT CONCRETE
DET. – DETAIL
BOTTOM REINFORCEMENT (B) – – – – – – –
TOP REINFORCEMENT (T) – ————————
SQ. – SQUARE
R.C. – REINFORCED CONCRETE
FDN. – FOUNDATION
THK. – THICK
COL. – COLUMN
MKD. – MARKED
RCC. – REINFORCED CEMENT CONCRETE
HCS. – HOLLOW CORE SLAB
REINF. – REINFORCEMENT
MM – MILIMETER
WWF – WELDED WIRE FABRIC

NOTES:-

1. ALL DIMENSIONS ARE IN MILLIMETRES AND LEVELS AND CO-ORDINATES ARE IN METRES UNLESS OTHERWISE STATED.
2. NET SAFE BEARING CAPACITY OF SOIL AT BOTTOM OF FOUNDATION CONSIDER 450KN/ SQ. M
3. GRADE OF CONCRETE SHALL BE C.35 (35MPa) FOR FOUNDATION & C15 (15MPa) FOR BLINDING CONCRETE.
4. GRADE OF REINFORCEMENT SHALL BE DEFORMED BAR 420 MPa (GRADE 60) – ASTM A615/A615M.
5. IF ANY PART OF FOUNDATION COMES ON BACKFILL ZONE OF ADJACENT FOUNDATION OR ANY LOOSE SOIL ARE ENCOUNTERED BELOW FOUNDATION LEVEL THE SAME SHALL BE REMOVED AND FILLED WITH PCC (C15).
6. FOR STANDARD REINFORCEMENT DETAIL & GENERAL NOTES FOR CIVIL WORKS REFER DRAWING NO. MD-216-1000-EG-CV-DED-1005 & 1001.

DOCUMENT NUMBER	REFERENCE DOCUMENTS	REV	DATE	REVISION DESCRIPTION	DRN	CHK	ENG	APP	EMP
		D01	09/03/2023	AS-BUILT	SYA	SJM	AVG	AG	
		C01	03/02/2022	ISSUED FOR CONSTRUCTION, REVISED AS PER EMPLOYER COMMENTS DATED 08/05/2021 & REVISED AS MARKED C01	SYA	SJM	AVG	AG	
		A01	08/04/2021	ISSUED FOR REVIEW	DSR	SJM	AVG	AG	

RESERVED FOR VENDOR LOGO AND DRAWING NUMBER

LARSEN & TOUBRO

This drawing is the property of LARSEN & TOUBRO and must not be passed on to any person or body not authorized by us to receive it nor be copied or otherwise made use either in full or in part by such person or body without our prior permission in writing.

Outotec

The content of these documents are the sole property of Outotec Oyj. Any rights not expressly granted herein are reserved. Reproduction, transfer or distribution of part or all of the contents in any form without prior written permission of Outotec is prohibited.

MA'ADEN معادن
Saudi Arabian Mining Company شركة التعدين العربية السعودية

This document and the information contained herein is Ma'aden proprietary know-how. This document or any part thereof should not be reproduced, stored in a retrieval system or transmitted by any means, electronic or otherwise, or divulged without prior written permission of Ma'aden.

LARSEN & TOUBRO DRAWING NUMBER: 019045_080_C_D_24651_001 | REVISION: 2
OUTOTEC DRAWING NUMBER: 900707__GAU01__AG11__CTB17__39126 | DOCUMENT ID: OU100720803 | REVISION: 2

DRAWN	DSR	03/04/2021
CHECKED	SJM	07/04/2021
ENGINEER	AVG	03/04/2021
APPROVED	AG	08/04/2021
EMPLOYER		
SCALE	1:50,20,10	A1

MANSOURAH - MASSARAH GOLD PROJECT
DETAIL DRAWING
POX & OXYGEN COOLING TOWER AREA
DETAIL OF CHEMICAL STORAGE BUILDING

DRAWING NUMBER: MD-216-39WL-EG-CV-DED-1003 | REV: D01