




DETAIL OF GRADE SLAB
(SCALE 1:10)

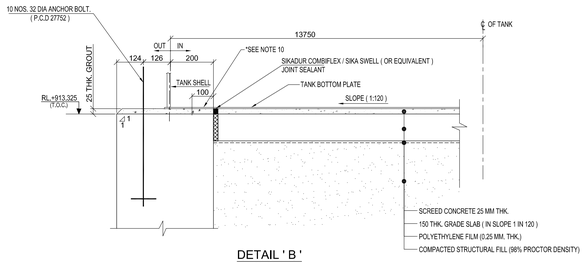


DETAIL ' B '
(SCALE 1:10)

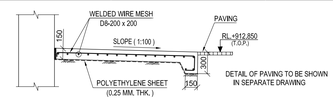


DETAIL 'X'
(SCALE 1:30)

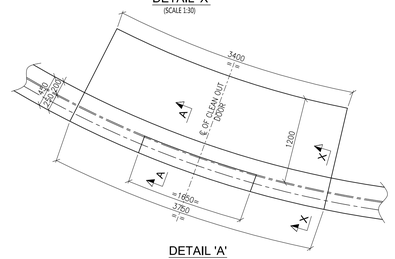


DETAIL 'A'
(SCALE 1:30)

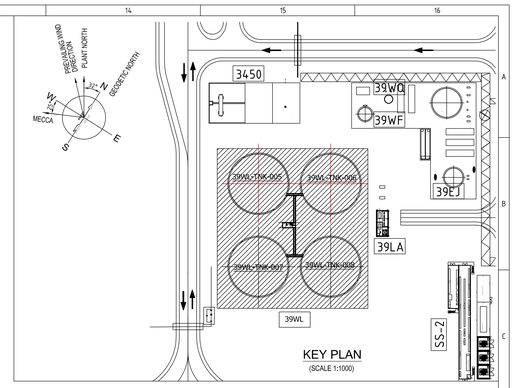


KEY PLAN
(SCALE 1:1000)

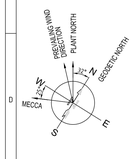


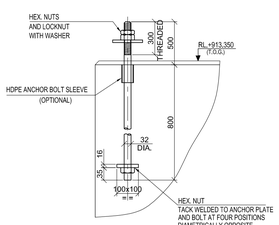


BOLT DETAIL
(SCALE 1:10)

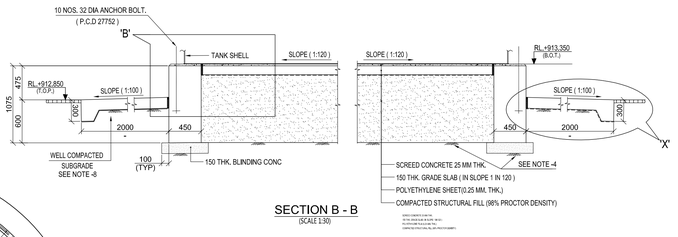


SECTION B - B
(SCALE 1:30)

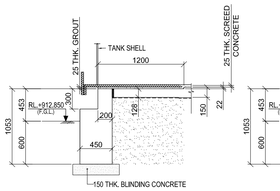


SECTION A-A
(SCALE 1:30)

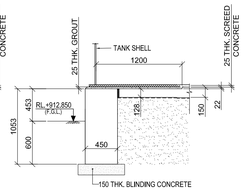


SECTION X-X
(SCALE 1:30)

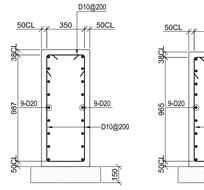


SECTION D-D
(SCALE 1:20)

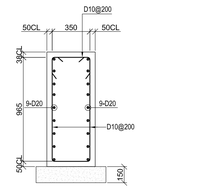


SECTION E1-E1
(SCALE 1:20)

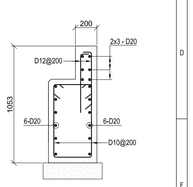


SECTION E-E
(SCALE 1:20)

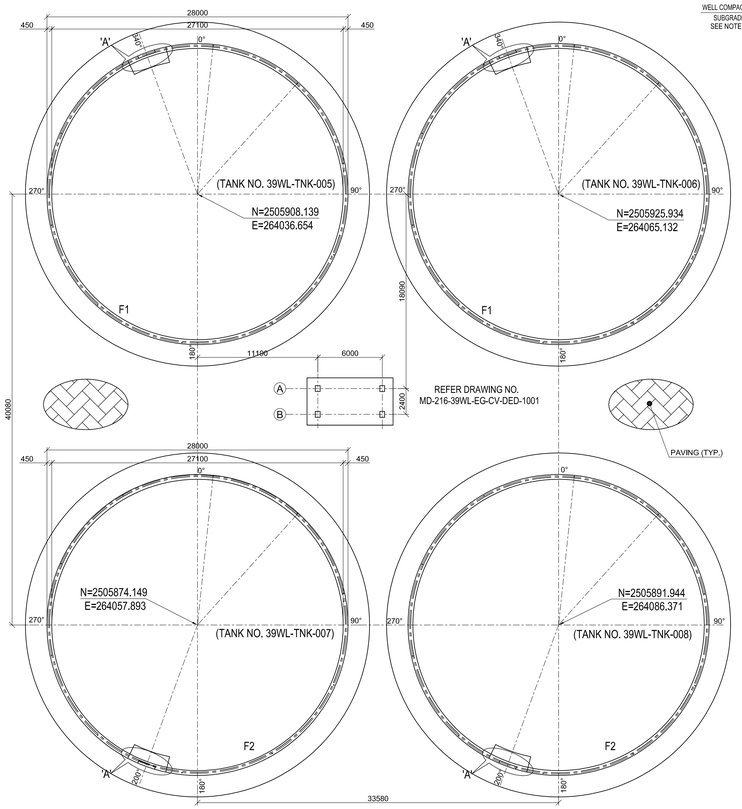

LAYOUT OF FOUNDATION
(SCALE 1:200)

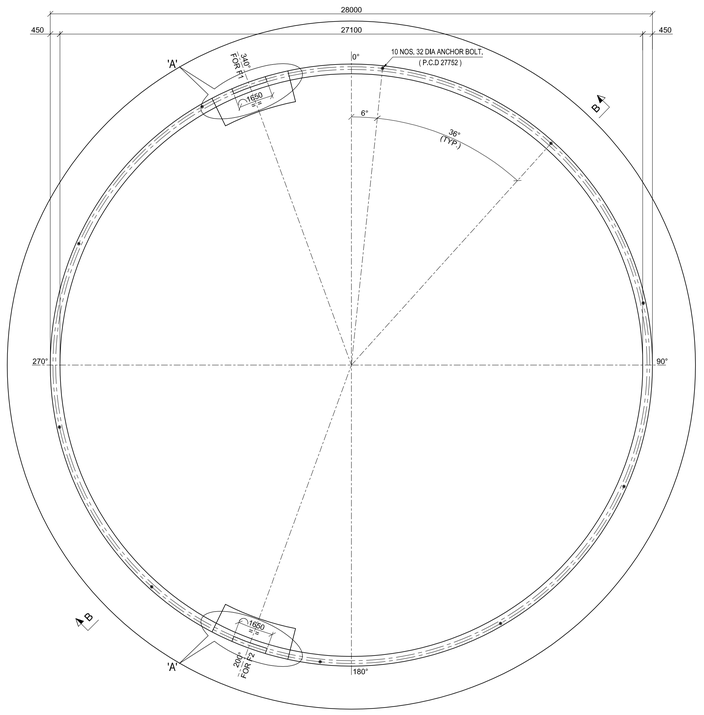

PLAN OF FDN. MKD. F1 & F2
(SCALE 1:100)

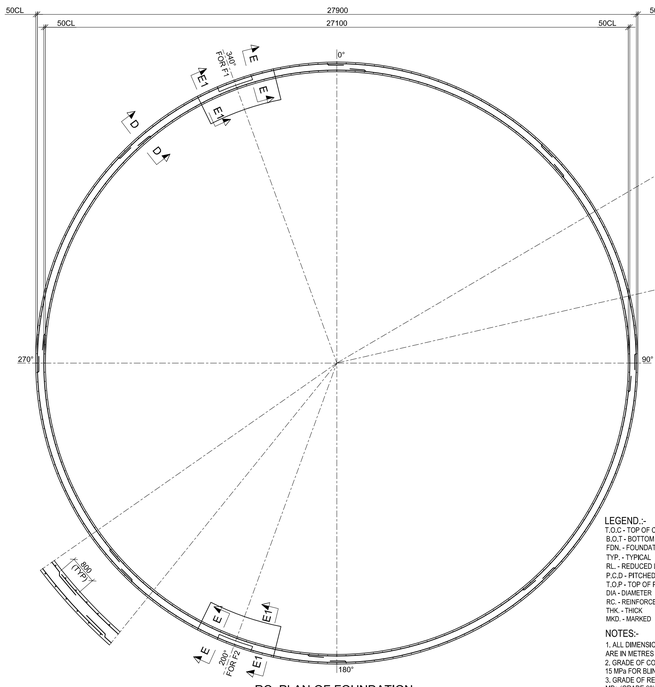

RC. PLAN OF FOUNDATION
(SCALE 1:100)

LEGEND.:-
T.O.C - TOP OF CONCRETE
B.O.T - BOTTOM OF TANK
FDN. - FOUNDATION
TYP. - TYPICAL
RL - REDUCED LEVEL
P.C.D - PITCHED CIRCLE DIAMETER
T.O.P - TOP OF PAVING
DIA - DIAMETER
RC. - REINFORCED CONCRETE
THK. - THICK
MKD. - MARKED

NOTES:-
1. ALL DIMENSIONS ARE IN MILLIMETRES . LEVELS & COORDINATES ARE IN METRES UNLESS OTHERWISE STATED.
2. GRADE OF CONCRETE SHALL BE 35 MPa FOR WALL & 15 MPa FOR BLINDING CONCRETE.
3. GRADE OF REINFORCEMENT SHALL BE DEFORMED BAR 420 MPa (GRADE 60)) - ASTM A615/A615M.
4. NET SAFE BEARING CAPACITY AT THE FOUNDING LEVEL CONSIDERED 375KN / SQ. M.
5. IF ANY PART OF FOUNDATION COMES ON BACKFILLED ZONE OF ADJACENT FOUNDATION OR ANY LOOSE POCKETS ARE ENCOUNTERED BELOW FOUNDATION LEVEL THE SAME SHALL BE REMOVED AND FILLED WITH PCC (15 MPa).
6. CLEAR COVER TO MAIN REINFORCEMENT SHALL BE WALL SIDES & BOT. = 50MM , TOP=98MM
7. THE CONTENT OF THIS DRAWING SHALL CONFORM TO THE PROVISIONS OF CIVIL, STRUCTURAL AND ARCHITECTURAL DESIGN CRITERIA DOCUMENT NO. MD-216-1000-EG-ST-CRT-1001.
8. 2M LENGTH APRON OUTSIDE THE TANK FOUNDATION ABOVE COMPACTED FILLING TO BE CAST BEFORE INSIDE COMPACTION.
9. TOP OF SCREED / GRADE SLAB TOLERANCE SHALL BE WITHIN +/- 10MM OF DESIGN LEVEL.
10. 100 MM GROUT TO BE PLACED FOR PLACEMENT OF SEALANT.
11. FOR BOLT EMBEDMENT AND PROJECTION LENGTH THIS DETAIL TO BE FOLLOWED. FOR OTHER INFORMATION REFER BOLT DRAWING NO MD-216-1000-EG-CV-DED-1003.

DOCUMENT NUMBER	REFERENCE DOCUMENTS	REV	DATE	REVISION DESCRIPTION	DRN	CHK	ENG	APP	EMP
MD-216-1000-EG-CV-DED-1002	DET. DWG. GRADE SLAB STANDARD DET. FOR PAVING	D01	20/1/2023	AS BUILT	ABS	SJM	AVG	AG	
MD-216-1000-EG-CV-DED-1003	ANCHOR BOLTS STANDARD DETAILS.	C04	28/07/2020	ISSUED FOR CONSTRUCTION & REVISED AS MARKED (04)	ABS	SJM	AVG	AG	
MD-216-39WL-EG-ST-GAD-2377	PLAN/ELEVATIONS & DETAILS OF TANK	C03	09/06/2020	ISSUED CONSTRUCTION	AUD	SJM	AVG	AG	
MD-216-1000-EG-ST-CRT-1001	CIVIL, STRUCTURAL & ARCHITECTURAL - DESIGN CRITERIA	C02	02/05/2020	ISSUED FOR APPROVAL & REVISED AS MARKED	AUD	SJM	AVG	AG	
MD-216-39WL-EG-ME-GAD-1002	GENERAL ARRANGEMENT RAW WATER TANK-3 & 39WL-TNK-007 & 39WL-TNK-008	C01	04/02/2020	ISSUED FOR CONSTRUCTION & REVISED AS MARKED.	AUD	SJM	AVG	AG	
MD-216-39WL-EG-ME-GAD-1001	GENERAL ARRANGEMENT RAW WATER TANK-1 & 2 39WL-TNK-005 & 39WL-TNK-006	A01	30/12/2019	ISSUED FOR REFERENCE	AUD	SJM	AVG	AG	

RESERVED FOR VENDOR LOGO AND DRAWING NUMBER

LARSEN & TOUBRO

This drawing is the property of LARSEN & TOUBRO and must not be passed on to any person or body not authorized by us to receive it or be copied or otherwise made use either in full or in part by such person or body without our prior permission in writing.

Outotec

The content of these documents are the sole property of Outotec Oyj. Any rights not expressly granted herein are reserved. Reproduction, transfer or distribution of part or all of the contents in any form without prior written permission of Outotec is prohibited.

MA'ADEN معادن
Saudi Arabian Mining Company شركة معادن العربية السعودية

This document and the information contained herein is Ma'aden proprietary know-how. This document or any part thereof should not be reproduced, stored in a retrieval system or transmitted by any means, electronic or otherwise, or divulged without prior written permission of Ma'aden.

LARSEN & TOUBRO DRAWING NUMBER: 019045_080_C_G_24179_001 — REVISION: 5
OUTOTEC DRAWING NUMBER: 900707__GAU01__AG11__MTL01__39000 — DOCUMENT ID: OU100666821 — REVISION: 5

DRAWN	AUD	09/12/2019
CHECKED	SJM	27/12/2019
ENGINEER	AVG	23/12/2019
APPROVED	AG	30/12/2019
EMPLOYER		
SCALE	1:100,20	A0

MANSOURAH - MASSARAH GOLD PROJECT
GENERAL ARRANGEMENT DRAWING
RAW WATER
LAYOUT & DETAIL OF TANK FOUNDATIONS

DRAWING NUMBER: MD-216-39WL-EG-CV-GAD-1448 — REV: D01