


DRAWING NUMBER MD-216-39WL-EG-CV-GAD-1550 REV D01

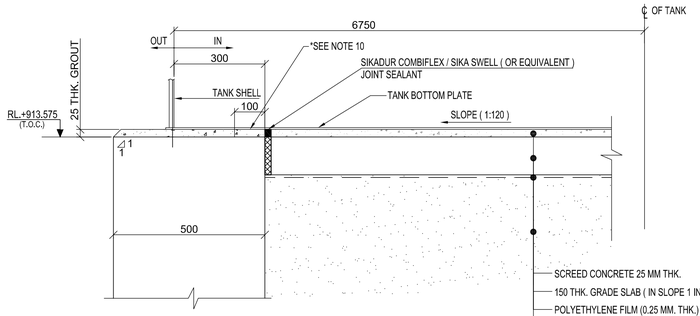


DETAIL ' B '
(SCALE 1:10)

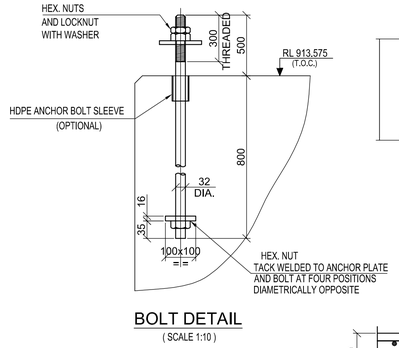


BOLT DETAIL
(SCALE 1:10)

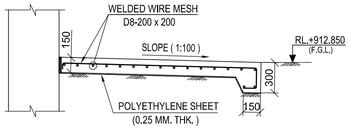


DETAIL 'X'
(SCALE 1:30)

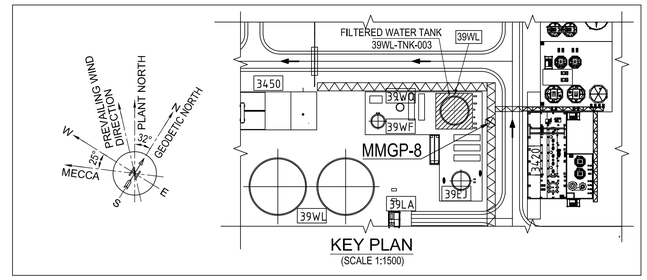


KEY PLAN
(SCALE 1:1500)

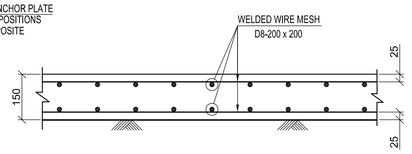


DETAIL OF GRADE SLAB
(SCALE 1:10)

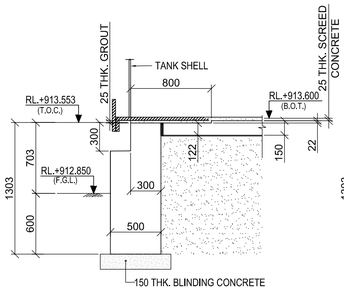


SECTION A-A
(SCALE 1:30)

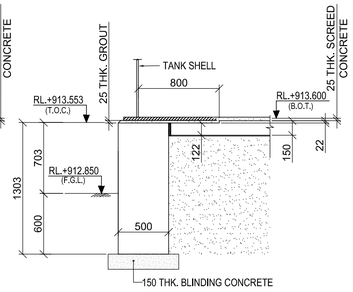


SECTION X-X
(SCALE 1:30)

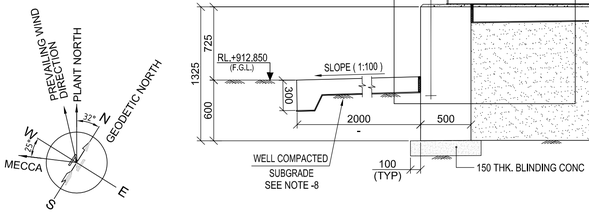


SECTION B - B
(SCALE 1:30)

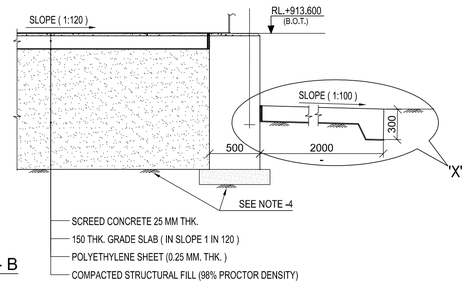


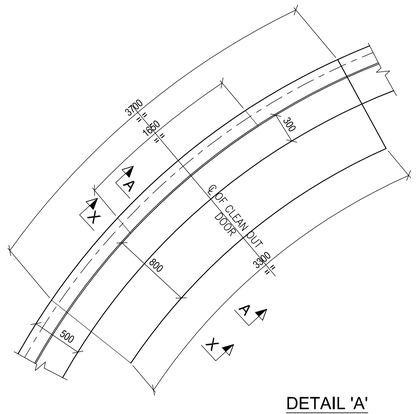


DETAIL 'A'
(SCALE 1:30)

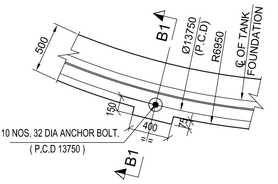


DETAIL 'C'
(SCALE 1:30)

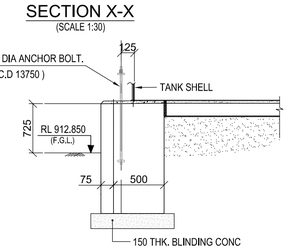


SECTION B1-B1
(SCALE 1:30)

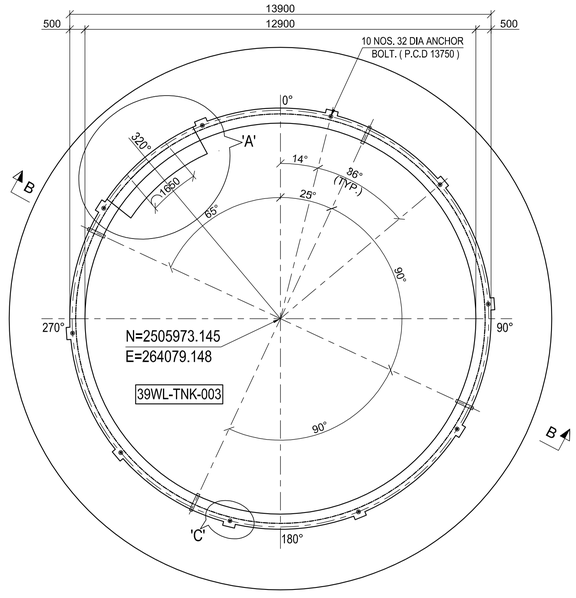


LAYOUT OF FOUNDATION
(SCALE 1:100)

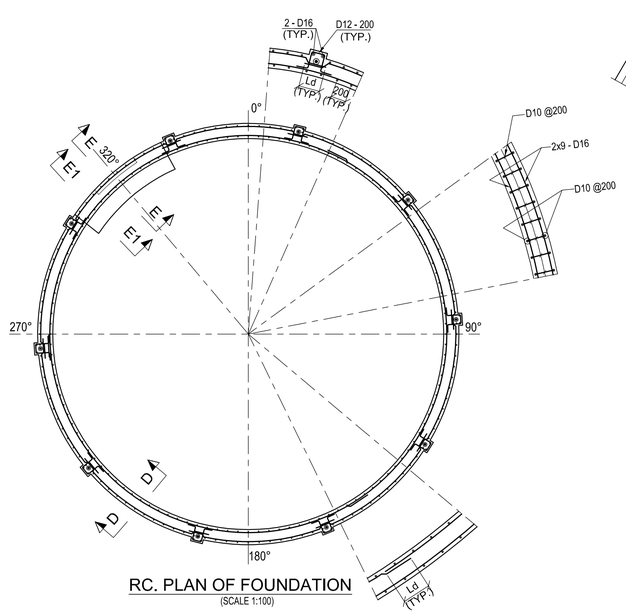


RC. PLAN OF FOUNDATION
(SCALE 1:100)

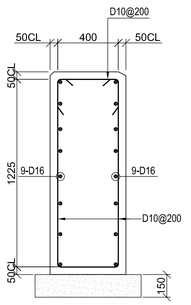

SECTION D-D
(SCALE 1:20)

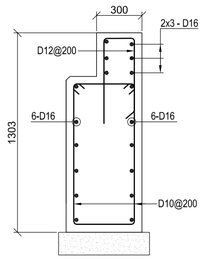

SECTION E-E
(SCALE 1:20)

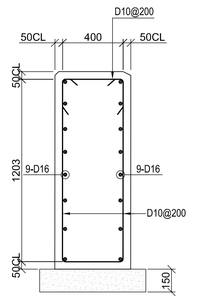

SECTION E1-E1
(SCALE 1:20)

LEGEND.:-
T.O.C - TOP OF CONCRETE
F.G.L - FINISHED GROUND LEVEL
B.O.T - BOTTOM OF TANK
FDN. - FOUNDATION
TYP. - TYPICAL
RL. - REDUCED LEVEL
P.C.D - PITCHED CIRCLE DIAMETER
F.D.N - FOUNDATION
DIA - DIAMETER
THK. - THICK
RC. - REINFORCED CONCRETE
℄ - CENTRE LINE

NOTES:-
1. ALL DIMENSIONS ARE IN MILLIMETRES , LEVELS & COORDINATES ARE IN METRES UNLESS OTHERWISE STATED.
2. GRADE OF CONCRETE SHALL BE 35 MPa FOR WALL & 15 MPa FOR BLINDING CONCRETE.
3. GRADE OF REINFORCEMENT SHALL BE DEFORMED BAR 420 MPa (GRADE 60)) - ASTM A615/A615M.
4. NET SAFE BEARING CAPACITY AT THE FOUNDING LEVEL CONSIDERED 375KN / SQ. M
5. IF ANY PART OF FOUNDATION COMES ON BACKFILLED ZONE OF ADJACENT FOUNDATION OR ANY LOOSE POCKETS ARE ENCOUNTERED BELOW FOUNDATION LEVEL THE SAME SHALL BE REMOVED AND FILLED WITH PCC (15 MPa).
6. CLEAR COVER TO MAIN REINFORCEMENT SHALL BE WALLS - 50MM.
7. THE CONTENT OF THIS DRAWING SHALL CONFORM TO THE PROVISIONS OF CIVIL, STRUCTURAL AND ARCHITECTURAL DESIGN CRITERIA DOC. NO. MD-216-1000-EG-ST-CRT-1001.
8. 2M WIDE APRON OUTSIDE THE TANK FOUNDATION ABOVE COMPACTED FILLING TO BE CAST BEFORE INSIDE COMPACTION .
9. TOP OF SCREED / GRADE SLAB TOLERANCE SHALL BE WITHIN +/- 10MM OF DESIGN LEVEL.
10. 100 MM GROUT TO BE PLACED FOR PLACEMENT OF SEALANT.

DOCUMENT NUMBER	REFERENCE DOCUMENTS	REV	DATE	REVISION DESCRIPTION	DRN	CHK	ENG	APP	EMP
MD-216-1000-EG-CV-DED-1003	ANCHOR BOLTS STANDARD DETAILS.	D01	20/7/2023	AS BUILT	AUD/ABS	SJM	AVG	AG	
MD-216-39WL-EG-ST-GAD-2382	PLAN, ELEV & DETAIL OF FILTERED WATER TANK	C02	24/07/2020	ISSUED FOR CONSTRUCTION & REVISED AS MARKED C02	AUD/ABS	SJM	AVG	AG	
MD-216-39W1-EG-ME-GAD-1017	CIVIL, STRUCTURAL AND ARCHITECTURAL DESIGN CRITERIA	C01	24/06/2020	ISSUED FOR CONSTRUCTION & REVISED AS MARKED C01	AUD	SJM	AVG	AG	
MD-216-39WL-EG-ME-GAD-1005	FILTERED WATER STORAGE TANK 39WL-TNK-003	A01	21/03/2020	ISSUED FOR REFERENCE	AUD	SJM	AVG	AG	

RESERVED FOR VENDOR LOGO AND DRAWING NUMBER

LARSEN & TOUBRO
This drawing is the property of LARSEN & TOUBRO and must not be passed on to any person or body not authorized by us to receive it nor be copied or otherwise made use either in full or in part by such person or body without our prior permission in writing.

Outotec
The content of these documents are the sole property of Outotec Oyj. Any rights not expressly granted herein are reserved. Reproduction, transfer or distribution of part or all of the contents in any form without prior written permission of Outotec is prohibited.

MA'ADEN معادن
Saudi Arabian Mining Company شركة التعدين العربية السعودية
This document and the information contained herein is Ma'aden proprietary know-how. This document or any part thereof should not be reproduced, stored in a retrieval system or transmitted by any means, electronic or otherwise, or divulged without prior written permission of Ma'aden.

LARSEN & TOUBRO DRAWING NUMBER	019045_080_C_G_24179_003	REVISION 3
OUTOTEC DRAWING NUMBER	900707 _GAU01 _AG11 _MTL01 _39119	DOCUMENT ID OU100669279 / REVISION 3

DRAWN	AUD	13/02/2020
CHECKED	SJM	28/02/2020
ENGINEER	AVG	29/02/2020
APPROVED	AG	21/03/2020
EMPLOYER		
SCALE	1:100, 1:30, 1:20, 1:10	A1

MANSOURAH - MASSARAH GOLD PROJECT
GENERAL ARRANGEMENT
RAW WATER
LAYOUT & DETAIL OF FILTERED WATER TANK FDN.

DRAWING NUMBER MD - 216 - 39WL- EG- CV - GAD - 1550 REV D01