


DRAWING NUMBER: MD-216-39WL-EG-CV-GAD-1551 | REV: D01

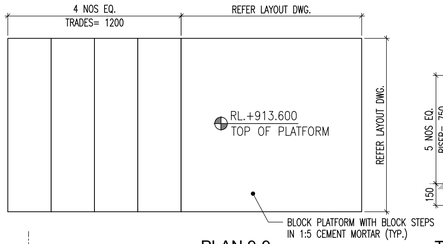


PLAN 9-9
(SCALE 1:20)

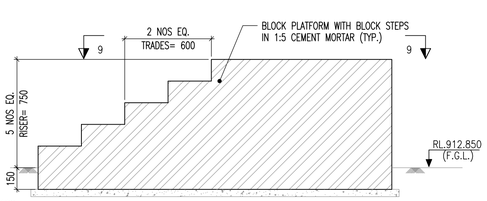


TYP. DETAIL OF PLATFORM WITH BLOCK STEP
(NEAR TANK MKD. 39WL-TNK-003)
(SCALE 1:20)

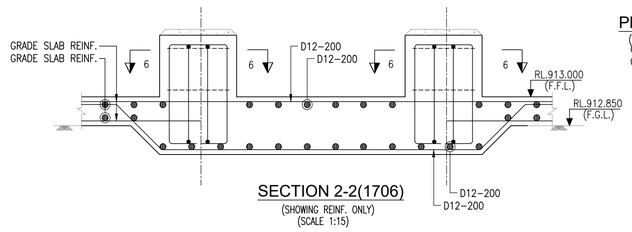


SECTION 2-2(1706)
(SHOWING REINF. ONLY)
(SCALE 1:15)

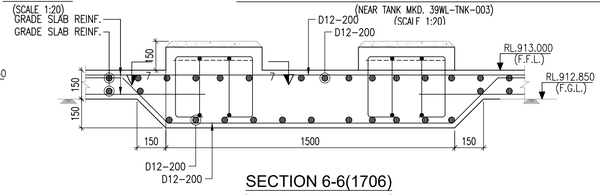


SECTION 6-6(1706)
(REINF. DETAI OF PEDESTAL MKD. P6)
(SCALE 1:25)

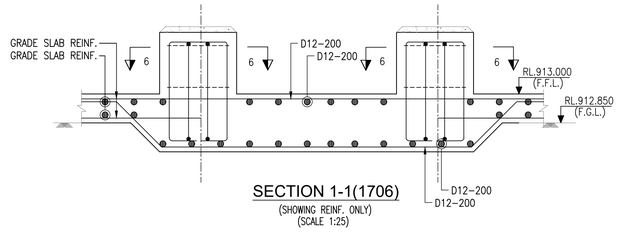


SECTION 1-1(1706)
(SHOWING REINF. ONLY)
(SCALE 1:25)

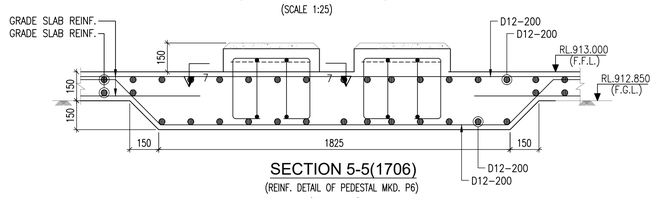


SECTION 5-5(1706)
(REINF. DETAIL OF PEDESTAL MKD. P6)
(SCALE 1:25)

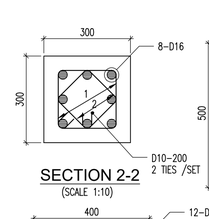


SECTION 2-2
(SCALE 1:10)

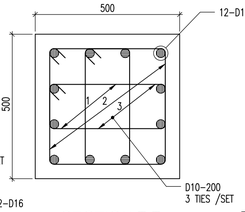


SECTION 7-7
(DETAIL OF PEDESTAL MKD. P6)
(SCALE 1:10)

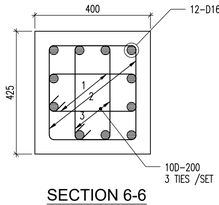


SECTION 6-6
(SCALE 1:10)

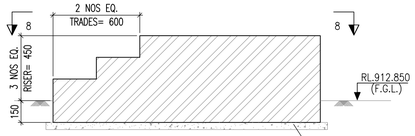


TYP. DETAIL OF PLATFORM WITH BLOCK STEP
(NEAR TANK MKD. 39WL-TNK-001)
(SCALE 1:20)

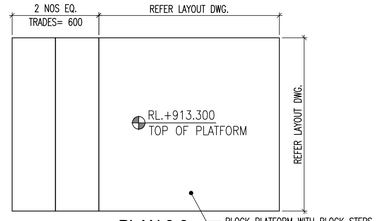


PLAN 8-8
(SCALE 1:20)

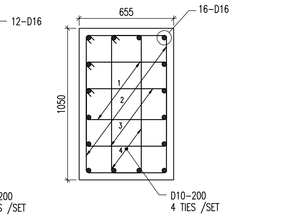


DETAIL OF PED. MKD. P1
(SCALE 1:20)

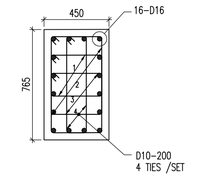


DETAIL OF PED. MKD. P2
(SCALE 1:20)

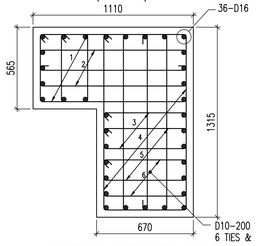


DETAIL OF PED. MKD. P3
(SCALE 1:20)

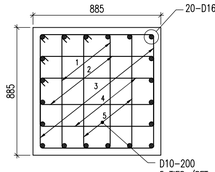

DETAIL OF PED. MKD. P5
(SCALE 1:20)

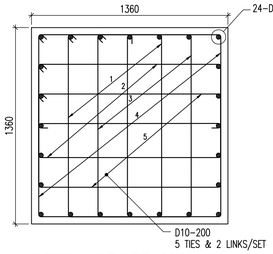


DETAIL OF PED. MKD. P4
(SCALE 1:20)

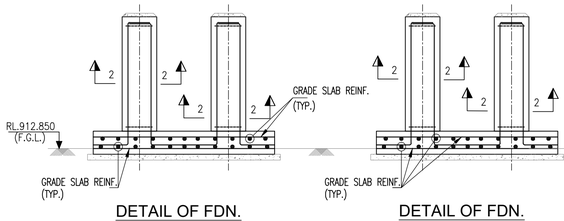


DETAIL OF FDN.
MKD. CF2
(SCALE 1:25)

DETAIL OF FDN.
MKD. CF3
(SCALE 1:25)

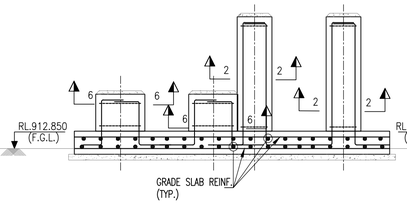

DETAIL OF FDN.
MKD. CF4
(SCALE 1:25)

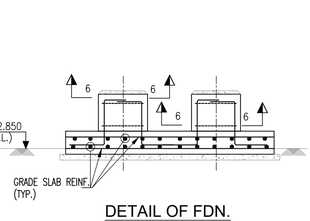


DETAIL OF FDN.
MKD. CF5
(SCALE 1:25)

LEGEND :-


R.L. - REDUCED LEVEL
℄ - CENTRE LINE
T.O.C. - TOP OF CONCRETE
TYP. - TYPICAL
F.G.L. - FINISHED GROUND LEVEL
F.F.L. - FINISHED FLOOR LEVEL
B.O.F. - BOTTOM OF FOUNDATION
MKD. - MARKED
R.C.C - REINFORCED CEMENT CONCRETE
P.C.C - PLAIN CEMENT CONCRETE
N.T.S. - NOT TO SCALE
EXP. JT. - EXPANSION JOINT
DET. - DETAIL
BOTTOM REINFORCEMENT (B) - - - - - - -
TOP REINFORCEMENT (T) - ———
SQ. - SQUARE
R.C. - REINFORCED CONCRETE
FDN. - FOUNDATION
THK. - THICK
SUPPT. - SUPPORT

NOTES:-

1. ALL DIMENSIONS ARE IN MILLIMETRES AND LEVELS AND CO-ORDINATES ARE IN METRES UNLESS OTHERWISE STATED.
2. NET SAFE BEARING CAPACITY OF SOIL AT BOTTOM OF FOUNDATION CONSIDER 200KN/ SQ. M
3. GRADE OF CONCRETE SHALL BE C35 (35MPa) FOR FOUNDATION & C15 (15MPa) FOR BLINDING CONCRETE.
4. GRADE OF REINFORCEMENT SHALL BE DEFORMED BAR 420 MPa (GRADE 60) – ASTM A615/A615M.
5. IF ANY PART OF FOUNDATION COMES ON BACKFILL ZONE OF ADJACENT FOUNDATION OR ANY LOOSE SOIL ARE ENCOUNTERED BELOW FOUNDATION LEVEL THE SAME SHALL BE REMOVED AND FILLED WITH PCC (C15).
6. CLEAR COVER TO REINFORCEMENT SHALL BE a. FOUNDATIONS = 50 MM., b. COLUMNS = 50 MM.
7. FOR STANDARD REINFORCEMENT DETAIL & GENERAL NOTES FOR CIVIL WORKS REFER DRAWING NO. MD-216-1000-EG-CV-DED-1005 & 1001.
8. THIS DRAWING SHOULD BE READ IN CONJUNCTION WITH DRAWING NO. MD-216-39WL-EG-CV-GAD-1706, MD-216-39WL-EG-CV-GAD-1707, 1708 ,1709, 1710, 1716 & 1717

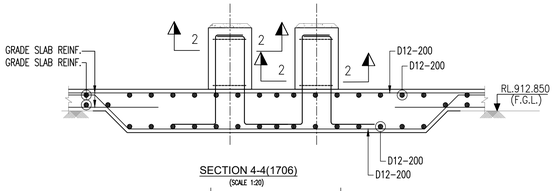

SECTION 4-4(1706)
(SCALE 1:20)

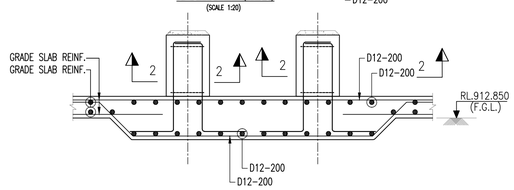

SECTION 3-3(1706)
(SCALE 1:20)

DOCUMENT NUMBER	REFERENCE DOCUMENTS	REV	DATE	REVISION DESCRIPTION	DRN	CHK	ENG	APP	EMP
MD-216-39WL-EG-CV-GAD-1707	DETAIL OF FOUNDATION								
MD-216-39WL-EG-CV-GAD-1706	LAYOUT & DETAIL OF FOUNDATION	D01	09/03/2023	AS-BUILT	TEC	AVG	TEC	AG	
MD-216-1000-EG-ST-CRT-1001	CIVIL, STRUCTURAL & ARCHITECTURAL-DESIGN CRITERIA	C02	15/03/2021	ISSUED FOR CONSTRUCTION AND REVISED AS MKD. C02	TEC	AVG	TEC	AG	
MD-216-3310-EG-ME-GAD-1055	PLAN AT EL. +913.000	C01	05/01/2021	ISSUED FOR CONSTRUCTION	TEC	AVG	TEC	AG	
MD-216-3310-EG-CV-GAD-1177	LAYOUT & DETAIL OF GRADE SLAB	A01	30/11/2020	ISSUED FOR APPROVAL	TEC	AVG	TEC	AG	

RESERVED FOR VENDOR LOGO AND DRAWING NUMBER

LARSEN & TOUBRO
This drawing is the property of LARSEN & TOUBRO and must not be passed on to any person or body not authorized by us to receive it nor be copied or otherwise made use either in full or in part by such person or body without our prior permission in writing.

Outotec
The content of these documents are the sole property of Outotec Oyj. Any rights not expressly granted herein are reserved. Reproduction, transfer or distribution of part or all of the contents in any form without prior written permission of Outotec is prohibited.

MA'ADEN معادن
Saudi Arabian Mining Company شركة التعدين العربية السعودية
This document and the information contained herein is Ma'aden proprietary know-how. This document or any part thereof should not be reproduced, stored in a retrieval system or transmitted by any means, electronic or otherwise, or divulged without prior written permission of Ma'aden.

LARSEN & TOUBRO DRAWING NUMBER: 019045_080_C_G_24179_004 | REVISION: 3
OUTOTEC DRAWING NUMBER: 900707 _GAU01 _AG11 _MTL01 _39136 | DOCUMENT ID: 0U100673638 | REVISION: 3

DRAWN	TEC	25/11/2020
CHECKED	AVG	28/11/2020
ENGINEER	TEC	26/11/2020
APPROVED	AG	30/11/2020
EMPLOYER		
SCALE	1:20, 1:50, 1:150	A1

MANSOURAH - MASSARAH GOLD PROJECT
GENERAL ARRANGEMENT
RAW WATER
RCC. DET. OF PIPE & PLATFROM SUPPT. FOUNDATION

DRAWING NUMBER: MD-216-39WL-EG-CV-GAD-1551 | REV: D01