


DRAWING NUMBER: MD-216-39WL-EG-CV-GAD-1695 REV D01

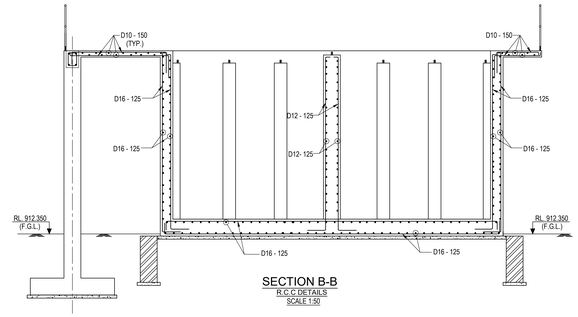


SECTION B-B
R.C.C DETAILS
SCALE 1:50

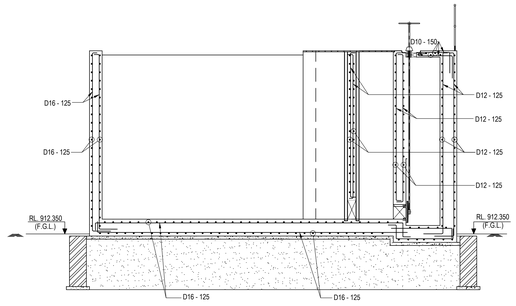


SECTION A-A
R.C.C DETAILS
SCALE 1:50

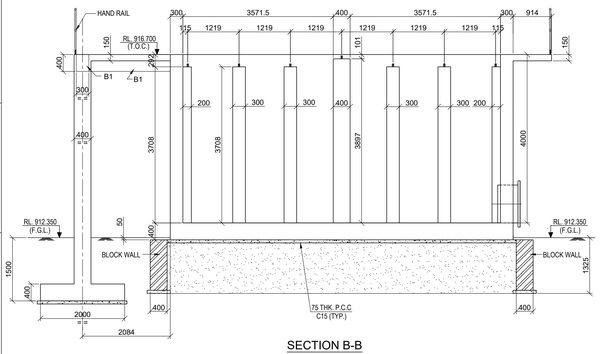


SECTION B-B
SCALE 1:50

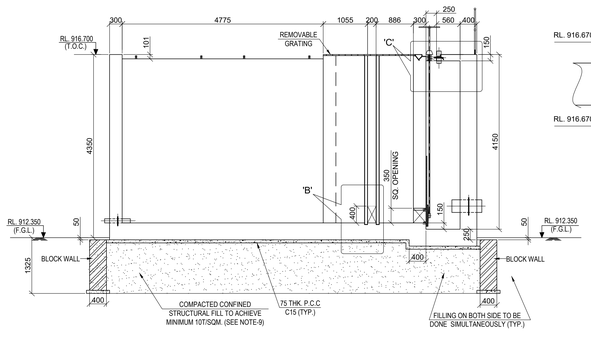


SECTION A-A
SCALE 1:50

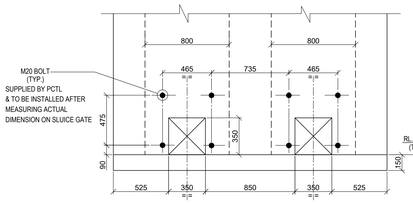


VIEW F-F
SCALE 1:20

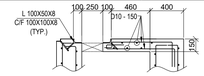


DETAIL 'C'
R.C.C DETAILS
SCALE 1:25

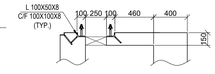


DETAIL 'C'
SCALE 1:25

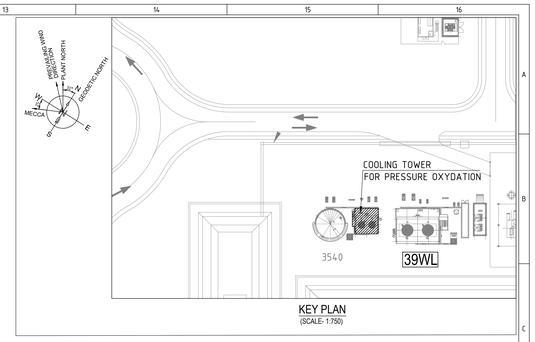


KEY PLAN
(SCALE- 1:750)

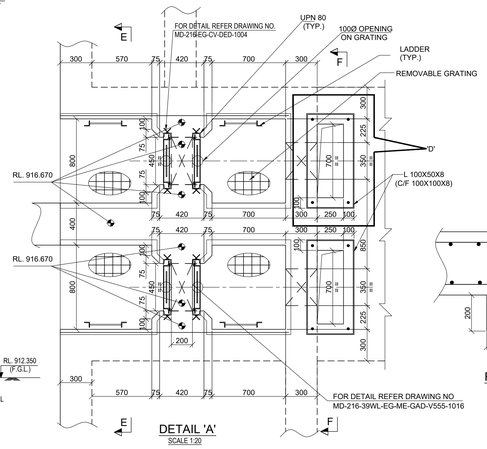


DETAIL 'A'
SCALE 1:20

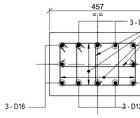


R.C DETAILS OF P4
SCALE 1:10

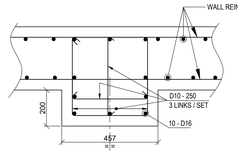


R.C DETAILS OF P3
SCALE 1:10

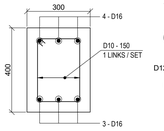


R.C DETAILS BEAM MARKED B1
SCALE 1:10

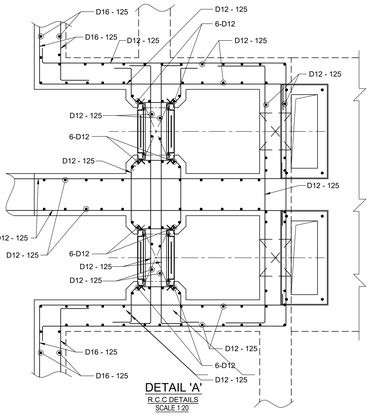


DETAIL 'A'
R.C.C DETAILS
SCALE 1:20

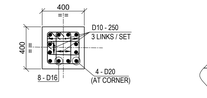


R.C DETAILS OF C1
SCALE 1:20

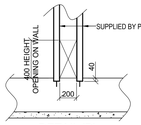


DETAIL 'B'
SCALE 1:25

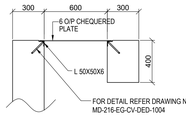


SECTION D-D
SCALE 1:20

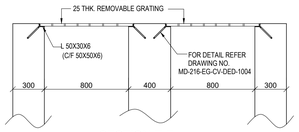


SECTION E-E
SCALE 1:20

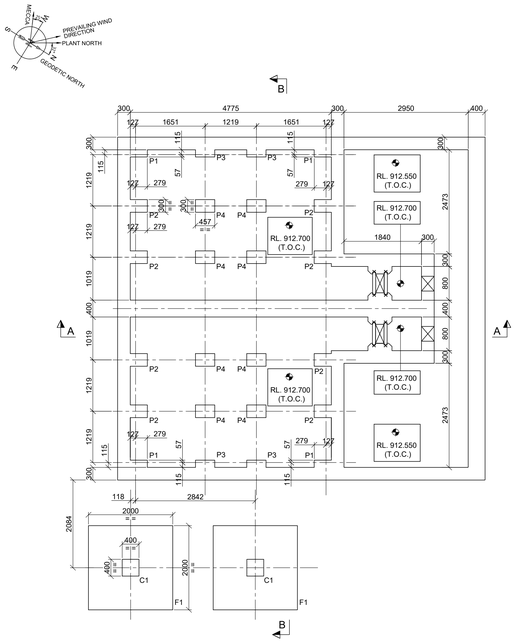


LAYOUT OF FOUNDATION FOR POX COOLING TOWER
SCALE 1:50

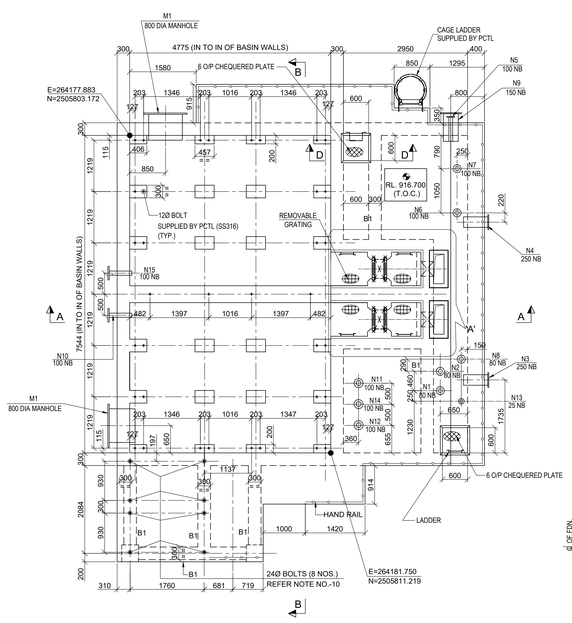


PLAN OF POX COOLING TOWER AT RL. 916.700
SCALE 1:50

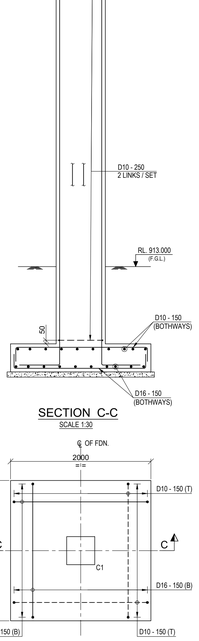


SECTION C-C
SCALE 1:30

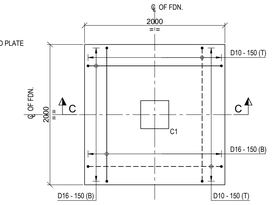


R.C DETAILS OF FOUNDATION MKD. F1
SCALE 1:30

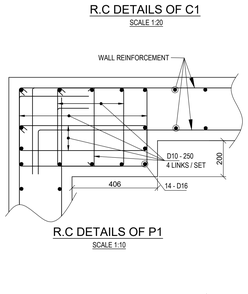


R.C DETAILS OF P1
SCALE 1:10

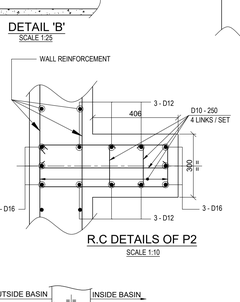


R.C DETAILS OF P2
SCALE 1:10

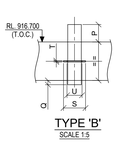

TYPE 'B'
SCALE 1:5

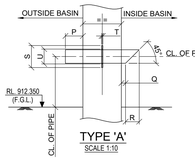

TYPE 'A'
SCALE 1:10

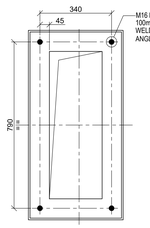

DETAIL 'D'
SCALE 1:10

LEGEND :-

R.L. - REDUCED LEVEL
℄ - CENTRE LINE
T.O.C. - TOP OF CONCRETE
T.O.G. - TOP OF GROUT
TYP. - TYPICAL
F.G.L. - FINISHED GROUND LEVEL
B.O.F. - BOTTOM OF FOUNDATION
P.C.D. - PITCH CIRCLE DIAMETER
Ø - DIAMETER
DIA - DIAMETER
I.D. - INTERNAL DIAMETER
P.C.C - PLAIN CEMENT CONCRETE
MKD. - MARKED
THK. - THICK
R.C.C. - REINFORCED CEMENT CONCRETE
HEX - HEXAGONAL
HDPE - HIGH DENSITY POLYETHYLENE
PL. - PLATE
C/C - CENTRE TO CENTRE
FDN. - FOUNDATION
DET. - DETAIL
DRG. - DRAWING
PCTL - PAHARPUR COOLING TOWERS LTD.

NOTES :-

1. ALL DIMENSIONS ARE IN MILLIMETRES AND LEVELS AND CO-ORDINATES ARE IN METRES, UNLESS OTHERWISE STATED.
2. GRADE OF CONCRETE SHALL BE C35 FOR FOUNDATION.
3. GRADE OF REINFORCEMENT SHALL BE DEFORMED BAR ASTM-A615 - GRADE 60 (fy = 420 MPa).
4. NET SAFE BEARING CAPACITY OF SOIL AT BOTTOM OF RAFT HAS BEEN CONSIDERED 100KN/SQ. M. AND BOTTOM OF FOUNDATION HAS BEEN CONSIDERED 200KN/SQ. M.
5. IF ANY PART OF FOUNDATION COMES ON BACKFILL ZONE OF ADJACENT FOUNDATION OR ANY LOOSE SOIL ARE ENCOUNTERED BELOW FOUNDATION LEVEL THE SAME SHALL BE REMOVED AND FILLED WITH PCC (15MPa).
6. CLEAR COVER TO REINFORCEMENT SHALL BE AS
   a) RAFT, WALL & COLUMN = 50mm
   b) BEAM = 25mm
   c) SLAB = 20mm
7. MINIMUM LAP LENGTH OF REINFORCEMENT SHALL BE 40 x DIA. OF BAR AS PER DRAWING NO. MD-216-1000-EG-CV-DED-1001 (GENERAL NOTES FOR CIVIL WORKS)
8. THE CONTENT OF THIS DRAWING SHALL CONFORM TO THE PROVISIONS OF CIVIL, STRUCTURAL & ARCHITECTURAL DESIGN CRITERIA DOCUMENT NO. MD-216-1000-EG-ST-CRT-1001.
9. THE STRUCTURAL FILL SHALL CONFORM TO PROVISIONS OF DOCUMENT NO. MD-216-1000-EG-CV-MST-1698.
10. PIPE SUPPORTS ON COOLING TOWER SHALL BE INSTALLED BY CHEMICAL BOLTS.
11. CAGE LADDER TO FAN DECK IS TO BE ANCHORED BY CHEMICAL BOLTS (SUPPLIED BY PCTL) SUIT AT SITE SITUATION AFTER INSTALLATION OF FRP COOLING TOWER.

NOZZLE SCHEDULE (POX COOLING TOWER BASIN)

NOZZLE NO.	SIZE (DN)	DESCRIPTION	MATERIAL	TYPE	PROJECTION P	PROJECTION Q	PROJECTION R	PUDDLE FLANGE S	PUDDLE FLANGE U	PUDDLE FLANGE T	CL. OF PIPE ELEVATION	LOCATION
N1	80	AUTO BACKWASH FILTER OUTLET	SS316	B	150	100	-	170	93	8	-	BASIN TOP
N2	80	AUTO BACKWASH FILTER OUTLET CONTROL VALVE BYPASS	SS316	B	150	100	-	170	93	8	-	BASIN TOP
N3	250	POX COLD WATER SUPPLY PUMP 1 SUCTION	SS316	A	250	100	273	400	276	10	913.100	BASIN WALL
N4	250	POX COLD WATER SUPPLY PUMP 2 SUCTION	SS316	A	250	100	273	400	276	10	913.100	BASIN WALL
N5	100	COMMON COLD WELL DRAIN	SS316	A	200	100	-	200	118	8	912.600	BASIN WALL
N6	100	DM WATER MAKE UP	SS316	B	150	100	-	200	118	8	-	BASIN TOP
N7	100	DM WATER MAKE UP _BYPASS	SS316	B	150	100	-	200	118	8	-	BASIN TOP
N8	80	PUMP RECIRCULATION LINE	SS316	B	150	100	-	170	93	8	-	BASIN TOP
N9	150	OVERFLOW	SS316	A	200	100	-	265	170	10	916.350	BASIN WALL
N10	100	DRAIN	SS316	A	200	0	-	200	118	8	912.750	BASIN WALL
N11	100	LEVEL TRANSMITTER LT 95031	ASTM A53 GR.B	B	100	100	-	200	118	8	-	BASIN TOP
N12	100	SPARE C/W BLIND	ASTM A53 GR.B	B	150	100	-	200	118	8	-	BASIN TOP
N13	25	CHEMICAL INLET	SS316	B	150	100	-	85	37	6	-	BASIN TOP
N14	100	VENT	ASTM A53 GR.B	B	150	100	-	200	118	8	-	BASIN TOP
N15	100	DRAIN	SS316	A	200	0	-	200	118	8	912.750	BASIN WALL
M1	750	MANHOLE	SS316	A	150	0	-	1000	766	16	913.150	BASIN WALL
M2	750	MANHOLE	SS316	A	150	0	-	1000	766	16	913.150	BASIN WALL

DOCUMENT NUMBER	REFERENCE DOCUMENTS	REV	DATE	REVISION DESCRIPTION	DRN	CHK	ENG	APP	EMP
		D01	09/03/2023	AS-BUILT	AUD	SJM	SNM	AG	
MD-216-39WL-EG-ME-GAD-V555-1020	SLUICE GATE FOR POX COOLING TOWER	C02	31/12/2020	ISSUED FOR CONSTRUCTION & AND REVISE DAS MARKED_C02	AUD	SJM	SNM	AG	
MD-216-39WL-EG-ME-GAD-V555-1009	STAIRCAE, PLATFORMS & LADDER FOR COOLING TOWER	C01	06/11/2020	ISSUED FOR CONSTRUCTION	SYA	SJM	SNM	AG	
MD-216-39WL-EG-ME-GAD-V555-1008	POX COOLING TOWER	A01	10/10/2020	ISSUED FOR APPROVAL	SYA	SJM	SNM	AG	

RESERVED FOR VENDOR LOGO AND DRAWING NUMBER

LARSEN & TOUBRO
This drawing is the property of LARSEN & TOUBRO and must not be passed on to any person or body not authorized by us to receive it nor be copied or otherwise made use either in full or in part by such person or body without our prior permission in writing.
Outotec
The content of these documents are the sole property of Outotec Oyj. Any rights not expressly granted herein are reserved. Reproduction, transfer or distribution of part or all of the contents in any form without prior written permission of Outotec is prohibited.
MA'ADEN معادن Saudi Arabian Mining Company شركة معادن العربية السعودية
This document and the information contained herein is Ma'aden proprietary know-how. This document or any part thereof should not be reproduced, stored in a retrieval system or transmitted by any means, electronic or otherwise, or divulged without prior written permission of Ma'aden.

LARSEN & TOUBRO DRAWING NUMBER			REVISION
019045_080_C_G_24976_001			3
OUTOTEC DRAWING NUMBER		DOCUMENT ID	REVISION
900707__GAU01__AG11__MTL01__39196		OU100696027	3
DRAWN	SYA	22/09/2020	MANSOURAH - MASSARAH GOLD PROJECT
CHECKED	SJM	24/09/2020	GENERAL ARRANGEMENT DRAWING
ENGINEER	SNM	22/09/2020	POX COOLING TOWER
APPROVED	AG	10/10/2020	PLAN, ELEVATION AND DETAILS
EMPLOYER			
SCALE	1:50, 25, 20, 10	A0	DRAWING NUMBER: MD-216-39WL-EG-CV-GAD-1695 REV: D01