

LEGENDS

AREA	DESCRIPTION
1	WEIGHBRIDGE
2	NOT USED
3	WAREHOUSE OUTSIDE LAYDOWN
4	NOT USED
5	WORKSHOP
6	LABORATORY
7	ENGINEERING OFFICE
8	CONTROL ROOM
9	NOT USED
25	ACIDIC EVENT POND
26	CYANIDE EVENT POND
27	PASTE THICKENER EVENT POND
37	BUS STOP
38	SECURITY GATE 5
39	MOSQUE
43	ABLUTION
44	ADMIN BUILDING
45	EMERGENCY SERVICES BUILDING
46	NOT USED
47	COMMUNICATION TOWER

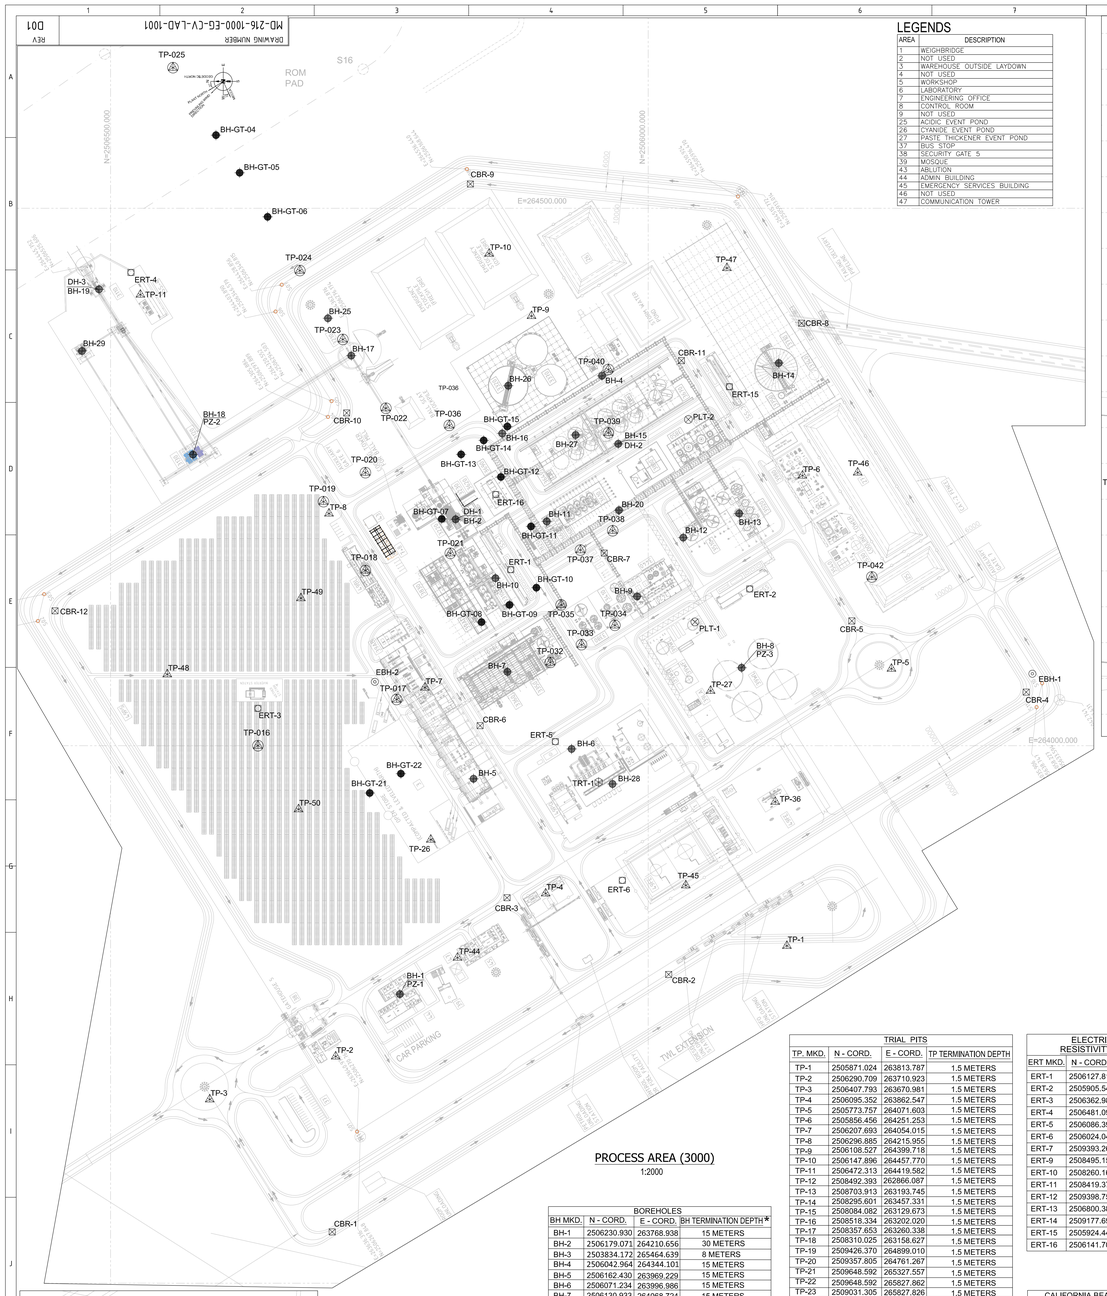

PROCESS AREA (3000)
1:2000

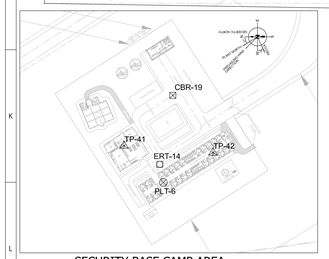

SECURITY BASE CAMP AREA
1:1000

BOREHOLES			
BH MKD.	N - CORD.	E - CORD.	BH TERMINATION DEPTH*
BH-1	2506230.930	263768.938	15 METERS
BH-2	2506179.071	264210.656	30 METERS
BH-3	2503834.172	265464.639	8 METERS
BH-4	2506042.964	264344.101	15 METERS
BH-5	2506162.430	263969.229	15 METERS
BH-6	2506071.234	263996.986	15 METERS
BH-7	2506130.933	264068.724	15 METERS
BH-8	2505913.117	264072.548	15 METERS
BH-9	2506010.372	264138.908	15 METERS
BH-10	2506142.028	264155.853	15 METERS
BH-11	2506094.386	264208.644	15 METERS
BH-12	2505967.370	264193.575	15 METERS
BH-13	2505915.358	264216.032	15 METERS
BH-14	2505878.500	264355.994	15 METERS
BH-15	2506027.885	264280.822	30 METERS
BH-16	2506135.791	264290.480	15 METERS
BH-17	2506276.168	264362.880	15 METERS
BH-18	2506423.387	264270.887	15 METERS
BH-19	2506510.835	264424.563	30 METERS
BH-20	2506027.189	264219.066	15 METERS
BH-21	2508267.290	263178.795	15 METERS
BH-22	2509287.328	265495.284	15 METERS
BH-23	2505158.977	264306.200	15 METERS
BH-25	2506297.894	264397.650	15 METERS
BH-26	2506130.164	264334.912	15 METERS
BH-27	2506067.527	264289.071	15 METERS
BH-28	2506033.191	263964.386	15 METERS
BH-29	2506526.604	264367.166	15 METERS

DOWN HOLE SEISMIC TEST		
DH. MKD.	N - CORD.	E - CORD.
DH-1(WITHIN BH-2)	2506179.071	264210.656
DH-2 (WITHIN BH-15)	2506027.885	264280.822
DH-3 (WITHIN BH-19)	2506510.835	264424.583

PIEZOMETER TEST		
PZ. MKD.	N - CORD.	E - CORD.
PZ-1(WITHIN BH-1)	2506230.930	263768.938
PZ-2 (WITHIN BH-18)	2506423.387	264270.887
PZ-3 (WITHIN BH-8)	2505913.117	264072.548

THERMAL RESISTIVITY TEST		
TRT. MKD.	N - CORD.	E - CORD.
TRT-1	2506046.160	263966.171

* NOTE:- DEPTH TO BE FINALISED AFTER DISCUSSION WITH TESTING AGENCY

TRIAL PITS			
TP. MKD.	N - CORD.	E - CORD.	TP TERMINATION DEPTH
TP-1	2505871.024	263813.787	1.5 METERS
TP-2	2506290.709	263710.923	1.5 METERS
TP-3	2506407.793	263670.981	1.5 METERS
TP-4	2506095.352	263862.547	1.5 METERS
TP-5	2505773.757	264071.603	1.5 METERS
TP-6	2505856.456	264251.253	1.5 METERS
TP-7	2506207.693	264054.015	1.5 METERS
TP-8	2506296.885	264215.955	1.5 METERS
TP-9	2506108.527	264399.718	1.5 METERS
TP-10	2506147.896	264457.770	1.5 METERS
TP-11	2506472.313	264419.582	1.5 METERS
TP-12	2508492.393	262866.087	1.5 METERS
TP-13	2508703.913	263193.745	1.5 METERS
TP-14	2508295.601	263457.331	1.5 METERS
TP-15	2508084.082	263129.673	1.5 METERS
TP-16	2508516.334	263202.020	1.5 METERS
TP-17	2508357.653	263260.338	1.5 METERS
TP-18	2508310.025	263158.627	1.5 METERS
TP-19	2509426.370	264899.010	1.5 METERS
TP-20	2509357.805	264761.267	1.5 METERS
TP-21	2509648.592	265327.557	1.5 METERS
TP-22	2509648.592	265827.862	1.5 METERS
TP-23	2509031.305	265827.826	1.5 METERS
TP-24	2509031.300	265327.560	1.5 METERS
TP-25	2508286.441	262982.705	1.5 METERS
TP-26	2506202.226	263912.559	1.5 METERS
TP-27	2505941.986	264051.068	1.5 METERS
TP-28	2504886.341	262381.915	1.5 METERS
TP-29	2502543.025	263678.220	1.5 METERS
TP-30	2503431.597	268590.000	1.5 METERS
TP-31	2506475.534	268590.000	1.5 METERS
TP-32	2510479.237	266377.762	1.5 METERS
TP-33	2514933.124	263916.776	1.5 METERS
TP-34	2514686.696	262156.429	1.5 METERS
TP-35	2510985.789	262295.647	1.5 METERS
TP-36	2505881.869	263947.835	1.5 METERS
TP-41	2509194.335	261836.091	1.5 METERS
TP-42	2509152.968	261832.920	1.5 METERS
TP-43	2506673.817	263892.737	1.5 METERS
TP-44	2506177.327	263802.776	1.5 METERS
TP-45	2505965.004	263870.119	1.5 METERS
TP-46	2505805.123	264254.097	4 METERS
TP-47	2505926.765	264444.343	4 METERS
TP-48	2506447.348	264066.431	1.5 METERS
TP-49	2506322.996	264137.259	1.5 METERS
TP-50	2506325.231	263940.870	1.5 METERS

ELECTRICAL RESISTIVITY TEST		
ERT MKD.	N - CORD.	E - CORD.
ERT-1	2506127.818	264163.775
ERT-2	2505905.541	264145.847
ERT-3	2506362.987	264034.715
ERT-4	2506481.090	264440.232
ERT-5	2506086.398	264003.793
ERT-6	2506024.040	263874.764
ERT-7	2509393.269	264888.439
ERT-9	2508495.158	263255.302
ERT-10	2508260.166	263217.165
ERT-11	2508419.379	263058.270
ERT-12	2509398.759	265649.455
ERT-13	2506800.380	263714.984
ERT-14	2509177.693	261827.469
ERT-15	2505924.444	264333.985
ERT-16	2506141.706	264233.672

CALIFORNIA BEARING RATIO		
CBR. MKD.	N - CORD.	E - CORD.
CRB-1	2506293.900	263547.697
CBR-2	2505980.974	263787.176
CBR-3	2506131.287	263858.582
CBR-4	2505648.408	264049.895
CBR-5	2505810.594	264116.104
CBR-6	2506156.333	264018.629
CBR-7	2506040.884	264179.207
CBR-8	2505857.328	264393.021
CBR-9	2506165.392	264522.509
CBR-10	2506280.463	264309.592
CBR-11	2505969.066	264358.264
CBR-12	2506551.675	264125.477
CBR-13	2508722.706	263203.218
CBR-14	2508063.024	263118.687
CBR-15	2509004.189	265854.978
CBR-16	2509675.708	265300.441
CBR-17	2504718.247	264445.364
CBR-19	2509171.635	261659.561

ENVIRONMENTAL BOREHOLES		
EBH. MKD.	N - CORD.	E - CORD.
EBH-1	2505642.661	264066.961
EBH-2	2506254.243	264059.434
EBH-3	2509547.711	265768.778

PLATE LOAD TESTS		
PLT. MKD.	N - CORD.	E - CORD.
PLT-1	2505956.533	264115.134
PLT-2	2505962.600	264303.475
PLT-3	2508417.463	263018.466
PLT-6	2509176.016	261819.089


LEGENDS

3000	PROCESS PLANT
4100	ACCOMODATION VILLAGE
50	TAILING POND
51	MINING OPERATION MAINTENANCE (BY OTHERS)
52	WATER TREATMENT AND STORAGE
53	WASTE DRYING BED
54	WASTE WATER TREATMENT
55	CARBAGE COLLECTION AREA
56	MINING VILLAGE (BY OTHERS)
57	MAADEN PMC TEMP ACCOMODATION (BY OTHERS)
58	CONSTRUCTION CAMP
59	CONSTRUCTION LAYDOWN YARD
60	HELICOPTER PAD
61	NOT USED
62	FACULTY SECURITY FORCE BASE CAMP
63	GOVERNMENT SECURITY BUILDING
64	OVERWATCH TOWER
65	ROM PAD
66	FACILITY BY OTHERS




SITE PLAN
1:30000


VILLAGE AREA (4100)
1:2500

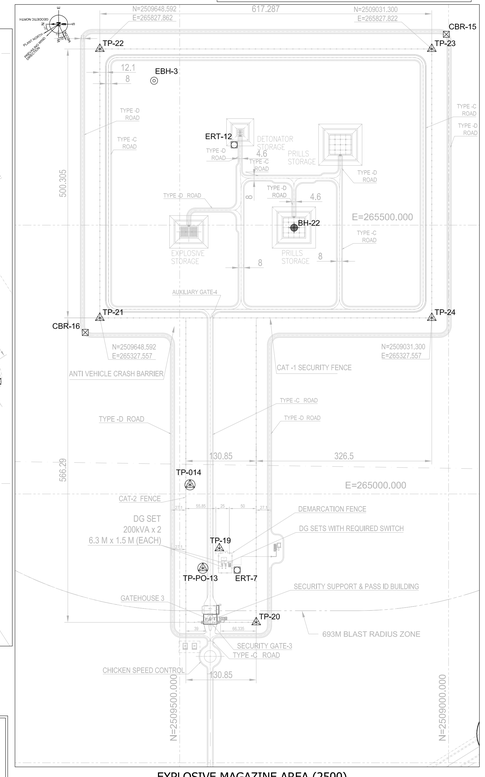

EXPLOSIVE MAGAZINE AREA (2500)
(FUTURE SCOPE)
1:4000

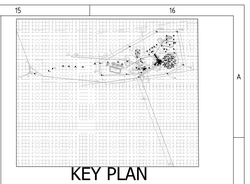

KEY PLAN

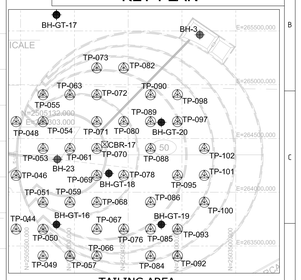

TAILING AREA
1:20000

PROPOSED TESTS TO BE CONDUCTED		
BH	-	BORE HOLE
TP	-	TRIAL PIT
CBR	-	CALIFORNIA BEARING RATIO
PLT	-	PLATE LOAD TEST
EBH	-	ENVIRONMENTAL BORE HOLE
ERT	-	ELECTRICAL RESISTIVITY TEST
DH	-	DOWN HOLE SEISMIC TEST
TRT	-	THERMAL RESISTIVITY TEST

EXISTING BH & TRIAL PITS (PROVIDED IN MAADEN GEOTECHNICAL INVESTIGATION REPORT # MD-216-0000-CP-CT-RFP-0111, C01)

BH-GT	- CLIENT BORE HOLE
TP,TP-PO &TP-WWP	- CLIENT TRIAL PIT

LIST OF UNITS :-

AREA	DESCRIPTION
3110	PRIMARY CRUSHING
3120	SECONDARY CRUSHING
3130	TERTIARY CRUSHING
3210	CRUSHED ORE STORAGE AND TRANSFER
3220	GRINDING AND CLASSIFICATION – BALL MILL
3230	GRINDING AND CLASSIFICATION – GRAVITY CONCENTRATOR
3310	FLOTATION ROUGHER/SCAVENGER/CLEANER
3320	LOW GRADE THICKENING
3340	CONCENTRATE THICKENING
3350	CONCENTRATE FILTRATION
3360	CONCENTRATE STORAGE AND REPULP
3370	FLOTATION PROCESS WATER STORAGE AND DISTRIBUTION
3380	ACIDULATION
3410	PRESSURE OXIDATION – AUTOCLAVE FEED STORAGE
3420	PRESSURE OXIDATION – AUTOCLAVE, FLASH VESSEL & SCRUBBER
3440	PRESSURE OXIDATION – HOT ACID CURE
3450	PRESSURE OXIDATION – SERVICES
3510	CCD CIRCUIT & POX CONDITIONING
3520	NEUTRALIZATION AND THICKENING
3530	CCD & POX – PROCESS WATER COOLING
3540	CCD & POX – PROCESS WATER STORAGE
3610	POX LEACHING/ADSORPTION
3620	POX INTENSIVE CYANIDE LEACHING
3640	LOW GRADE CONDITIONING/LEACHING/ADSORPTION
3650	POX ACID WASH/ELUTION/CARBON REGENERATION
3660	LOW GRADE ACID WASH / ELUTION / CARBON REGEN
3670	PRIMARY CYANIDE DESTRUCTION
3680	CONDITIONING & LEACHING & CARBON CIRCUITS ELECTROWIN
3690	GOLD ROOM & ELECTROWINNING & CALCINING & SMELTING
3710	TAILINGS PASTE THICKENING
3720	TAILINGS DISPOSAL/TAILINGS MANAGEMENT FACILITY PIPELINE
3740	TAILINGS & CIL SECONDARY CYANIDE DESTRUCTION
3750	TAILINGS & CIL PROCESS WATER STORAGE
3810	REAGENTS – CAUSTIC AND CYANIDE
3820	REAGENTS – HYDROCHLORIC ACID/SULPHAMIC ACID
3830	REAGENTS – FLOTATION
3840	REAGENTS – FLOCCULANT
3850	REAGENTS – LIME SLAKING
3860	REAGENTS – LIMESTONE
3890	REAGENTS – SMBS & PEROXIDE
39RL	RAW WATER
39LA	FIRE WATER SYSTEM
39WQ	GLAND WATER / MINE WATER
39WF	POTABLE WATER STORAGE AND DISTRIBUTION
39EJ	DEMINERALISATION SYSTEM
39AD	LOW PRESSURE AIR
39AB	PLANT AIR DISTRIBUTION
39AA	INSTRUMENT AIR
39MA	PIPE RACKS
3980	OXYGEN PLANT
4000	OTHER BUILDINGS
1800	HEALTH & SAFETY & SECURITY AND RISK
49RD	INTERNAL ROADS AND DRAINAGE
44ID	TAILINGS MANAGEMENT FACILITY CHANNEL/DRAINAGE/POND
49EE	WASTE DISPOSAL
49PR	POWER GENERATION
49PD	POWER DISTRIBUTION
49PS	SOLAR POWER PLANT
49FE	FUEL STORAGE
49FE	FUEL STORAGE(LPG)
49RA	ACCESS ROAD
39WI	BOOSTER PUMP STATION & PROCESS WATER SUPPLY
49WF	POTABLE WATER SUPPLY
49BL	LABORATORY
49CD	IT AND COMMUNICATIONS SYSTEM

NOTES:-
1. ALL DIMENSIONS ARE IN M.
2. ALL CO ORDINATES ARE IN M.
3. THIS DWG. SHALL BE READ IN CONJUNCTION WITH DWG. NO. 019045_001_T_B_24754_002
5. THE GEOTECHNICAL TEST POINTS ARE INDICATED AS PER RECENT LAYOUT DATED 13.09.19.

DOCUMENT NUMBER	REFERENCE DOCUMENTS	DOCUMENT NUMBER	REFERENCE DOCUMENTS

REV	DATE	REVISION DESCRIPTION	DRN	CHK	ENG	APP	EMP
D01	11/10/2023	AS BUILT	SYA	MLI	MLI	SJM	
C01	06/02/2020	ISSUED FOR CONSTRUCTION	SYA	MLI	MLI	SJM	
00	08-07-2019	FIRST ISSUE	SYA	MLI	MLI	SJM	
05	16-09-2019	ADDITION OF TEST POINTS AT EXPLOSIVE MAGAZINE AREA & BH-28 & BH-29 ADDED DUE TO LAYOUT CHANGE ON 10.09.19	SYA	MLI	MLI	SJM	
04	10-09-2019	BORE HOLE MARKED BH-26 & BH-27 ADDED, ERT16 SHIFTED DUE TO LAYOUT CHANGE ON 09.09.19 & TRT-1 ADDED (AS MKD.)	SYA	MLI	MLI	SJM	
03	23-08-2019	HOLD RELEASED	SYA	MLI	MLI	SJM	
02	09-08-2019	REVISED DUE TO LAYOUT CHANGE & DELETION OF TEST POINTS AT EXPLOSIVE MAGAZINE	SYA	MLI	MLI	SJM	
01	02-08-2019	REVISED DUE TO LAYOUT CHANGE & FOLLOWING TEST POINTS ARE RELEASED FOR SITE EXECUTION:- BH-2, BH-9, BH10, BH-18, BH-19, DH-1, DH-3, PZ-2	SYA	MLI	MLI	SJM	

RESERVED FOR VENDOR LOGO AND DRAWING NUMBER

LARSEN & TOUBRO

This drawing is the property of LARSEN & TOUBRO and must not be passed on to any person or body not authorised by us to receive it nor be copied or otherwise made use either in full or in part by such person or body without our prior permission in writing.

Outotec

The content of these documents are the sole property of Outotec Oyj. Any rights not expressly granted herein are reserved. Reproduction, transfer or distribution of part or all of the contents in any form without prior written permission of Outotec is prohibited.

MA'ADEN معادن Saudi Arabian Mining Company شركة معادن للتعدين العربية السعودية

This document and the information contained herein is Ma'aden proprietary know-how. This document or any part thereof should not be reproduced, stored in a retrieval system or transmitted by any means, electronic or otherwise, or divulged without prior written permission of Ma'aden.

LARSEN & TOUBRO DRAWING NUMBER			REVISION 7
019045_001_T_B_24754_001			
OUTOTEC DRAWING NUMBER		DOCUMENT ID	REVISION 4
900707_GAU01_ZZ01_CLD01_00003		OU100656268	
DRAWN	SYA	08-07-2019	MANSOURAH - MASSARAH GOLD PROJECT
CHECKED	MLI	08-07-2019	SITE PLAN
ENGINEER	MLI	08-07-2019	PLANT LAYOUT AND SOIL TEST LOCATIONS
APPROVED	SJM	08-07-2019	
EMPLOYER			
SCALE	1:30000,20000,4500 1:3000,2500,2000	A0	DRAWING NUMBER MD-216-1000-EG-CV-LAD-1001 REV D01