DRAWING NUMBER MD-216-1000-EG-CV-LAD-1002
REV D01


CALIFORNIA BEARING RATIO		
CBR. MKD.	N - CORD.	E - CORD.
CBR-18	2534651.919	253824.634

PLATE LOAD TESTS		
PLT MKD.	N - CORD.	E - CORD.
PLT-7	2534564.884	253852.927

BOREHOLES			
BH MKD.	N - CORD.	E - CORD.	BH TERMINATION DEPTH
BH-24	2534552.227	253867.978	15 METERS

TRIAL PITS		
TP. MKD.	N - CORD.	E - CORD.
TP-37	2534619.029	253854.142
TP-38	2534608.733	253870.308
TP-39	2534579.037	253868.695
TP-40	2534627.258	253782.267

ELECTRICAL RESISTIVITY TEST		
ERT MKD.	N - CORD.	E - CORD.
ERT-8	2534576.695	253857.848
ERT-17	2503964.671	248619.869
ERT-18	2519172.333	264866.555

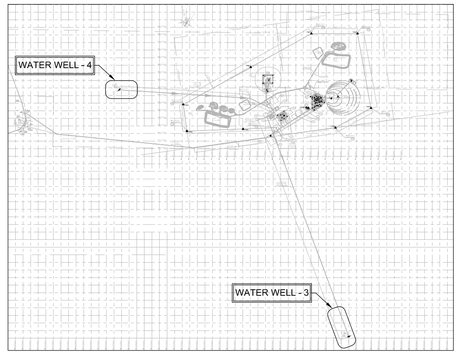


KEY PLAN
1:200000



BOOSTER PUMPING STATION
SCALE - 1:350

THIS DRAWING SUPERSEDES, MA'ADEN DRAWING NUMBER MD-216-1000-EG-CV-DLA-0002, REVISION A01

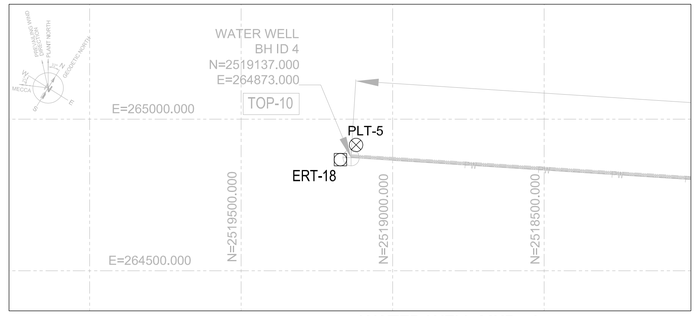


WATER WELL MKD. 4
SCALE - 1:10000

LEGEND:-

- BH - BORE HOLE
- TP - TRIAL PIT
- CBR - CALIFORNIA BEARING RATIO
- PLT - PLATE LOAD TEST
- ERT - ELECTRICAL RESISTIVITY TEST

PLATE LOAD TESTS		
PLT MKD.	N - CORD.	E - CORD.
PLT-4	2504043.156	248605.515
PLT-5	2519120.662	264915.080

NOTES:-
1. ALL DIMENSIONS ARE IN M.
2. ALL CO ORDINATES ARE IN M.
3. THIS DWG. SHALL BE READ IN CONJUNCTION WITH DWG. NO. 019045_001_T_B_24754_001

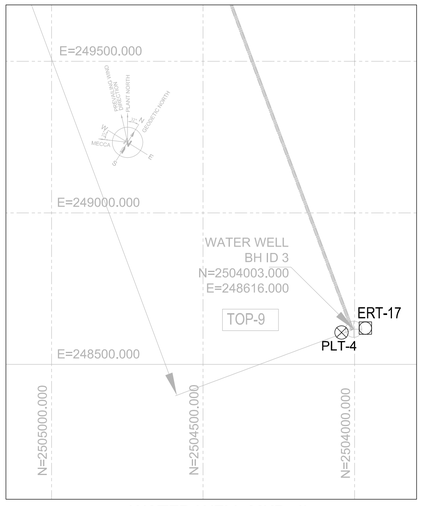

WATER WELL MKD. 3
SCALE - 1:10000

DOCUMENT NUMBER	REFERENCE DOCUMENTS	REV	DATE	REVISION DESCRIPTION	DRN	CHK	ENG	APP	EMP
		D01	11/10/2023	AS BUILT					
		C01	26/06/2020	ISSUED FOR CONSTRUCTION	SYA	SJM	MLI	AG	
		A05	01/06/2020	REVISED AS PER EMPLOYER COMMENTS ON 20/05/2020	SYA	SJM	MLI	AG	
		A04	27/04/2020	REVISED DUE TO LAYOUT CHANGE & AS MARKED	SYA	SJM	MLI	AG	
		A03	28/03/2020	REVISED AS PER EMPLOYER COMMENTS ON 17/09/2019	SYA	SJM	MLI	AG	
		A02	09/08/2019	BOOSTER PUMP STATION LAYOUT UPDATED	SYA	MLI	MLI	SJM	
		A01	08/07/2019	FIRST ISSUE	SYA	MLI	MLI	SJM	

RESERVED FOR VENDOR LOGO AND DRAWING NUMBER

LARSEN & TOUBRO

This drawing is the property of LARSEN & TOUBRO and must not be passed on to any person or body not authorized by us to receive it nor be copied or otherwise made use either in full or in part by such person or body without our prior permission in writing.

Outotec

The content of these documents are the sole property of Outotec Oyj. Any rights not expressly granted herein are reserved. Reproduction, transfer or distribution of part or all of the contents in any form without prior written permission of Outotec is prohibited.

MA'ADEN معادن
Saudi Arabian Mining Company شركة التعدين العربية السعودية

This document and the information contained herein is Ma'aden proprietary know-how. This document or any part thereof should not be reproduced, stored in a retrieval system or transmitted by any means, electronic or otherwise, or divulged without prior written permission of Ma'aden.

DRAWN	SYA	08-07-2019
CHECKED	MLI	08-07-2019
ENGINEER	MLI	08-07-2019
APPROVED	SJM	08-07-2019
EMPLOYER		
SCALE	1:200000,10000,350	A1

LARSEN & TOUBRO DRAWING NUMBER: 019045_001_T_B_24754_002 — REVISION: 6
OUTOTEC DRAWING NUMBER: 900707_GAU01_ZZ01_CLD01_00004 — DOCUMENT ID: OU100656269 — REVISION: 6

MANSOURAH - MASSARAH GOLD PROJECT
SITE PLAN
PLANT LAYOUT AND SOIL TEST LOCATIONS
BOOSTER PUMPING STATION (KP 292) AND WATER WELL 3 & 4

DRAWING NUMBER: MD-216-1000-EG-CV-LAD-1002 — REV: D01