

DRAWING NUMBER MD-216-1000-EG-CV-LAD-1003 REV D01

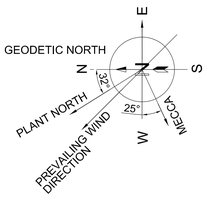

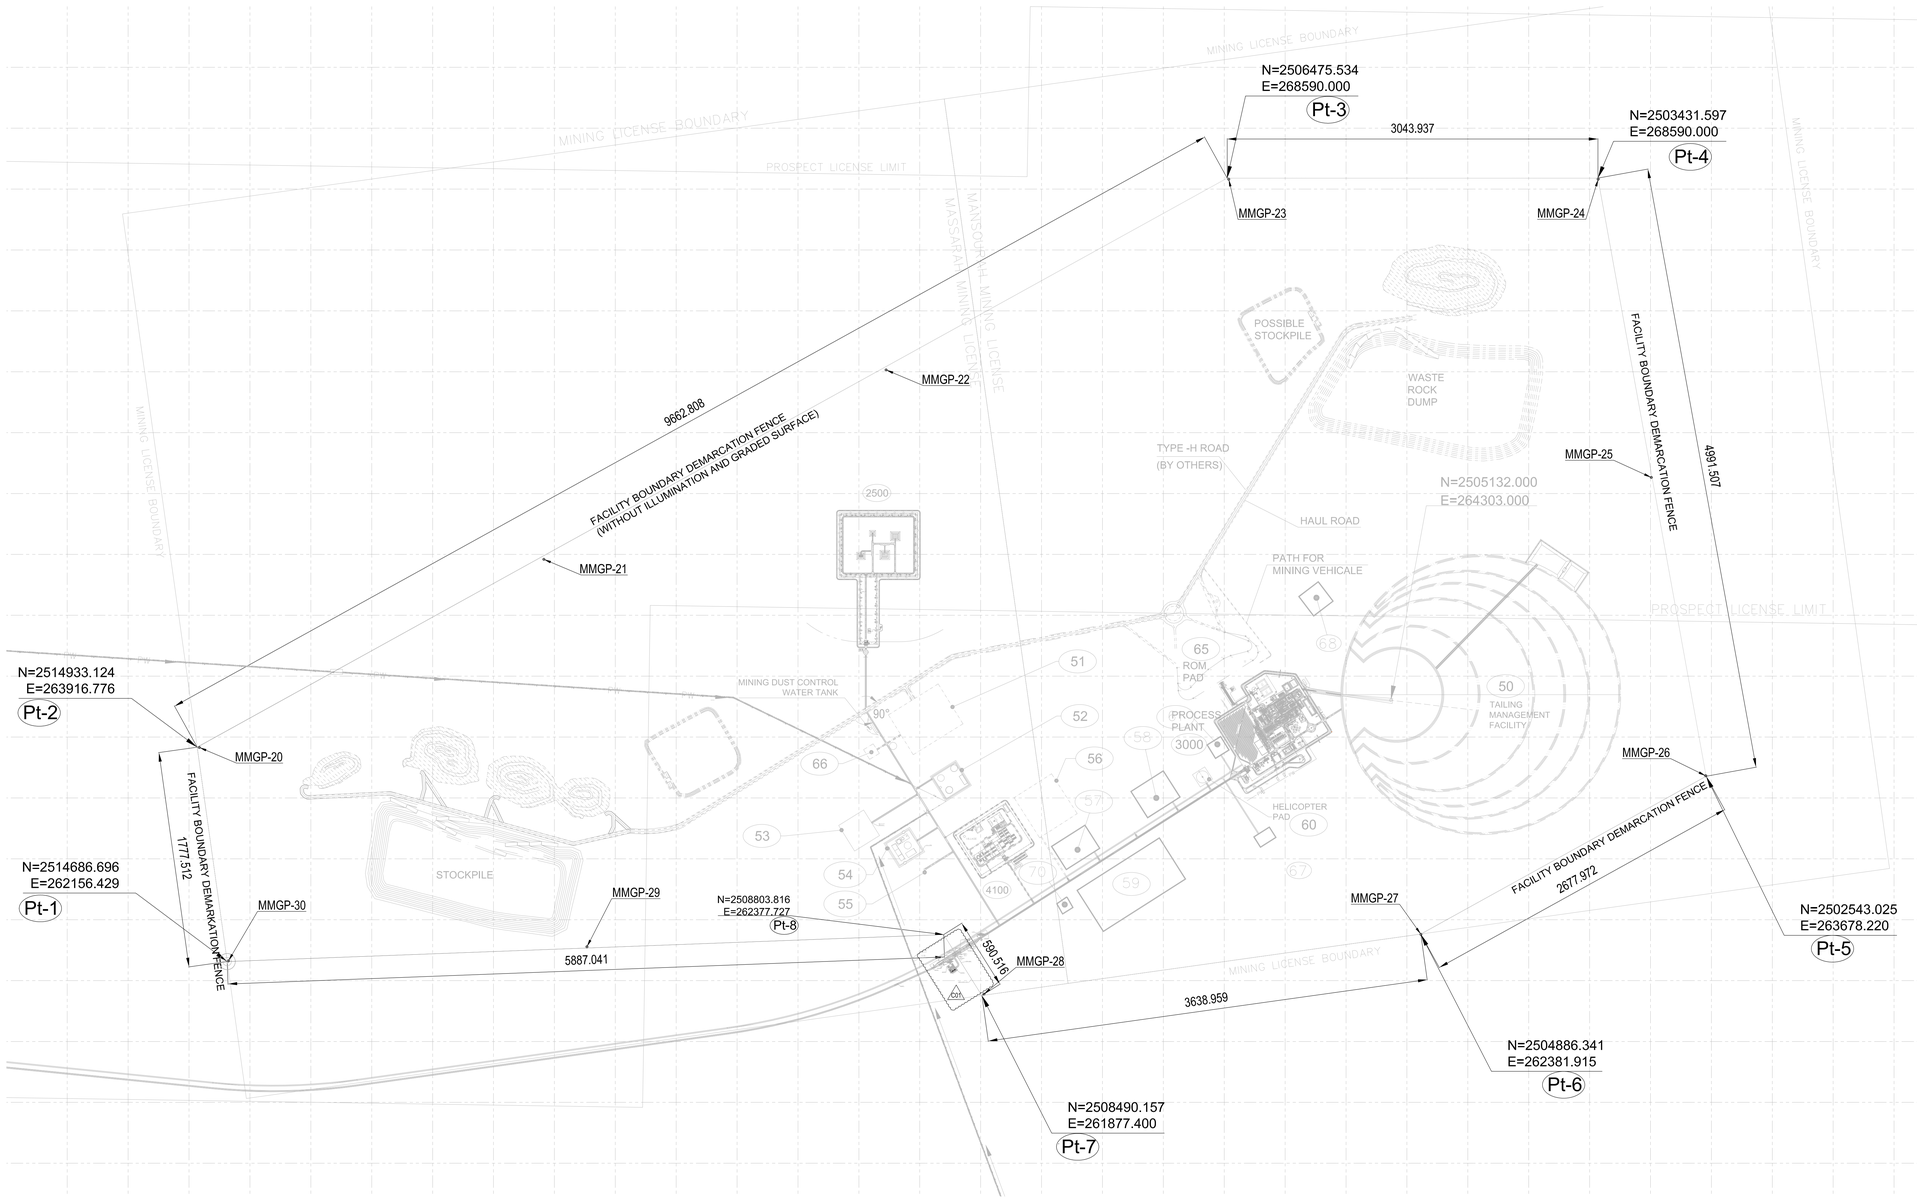

FINAL LOCATIONS OF BENCHMARK SURVEY PILLARS		
POINTS	NORTHING	EASTING
MMGP-20	2514916.079	263914.957
MMGP-21	2512086.713	265459.636
MMGP-22	2509276.247	267015.056
MMGP-23	2506463.227	268581.058
MMGP-24	2503429.406	268581.635
MMGP-25	2502993.595	266132.215
MMGP-26	2502546.981	263682.496
MMGP-27	2504885.339	262379.778
MMGP-28	2508472.887	261888.665
MMGP-29	2511732.752	262278.101
MMGP-30	2514676.449	262162.153

BENCHMARK SURVEY PILLARS LAYOUT PLAN
1:25000

NOTES:~
1. ALL DIMENSIONS ARE IN METRES.
2. CO-ORDINATES ARE IN METRES.
3. CO-ORDINATES ARE ON WORLD GRID (FLAT PLANT / WORLD)
4. WORLD MAPPING GRID BASED ON - UTM (WGS 84) Q 38 N.
5. THIS DRAWING IS TO BE READ IN CONJUNCTION WITH MD-216-1000-EG-CV-LAD-1004.

DOCUMENT NUMBER	REFERENCE DOCUMENTS	REV	DATE	REVISION DESCRIPTION	DRN	CHK	ENG	APP	EMP
		D01	10/10/2023	AS BUILT	SYA	NZH	MLI	SJM	
		C01	12/02/2020	ISSUED FOR CONSTRUCTION & REVISED AS PER EMPLOYER COMMENTS DATED 19/12/2019	SYA	NZH	MLI	SJM	
MD-216-0000-EG-GE-DLO-0002-C02	MINING BOUNDARY LIMITS SITE PLAN	A01	14-11-2019	FIRST ISSUE	SYA	NZH	MLI	SJM	

RESERVED FOR VENDOR LOGO AND DRAWING NUMBER

LARSEN & TOUBRO

This drawing is the property of LARSEN & TOUBRO and must not be passed on to any person or body not authorized by us to receive it nor be copied or otherwise made use either in full or in part by such person or body without our prior permission in writing.

Outotec

The content of these documents are the sole property of Outotec Oyj. Any rights not expressly granted herein are reserved. Reproduction, transfer or distribution of part or all of the contents in any form without prior written permission of Outotec is prohibited.

MA'ADEN معادن
Saudi Arabian Mining Company شركة معادن العربية السعودية

This document and the information contained herein is Ma'aden proprietary know-how. This document or any part thereof should not be reproduced, stored in a retrieval system or transmitted by any means, electronic or otherwise, or divulged without prior written permission of Ma'aden.

LARSEN & TOUBRO DRAWING NUMBER: O19045_900_C_G_24401_002 — REVISION: 2
OUTOTEC DRAWING NUMBER: 900707_GAU01_ZZ01_MTL01_10002 — DOCUMENT ID: OU100665621 — REVISION: 2

DRAWN	SYA	11-11-2019
CHECKED	NZH	12-11-2019
ENGINEER	MLI	13-11-2019
APPROVED	SJM	14-11-2019
EMPLOYER		
SCALE	1:25000,12500,1000, 75	A0

MANSOURAH - MASSARAH GOLD PROJECT
GENERAL ARRANGEMENT DRAWING
LAYOUT SHOWING TENTATIVE LOCATIONS OF BENCHMARK SURVEY PILLARS FOR OVERALL MINING BOUNDARY PERIMETER FENCE AREA

DRAWING NUMBER: MD-216-1000-EG-CV-LAD-1003 — REV: D01

MA'ADEN معادن
Saudi Arabian Mining Company شركة التعدين العربية السعودية

BECHTEL

Mansourah Massarah Gold Project
Comment Resolution Log Sheet / Compliance Report

Outotec

LARSEN & TOUBRO

PROJECT: MANSOURAH MASSARAH GOLD PROJECT — **PROJECT NO.: 216**

STAGE: 4 - PROJECT EXECUTION. — **REVIEW LOG DOC. NO. & REV.:**

ACONEX REF. NO. & DATE: BECHTEL-WTRAN-000736, 19 December 2019

STATUS CODE: A - APPROVED, C - APPROVED WITH COMMENTS, R - REVISE & RESUBMIT & O - OTHERS (INFORMATION, REFERENCE, REVIEWED)

DOCUMENT NUMBER	Area / Title	Comment No.	PMC/PMT COMMENT DATE: 19 December 2019	Comment by	EPC Response DATE: 12 February 2020	Status	Remarks
			General Comments (cc)				
MD-216-1000-EG-CV-LAD-1003-A01	1000	1	Please be aware that these points need still to be agreed	Mr. Doron Golan BECHTEL	The benchmark survey pillars have already been established at site. The location of PIC will not have any impact on the content of this drawing. If required, temporary benchmark shall be established for construction works. However the updated location of PIC is incorporated in the drawing.	Closed	