
DRAWING NUMBER MD-216-1000-EG-CV-LAD-1004

REV D01




LEGENDS	
1	WEIGHBRIDGE
2	NOT USED
3	WAREHOUSE OUTSIDE LAYDOWN
4	NOT USED
5	WORKSHOP
6	LABORATORY
7	ENGINEERING OFFICE
8	CONTROL ROOM
9	NOT USED
25	ACIDIC EVENT POND
26	CYANIDE EVENT POND
27	PASTE THICKENER EVENT POND
37	BUS STOP
38	SECURITY GATE 5
39	MOSQUE
43	ABLUTION
44	ADMIN BUILDING
45	EMERGENCY SERVICES BUILDING
46	NOT USED
47	COMMUNICATION TOWER

PROCESS AREA (3000)
1:2500

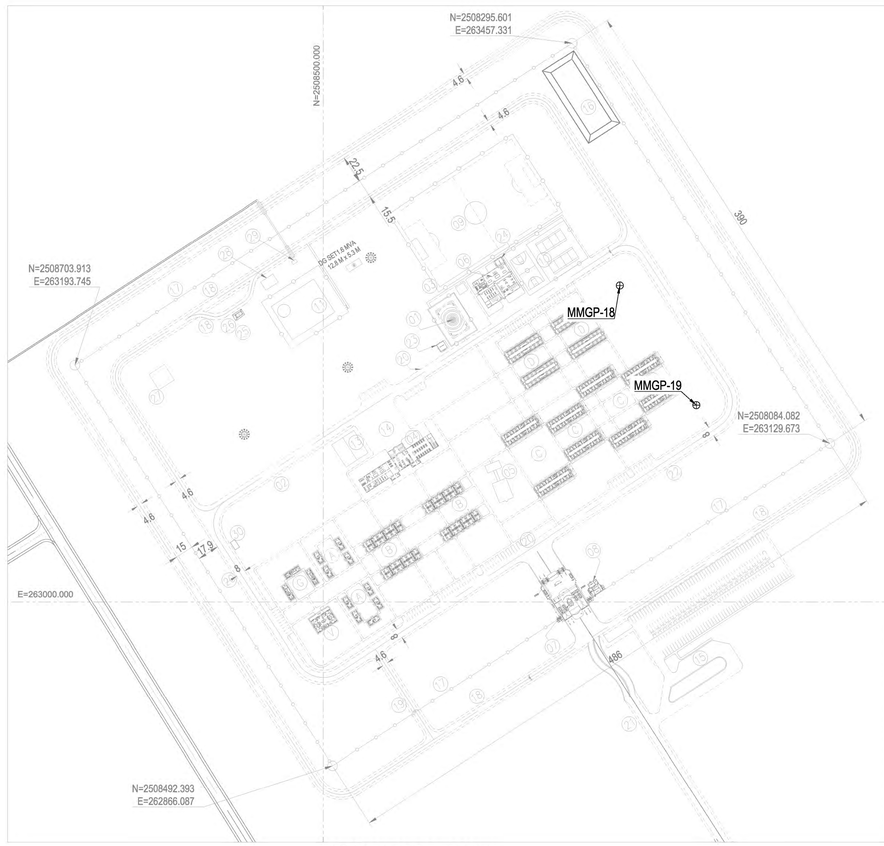

VILLAGE AREA (4100)
1:2500

LEGENDS	
	DESCRIPTION
1	SWIMMING POOL
2	OUTDOOR FESTIVAL AREA
3	PATIO WITH SUNSHADE
4	CENTRAL COMMUNITY CENTER
5	MOSQUE
6	JR. RECREATION BUILDING
7	SECURITY ACCESS CONTROL BUILDING
8	SECURITY PASS AND ID BUILDING
9	SOCCER
10	BASKETBALL AND TENNIS COURTS
11	SUNSHADE– VILLAGE ELECTRICAL EQUIPMENT
12	NOT USED
13	SUNSHADE– WATER SUPPORT AREA
14	LOADING AND PARKING
15	BUS PICK–UP / DROP–OFF
16	STORM WATER COLLECTION TANK
17	CATEGORY 2 – SECURITY FENCE
18	PERIMETER SECURITY LOOP ROAD– TYPE – D
19	AUXILIARY VEHICLE ENTRY GATE– ROAD TYPE – D
20	ACCESS ROAD TYPE –C
21	ENTRANCE ROAD TYPE –C
22	NOT USED
23	EQUIPMENT STORAGE – POOL
24	EQUIPMENT STORAGE – RECREATION
25	LOCAL / SWITCHBOARD DISTRIBUTION
26	DIESEL TANK FOR DG
27	WASTE STORAGE ROOM
28	DG
29	SUBSTATION
30	SEWAGE WATER COLLECTION TANK

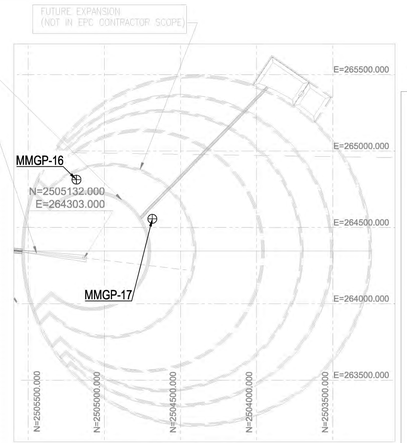

TAILING AREA
1:20000

FINAL LOCATIONS OF BENCHMARK SURVEY PILLARS		
POINTS	NORTHING	EASTING
MMGP-1	2506370.433	263814.116
MMGP-2	2506328.660	263777.125
MMGP-3	2506293.905	263645.280
MMGP-4	2506091.995	263783.805
MMGP-5	2505913.464	263959.005
MMGP-6	2506098.350	263896.609
MMGP-7	2506178.005	264090.979
MMGP-8	2505991.022	264108.952
MMGP-9	2505874.427	264234.319
MMGP-10	2506049.021	264327.432
MMGP-11	2506069.193	264404.449
MMGP-12	2506215.068	264177.913
MMGP-13	2506529.813	264393.023
MMGP-14	2506477.884	264410.159
MMGP-15	2506317.853	263866.778
MMGP-16	2505183.715	264812.806
MMGP-17	2504685.584	264557.204
MMGP-18	2508256.502	263258.866
MMGP-19	2508193.683	263160.995

C02

PROCESS AREA LIST OF UNITS :-

3110	PRIMARY CRUSHING	3690	GOLD ROOM & ELECTROWINNING & CALCINING & SMELTING	49PQ	POWER DISTRIBUTION
3120	SECONDARY CRUSHING	3710	TAILINGS PASTE THICKENING	49PS	SOLAR POWER PLANT
3130	TERTIARY CRUSHING	3720	TAILINGS DISPOSAL/TAILINGS MANAGEMENT FACILITY PIPELINE	49FE	FUEL STORAGE
3210	CRUSHED ORE STORAGE AND TRANSFER	3740	TAILINGS & CIL SECONDARY CYANIDE DESTRUCTION	49FE	FUEL STORAGE(LPG)
3220	GRINDING AND CLASSIFICATION – BALL MILL	3750	TAILINGS & CIL PROCESS WATER STORAGE	49RA	ACCESS ROAD
3230	GRINDING AND CLASSIFICATION – GRAVITY CONCENTRATOR	3810	REAGENTS – CAUSTIC AND CYANIDE	49W1	BOOSTER PUMP STATION & PROCESS WATER SUPPLY
3310	FLOTATION ROUGHER/SCAVENGER/CLEANER	3820	REAGENTS – HYDROCHLORIC ACID/SULPHAMIC ACID	49WF	POTABLE WATER SUPPLY
3320	LOW GRADE THICKENING	3830	REAGENTS – FLOTATION	49BL	LABORATORY
3340	CONCENTRATE THICKENING	3840	REAGENTS – FLOCCULANT	49CD	IT AND COMMUNICATIONS SYSTEM
3350	CONCENTRATE FILTRATION	3850	REAGENTS – LIME SLAKING		
3360	CONCENTRATE STORAGE AND REPULP	3860	REAGENTS – LIMESTONE		
3370	FLOTATION PROCESS WATER STORAGE AND DISTRIBUTION	3890	REAGENTS – SMBS & PEROXIDE		
3380	ACIDULATION	39WL	RAW WATER		
3410	PRESSURE OXIDATION – AUTOCLAVE FEED STORAGE	39LA	FIRE WATER SYSTEM		
3420	PRESSURE OXIDATION – AUTOCLAVE FLASH VESSEL & SCRUBBER	39WQ	GLAND WATER / MINE WATER		
3440	PRESSURE OXIDATION – HOT ACID CURE	39WF	POTABLE WATER STORAGE AND DISTRIBUTION		
3450	PRESSURE OXIDATION – SERVICES	39EJ	DEMINERALISATION SYSTEM		
3510	CCD CIRCUIT & POX CONDITIONING	39AD	LOW PRESSURE AIR		
3520	NEUTRALIZATION AND THICKENING	39AB	PLANT AIR DISTRIBUTION		
3530	CCD & POX – PROCESS WATER COOLING	39AA	INSTRUMENT AIR		
3540	CCD & POX – PROCESS WATER STORAGE	39MA	PIPE RACKS		
3610	POX LEACHING/ADSORPTION	3980	OXYGEN PLANT		
3620	POX INTENSIVE CYANIDE LEACHING	4000	OTHER BUILDINGS		
3640	LOW GRADE CONDITIONING/LEACHING/ADSORPTION	1800	HEALTH & SAFETY & SECURITY AND RISK		
3650	POX ACID WASH/ELUTION/CARBON REGENERATION	49RD	INTERNAL ROADS AND DRAINAGE		
3660	LOW GRADE ACID WASH / ELUTION / CARBON REGEN	4400	TAILINGS MANAGEMENT FACILITY CHANNEL/DRAINAGE/POND		
3670	PRIMARY CYANIDE DESTRUCTION	49EE	WASTE DISPOSAL.		
3680	CONDITIONING & LEACHING & CARBON CIRCUITS ELECTROWN	49PR	POWER GENERATION		

NOTES:
1. ALL DIMENSIONS ARE IN METRES.
2. CO–ORDINATES ARE IN METRES.
3. CO–ORDINATES ARE ON WORLD GRID (FLAT PLANT / WORLD)
4. WORLD MAPPING GRID BASED ON – UTM (WGS 84) Q 38 N.
5. BENCH MARK SURVEY PILLAR MKD. MMGP–10 IS ALREADY CONSTRUCTED. SUITABLE

THIS DOCUMENT SUPERSEDES MA'ADEN DOCUMENT NUMBER MD–216–1000–EG–CV–LAD–0004, REVISION A02, DATED 01.10.2019

DOCUMENT NUMBER	REFERENCE DOCUMENTS	REV	DATE	REVISION DESCRIPTION	DRN	CHK	ENG	APP	EMP
		D01	10.10.2023	AS BUILT	SYA	MLI	MLI	SJM	TION.
		C02	10.03.2020	ISSUED FOR CONSTRUCTION & REVISED AS MARKED C02	SYA	MLI	MLI	SJM	
		C01	16.01.2020	ISSUED FOR CONSTRUCTION	SYA	MLI	MLI	SJM	
		A03	22.10.2019	REVISED AS PER COMMENTS	SYA	MLI	MLI	SJM	
		A02	01.10.2019	REVISED DUE TO CHANGE OF LAYOUT ON 19.09.19 & AS BUILT	SYA	MLI	MLI	SJM	
		02	15.07.2019	REVISED AS PER OUTOTEC COMMENTS	CND	RKM	RKM	NBR	
		01	29.06.2019	REVISED AS PER OUTOTEC COMMENTS	SVM	RKM	RKM	NBR	
		00	26.06.2019	FIRST ISSUE	MNS	AKJ	AKJ	SJM	

RESERVED FOR VENDOR LOGO AND DRAWING NUMBER

LARSEN & TOUBRO DRAWING NUMBER 019045_900_C _G _24401_001 — REVISION 8

OUTOTEC DRAWING NUMBER 900707_GAU01_ZZ01_CLD01_00005 — DOCUMENT ID OU100656797 — REVISION 7

DRAWN	MNS	21.06.2019
CHECKED	AKJ	24.06.2019
ENGINEER	AKJ	25.06.2019
APPROVED	SJM	26.06.2019
EMPLOYER		
SCALE	1:20000,2500	A1

MANSOURAH MASSARAH GOLD PROJECT

PLANT LAYOUT SHOWING TENTATIVE LOCATIONS OF BENCHMARK SURVEY PILLARS

DRAWING NUMBER MD-216-1000-EG-CV-LAD-1004 — REV D01

LARSEN & TOUBRO

This drawing is the property of LARSEN & TOUBRO and must not be passed on to any person or body not authorized by us to receive it nor be copied or otherwise made use either in full or in part by such person or body without our prior permission in writing.

Outotec

The content of these documents are the sole property of Outotec Oyj. Any rights not expressly granted herein are reserved. Reproduction, transfer or distribution of part or all of the contents in any form without prior written permission of Outotec is prohibited.

MA'ADEN معادن Saudi Arabian Mining Company شركة التعدين العربية السعودية

This document and the information contained herein is Ma'aden proprietary know-how. This document or any part thereof should not be reproduced, stored in a retrieval system or transmitted by any means, electronic or otherwise, or divulged without prior written permission of Ma'aden.