
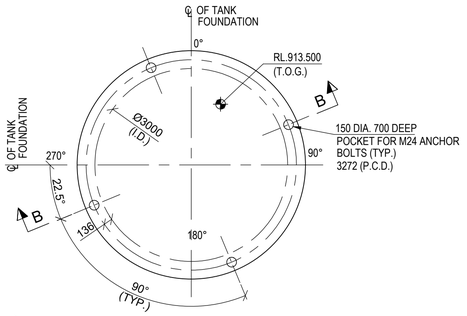



DETAIL OF FOUNDATION MKD. 3310-REA-002

SCALE 1:50

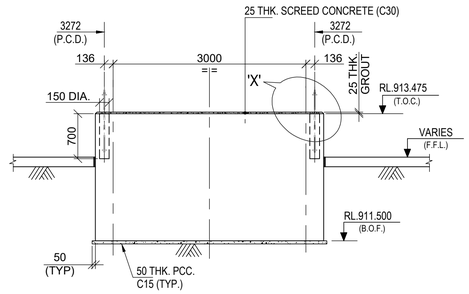


SECTION : B-B

SCALE 1:50

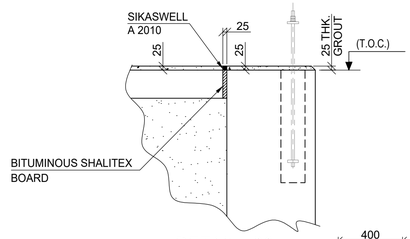

DETAIL - 'X'


SCALE 1:20

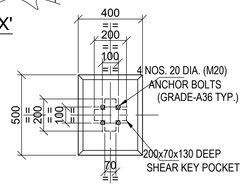



VIEW : 1-1

(DETAIL OF C1,C7)

SCALE 1:20

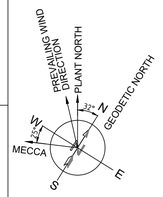


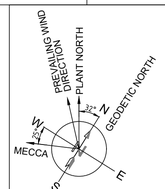

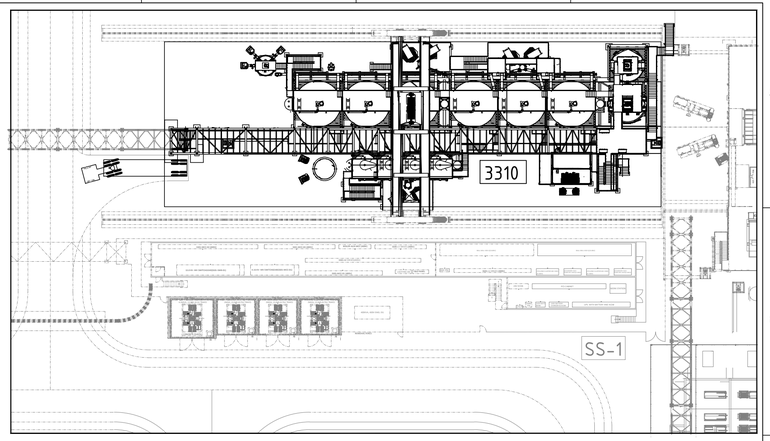


KEY PLAN

SCALE 1:500

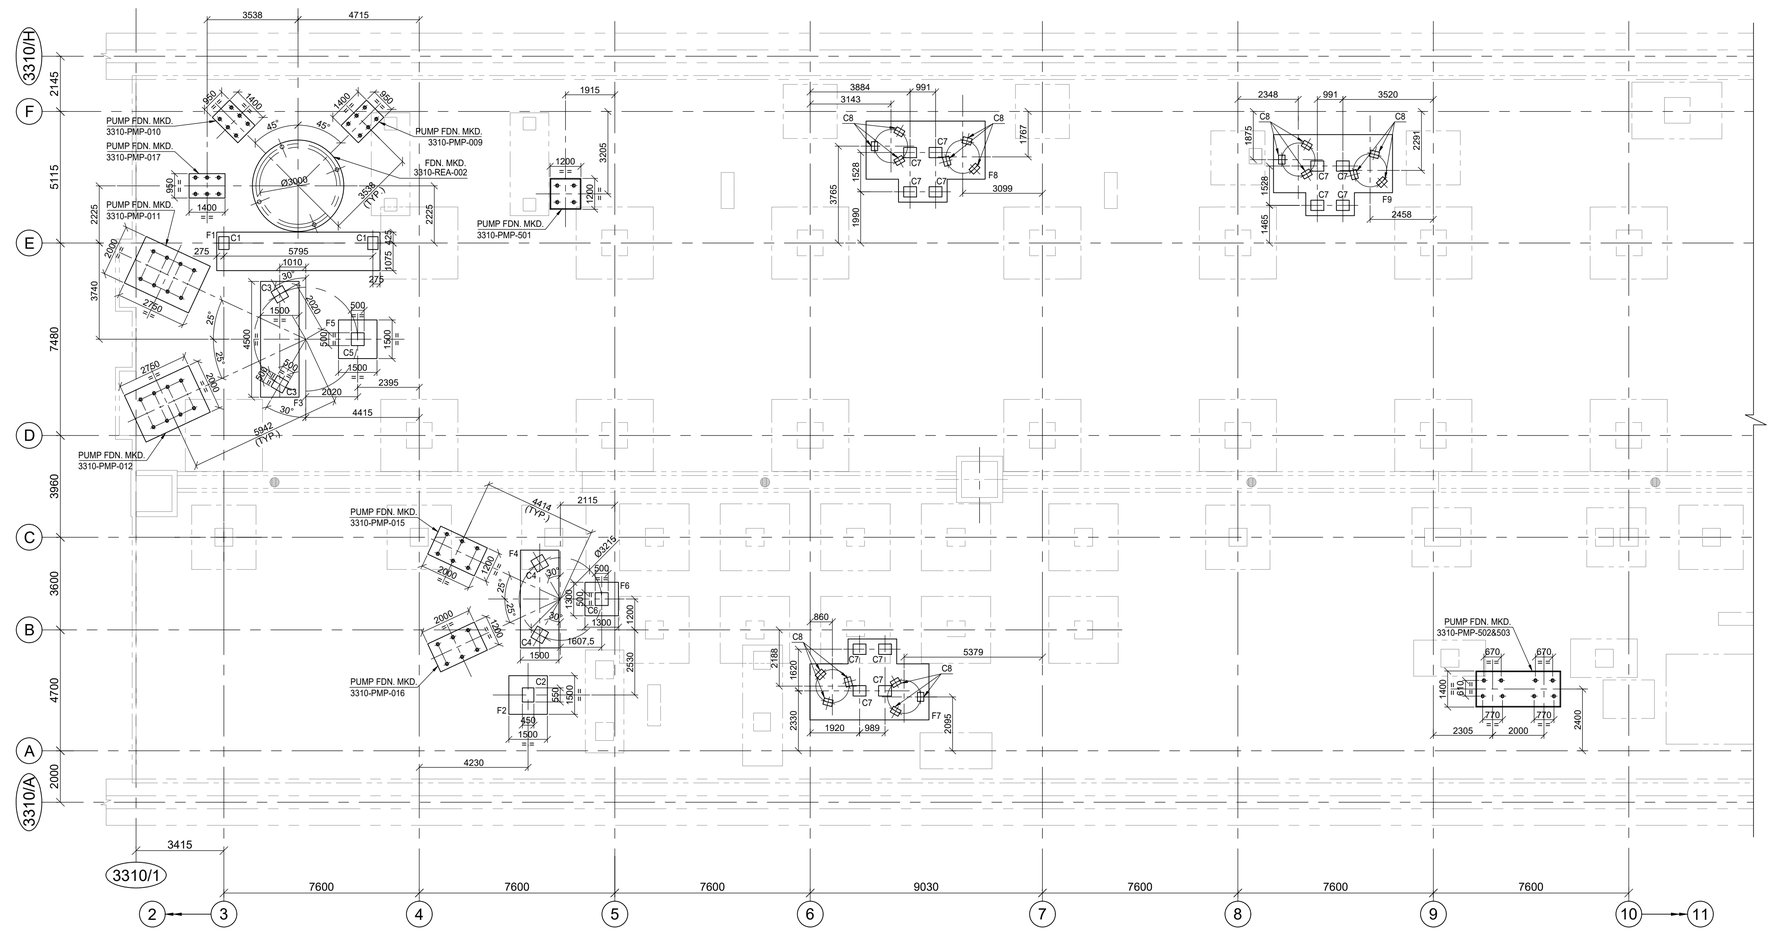


LAYOUT OF MISCELLANEOUS FOUNDATION

SCALE 1:125

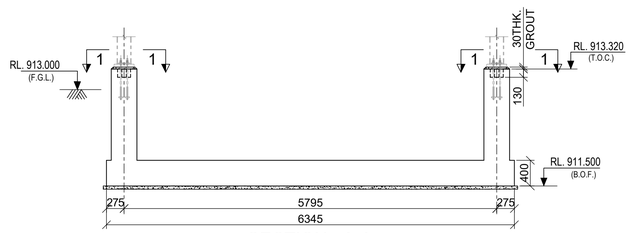


SECTION : A-A

SCALE 1:50

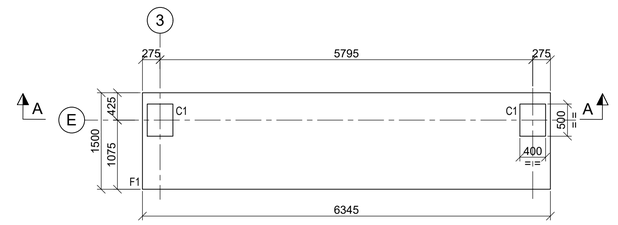


DET. OF FOUNDATION MKD. F1

SCALE 1:50

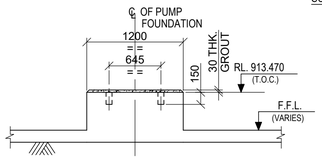

SECTION : C-C

SCALE 1:40

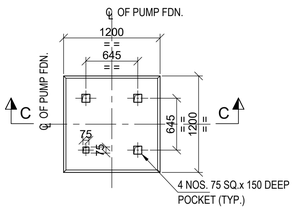

FDN. FOR PUMP MKD. 3310-PMP-501

SCALE 1:40

LEGEND :-

R.L. - REDUCED LEVEL
℄ - CENTRE LINE
T.O.C. - TOP OF CONCRETE
TYP. - TYPICAL
F.G.L. - FINISHED GROUND LEVEL
F.F.L. - FINISHED FLOOR LEVEL
B.O.F. - BOTTOM OF FOUNDATION
MKD. - MARKED
P.C.C - PLAIN CEMENT CONCRETE
P.C.D. - PITCH CIRCLE DIAMETER
DIA. - EXPANSION JOINT
DET. - DETAIL
SQ. - SQUARE
FDN. - FOUNDATION
THK. - THICK
DIA. - DIAMETER

NOTES:-

1. ALL DIMENSIONS ARE IN MILLIMETRES AND LEVELS AND CO-ORDINATES ARE IN METRES UNLESS OTHERWISE STATED.
2. NET SAFE BEARING CAPACITY OF SOIL AT BOTTOM OF FOUNDATION CONSIDER 450KN/ SQ. M
3. GRADE OF CONCRETE SHALL BE C35 (35MPa) FOR FOUNDATION & C15 (15MPa) FOR BLINDING CONCRETE.
4. GRADE OF REINFORCEMENT SHALL BE DEFORMED BAR 420 MPa (GRADE 60) - ASTM A615/A615M.
5. IF ANY PART OF FOUNDATION COMES ON BACKFILL ZONE OF ADJACENT FOUNDATION OR ANY LOOSE SOIL ARE ENCOUNTERED BELOW FOUNDATION LEVEL THE SAME SHALL BE REMOVED AND FILLED WITH PCC (C15).
6. THIS DRAWING SHOULD BE READ IN CONJUNCTION WITH DRAWING NO. MD-216-3310-EG-CV-GAD-1186. MD-216-3310-EG-CV-DED-1194.

DOCUMENT NUMBER	REFERENCE DOCUMENTS	REV	DATE	REVISION DESCRIPTION	DRN	CHK	ENG	APP	EMP
MD-216-3310-EG-CV-GAD-1173	LAYOUT & DETAIL OF FOUNDATION								
MD-216-3310-EG-CV-GAD-1186	DETAILS OF MISCELLANEOUS FOUNDATION								
MD-216-1000-EG-ST-CRT-1001	CIVIL, STRUCTURAL & ARCHITECTURAL-DESIGN CRITERIA	D01	22/02/2023	AS-BUILT	ABS	SJM	AVG	AG	
MD-216-3310-EG-ME-GAD-1055	PLAN AT EL. +913.000	C01	17/10/2020	ISSUED FOR CONSTRUCTION	ABS	SJM	AVG	AG	
MD-216-3310-EG-CV-GAD-1177	LAYOUT & DETAIL OF GRADE SLAB	A01	30/09/2020	ISSUED FOR REFERENCE	ABS	SJM	AVG	AG	

RESERVED FOR VENDOR LOGO AND DRAWING NUMBER

LARSEN & TOUBRO
This drawing is the property of LARSEN & TOUBRO and must not be passed on to any person or body not authorized by us to receive it nor be copied or otherwise made use either in full or in part by such person or body without our prior permission in writing.

Outotec
The content of these documents are the sole property of Outotec Oyj. Any rights not expressly granted herein are reserved. Reproduction, transfer or distribution of part or all of the contents in any form without prior written permission of Outotec is prohibited.

MA'ADEN معادن
Saudi Arabian Mining Company شركة معادن العربية السعودية
This document and the information contained herein is Ma'aden proprietary know-how. This document or any part thereof should not be reproduced, stored in a retrieval system or transmitted by any means, electronic or otherwise, or divulged without prior written permission of Ma'aden.

LARSEN & TOUBRO DRAWING NUMBER	019045_450_C_G_24390_001		REVISION 2
OUTOTEC DRAWING NUMBER	900707__GAU01__ZF01__MTL01__33198	DOCUMENT ID OU100696606	REVISION 2

DRAWN	ABS	07/09/2020
CHECKED	SJM	11/09/2020
ENGINEER	AVG	08/09/2020
APPROVED	AG	30/09/2020
EMPLOYER		
SCALE	1:20, 1:50, 1:150	A1

MANSOURAH - MASSARAH GOLD PROJECT
GENERAL ARRANGEMENT DRAWING
ROUGHER AND SCAVENGER FLOTATION
LAYOUT & DETAIL OF MISCELLANEOUS FOUNDATION

DRAWING NUMBER MD-216-3310-EG-CV-GAD-1185 REV D01