MA'ADEN معادن

Saudi Arabian Mining Company شركة التعدين العربية السعودية

Project **Mansourah Massarah Gold Project**

Customer: **MA'ADEN GOLD AND BASE METALS (MA'ADEN)**

Title: **DETAIL DRAWING**
LOW GRADE THICKENING
DETAILS OF GRADE SLAB

Document Number: **MD-216-3320-EG-CV-DED-1204**

Revision: **D01**

Revision Date: **22.02.2023**


Status: **ASBUILT**

Outotec Document Number:	900707	GAU01	ST02	CTB13	33210	OU100665545	3
L&T Document Number:	O19045	450	C	D	24087	002	3


REVISION HISTORY

Rev	Date	Revision Text	Prepared By	Reviewed By	Approved By	Employer
A01	19.03.2020	FIRST ISSUE	SYA	SJM	AG	
C01	29.04.2020	ISSUED FOR CONSTRUCTION AND REVISED AS MARKED C01	SYA	SJM	AG	
C02	31.10.2020	ISSUED FOR CONSTRUCTION AND REVISED AS MARKED C02	SYA	SJM	AG	
D01	22.02.2023	ASBUILT	SYA	SJM	AG	


DRAWING NUMBER: MD-216-3320-EG-CV-DED-1204 | REV: D01

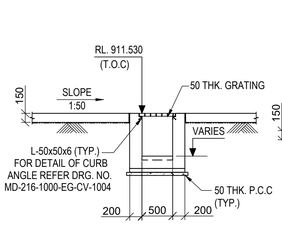


SECTION A-A
SCALE 1:50

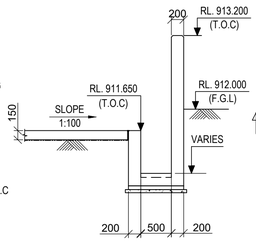


SECTION B-B
SCALE 1:50

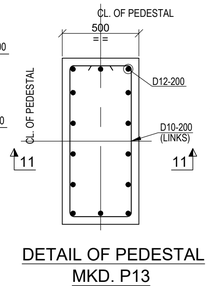


DETAIL OF PEDESTAL
MKD. P13
(SCALE - 1:20)

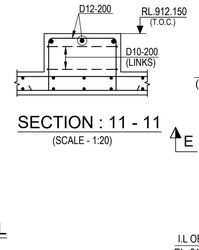


SECTION : 11 - 11
(SCALE - 1:20)

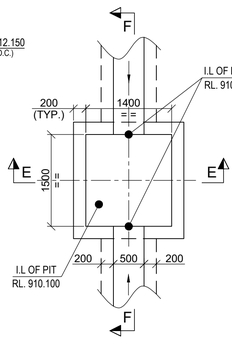


DETAIL-D1
DETAIL-D2 (OPP. HAND)
SCALE 1:50

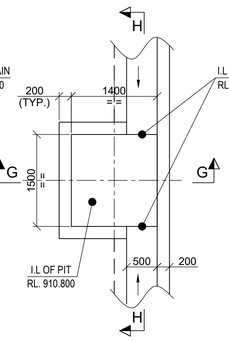


DETAIL-D3
DETAIL-D4 (OPP. HAND)
SCALE 1:50

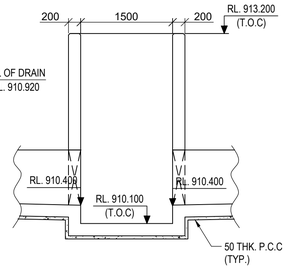


SECTION F-F
SCALE 1:50

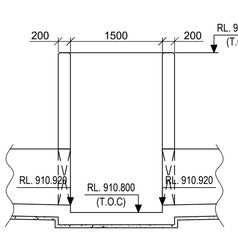


SECTION H-H
SCALE 1:50

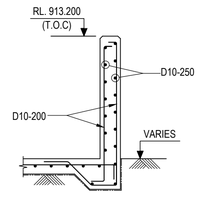


SECTION C-C
SECTION C'-C' (OPP. HAND)
(R.C DETAIL)
SCALE 1:30

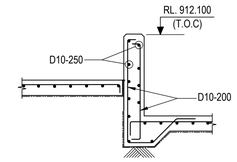


SECTION D-D
(R.C DETAIL)
SCALE 1:30

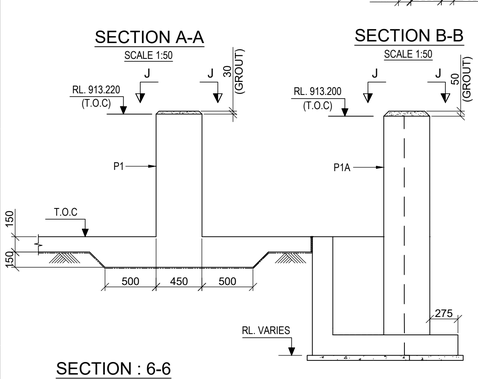


SECTION : 6-6
SCALE 1:30

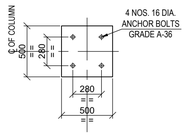


VIEW J-J
SCALE 1:30

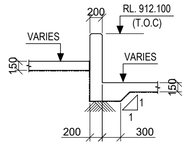


SECTION D-D
SCALE 1:50

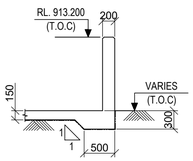


SECTION C-C
SECTION C'-C' (OPP. HAND)
SCALE 1:50

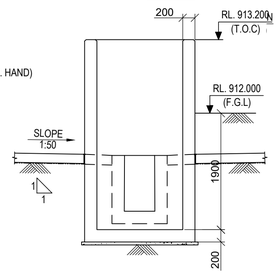


SECTION E-E
SCALE 1:50

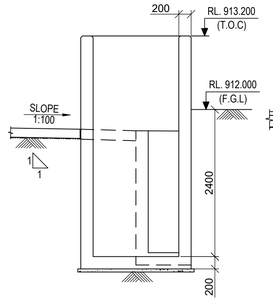


SECTION G-G
SCALE 1:50

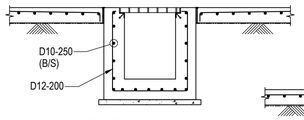


SECTION A-A
(R.C DETAIL)
SCALE 1:30

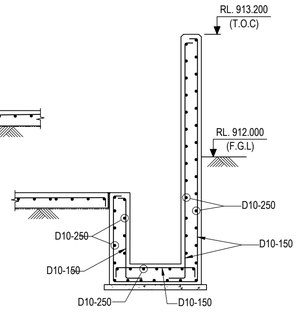


SECTION B-B
(R.C DETAIL)
SCALE 1:30

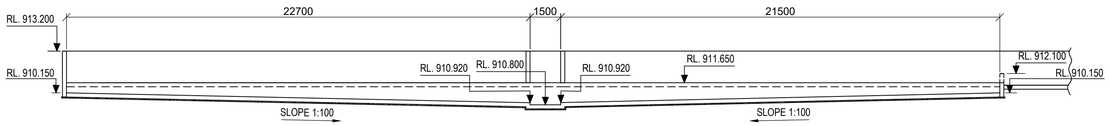


SECTION 4-4
SCALE 1:150

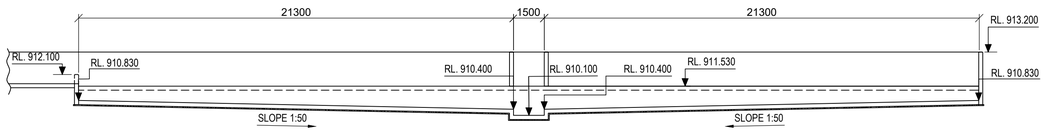


SECTION 3-3
SCALE 1:150

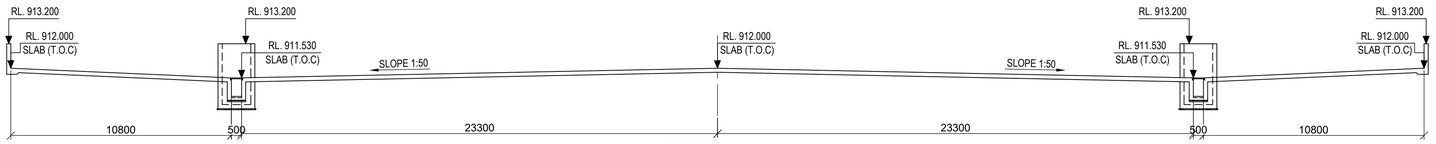


SECTION 1-1
SCALE 1:150

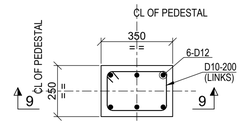


DETAIL OF PEDESTAL MKD. P9
(SCALE - 1:15)

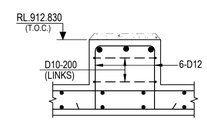


SECTION : 9 - 9
(SCALE - 1:15)

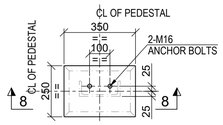


DETAIL OF PEDESTAL MKD. P14
(SCALE - 1:15)

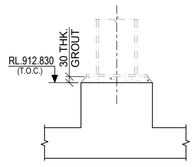


SECTION : 8 - 8
(SCALE - 1:15)

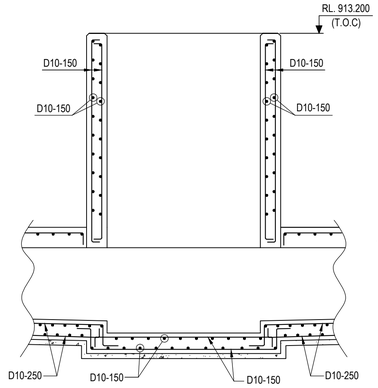


SECTION F-F & H-H
(R.C DETAIL)
SCALE 1:30

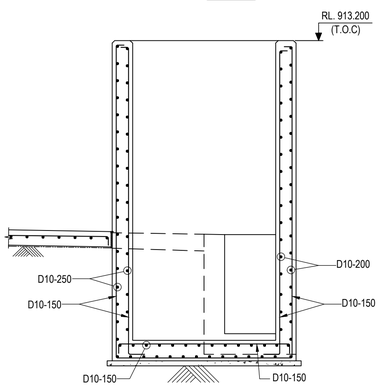

SECTION E-E
(R.C DETAIL)
SCALE 1:30

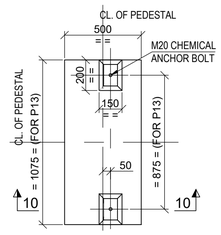

DETAIL OF PEDESTAL
MKD. P13
(PEDESTAL ORIENTATION TREATED AS PER LAYOUT PLAN)
(SCALE - 1:20)

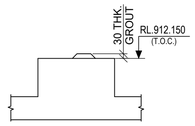

SECTION : U - U
(SCALE - 1:20)

C02

LEGEND :-

CJ - CONSTRUCTION JOINT
F.G.L - FINISHED GROUND LEVEL
R.L. - REDUCED LEVEL
I.L - INVERT LEVEL
THK. - THICK
T.O.C - TOP OF CONCRETE
CL - CENTRE LINE
MKD. - MARKED
DRG. - DRAWING

NOTES:-

1. ALL DIMENSIONS ARE IN MILLIMETRES AND LEVELS AND CO-ORDINATES ARE IN METRES UNLESS OTHERWISE STATED.
2. FOR DETAILS OF GRADE SLAB REFER DRG. NO. MD-216-1000-EG-CV-DED-1002.

(SHEET 1 OF 2)

DOCUMENT NUMBER	REFERENCE DOCUMENTS	REV	DATE	REVISION DESCRIPTION	DRN	CHK	ENG	APP	EMP
		D01	22/02/2023	AS-BUILT	SYA	SJM	AVG	AG	
		C02	31/10/2020	ISSUED FOR CONSTRUCTION AND REVISED AS MARKED	SYA	SJM	AVG	AG	
MD-216-3320-EG-CV-GAD-1198	LOW GRADE THICKENING LAYOUT OF GRADE SLAB	C01	29/04/2020	ISSUED FOR CONSTRUCTION AND REVISED AS MARKED	SYA	SJM	AVG	AG	
MD-216-3320-EG-CV-GAD-1197	LOW GRADE THICKENING LAYOUT OF GRADE SLAB	A01	19/03/2020	ISSUED FOR REFERENCE	SYA	SJM	AVG	AG	

RESERVED FOR VENDOR LOGO AND DRAWING NUMBER

LARSEN & TOUBRO

This drawing is the property of LARSEN & TOUBRO and must not be passed on to any person or body not authorized by us to receive it nor be copied or otherwise made use either in full or in part by such person or body without our prior permission in writing.

Outotec

The content of these documents are the sole property of Outotec Oyj. Any rights not expressly granted herein are reserved. Reproduction, transfer or distribution of part or all of the contents in any form without prior written permission of Outotec is prohibited.

MA'ADEN معادن
Saudi Arabian Mining Company شركة المعادن العربية السعودية

This document and the information contained herein is Ma'aden proprietary know-how. This document or any part thereof should not be reproduced, stored in a retrieval system or transmitted by any means, electronic or otherwise, or divulged without prior written permission of Ma'aden.


LARSEN & TOUBRO DRAWING NUMBER: 019045_450_C_D_24087_002 | REVISION: 3
OUTOTEC DRAWING NUMBER: 900707__GAU01__ST02__CTB13__33210 | DOCUMENT ID: OU100665545 | REVISION: 3

DRAWN	SYA	17/03/2020
CHECKED	SJM	18/03/2020
ENGINEER	AVG	17/03/2020
APPROVED	AG	19/03/2020
EMPLOYER		
SCALE	1:150, 50	A1


MANSOURAH - MASSARAH GOLD PROJECT
DETAIL DRAWING
LOW GRADE THICKENING
DETAILS OF GRADE SLAB

DRAWING NUMBER: MD-216-3320-EG-CV-DED-1204 | REV: D01


DRAWING NUMBER MD-216-3320-EG-CV-DED-1204 REV D01

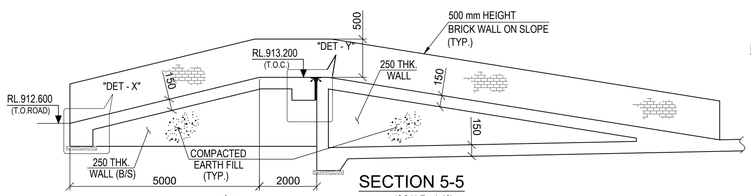


SECTION 5-5
(SCALE - 1:40)

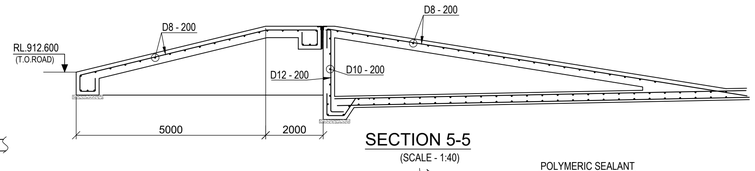


SECTION 5-5
(SCALE - 1:40)

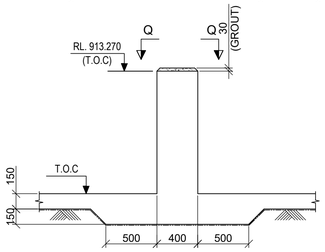


DETAIL - P4
SCALE 1:30

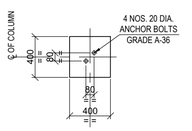


VIEW Q-Q
SCALE 1:30

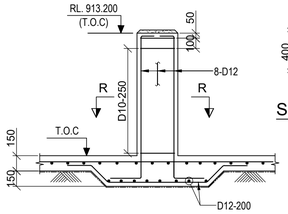


DETAIL - P4
(R.C DETAIL)
SCALE 1:30

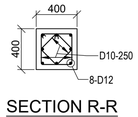


SECTION R-R
SCALE 1:30

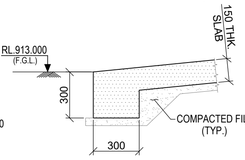


DETAIL - X
(SCALE 1:20)

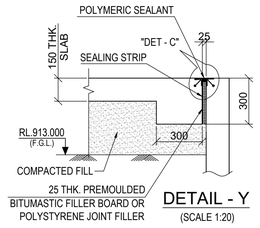


DETAIL - Y
(SCALE 1:20)

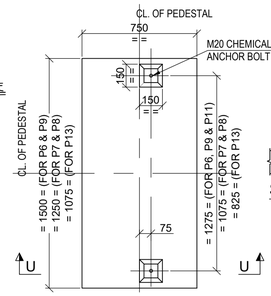

DETAIL OF PEDESTAL
MKD. P6, P7, P8, P9, P11 &P13
(PEDESTAL ORIENTATION TREATED AS PER LAYOUT PLAN)
(SCALE - 1:20)

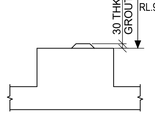


SECTION : U - U
(SCALE - 1:20)

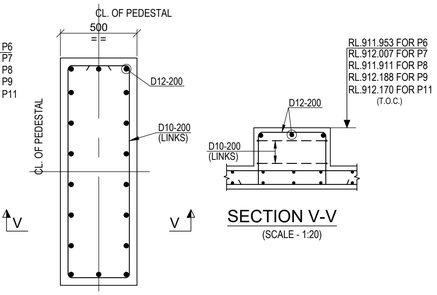


DETAIL OF PEDESTAL
MKD. P6, P7, P8, P9, P11 &P13
(SCALE - 1:20)


SECTION V-V
(SCALE - 1:20)

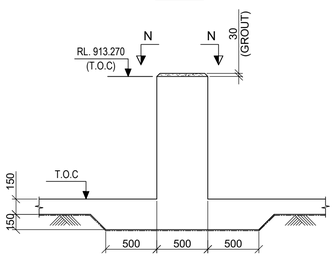


DETAIL - P3
SCALE 1:30

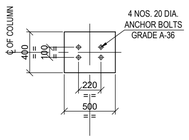


VIEW N-N
SCALE 1:30

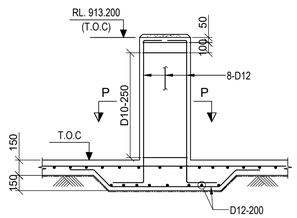


DETAIL - P3
(R.C DETAIL)
SCALE 1:30

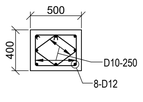


SECTION P-P
SCALE 1:30

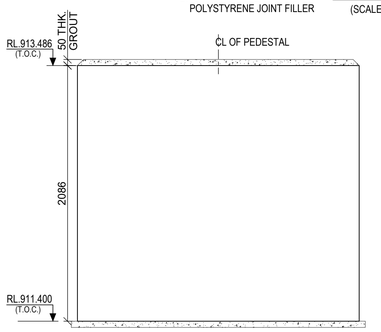


SECTION W-W
(SCALE - 1:25)

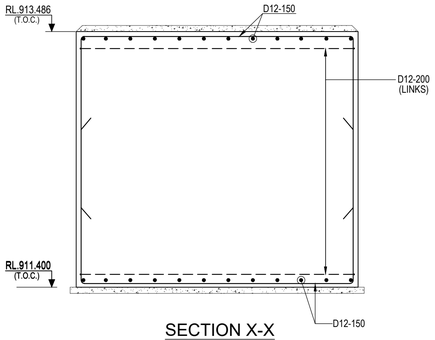


SECTION X-X
(SCALE - 1:25)

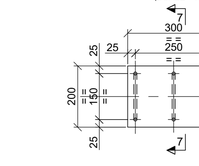


DETAIL OF INSERT PLATE - IP1
(SCALE 1:10)

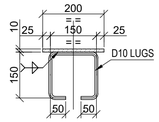


SECTION 7-7
(SCALE 1:10)

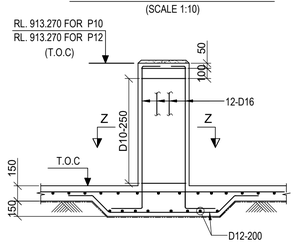


DETAIL - P10
(R.C DETAIL)
SCALE 1:30

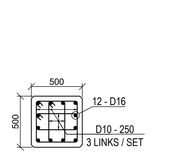


SECTION : Z-Z
SCALE 1:25

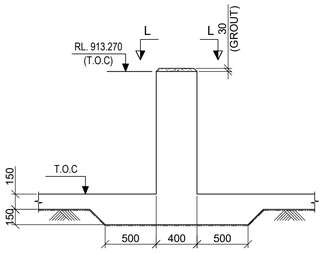


DETAIL - P2
SCALE 1:30

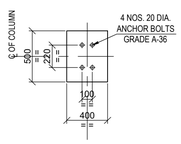


VIEW L-L
SCALE 1:30

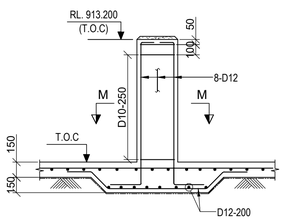


DETAIL - P2
(R.C DETAIL)
SCALE 1:30

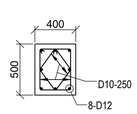


SECTION M-M
SCALE 1:30

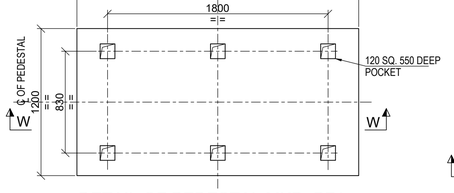

DETAIL OF PEDESTAL MKD. PF1
(FOR PUMP MKD. 3370-PMP-001 & 002)
(SCALE - 1:25)

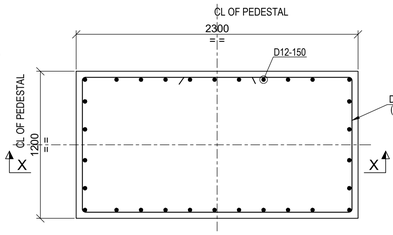


DETAIL OF PEDESTAL MKD. PF1
(SCALE - 1:25)

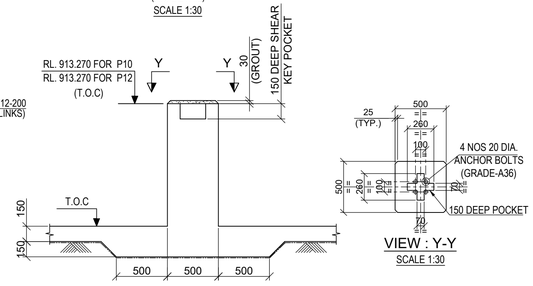


DETAIL - P10
SCALE 1:30


VIEW : Y-Y
SCALE 1:30

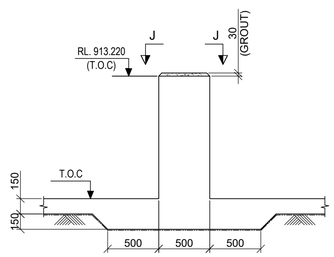


DETAIL - P1
SCALE 1:30

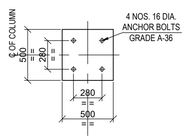


VIEW J-J
SCALE 1:30

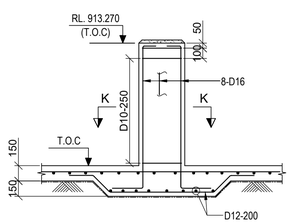


DETAIL - P1
(R.C DETAIL)
SCALE 1:30

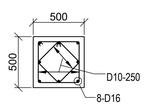


SECTION K-K
SCALE 1:30

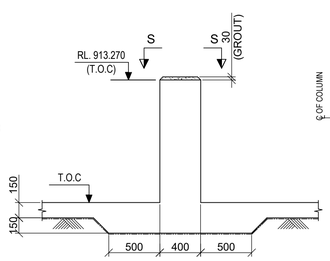


DETAIL - P5
SCALE 1:30

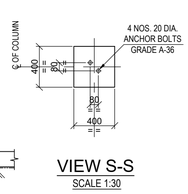

VIEW S-S
SCALE 1:30

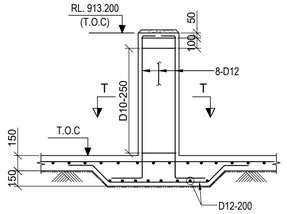

DETAIL - P5
(R.C DETAIL)
SCALE 1:30

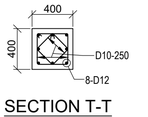

SECTION T-T
SCALE 1:30

LEGEND :-

CJ - CONSTRUCTION JOINT
F.G.L - FINISHED GROUND LEVEL
R.L. - REDUCED LEVEL
I.L - INVERT LEVEL
THK. - THICKNESS
T.O.C - TOP OF CONCRETE
CL - CENTRE LINE
MKD. - MARKED
DIA. - DIAMETER
DRG. - DRAWING

NOTES:-

1. ALL DIMENSIONS ARE IN MILLIMETRES AND LEVELS AND CO-ORDINATES ARE IN METRES UNLESS OTHERWISE STATED.
2. FOR DETAILS OF GRADE SLAB REFER DRG. NO. MD-216-1000-EG-CV-DED-1002.

(SHEET 2 OF 2)

DOCUMENT NUMBER	REFERENCE DOCUMENTS	REV	DATE	REVISION DESCRIPTION	DRN	CHK	ENG	APP	EMP
		D01	22/02/2023	AS-BUILT	SYA	SJM	AVG	AG	
		C02	31/10/2020	ISSUED FOR CONSTRUCTION AND REVISED AS MARKED	SYA	SJM	AVG	AG	
MD-216-3320-EG-CV-GAD-1198	LOW GRADE THICKENING LAYOUT OF GRADE SLAB	C01	29/04/2020	ISSUED FOR CONSTRUCTION AND REVISED AS MARKED	SYA	SJM	AVG	AG	
MD-216-3320-EG-CV-GAD-1197	LOW GRADE THICKENING LAYOUT OF GRADE SLAB	A01	19/03/2020	ISSUED FOR REFERENCE	SYA	SJM	AVG	AG	

RESERVED FOR VENDOR LOGO AND DRAWING NUMBER

LARSEN & TOUBRO
This drawing is the property of LARSEN & TOUBRO and must not be passed on to any person or body not authorized by us to receive it nor be copied or otherwise made use either in full or in part by such person or body without our prior permission in writing.

Outotec
The content of these documents are the sole property of Outotec Oyj. Any rights not expressly granted herein are reserved. Reproduction, transfer or distribution of part or all of the contents in any form without prior written permission of Outotec is prohibited.

MA'ADEN معادن
Saudi Arabian Mining Company شركة التعدين العربية السعودية
This document and the information contained herein is Ma'aden proprietary know-how. This document or any part thereof should not be reproduced, stored in a retrieval system or transmitted by any means, electronic or otherwise, or divulged without prior written permission of Ma'aden.

LARSEN & TOUBRO DRAWING NUMBER	O19045_450_C_D_24087_002	REVISION 3
OUTOTEC DRAWING NUMBER	900707__GAU01__ST02__CTB13__33210	DOCUMENT ID OU100665545 / REVISION 3

DRAWN	SYA	17/03/2020
CHECKED	SJM	18/03/2020
ENGINEER	AVG	17/03/2020
APPROVED	AG	19/03/2020
EMPLOYER		
SCALE	1:150, 50	A1

MANSOURAH - MASSARAH GOLD PROJECT
DETAIL DRAWING
LOW GRADE THICKENING
DETAILS OF GRADE SLAB

DRAWING NUMBER MD-216-3320-EG-CV-DED-1204 REV D01