


DRAWING NUMBER: MD-216-3320-EG-CV-DED-1205 | REV: D01

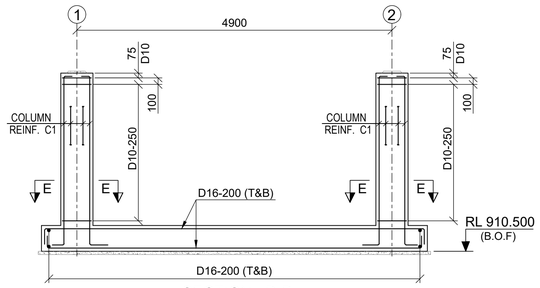


SECTION : D-D
(SCALE 1:50)

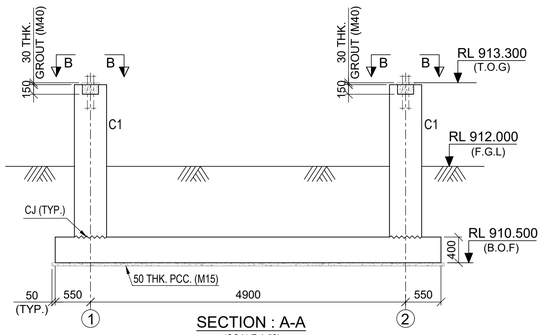


SECTION : A-A
(SCALE 1:50)

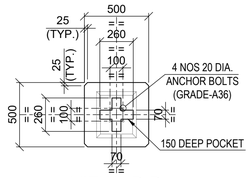


VIEW : B-B
(SCALE 1:25)

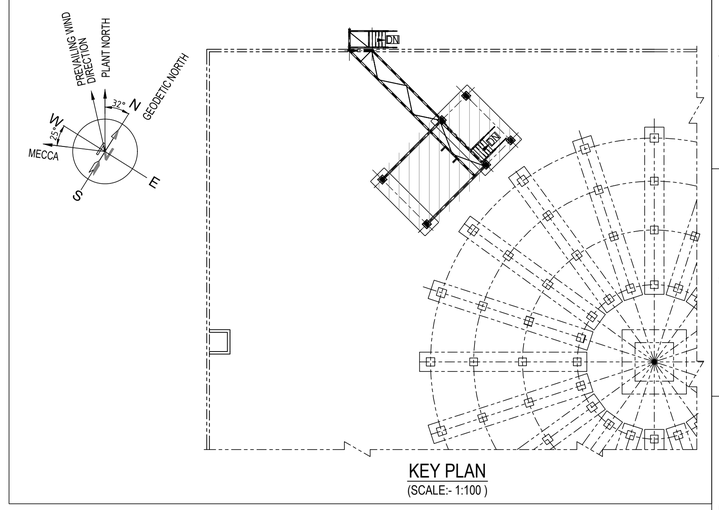


KEY PLAN
(SCALE:- 1:100)

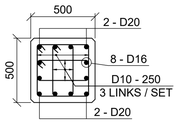


SECTION : E-E
(SCALE 1:25)

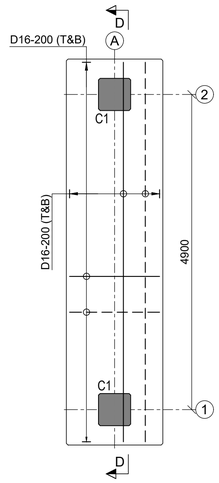


REINF. DETAIL OF FOUNDATION MKD. F1
(SCALE 1:50)

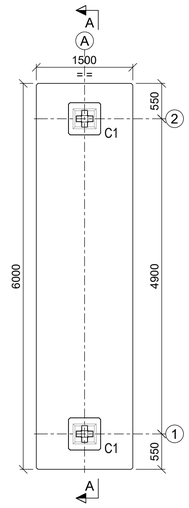


PLAN OF FOUNDATION MKD. F1
(SCALE 1:50)

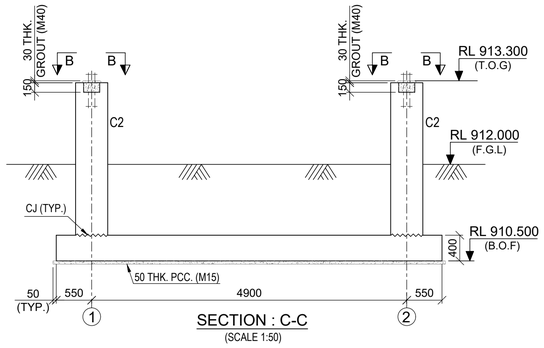


SECTION : C-C
(SCALE 1:50)

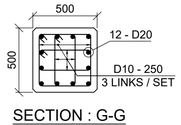


SECTION : G-G
(SCALE 1:25)

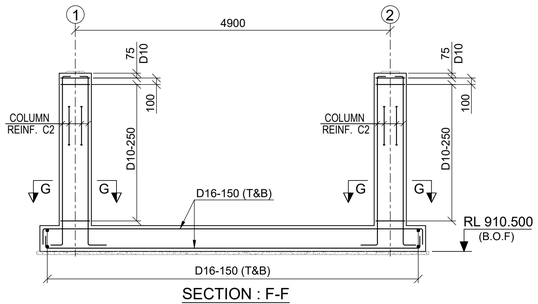


SECTION : F-F
(SCALE 1:50)

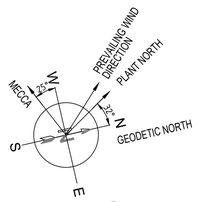


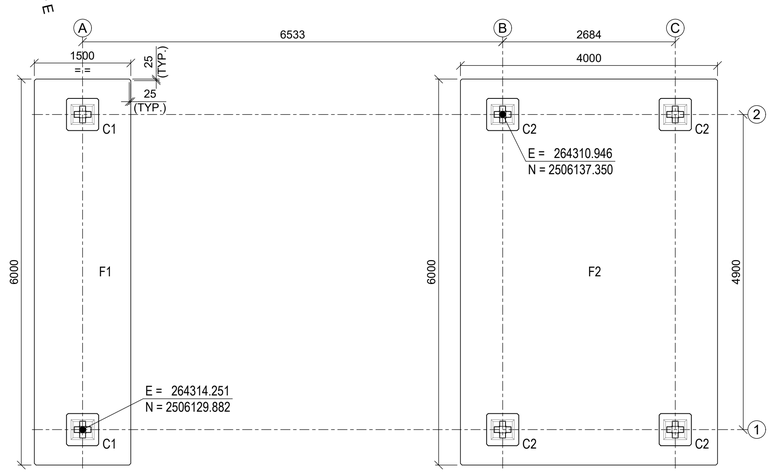

LAYOUT OF FOUNDATION
(SCALE 1:50)

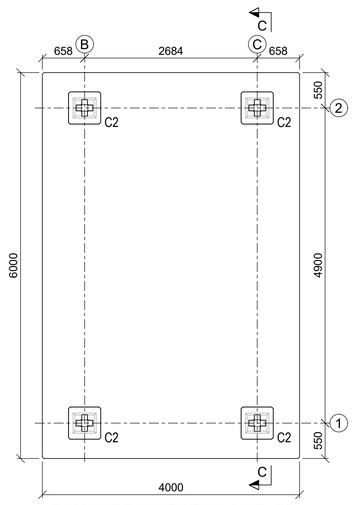

PLAN OF FOUNDATION MKD. F2
(SCALE 1:50)

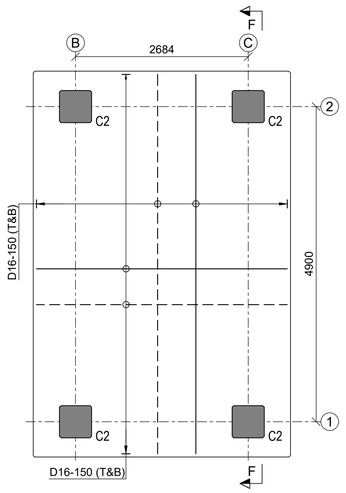

REINF. DETAIL OF FOUNDATION MKD. F2
(SCALE 1:50)

LEGEND :-

R.L. - REDUCED LEVEL
℄ - CENTRE LINE
T.O.C. - TOP OF CONCRETE
F.G.L. - FINISHED GROUND LEVEL
B.O.F. - BOTTOM OF FOUNDATION
TYP. - TYPICAL
P.C.D. - PITCH CIRCLE DIAMETER
R.C.C - REINFORCED CEMENT CONCRETE
P.C.C - PLAIN CEMENT CONCRETE
BOTTOM REINF.(B) - ————
TOP REINF.(T) - – – – – –
MKD. - MARKED
THK. - THICK
TYP. - TYPICAL
REINF. - REINFORCEMENT
T.O.G - TOP OF GROUT

NOTES:-

1. ALL DIMENSIONS ARE IN MILLIMETRES AND LEVELS AND CO-ORDINATES ARE IN METRES UNLESS OTHERWISE STATED.
2. GRADE OF CONCRETE SHALL BE 35 MPa FOR FOUNDATION & 15 MPa FOR BLINDING CONCRETE.
3. GRADE OF REINFORCEMENT SHALL BE DEFORMED BAR 420 MPa (GRADE 60) - ASTM A615/A615M.
4. NET SAFE BEARING CAPACITY OF SOIL AT BOTTOM OF FOUNDATION CONSIDERED 450KN/ SQ. M
5. IF ANY PART OF FOUNDATION COMES ON BACKFILL ZONE OF ADJACENT FOUNDATION OR ANY LOOSE SOIL ARE ENCOUNTERED BELOW FOUNDATION LEVEL THE SAME SHALL BE REMOVED AND FILLED WITH PCC.
6. FOR DETAIL OF ANCHOR BOLTS REFER DRAWING NO. MD-216-1000-EG-CV-DED-1003.
7. THIS DRAWING SHALL BE READ IN CONJUNCTION WITH GENERAL NOTES DRG NO. MD-216-1000-EG-CV-DED-1001 AND STANDARD REINFORCEMENT DETAILS DRG NO. MD-216-1000-EG-CV-DED-1005.

DOCUMENT NUMBER	REFERENCE DOCUMENTS	REV	DATE	REVISION DESCRIPTION	DRN	CHK	ENG	APP	EMP
		D01	22/02/2023	AS-BUILT	JYM	AVG	MMJ	SJM	
		C01	06/05/2020	RELEASE FOR CONSTRUCTION	JYM	AVG	MMJ	SJM	
MD-216-3320-EG-ST-GAD-2179	PLAN, ELEVATIONS & DETAILS	A01	09/04/2020	ISSUED FOR REFERENCE	JYM	AVG	MMJ	SJM	

RESERVED FOR VENDOR LOGO AND DRAWING NUMBER

LARSEN & TOUBRO

This drawing is the property of LARSEN & TOUBRO and must not be passed on to any person or body not authorized by us to receive it nor be copied or otherwise made use either in full or in part by such person or body without our prior permission in writing.

Outotec

The content of these documents are the sole property of Outotec Oyj. Any rights not expressly granted herein are reserved. Reproduction, transfer or distribution of part or all of the contents in any form without prior written permission of Outotec is prohibited.

MA'ADEN معادن
Saudi Arabian Mining Company شركة التعدين العربية السعودية

This document and the information contained herein is Ma'aden proprietary know-how. This document or any part thereof should not be reproduced, stored in a retrieval system or transmitted by any means, electronic or otherwise, or divulged without prior written permission of Ma'aden.

LARSEN & TOUBRO DRAWING NUMBER	019045_450_C_D_24087_003	REVISION 2
OUTOTEC DRAWING NUMBER	900707__GAU01__ST02__CTB17__33201	DOCUMENT ID OU100680961 / REVISION 2

DRAWN	JYM	07/04/2020
CHECKED	AVG	08/04/2020
ENGINEER	MMJ	07/04/2020
APPROVED	SJM	09/04/2020
EMPLOYER		
SCALE	1:25, 1:50, 1:100	A1

MANSOURAH - MASSARAH GOLD PROJECT
DETAIL DRAWING
LOW GRADE THICKENING
DETAIL OF STAIR FOUNDATION

DRAWING NUMBER: MD-216-3320-EG-CV-DED-1205 | REV: D01