


DRAWING NUMBER: MD-216-3320-EG-CV-GAD-1197 | REV: D01

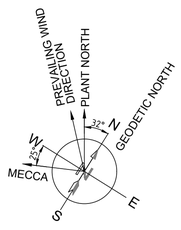

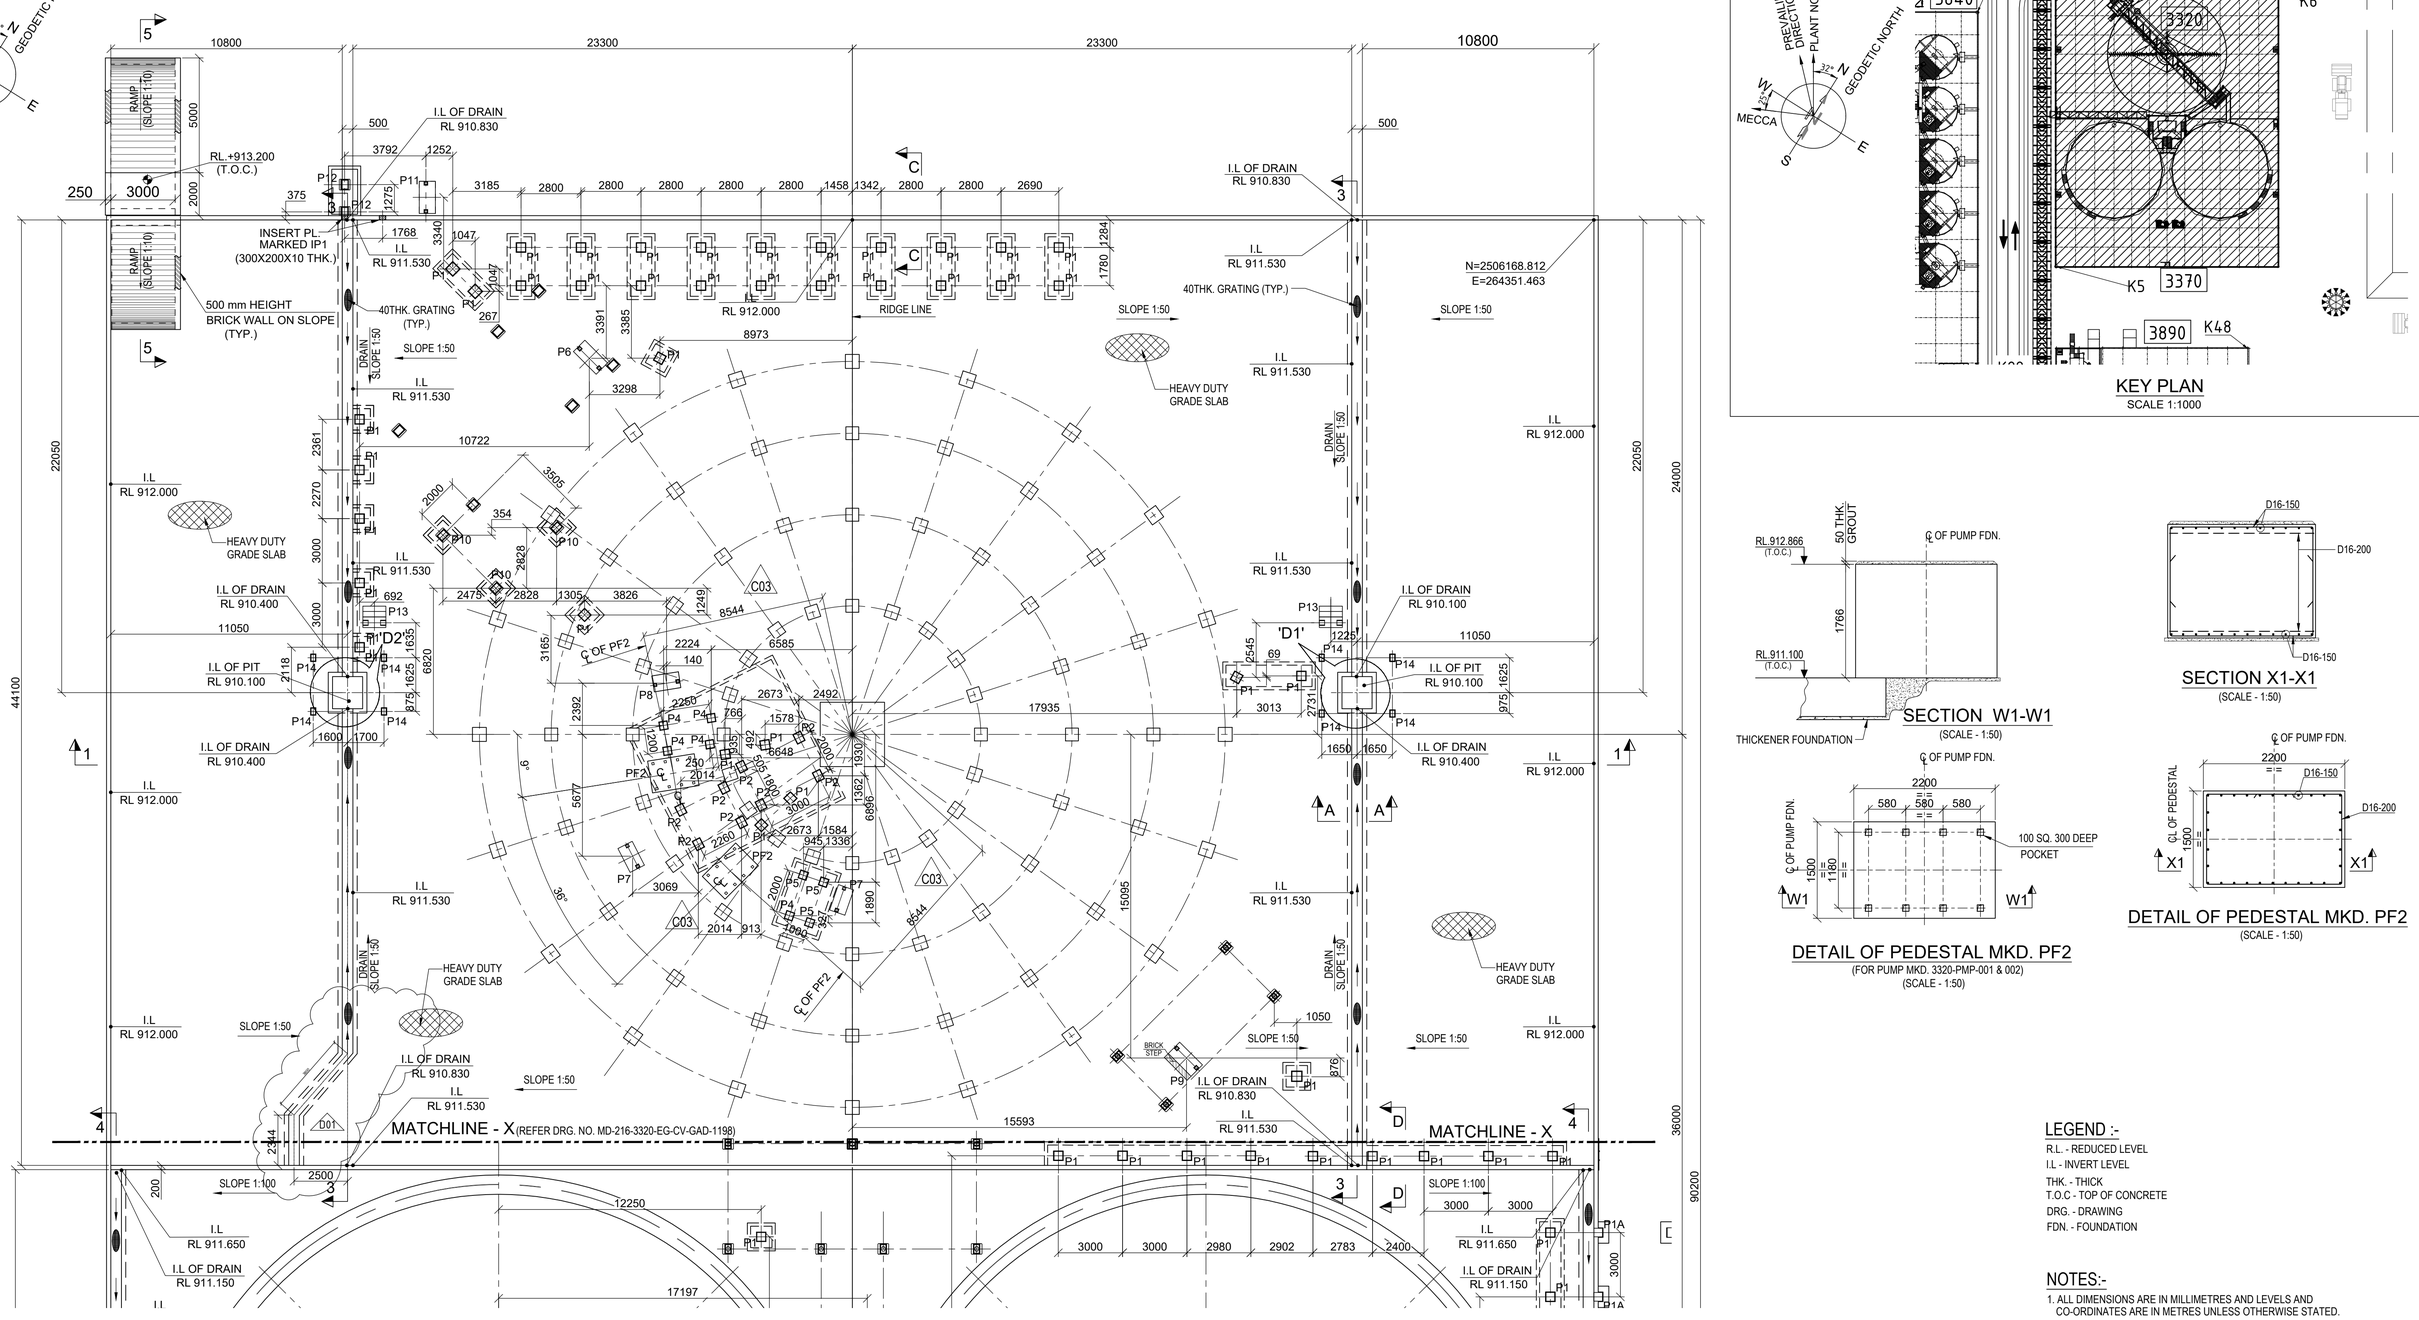

LAYOUT OF GRADE SLAB FOR LOW GRADE THICKENING
SCALE 1:150

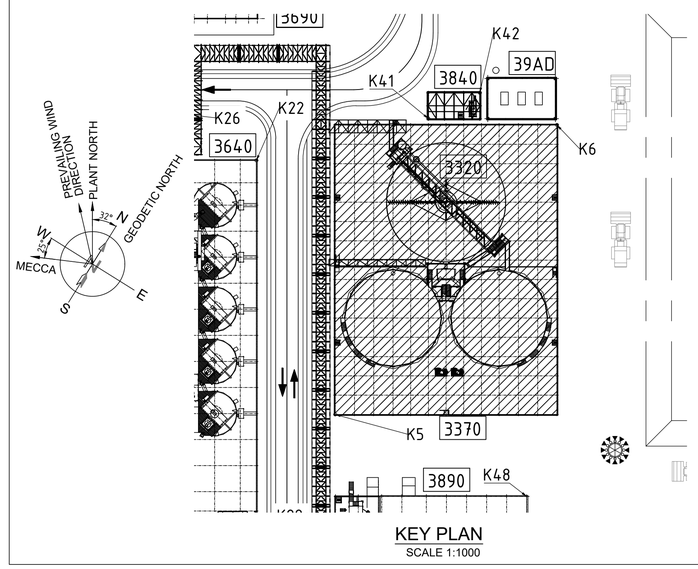

KEY PLAN
SCALE 1:1000

SECTION W1-W1
(SCALE - 1:50)

SECTION X1-X1
(SCALE - 1:50)

DETAIL OF PEDESTAL MKD. PF2
(FOR PUMP MKD. 3320-PMP-001 & 002)
(SCALE - 1:50)

DETAIL OF PEDESTAL MKD. PF2
(SCALE - 1:50)

LEGEND :-
R.L. - REDUCED LEVEL
I.L - INVERT LEVEL
THK. - THICK
T.O.C - TOP OF CONCRETE
DRG. - DRAWING
FDN. - FOUNDATION

NOTES:-
1. ALL DIMENSIONS ARE IN MILLIMETRES AND LEVELS AND CO-ORDINATES ARE IN METRES UNLESS OTHERWISE STATED.
2. FOR DETAILS OF GRADE SLAB REFER DRG. NO. MD-216-1000-EG-CV-DED-1002.

DOCUMENT NUMBER	REFERENCE DOCUMENTS	REV	DATE	REVISION DESCRIPTION	DRN	CHK	ENG	APP	EMP
		D01	18/02/2023	AS-BUILT	NAEW-SN	SJM	AVG	AG	
MD-216-3320-EG-CV-DED-1204	LOW GRADE THICKENING DETAIL OF GRADE SLAB	C03	22/12/2020	ISSUED FOR CONSTRUCTION AND REVISED AS MARKED C03	SYA	SJM	AVG	AG	
MD-216-3320-EG-CV-GAD-1198	LOW GRADE THICKENING LAYOUT OF GRADE SLAB	C02	31/10/2020	ISSUED FOR CONSTRUCTION AND REVISED AS MARKED C02	SYA	SJM	AVG	AG	
MD-216-3320-EG-ME-GAD-1005	LOAD PLAN LOW GRADE THICKENING PLAN VIEW	C01	29/04/2020	ISSUED FOR CONSTRUCTION, REVISED AS PER EMPLOYER	SYA	SJM	AVG	AG	
MD-216-3320-EG-CV-DED-1203	RC DETAILS OF FOUNDATION			COMMENTS ON 17/04/2020 AND REVISED AS MARKED C01					
MD-216-3320-EG-CV-GAD-1195	LAYOUT & DETAIL OF FOUNDATION	A01	19/03/2019	ISSUED FOR REFERENCE	SYA	SJM	AVG	AG	

RESERVED FOR VENDOR LOGO AND DRAWING NUMBER

LARSEN & TOUBRO DRAWING NUMBER: 019045_450_C_G_24086_003 | REVISION: 4
OUTOTEC DRAWING NUMBER: 900707__GAU01__ST02__MTL01__33207 | DOCUMENT ID: OU100665288 | REVISION: 4

LARSEN & TOUBRO

This drawing is the property of LARSEN & TOUBRO and must not be passed on to any person or body not authorized by us to receive it nor be copied or otherwise made use either in full or in part by such person or body without our prior permission in writing.

Outotec

The content of these documents are the sole property of Outotec Oyj. Any rights not expressly granted herein are reserved. Reproduction, transfer or distribution of part or all of the contents in any form without prior written permission of Outotec is prohibited.

MA'ADEN معادن
Saudi Arabian Mining Company شركة التعدين العربية السعودية

This document and the information contained herein is Ma'aden proprietary know-how. This document or any part thereof should not be reproduced, stored in a retrieval system or transmitted by any means, electronic or otherwise, or divulged without prior written permission of Ma'aden.

DRAWN	SYA	17/03/2019
CHECKED	SJM	18/03/2019
ENGINEER	AVG	17/03/2019
APPROVED	AG	19/03/2019
EMPLOYER		
SCALE	1:150	A1

MANSOURAH - MASSARAH GOLD PROJECT
GENERAL ARRANGEMENT DRAWING
LOW GRADE THICKENING
LAYOUT OF GRADE SLAB

DRAWING NUMBER: MD-216-3320-EG-CV-GAD-1197 | REV: D01