


DRAWING NUMBER MD-216-3340-EG-CV-DED-1217 REV D01

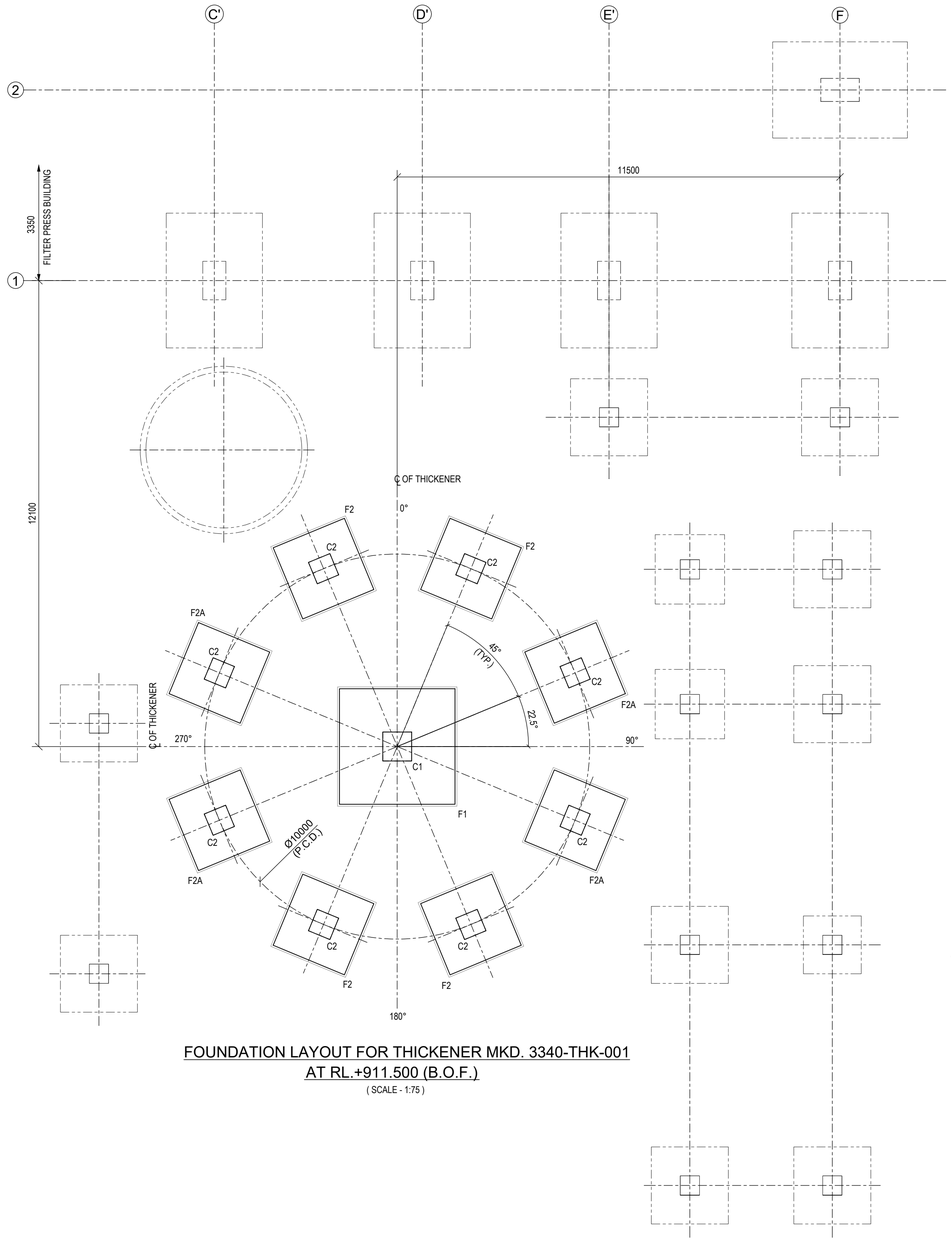


FOUNDATION LAYOUT FOR THICKENER MKD. 3340-THK-001
AT RL.+911.500 (B.O.F.)
(SCALE - 1:75)

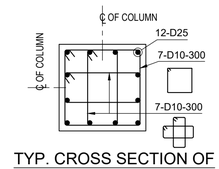


TYP. CROSS SECTION OF
COLUMN MKD. C1
(1 NO. REQUIRED)
(SCALE- 1:25)

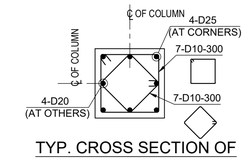


TYP. CROSS SECTION OF
COLUMN MKD. C2
(8 NOS. REQUIRED)
(SCALE- 1:25)

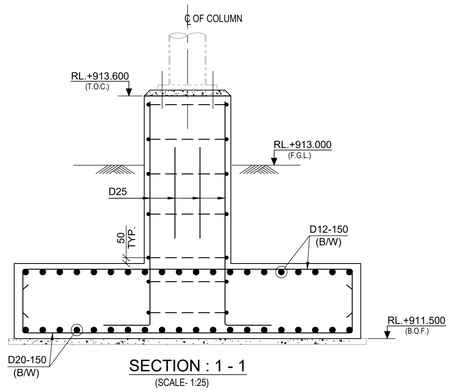


SECTION : 1 - 1
(SCALE- 1:25)

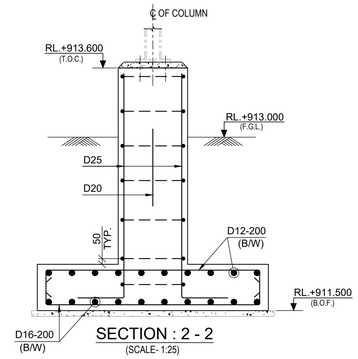

SECTION : 2 - 2
(SCALE- 1:25)

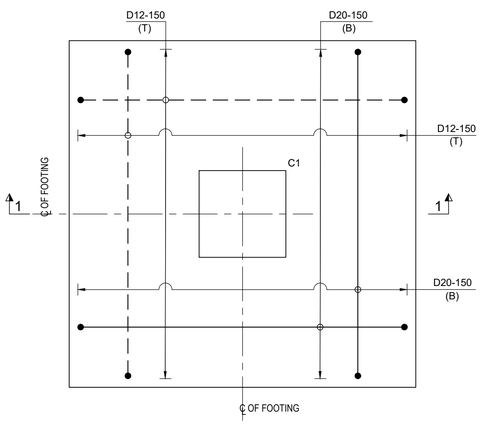

R.C. DETAIL OF FOUNDATION MKD. F1
(1 NO. REQUIRED)
(SCALE- 1:25)

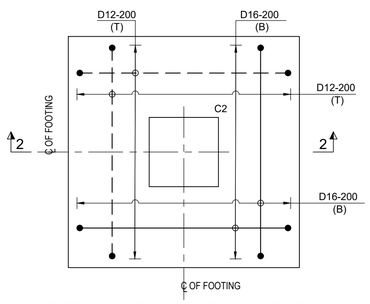

R.C. DETAIL OF FOUNDATION MKD. F2 & F2A
(8 NOS. REQUIRED)
(SCALE- 1:25)

LEGEND :-

T.O.C. - TOP OF CONCRETE.
F.G.L. - FINISHED GROUND LEVEL.
B.O.F. - BOTTOM OF FOOTING
P.C.D. - PITCH CIRCLE DIAMETER.
TYP. - TYPICAL.
B/W - BOTHWAYS.
R.C. - REINFORCED CONCRETE..
THK. - THICKENER.
FDN. - FOUNDATION.
MKD. - MARKED.
T - TOP.
B - BOTTOM.
- - - - - TOP REINFORCEMENT.
——— BOTTOM REINFORCEMENT.

NOTES :-

1. ALL DIMENSIONS ARE IN MILLIMETERS AND LEVELS AND CO-ORDINATES ARE IN METERS. UNLESS OTHERWISE STATED.
3. ALL OTHER NOTES REFER DRAWING NO. MD-101-SMEM-EG-ST-DST-0001.
3. ALL OTHER NOTES REFER DRAWING NO. MD-101-SMEM-EG-ST-DST-0001.

DOCUMENT NUMBER	REFERENCE DOCUMENTS	REV	DATE	REVISION DESCRIPTION	DRN	CHK	ENG	APP	EMP
		D01	15/03/2023	AS-BUILT	PDK	SGC	SHD	PRI	
		C01	30/01/2020	ISSUED FOR CONSTRUCTION	PDK	SGC	SHD	PRI	
MD-216-3340-EG-ME-GAD-1002	CONCENTRATE THICKENING	A01	07/01/2020	ISSUED FOR REFERENCE	PDK	SGC	SHD	PRI	

RESERVED FOR VENDOR LOGO AND DRAWING NUMBER

LARSEN & TOUBRO

This drawing is the property of LARSEN & TOUBRO and must not be passed on to any person or body not authorized by us to receive it nor be copied or otherwise made use either in full or in part by such person or body without our prior permission in writing.

Outotec

The content of these documents are the sole property of Outotec Oyj. Any rights not expressly granted herein are reserved. Reproduction, transfer or distribution of part or all of the contents in any form without prior written permission of Outotec is prohibited.

MA'ADEN معادن
Saudi Arabian Mining Company شركة التعدين العربية السعودية

This document and the information contained herein is Ma'aden proprietary know-how. This document or any part thereof should not be reproduced, stored in a retrieval system or transmitted by any means, electronic or otherwise, or divulged without prior written permission of Ma'aden.

LARSEN & TOUBRO DRAWING NUMBER: 019045_450_C_D_24093_001 — REVISION: 2
OUTOTEC DRAWING NUMBER: 900707__GAU01__ST01__CTB17__33401 — DOCUMENT ID: OU100666579 — REVISION: 2

DRAWN	PDK	18/12/2019
CHECKED	SGC	19/12/2019
ENGINEER	SHD	16/12/2019
APPROVED	PRI	07/01/2020
EMPLOYER		
SCALE 1:75, 1:25		A1

MANSOURAH - MASSARAH GOLD PROJECT
DETAIL DRAWING
CONCENTRATE THICKENING
R.C. DETAILS OF THK. FDN. MKD. 3340-THK-001

DRAWING NUMBER: MD-216-3340-EG-CV-DED-1217 — REV: D01