


DRAWING NUMBER: MD - 216 - 3340 - EG - CV - DED - 1218
REV: D01

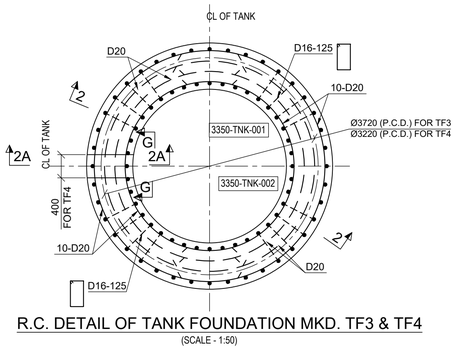


R.C. DETAIL OF TANK FOUNDATION MKD. TF3 & TF4
(SCALE - 1:50)

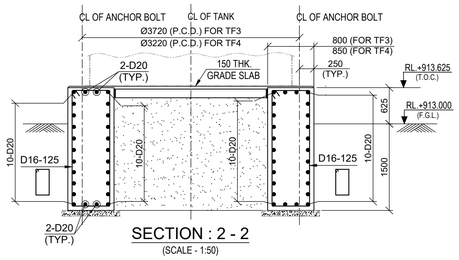


SECTION : 2 - 2
(SCALE - 1:50)

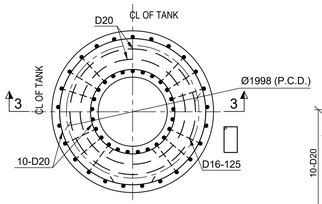


R.C. DETAIL OF TANK FOUNDATION MKD. TF5
(SCALE - 1:50)

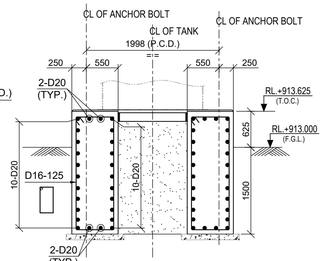


SECTION : 3 - 3
(SCALE - 1 : 50)

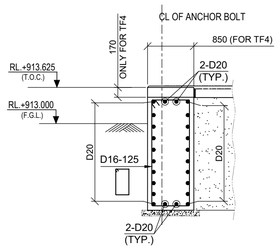


SECTION : 2A - 2A
(SCALE - 1:50)

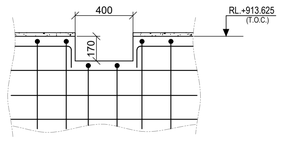


SECTION : G - G
(SCALE - 1:20)

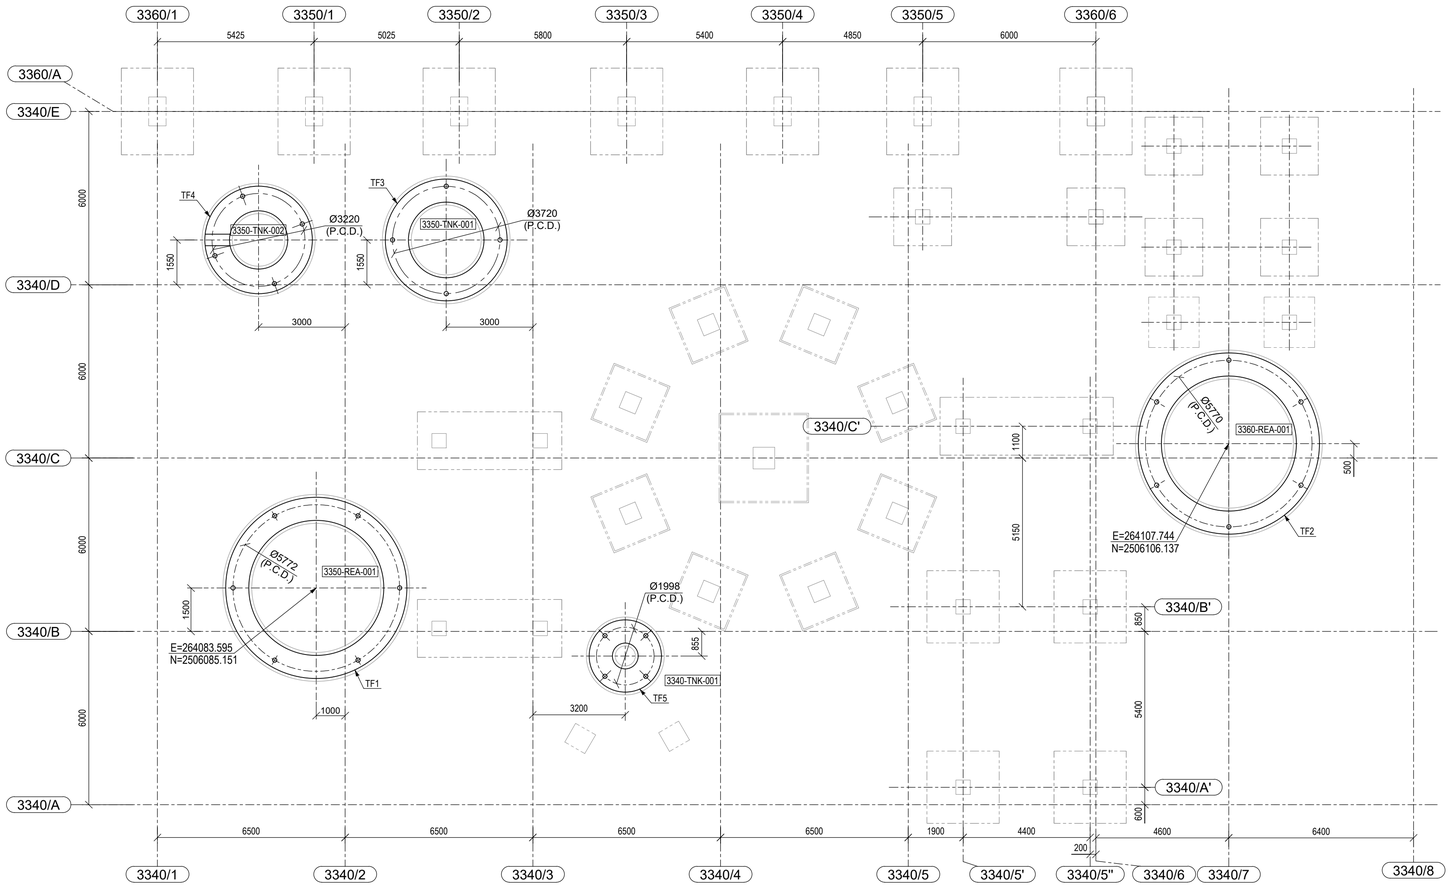


FOUNDATION LAYOUT FOR TANKS
(SCALE - 1:100)

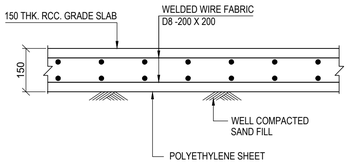

TYP. DET. OF 150 THK. GRADE SLAB
SCALE 1:10

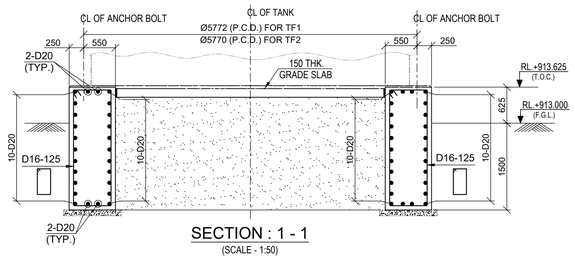

SECTION : 1 - 1
(SCALE - 1:50)

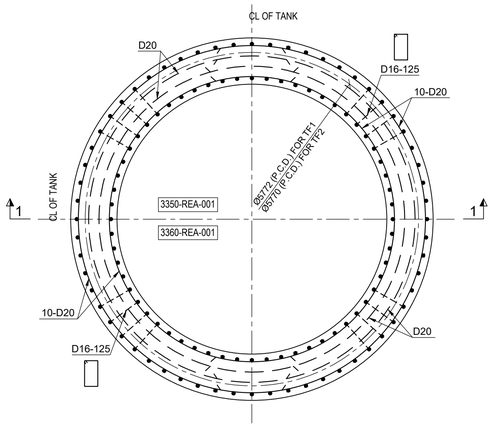

R.C. DETAIL OF TANK FOUNDATION MKD. TF1 & TF2
(SCALE - 1:50)

LEGEND :-

RL. - REDUCED LEVEL.
T.O.C. - TOP OF CONCRETE.
F.G.L. - FINISHED GROUND LEVEL.
P.C.D. - PITCH CIRCLE DIAMETER.
TYP. - TYPICAL.
R.C. - REINFORCED CONCRETE..
DET. - DETAIL.
FDN. - FOUNDATION.
MKD. - MARKED.
T - TOP.
B - BOTTOM.
- - - - - - TOP REINFORCEMENT.
——— BOTTOM REINFORCEMENT.

NOTES :-

1. ALL DIMENSIONS ARE IN MILLIMETERS AND LEVELS AND CO-ORDINATES ARE IN METERS. UNLESS OTHERWISE STATED.
2. THIS DRAWING SHALL BE READ IN CONJUNCTION WITH DRG. NO. MD-216-3340-EG-CV-GAD-1215.
3. ALL OTHER NOTES REFER DRAWING NO. MD-101-SMEM-EG-ST-DST-0001 TO 0008.

DOCUMENT NUMBER	REFERENCE DOCUMENTS			REVISION DESCRIPTION	DRN	CHK	ENG	APP	EMP
MD-216-3000-EG-CV-RPT-1008	GEOTECHNICAL REPORT								
MD-216-1000-EG-ST-CRT-1001	CIVIL, STRUCTURAL AND ARCH. DESIGN CRITERIA								
MD-216-3350-EG-ME-GAD-1058	3350-TNK-002 FILTER CLOTH WASH TANK								
MD-216-3350-EG-ME-GAD-1057	3350-TNK-001 FILTRATE TANK	D01	15/03/2023	AS-BUILT	AMJ	SGC	SHD	PRI	
MD-216-3360-EG-ME-GAD-1024	3340-TNK-001 FLOTATION CONCENTRATE THICKENER	C03	03/10/2020	ISSUED FOR CONSTRUCTION & REVISED AS MKD_C03	AMJ	SGC	SHD	PRI	
	OVERFLOW TANK	C02	13/04/2020	ISSUED FOR CONSTRUCTION & REVISED AS MKD_C02	PDK	SGC	SHD	PRI	
MD-216-3360-EG-ME-PLN-1001	3360-REA-001 CONCENTRATE REPULP TANK	C01	23/03/2020	ISSUED FOR CONSTRUCTION	PDK	SGC	SHD	PRI	
MD-216-3350-EG-ME-PLN-1002	3350-REA-001 CONCENTRATE FILTER FEED TANK	A01	18/02/2020	ISSUED FOR REFERENCE	PDK	SGC	SHD	PRI	

RESERVED FOR VENDOR LOGO AND DRAWING NUMBER

LARSEN & TOUBRO

This drawing is the property of LARSEN & TOUBRO and must not be passed on to any person or body not authorized by us to receive it nor be copied or otherwise made use either in full or in part by such person or body without our prior permission in writing.

Outotec

The content of these documents are the sole property of Outotec Oyj. Any rights not expressly granted herein are reserved. Reproduction, transfer or distribution of part or all of the contents in any form without prior written permission of Outotec is prohibited.

MA'ADEN معادن
Saudi Arabian Mining Company شركة فعادن العربية السعودية

This document and the information contained herein is Ma'aden proprietary know-how. This document or any part thereof should not be reproduced, stored in a retrieval system or transmitted by any means, electronic or otherwise, or divulged without prior written permission of Ma'aden.

LARSEN & TOUBRO DRAWING NUMBER: 019045_450_C_D_24093_002 — REVISION: 4
OUTOTEC DRAWING NUMBER: 900707 __GAU01 __ST01 __CTB17 __33402 — DOCUMENT ID: OU100666580 — REVISION: 4

DRAWN	PDK	30/01/2020	MANSOURAH - MASSARAH GOLD PROJECT
CHECKED	SGC	14/02/2020	DETAIL DRAWING
ENGINEER	SHD	05/02/2020	CONCENTRATE THICKENING
APPROVED	PRI	18/02/2020	R.C. DET. OF FDN. MKD. TF1, TF2, TF3, TF4 & TF5
EMPLOYER			
SCALE 1:100 1:50	A1		DRAWING NUMBER: MD - 216 - 3340 - EG - CV - DED - 1218 — REV: D01