


DRAWING NUMBER: MD - 216 - 3340 - EG - CV - DED - 1221
REV: D01

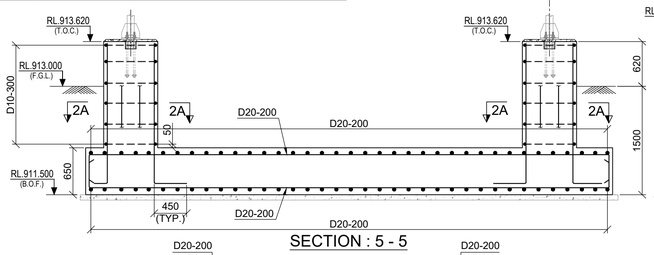


SECTION : 5 - 5

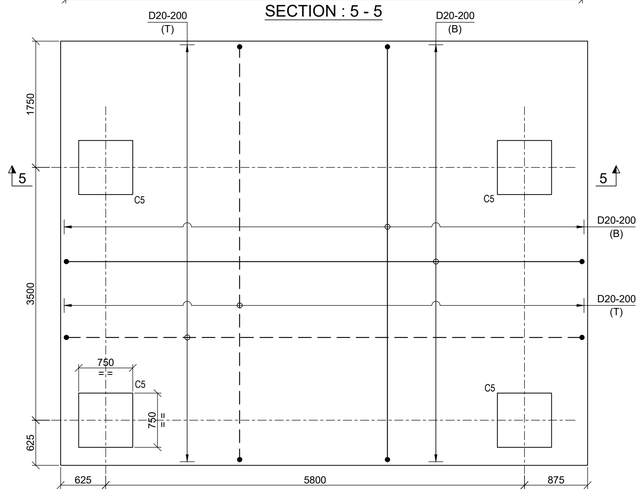


R.C. DETAIL OF FOUNDATION MKD. F5
(1 NO. REQUIRED)
(SCALE - 1:40)

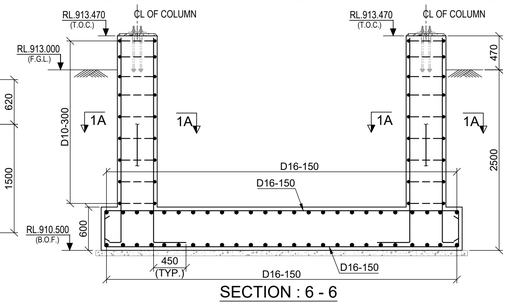


SECTION : 6 - 6
(SCALE - 1:40)

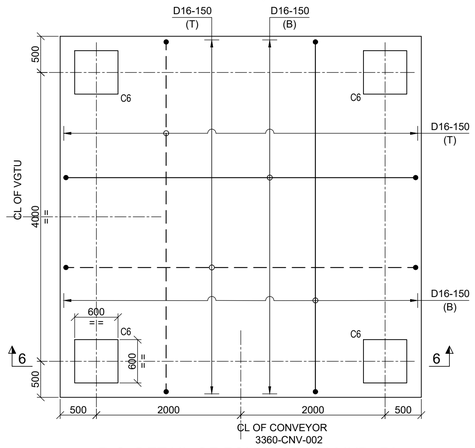


R.C. DETAIL OF FOUNDATION MKD. F6
(1 NO. REQUIRED)
(SCALE - 1:40)

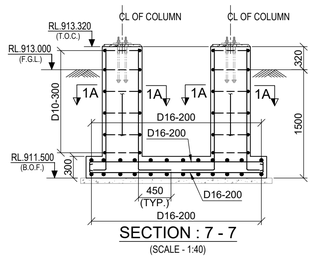


SECTION : 7 - 7
(SCALE - 1:40)

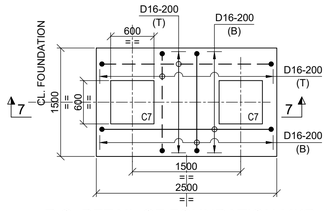


R.C. DETAIL OF FOUNDATION MKD. F7
(2 NOS. REQUIRED)
(SCALE - 1:40)

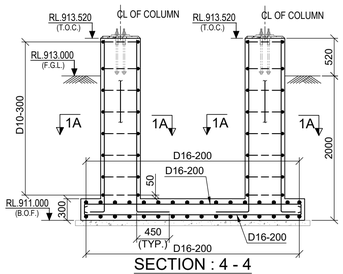


SECTION : 4 - 4
(SCALE - 1:40)

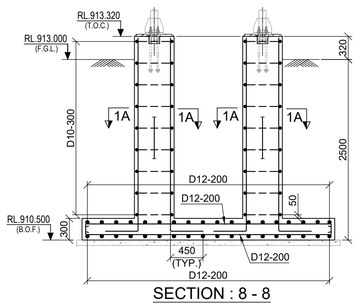


SECTION : 8 - 8
(SCALE - 1:40)

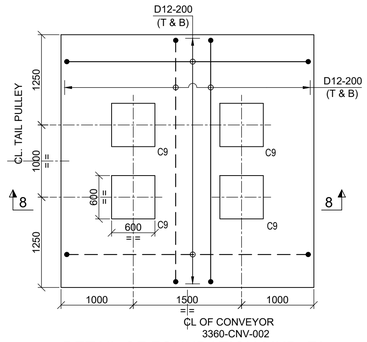


DETAIL OF FOUNDATION MKD. F9
(1 NO. REQUIRED)
(SCALE - 1:40)

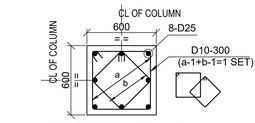


SECTION : 1A - 1A
TYP. R.C. CROSS SECTION OF COLUMN MKD. C1 TO C4, & C6 TO C9
(SCALE- 1:25)

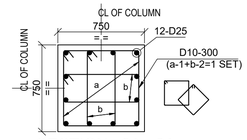


SECTION : 2A - 2A
TYP. R.C. CROSS SECTION OF COLUMN MKD. C5
(SCALE- 1:25)

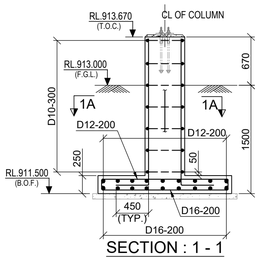


SECTION : 1 - 1
(SCALE - 1:40)

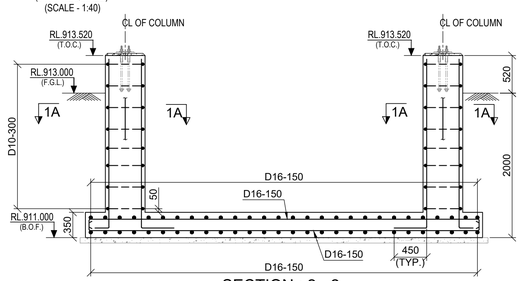


SECTION : 2 - 2
(SCALE - 1:40)

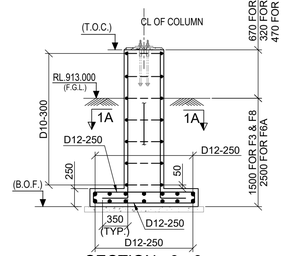


SECTION : 3 - 3
(SCALE - 1:40)

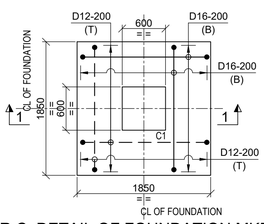


R.C. DETAIL OF FOUNDATION MKD. F1
(4 NOS. REQUIRED)
(SCALE - 1:40)

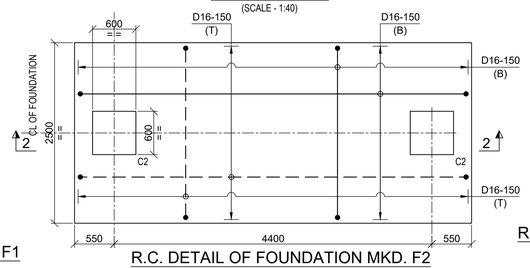

R.C. DETAIL OF FOUNDATION MKD. F2
(3 NOS. REQUIRED)
(SCALE - 1:40)

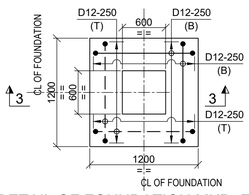

R.C. DETAIL OF FOUNDATION MKD. F3, F6A & F8
(10 NOS. REQUIRED)
(SCALE - 1:40)

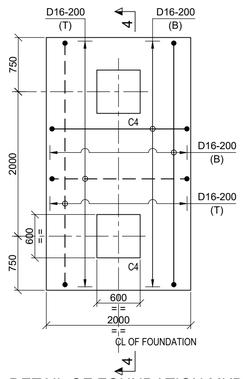

R.C. DETAIL OF FOUNDATION MKD. F4
(1 NO. REQUIRED)
(SCALE - 1:40)

LEGENDS :-

RL	- REDUCED LEVEL.
T.O.C.	- TOP OF CONCRETE.
F.G.L.	- FINISHED GROUND LEVEL.
B.O.F.	- BOTTOM OF FOOTING
TYP.	- TYPICAL.
B/W	- BOTHWAYS.
R.C.	- REINFORCED CONCRETE..
T	- TOP.
B	- BOTTOM.
- - - -	- TOP REINFORCEMENT.
———	- BOTTOM REINFORCEMENT.

NOTES :-

1. ALL DIMENSIONS ARE IN MILLIMETERS AND LEVELS AND CO-ORDINATES ARE IN METERS. UNLESS OTHERWISE STATED.
2. THIS DRAWING SHALL BE READ IN CONJUNCTION WITH DRAWING NO. MD-216-3340-EG-CV-GAD-1216.
3. ALL OTHER NOTES REFER DRAWING NO. MD-101-SMEM-EG-ST-DST-0001 TO 0008.
4. GENERAL NOTES FOR CIVIL WORKS & STANDARD REINFORCEMENT DETAIL REFER DRAWING NO. MD-216-1000-EG-CV-DED-1001 & 1005.

DOCUMENT NUMBER	REFERENCE DOCUMENTS	REV	DATE	REVISION DESCRIPTION	DRN	CHK	ENG	APP	EMP
MD-216-1000-EG-CV-DED-1003	ANCHOR BOLTS STANDARD DETAILS.								
MD-216-3340-EG-ME-GAD-1021	PLAN AT. +913.000								
MD-216-3340-EG-ME-GAD-1003	PLAN AT. +921.750								
MD-216-3360-EG-ME-ELV-1004	CONV. 3360-CNV-002-ELEVATION	D01	15/03/2023	AS-BUILT	PDK	SGC	SHD	PRI	
MD-216-3360-EG-ME-LPX-1002	CONV. 3360-CNV-002-PLAN VIEW	C01	29/06/2020	ISSUED FOR CONSTRUCTION	PDK	SGC	SHD	PRI	
MD-216-3360-EG-ME-ELV-1003	CONV. 3360-CNV-002-ELEVATION	A01	30/05/2020	ISSUED FOR REFERENCE	PDK	SGC	SHD	PRI	

RESERVED FOR VENDOR LOGO AND DRAWING NUMBER

LARSEN & TOUBRO DRAWING NUMBER: 019045_450_C_D_24093_003 — REVISION: 2
OUTOTEC DRAWING NUMBER: 900707__GAU01__ST01__CTB17__33403 — DOCUMENT ID: OU100686831 — REVISION: 2

LARSEN & TOUBRO
This drawing is the property of LARSEN & TOUBRO and must not be passed on to any person or body not authorized by us to receive it nor be copied or otherwise made use either in full or in part by such person or body without our prior permission in writing.

Outotec
The content of these documents are the sole property of Outotec Oyj. Any rights not expressly granted herein are reserved. Reproduction, transfer or distribution of part or all of the contents in any form without prior written permission of Outotec is prohibited.

MA'ADEN معادن
Saudi Arabian Mining Company شركة التعدين العربية السعودية
This document and the information contained herein is Ma'aden proprietary know-how. This document or any part thereof should not be reproduced, stored in a retrieval system or transmitted by any means, electronic or otherwise, or divulged without prior written permission of Ma'aden.

DRAWN	PDK	18/05/2020
CHECKED	SGC	25/05/2020
ENGINEER	SHD	15/05/2020
APPROVED	PRI	30/05/2020
EMPLOYER		
SCALE 1:40 & 1:25		A1

MANSOURAH - MASSARAH GOLD PROJECT
DETAIL DRAWING
CONCENTRATE THICKENING
R.C. DETAIL OF MISCELLANEOUS FOUNDATION

DRAWING NUMBER: MD - 216 - 3340 - EG - CV - DED - 1221 — REV: D01