


DRAWING NUMBER: MD-216-3340-EG-CV-DED-1224 | REV: D01

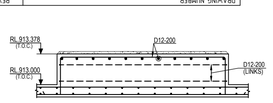


SECTION : 1 - 1
(SCALE - 1:25)

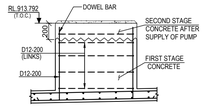


SECTION : 2 - 2
(SCALE - 1:25)

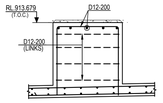


SECTION : 3 - 3
(SCALE - 1:25)

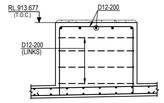


SECTION : 4 - 4
(SCALE - 1:25)

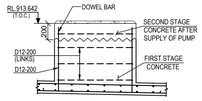


SECTION : 5 - 5
(SCALE - 1:25)

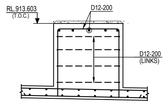


SECTION : 6 - 6
(SCALE - 1:25)

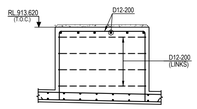


SECTION : 7 - 7
(SCALE - 1:25)

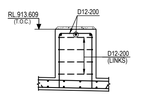


SECTION : 8 - 8
(SCALE - 1:25)

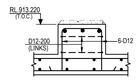


SECTION : 9 - 9
(SCALE - 1:15)

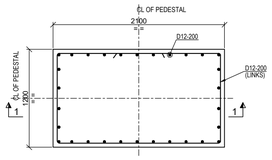


DETAIL OF PEDESTAL MKD. P1
(SCALE - 1:25)

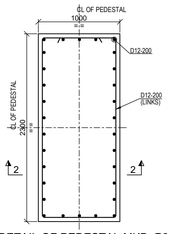


DETAIL OF PEDESTAL MKD. P2
(SCALE - 1:25)

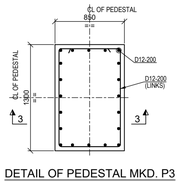


DETAIL OF PEDESTAL MKD. P3
(SCALE - 1:25)

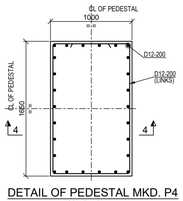


DETAIL OF PEDESTAL MKD. P4
(SCALE - 1:25)

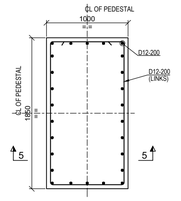


DETAIL OF PEDESTAL MKD. P5
(SCALE - 1:25)

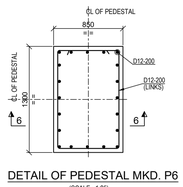


DETAIL OF PEDESTAL MKD. P6
(SCALE - 1:25)

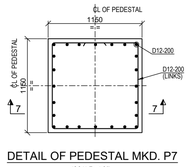


DETAIL OF PEDESTAL MKD. P7
(SCALE - 1:25)

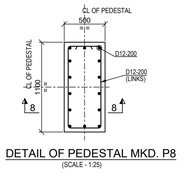


DETAIL OF PEDESTAL MKD. P8
(SCALE - 1:25)

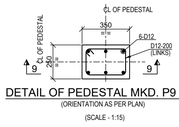


DETAIL OF PEDESTAL MKD. P9 & P9A
(ORIENTATION AS PER PLAN)
(SCALE - 1:15)

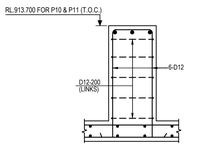


SECTION : 10 - 10
(SCALE - 1:15)

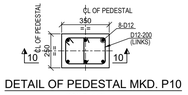


DETAIL OF PEDESTAL MKD. P10
(SCALE - 1:15)

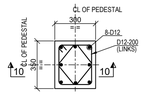


DETAIL OF PEDESTAL MKD. P11
(SCALE - 1:15)

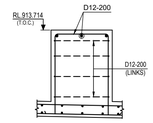


SECTION : 16 - 16
(SCALE - 1:20)

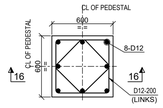


DETAIL OF PEDESTAL MKD. P12
(SCALE - 1:20)

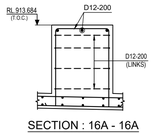


SECTION : 16A - 16A
(SCALE - 1:20)

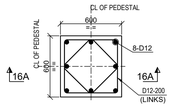


DETAIL OF PEDESTAL MKD. P12A
(SCALE - 1:20)

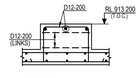


SECTION : 11 - 11
(SCALE - 1:20)

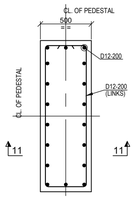


DETAIL OF PEDESTAL MKD. P13 & P14
(SCALE - 1:20)

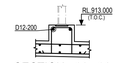


SECTION : 14 - 14
(SCALE - 1:20)

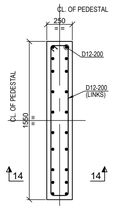


DETAIL OF PEDESTAL MKD. P15
(SCALE - 1:20)

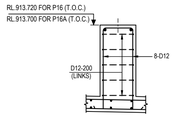


SECTION : 15 - 15
(SCALE - 1:20)

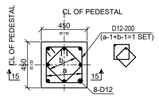


DETAIL OF PEDESTAL MKD. P16 & P16A
(SCALE - 1:20)

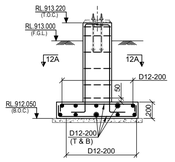


SECTION : 12 - 12
(SCALE - 1:25)

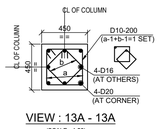


VIEW : 13A - 13A
(SCALE - 1:20)

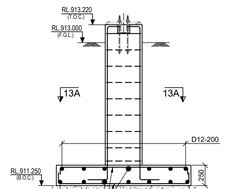


SECTION : 13 - 13
(SCALE - 1:25)

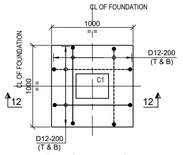


DETAIL OF FOUNDATION MKD. F1
(SCALE - 1:25)

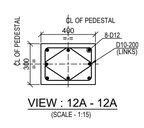


VIEW : 12A - 12A
(SCALE - 1:15)

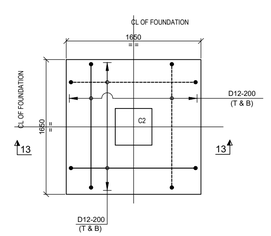


DETAIL OF FOUNDATION MKD. F2
(SCALE - 1:25)

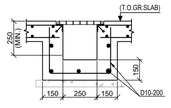


SECTION : E - E
(SCALE - 1:15)

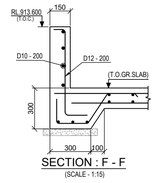


SECTION : F - F
(SCALE - 1:15)

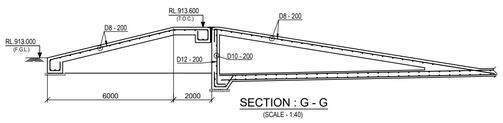


SECTION : G - G
(SCALE - 1:40)

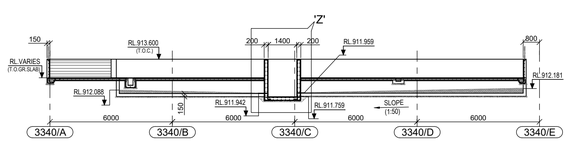


SECTION : B - B
(SCALE - 1:100)

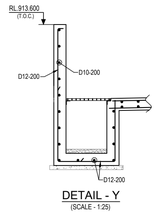


DETAIL - Y
(SCALE - 1:25)

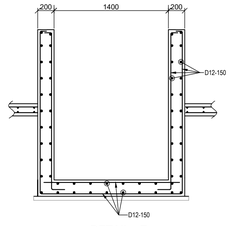


DETAIL - Z
(SCALE - 1:25)

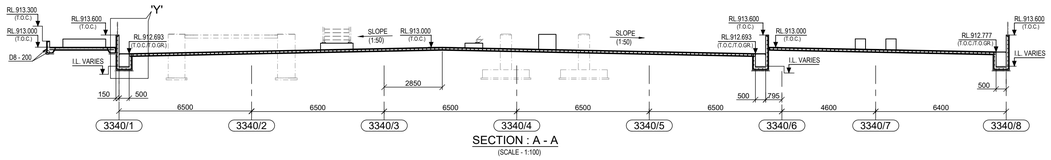


SECTION : A - A
(SCALE - 1:100)

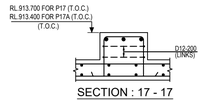

SECTION : 17 - 17
(SCALE - 1:15)

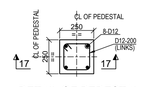

DETAIL OF PEDESTAL MKD. P17 & P17A
(SCALE - 1:15)

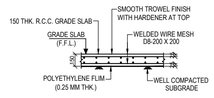

TYP. RC DETAIL OF 150 THK. HEAVY DUTY GRADE SLAB
SCALE 1:25

LEGEND :-

RL - REDUCED LEVEL.
T.O.C. - TOP OF CONCRETE.
F.G.L. - FINISHED GROUND LEVEL.
B.O.C. - BOTTOM OF CONCRETE.
CL - CENTRE LINE.
TYP. - TYPICAL.
THK. - THICK.
MKD. - MARKED.
T.O.GR.SLAB. - TOP OF GRADE SLAB.
I.L. - INVERT LEVEL.
OS. - OILY WATER DRAINAGE PIPE.

NOTES :-

1. ALL DIMENSIONS ARE IN MILLIMETERS AND LEVELS AND CO-ORDINATES ARE IN METERS, UNLESS OTHERWISE STATED.
2. GRADE OF CONCRETE SHALL BE 35 MPa FOR FOUNDATION & 15 MPa FOR BLINDING CONCRETE.
3. GRADE OF REINFORCEMENT SHALL BE DEFORMED BAR 420 MPa (GRADE 60) - ASTM A615/A615M.
4. NET SAFE BEARING CAPACITY OF SOIL AT BOTTOM OF FOUNDATION CONSIDER 400 KN/ SQ. M.
5. CLEAR COVER TO MAIN REINFORCEMENT SHALL BE 75 mm FOR RAFT & 50 mm FOR COLUMN.
6. IF ANY PART OF FOUNDATION COMES ON BACKFILL ZONE OF ADJACENT FOUNDATION OR ANY LOOSE SOIL ARE ENCOUNTERED BELOW FOUNDATION LEVEL THE SAME SHALL BE REMOVED AND FILLED WITH PCC.
7. FOR DETAILS OF GRADE SLAB REFER DRG. NO. MD-216-1000-EG-CV-DED-1002.
8. THE CONTENT OF THIS DRAWING SHALL CONFORM TO THE PROVISIONS OF CIVIL STRUCTURAL AND ARCHITECTURAL DESIGN CRITERIA DOC NO. MD-216-1000-EG-ST-CRT-1001.
9. THIS DRAWING SHALL BE READ IN CONJUNCTION WITH DRAWING NO. MD-216-3340-EG-CV-QAD-1224.
10. GENERAL NOTES FOR CIVIL WORKS & STANDARD REINFORCEMENT DETAIL REFER DRAWING NO. MD-216-1000-EG-CV-DED-1001 & 1005.
11. FOR DETAIL OF BOLTS REFER DRG. NO. MD-216-1000-EG-CV-DED-1003.

DOCUMENT NUMBER	REFERENCE DOCUMENTS	REV	DATE	REVISION DESCRIPTION	DRN	CHK	ENG	APP	EMP
		D01	15/03/2023	AS-BUILT	AMJ	SGC	SHD	PRI	
MD-216-3340-EG-ST-GAD-2196	CONCENTRATE THICKENING, MISCELLANEOUS PLATFORMS	C01	21/12/2020	ISSUED FOR CONSTRUCTION AND REVISED AS MKD. 4	AMJ	SGC	SHD	PRI	
MD-216-1000-EG-ST-CRT-1001	CIVIL, STRUCTURAL AND ARCHITECTURAL DESIGN CRITERIA	A02	06/11/2020	REVISED AS PER EMPLOYER COMMENTS ON DTD. 27.10.2020.	PDK	SGC	SHD	PRI	
MD-216-3350-EG-AR-GAD-1001	CONCENTRATE FILTRATION, FLOOR PLAN			REVISED AS MKD. 4 & ISSUED FOR APPROVAL					
MD-216-3340-EG-ME-GAD-1021	CONCENTRATE THICKENING, PLAN AT 913.000	A01	03/10/2020	ISSUED FOR REFERENCE	AMJ	SGC	SHD	PRI	

RESERVED FOR VENDOR LOGO AND DRAWING NUMBER

LARSEN & TOUBRO

This drawing is the property of LARSEN & TOUBRO and must not be passed on to any person or body not authorized by us to receive it nor be copied or otherwise made use either in full or in part by such person or body without our prior permission in writing.

Outotec

The content of these documents are the sole property of Outotec Oyj. Any rights not expressly granted herein are reserved. Reproduction, transfer or distribution of part or all of the contents in any form without prior written permission of Outotec is prohibited.

MA'ADEN — Saudi Arabian Mining Company

This document and the information contained herein is Ma'aden proprietary know-how. This document or any part thereof should not be reproduced, stored in a retrieval system or transmitted by any means, electronic or otherwise, or divulged without prior written permission of Ma'aden.

LARSEN & TOUBRO DRAWING NUMBER			REVISION
019045_450_C_D_24093_004			3
OUTOTEC DRAWING NUMBER		DOCUMENT ID	REVISION
900707__GAU01__ST01__CTB17__33404		OU100686832	3
DRAWN	AMJ	30/09/2020	MANSOURAH - MASSARAH GOLD PROJECT
CHECKED	SGC	30/09/2020	DETAIL DRAWING
ENGINEER	SHD	29/09/2020	CONCENTRATE THICKENING
APPROVED	PRI	03/10/2020	DETAIL OF GRADE SLAB
EMPLOYER			
SCALE 1:100		A0	DRAWING NUMBER: MD-216-3340-EG-CV-DED-1224 — REV: D01