


DRAWING NUMBER: MD - 216 - 3340 - EG - CV - GAD - 1214
REV: D01

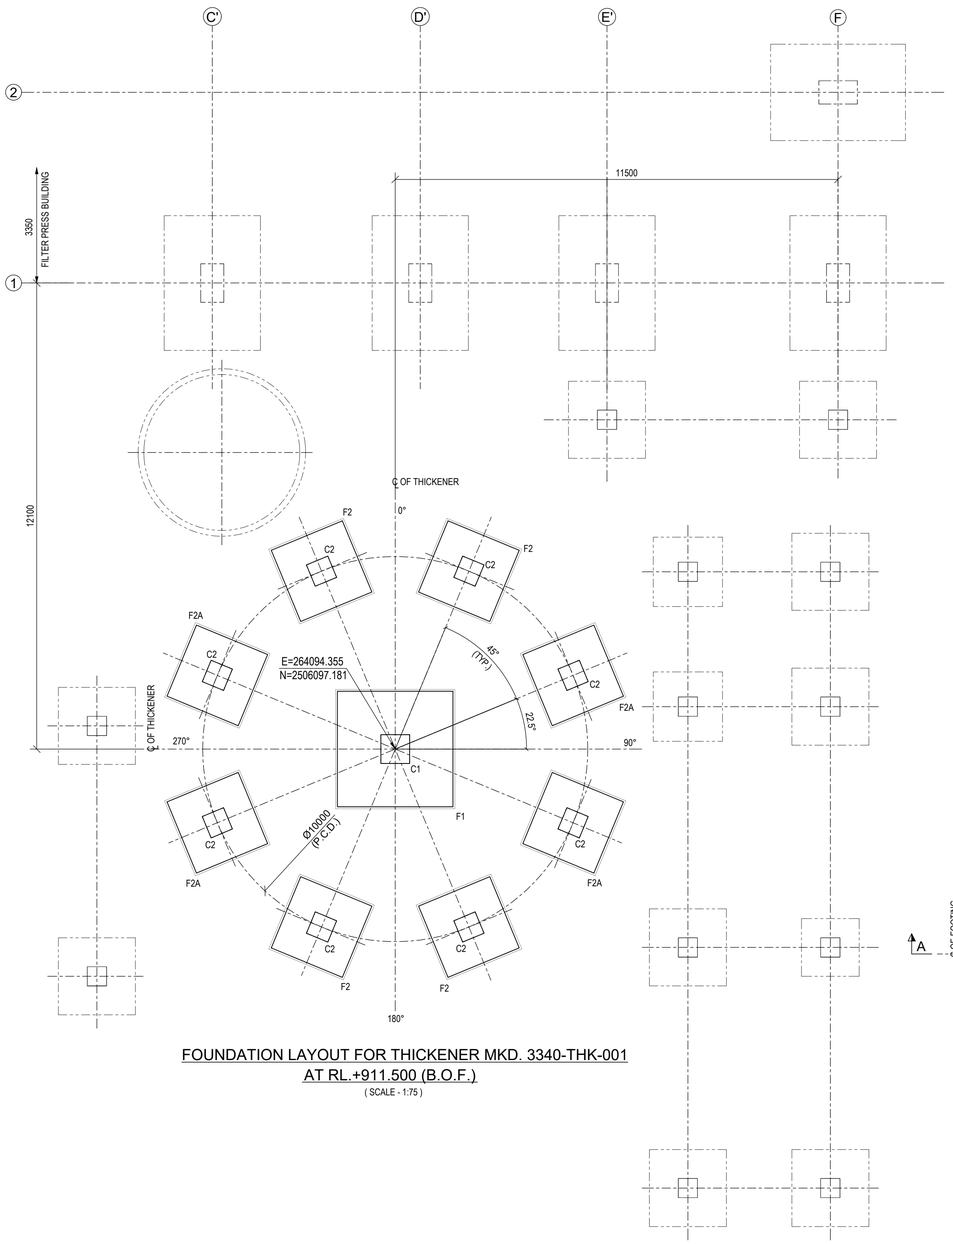


FOUNDATION LAYOUT FOR THICKENER MKD. 3340-THK-001
AT RL.+911.500 (B.O.F.)
(SCALE - 1:75)

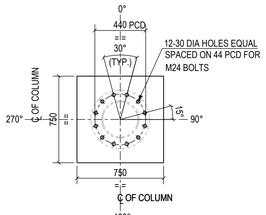


VIEW : B-B
(SCALE : 1:25)

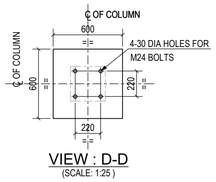


VIEW : D-D
(SCALE: 1:25)

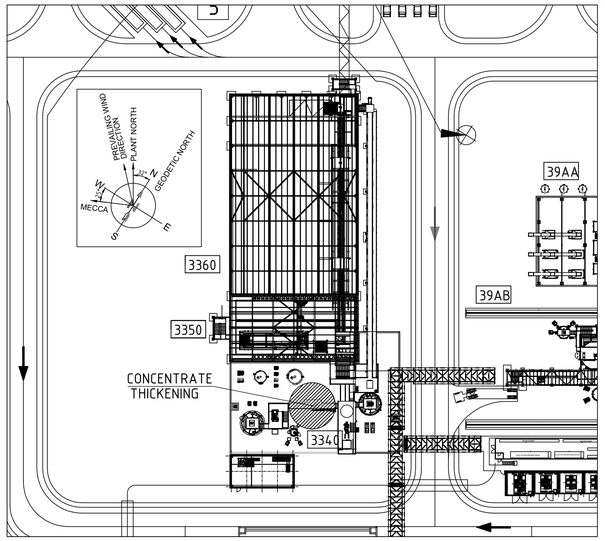


KEY PLAN
(SCALE- 1:750)

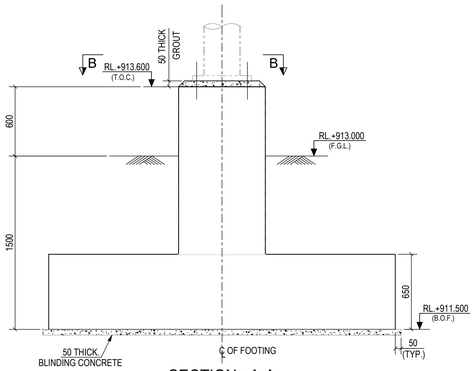


SECTION : A-A
(SCALE: 1:25)

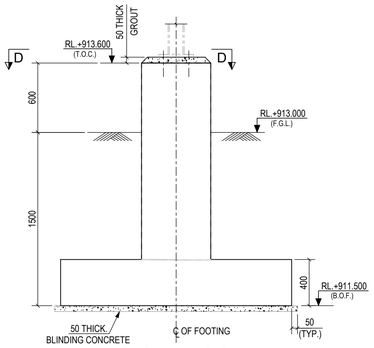

SECTION : C-C
(SCALE: 1:25)

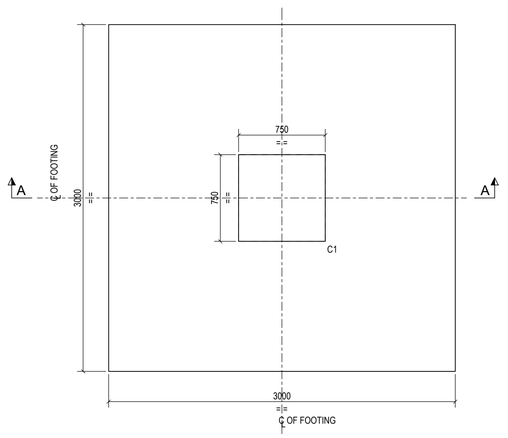

DETAIL OF FOUNDATION MKD. F1
(SCALE- 1:25)

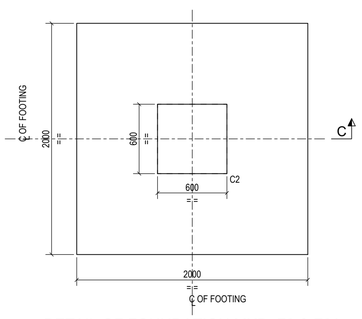

DETAIL OF FOUNDATION MKD. F2 & F2A
(SCALE: 1:25)

LEGEND :-

T.O.C. - TOP OF CONCRETE.
F.G.L. - FINISHED GROUND LEVEL.
B.O.F. - BOTTOM OF FOOTING
TYP. - TYPICAL.
P.C.D. - PITCH CIRCLE DIAMETER.
P.C.C. - PLAIN CEMENT CONCRETE.
LAY. - LAYOUT.
DET. - DETAIL.
THK. - THICKENER.
FDN. - FOUNDATION.
MKD. - MARKED.

NOTES :-

1. ALL DIMENSIONS ARE IN MILLIMETERS AND LEVELS AND CO-ORDINATES ARE IN METERS. UNLESS OTHERWISE STATED.
2. GRADE OF CONCRETE SHALL BE 35 MPa FOR FOUNDATION & 15 MPa FOR BLINDING CONCRETE.
3. GRADE OF REINFORCEMENT SHALL BE DEFORMED BAR 420 MPa (GRADE 60) - ASTM A615/A615M.
4. NET SAFE BEARING CAPACITY OF SOIL AT BOTTOM OF FOUNDATION CONSIDER 400KN/ SQ. M.
5. CLEAR COVER TO MAIN REINFORCEMENT SHALL BE 75 mm FOR RAFT & 50 mm FOR COLUMN.
6. IF ANY PART OF FOUNDATION COMES ON BACKFILL ZONE OF ADJACENT FOUNDATION OR ANY LOOSE SOIL ARE ENCOUNTERED BELOW FOUNDATION LEVEL THE SAME SHALL BE REMOVED AND FILLED WITH PCC.
7. BOLTS TO BE SUPPLIED BY EQUIPMENT SUPPLIER.

DOCUMENT NUMBER	REFERENCE DOCUMENTS	REV	DATE	REVISION DESCRIPTION	DRN	CHK	ENG	APP	EMP
		D01	15/03/2023	AS-BUILT	PDK	SGC	SHD	PRI	
		C02	04/01/2021	ISSUED FOR CONSTRUCTION & REVISED AS MKD. C02	PDK	SGC	SHD	PRI	
		C01	30/01/2020	ISSUED FOR CONSTRUCTION & REVISED AS MKD. C01	PDK	SGC	SHD	PRI	
MD-216-3340-EG-ME-GAD-1002	CONCENTRATE THICKENING	A01	07/01/2020	ISSUED FOR REFERENCE	PDK	SGC	SHD	PRI	

RESERVED FOR VENDOR LOGO AND DRAWING NUMBER

LARSEN & TOUBRO

This drawing is the property of LARSEN & TOUBRO and must not be passed on to any person or body not authorized by us to receive it nor be copied or otherwise made use either in full or in part by such person or body without our prior permission in writing.

Outotec

The content of these documents are the sole property of Outotec Oyj. Any rights not expressly granted herein are reserved. Reproduction, transfer or distribution of part or all of the contents in any form without prior written permission of Outotec is prohibited.

MA'ADEN معادن
Saudi Arabian Mining Company شركة التعدين العربية السعودية

This document and the information contained herein is Ma'aden proprietary know-how. This document or any part thereof should not be reproduced, stored in a retrieval system or transmitted by any means, electronic or otherwise, or divulged without prior written permission of Ma'aden.

LARSEN & TOUBRO DRAWING NUMBER: 019045_450_C_G_24092_001 — REVISION: 3
OUTOTEC DRAWING NUMBER: 900707__GAU01__ST01__MTL01__33410 — DOCUMENT ID: OU100666558 — REVISION: 3

DRAWN	PDK	18/12/2019
CHECKED	SGC	19/12/2019
ENGINEER	SHD	16/12/2019
APPROVED	PRI	07/01/2020
EMPLOYER		
SCALE 1:75, 1:25		A1

MANSOURAH - MASSARAH GOLD PROJECT
GENERAL ARRANGEMENT DRAWING
CONCENTRATE THICKENING
LAY. & DET. OF THK. FDN. MKD. 3340-THK-001

DRAWING NUMBER: MD - 216 - 3340 - EG - CV - GAD - 1214 — REV: D01