


DRAWING NUMBER: MD-216-3340-EG-CV-GAD-1215 | REV: D01

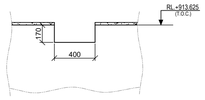


SECTION : G - G
(SCALE - 1:20)

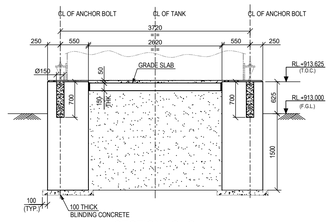


SECTION : C - C
(SCALE - 1:40)

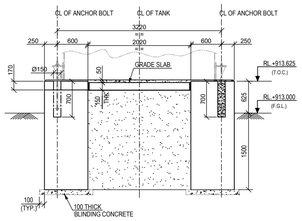


SECTION : D - D
(SCALE - 1:40)

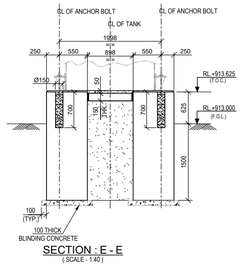


SECTION : E - E
(SCALE - 1:40)

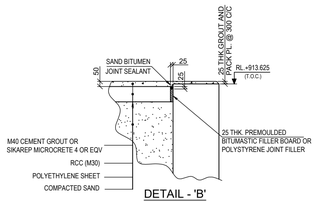


DETAIL - 'B'
(SCALE- 1:20)

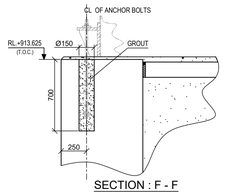


SECTION : F - F
(SCALE- 1:20)

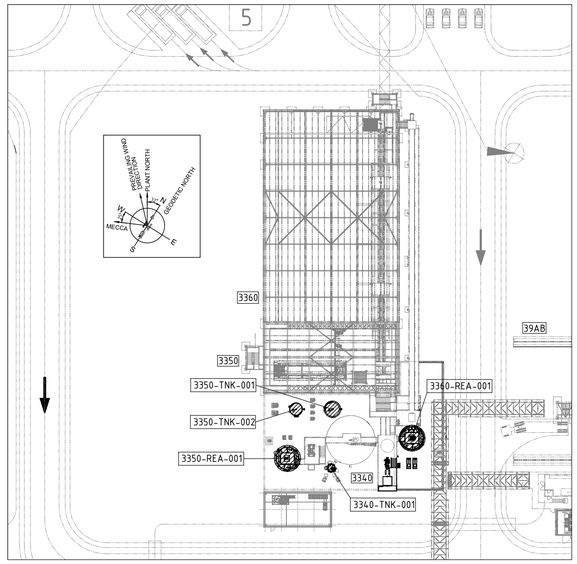


KEY PLAN
(SCALE- 1:500)

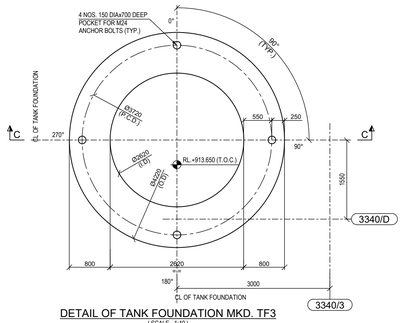


DETAIL OF TANK FOUNDATION MKD. TF3
(SCALE - 1:40)

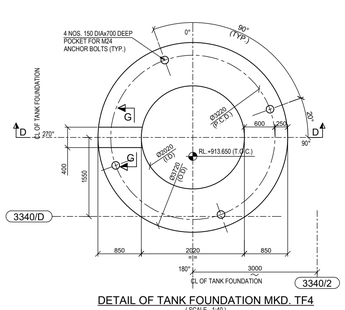


DETAIL OF TANK FOUNDATION MKD. TF4
(SCALE - 1:40)

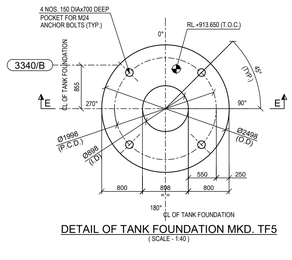


DETAIL OF TANK FOUNDATION MKD. TF5
(SCALE - 1:40)

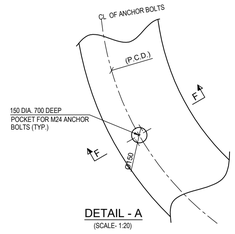


DETAIL - A
(SCALE- 1:20)

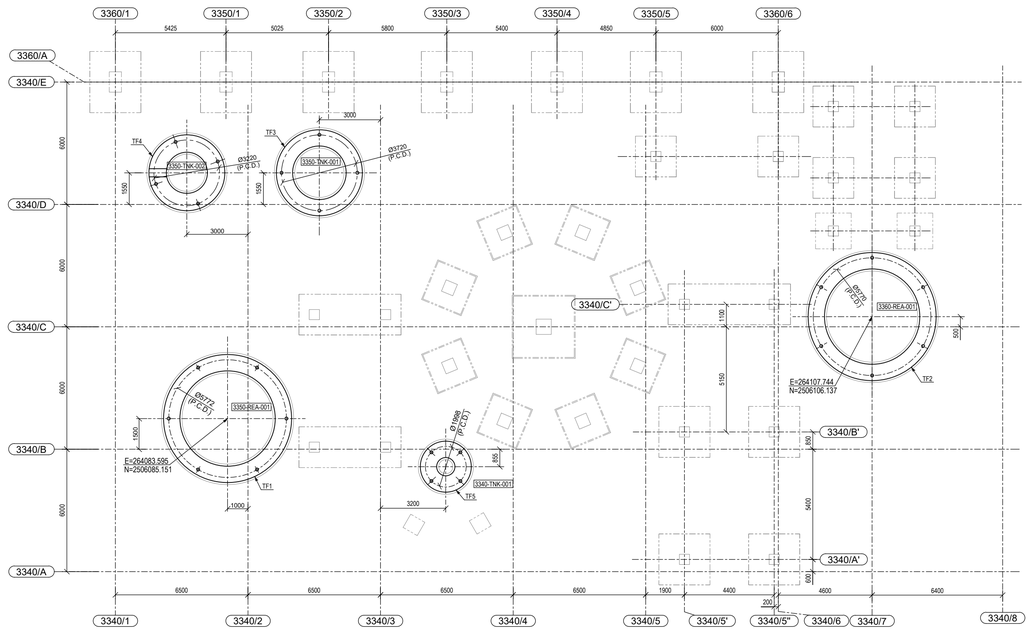


FOUNDATION LAYOUT FOR TANKS
(SCALE - 1:100)

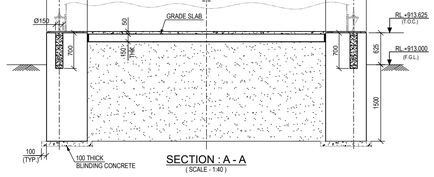


SECTION : A - A
(SCALE - 1:40)

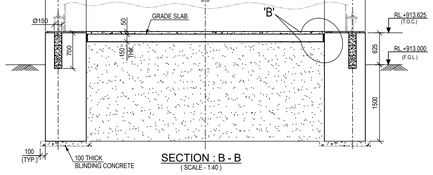

SECTION : B - B
(SCALE - 1:40)

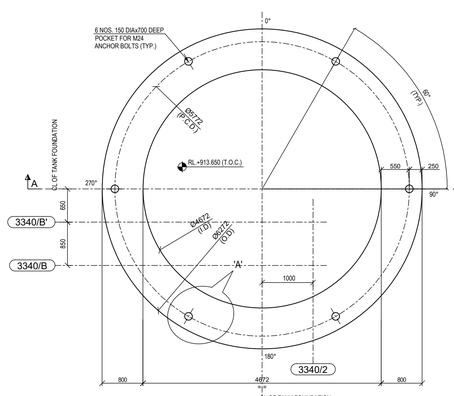

DETAIL OF TANK FOUNDATION MKD. TF1
(SCALE - 1:40)

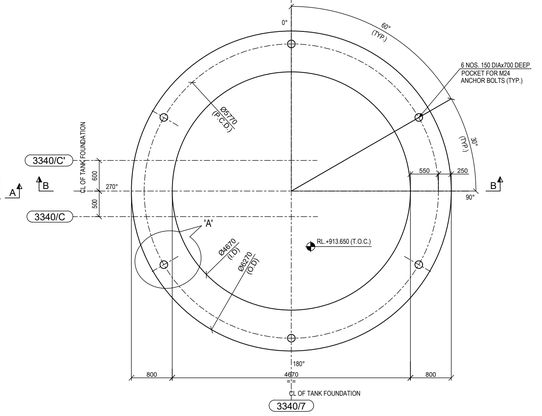

DETAIL OF TANK FOUNDATION MKD. TF2
(SCALE - 1:40)

LEGEND :-

RL	REDUCED LEVEL.
CL	CENTRE LINE.
T.O.C.	TOP OF CONCRETE.
F.G.L	FINISHED GROUND LEVEL.
P.C.D	PITCH CIRCLE DIAMETER.
TYP	TYPICAL.
PCC	PLAIN CEMENT CONCRETE.
MKD.	MARKED.
Ø	DIAMETER.
R	RADIUS.
I.D	INNER DIAMETER.
O.D	OUTER DIAMETER.
THK.	THICK.
DET.	DETAIL.
TNK.	TANK.
FDN.	FOUNDATION.

NOTES:-

1. ALL DIMENSIONS ARE IN MILLIMETERS AND LEVELS AND CO-ORDINATES ARE IN METERS. UNLESS OTHERWISE STATED.
2. GRADE OF CONCRETE SHALL BE C35 (35MPa) FOR FOUNDATION, C30 (30MPa) FOR GRADE SLAB & C15 (15MPa) FOR BLINDING CONCRETE.
3. GRADE OF REINFORCEMENT SHALL BE DEFORMED BAR 420 MPa (GRADE 60) - ASTM A615/A615M.
4. NET SAFE BEARING CAPACITY OF SOIL AT BOTTOM OF FOUNDATION CONSIDER 450KN/ SQ. M (BH-7).
5. CLEAR COVER TO MAIN REINFORCEMENT SHALL BE 75 mm.
6. IF ANY PART OF FOUNDATION COMES ON BACKFILL ZONE OF ADJACENT FOUNDATION OR ANY LOOSE SOIL ARE ENCOUNTERED BELOW FOUNDATION LEVEL THE SAME SHALL BE REMOVED AND FILLED WITH PCC.
7. BOLTS TO BE SUPPLIED BY EQUIPMENT SUPPLIER.
8. THE FIRST 300mm WIDTH OF AN ANNULAR RING MEASURED FROM THE OUTSIDE OF THE TANK RADIALLY TOWARDS THE CENTRE SHALL BE WITHIN +/-3mm OF THE DESIGN LEVEL.
9. THE REMAINDER OF THE FOUNDATION SHALL BE WITHIN +/-6mm OF THE DESIGN LEVEL.
10. FOR R.C. DETAIL REFER DRAWING NO. MD-216-3360-EG-CV-DED-1218.
11. ALL OTHER NOTES REFER DRAWING NO. MD-101-SMEM-EG-ST-DST-0001 TO 0008.

DOCUMENT NUMBER	REFERENCE DOCUMENTS
MD-216-1000-EG-ST-CRT-1001	CIVIL, STRUCTURAL AND ARCHITECTURAL DESIGN CRITERIA
MD-216-3000-EG-CV-RPT-1008	GEOTECHNICAL REPORT
MD-216-3350-EG-ME-GAD-1058	3350-TNK-002 FILTER CLOTH WASH TANK
MD-216-3350-EG-ME-GAD-1057	3350-TNK-001 FILTRATE TANK
MD-216-3340-EG-ME-GAD-1024	3340-TNK-001 FLOTATION CONCENTRATE THICKENER
	OVERFLOW TANK
MD-216-3360-EG-ME-PLN-1001	3360-REA-001 CONCENTRATE REPULP TANK
MD-216-3350-EG-ME-PLN-1002	3350-REA-001 CONCENTRATE FILTER FEED TANK

REV	DATE	REVISION DESCRIPTION	DRN	CHK	ENG	APP	EMP
D01	15/03/2023	AS-BUILT	AMJ	SGC	SHD	PRI	
C03	03/10/2020	ISSUED FOR CONSTRUCTION & REVISED AS MKD. C02	AMJ	SGC	SHD	PRI	
C02	13/04/2020	ISSUED FOR CONSTRUCTION & REVISED AS MKD. C01	PDK	SGC	SHD	PRI	
C01	23/03/2020	ISSUED FOR CONSTRUCTION	PDK	SGC	SHD	PRI	
A01	18/02/2020	ISSUED FOR REFERENCE	PDK	SGC	SHD	PRI	

RESERVED FOR VENDOR LOGO AND DRAWING NUMBER

LARSEN & TOUBRO

This drawing is the property of LARSEN & TOUBRO and must not be passed on to any person or body not authorized by us to receive it nor be copied or otherwise made use either in full or in part by such person or body without our prior permission in writing.

Outotec

The content of these documents are the sole property of Outotec Oyj. Any rights not expressly granted herein are reserved. Reproduction, transfer or distribution of part or all of the contents in any form without prior written permission of Outotec is prohibited.

MA'ADEN — Saudi Arabian Mining Company

This document and the information contained herein is Ma'aden proprietary know-how. This document or any part thereof should not be reproduced, stored in a retrieval system or transmitted by any means, electronic or otherwise, or divulged without prior written permission of Ma'aden.

LARSEN & TOUBRO DRAWING NUMBER	019045_450_C_G_24092_002		REVISION 4
OUTOTEC DRAWING NUMBER	900707__GAU01__ST01__MTL01__33411	DOCUMENT ID OU100666559	REVISION 4
DRAWN	PDK	30/01/2020	MANSOURAH - MASSARAH GOLD PROJECT
CHECKED	SGC	12/02/2020	GENERAL ARRANGEMENT DRAWING
ENGINEER	SHD	03/02/2020	CONCENTRATE THICKENING
APPROVED	PRI	18/02/2020	DETAIL OF FDN. MKD. TF1, TF2, TF3, TF4 & TF5
EMPLOYER			
SCALE	1:100, 1:40, 1:20	A0	DRAWING NUMBER MD-216-3340-EG-CV-GAD-1215 REV D01