


DRAWING NUMBER: MD-216-3340-EG-CV-GAD-1216 | REV: D01

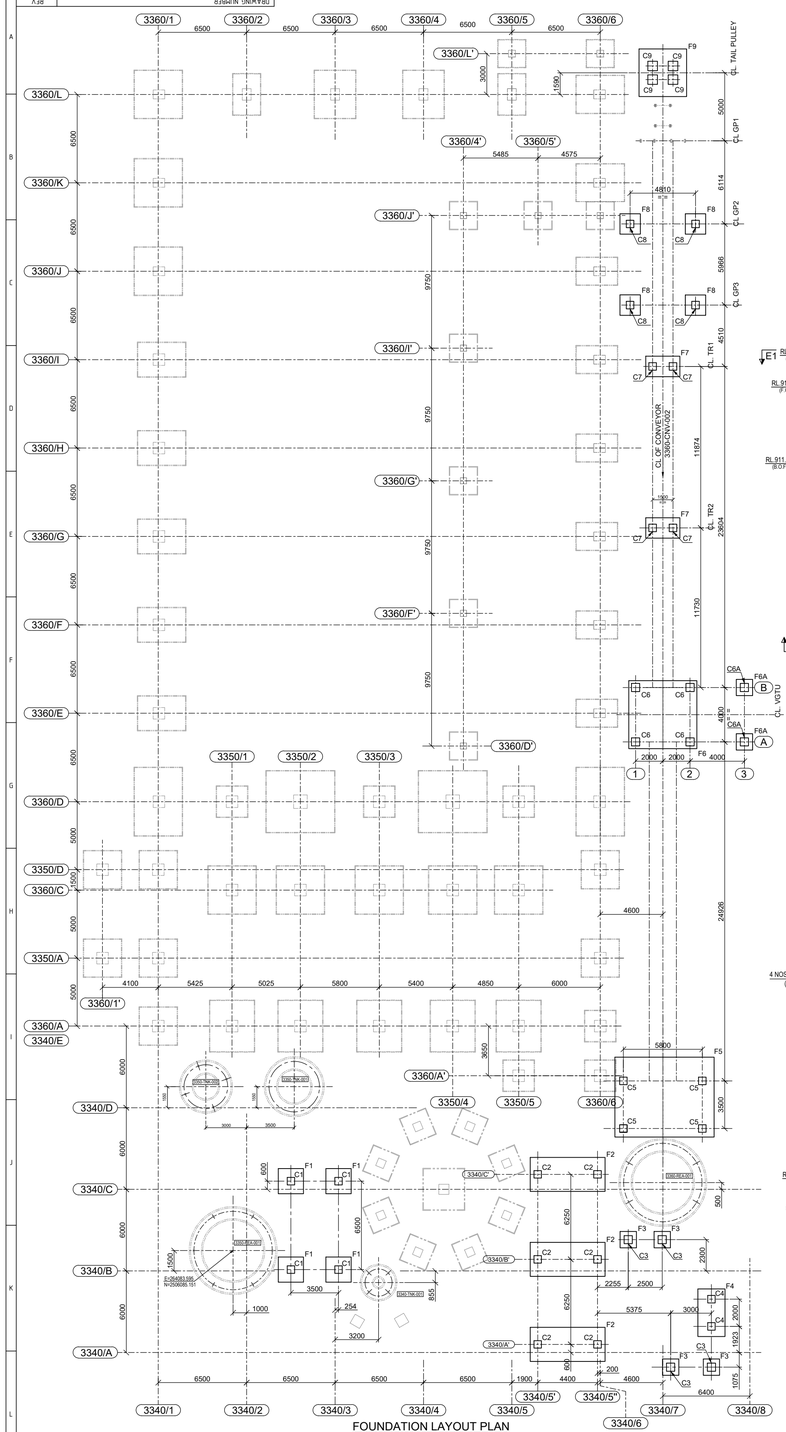


FOUNDATION LAYOUT PLAN
(SCALE 1:150)

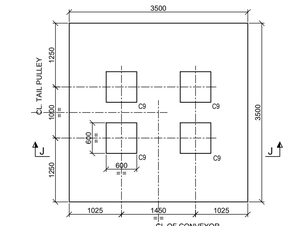


DETAIL OF FOUNDATION MKD. F9
(1 NO. REQUIRED)
(SCALE - 1:40)

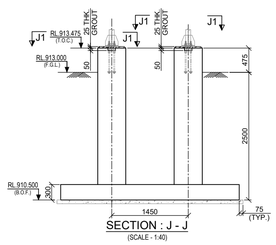


SECTION : J - J
(SCALE - 1:40)

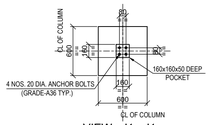


VIEW : J1 - J1
(SCALE- 1:25)

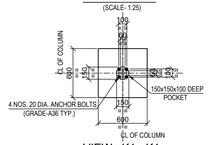


VIEW : K1 - K1
(SCALE- 1:25)

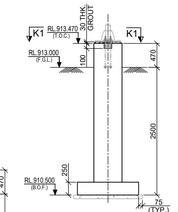


SECTION : K - K
(SCALE - 1:40)

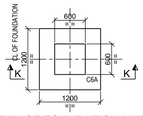


DETAIL OF FOUNDATION MKD. F6A
(2 NOS. REQUIRED)
(SCALE - 1:40)

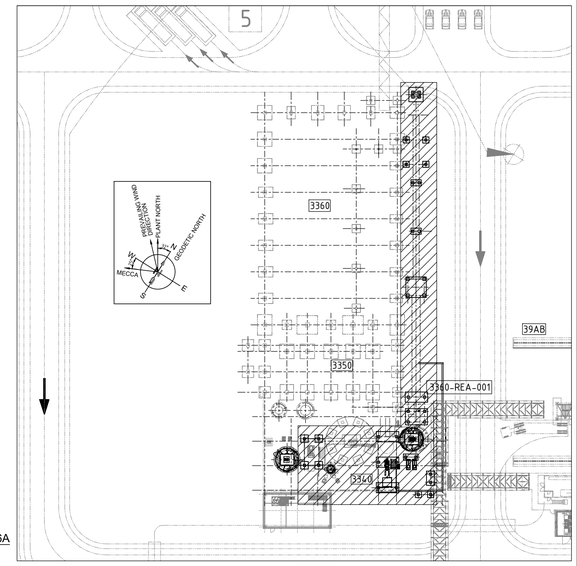


KEY PLAN
(SCALE- 1:500)

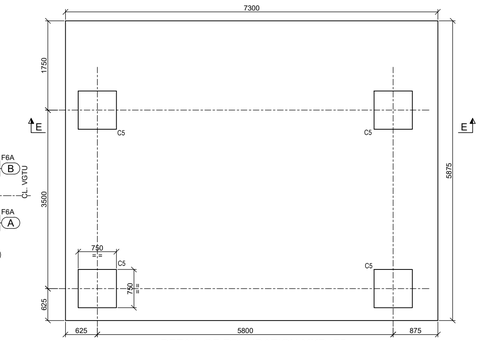


DETAIL OF FOUNDATION MKD. F5
(1 NO. REQUIRED)
(SCALE - 1:40)

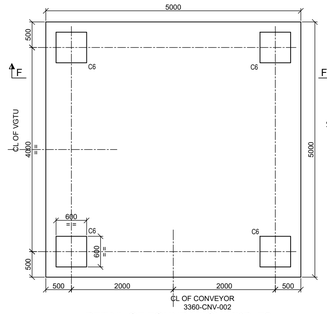


DETAIL OF FOUNDATION MKD. F6
(1 NO. REQUIRED)
(SCALE - 1:40)

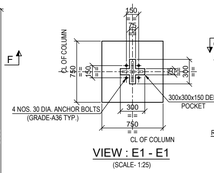


VIEW : E1 - E1
(SCALE- 1:25)

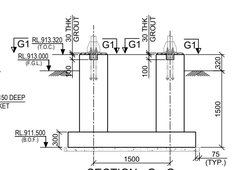


SECTION : G - G
(SCALE - 1:40)

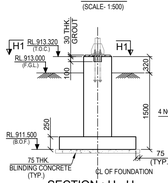


SECTION : H - H
(SCALE - 1:40)

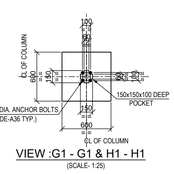


VIEW :G1 - G1 & H1 - H1
(SCALE- 1:25)

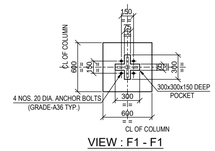


VIEW : F1 - F1
(SCALE- 1:25)

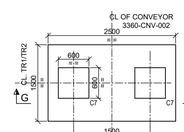


DETAIL OF FOUNDATION MKD. F7
(2 NOS. REQUIRED)
(SCALE - 1:40)

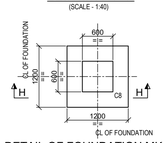


DETAIL OF FOUNDATION MKD. F8
(4 NOS. REQUIRED)
(SCALE - 1:40)

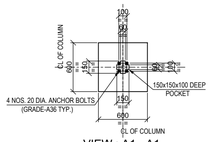


VIEW : A1 - A1
(SCALE- 1:25)

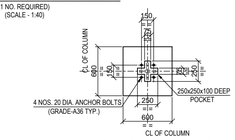


VIEW : B1 - B1 & D1 - D1
(SCALE- 1:25)

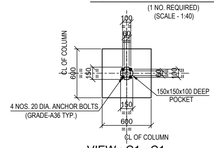


VIEW : C1 - C1
(SCALE- 1:25)

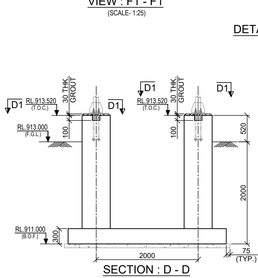


SECTION : D - D
(SCALE - 1:40)

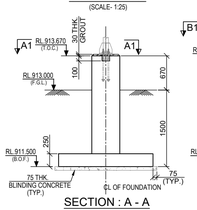


SECTION : A - A
(SCALE - 1:40)

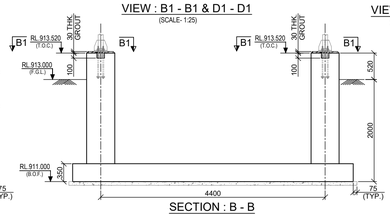


SECTION : B - B
(SCALE - 1:40)

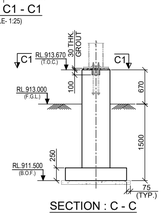


SECTION : C - C
(SCALE - 1:40)

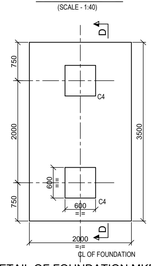


DETAIL OF FOUNDATION MKD. F4
(1 NO. REQUIRED)
(SCALE - 1:40)

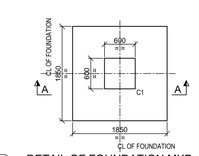

DETAIL OF FOUNDATION MKD. F1
(4 NOS. REQUIRED)
(SCALE - 1:40)

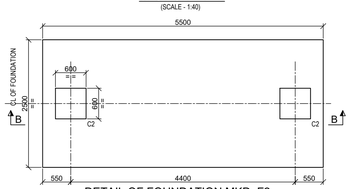

DETAIL OF FOUNDATION MKD. F2
(3 NOS. REQUIRED)
(SCALE - 1:40)

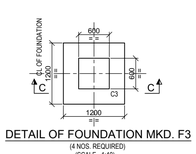

DETAIL OF FOUNDATION MKD. F3
(4 NOS. REQUIRED)
(SCALE - 1:40)

LEGENDS :-

RL - REDUCED LEVEL
T.O.C. - TOP OF CONCRETE.
F.G.L. - FINISHED GROUND LEVEL.
B.O.F. - BOTTOM OF FOOTING.
CL - CENTRE LINE.
TYP. - TYPICAL.
THK - THICK.
MKD - MARKED.
C/C - CENTER TO CENTER.
DIA - DIAMETER.

NOTES :-

1. ALL DIMENSIONS ARE IN MILLIMETERS AND LEVELS AND CO-ORDINATES ARE IN METERS. UNLESS OTHERWISE STATED.
2. GRADE OF CONCRETE SHALL BE 35 MPa FOR FOUNDATION & 15 MPa FOR BLINDING CONCRETE.
3. GRADE OF REINFORCEMENT SHALL BE DEFORMED BAR 420 MPa (GRADE 60) - ASTM A615/A615M.
4. NET SAFE BEARING CAPACITY OF SOIL AT BOTTOM OF FOUNDATION CONSIDER 450KN/ SQ. M.
5. CLEAR COVER TO MAIN REINFORCEMENT SHALL BE 75 mm FOR RAFT & 50 mm FOR COLUMN.
6. IF ANY PART OF FOUNDATION COMES ON BACKFILL ZONE OF ADJACENT FOUNDATION OR ANY LOOSE SOIL ARE ENCOUNTERED BELOW FOUNDATION LEVEL THE SAME SHALL BE REMOVED AND FILLED WITH PCC.
7. THIS DRAWING SHALL BE READ IN CONJUNCTION WITH DRAWING NO. MD-216-3340-EG-ST-GAD-2189 TO 2195.
8. ALL OTHER NOTES REFER DRAWING NO. MD-101-SMEM-EG-ST-DST-0001 TO 0008.
9. GENERAL NOTES FOR CIVIL WORKS & STANDARD REINFORCEMENT DETAIL REFER DRAWING NO. MD-216-1000-EG-CV-DED-1001 & 1005.

DOCUMENT NUMBER	REFERENCE DOCUMENTS
MD-216-1000-EG-ST-CRT-1001	CIVIL, STRUCTURAL AND ARCHITECTURAL DESIGN CRITERIA
MD-216-3000-EG-CV-RPT-1008	GEOTECHNICAL REPORT
MD-216-1000-EG-CV-DED-1003	ANCHOR BOLTS STANDARD DETAILS.
MD-216-3340-EG-ME-GAD-1021	PLAN AT. +913.000
MD-216-3340-EG-ME-GAD-1003	PLAN AT. +921.750
MD-216-3360-EG-ME-ELV-1004	CONV. 3360-CNV-002-ELEVATION
MD-216-3360-EG-ME-LPX-1002	CONV. 3360-CNV-002-PLAN VIEW
MD-216-3360-EG-ME-ELV-1003	CONV. 3360-CNV-002-ELEVATION

REV	DATE	REVISION DESCRIPTION	DRN	CHK	ENG	APP	EMP
D01	15/03/2023	AS-BUILT	PDK	SGC	SHD	PRI	
C02	22/10/2020	ISSUED FOR CONSTRUCTION & REVISED AS MKD. (02)	PDK	SGC	SHD	PRI	
C01	29/06/2020	ISSUED FOR CONSTRUCTION	PDK	SGC	SHD	PRI	
A01	30/05/2020	ISSUED FOR REFERENCE	PDK	SGC	SHD	PRI	

RESERVED FOR VENDOR LOGO AND DRAWING NUMBER

LARSEN & TOUBRO

This drawing is the property of LARSEN & TOUBRO and must not be passed on to any person or body not authorized by us to receive it nor be copied or otherwise made use either in full or in part by such person or body without our prior permission in writing.

Outotec

The content of these documents are the sole property of Outotec Oyj. Any rights not expressly granted herein are reserved. Reproduction, transfer or distribution of part or all of the contents in any form without prior written permission of Outotec is prohibited.

MA'ADEN
Saudi Arabian Mining Company

This document and the information contained herein is Ma'aden proprietary know-how. This document or any part thereof should not be reproduced, stored in a retrieval system or transmitted by any means, electronic or otherwise, or divulged without prior written permission of Ma'aden.

LARSEN & TOUBRO DRAWING NUMBER			REVISION
019045_450_C_G_24092_003			3
OUTOTEC DRAWING NUMBER		DOCUMENT ID	REVISION
900707__GAU01__ST01__MTL01__33412		OU100666560	3
DRAWN	PDK	18/05/2020	MANSOURAH - MASSARAH GOLD PROJECT
CHECKED	SGC	25/05/2020	GENERAL ARRANGEMENT DRAWING
ENGINEER	SHD	15/05/2020	CONCENTRATE THICKENING
APPROVED	PRI	30/05/2020	DETAIL OF MISCELLANEOUS FOUNDATION
EMPLOYER			
SCALE 1:100, 1:40, 1:20		A0	DRAWING NUMBER: MD - 216 - 3340 - EG - CV - GAD - 1216
			REV: D01

C02