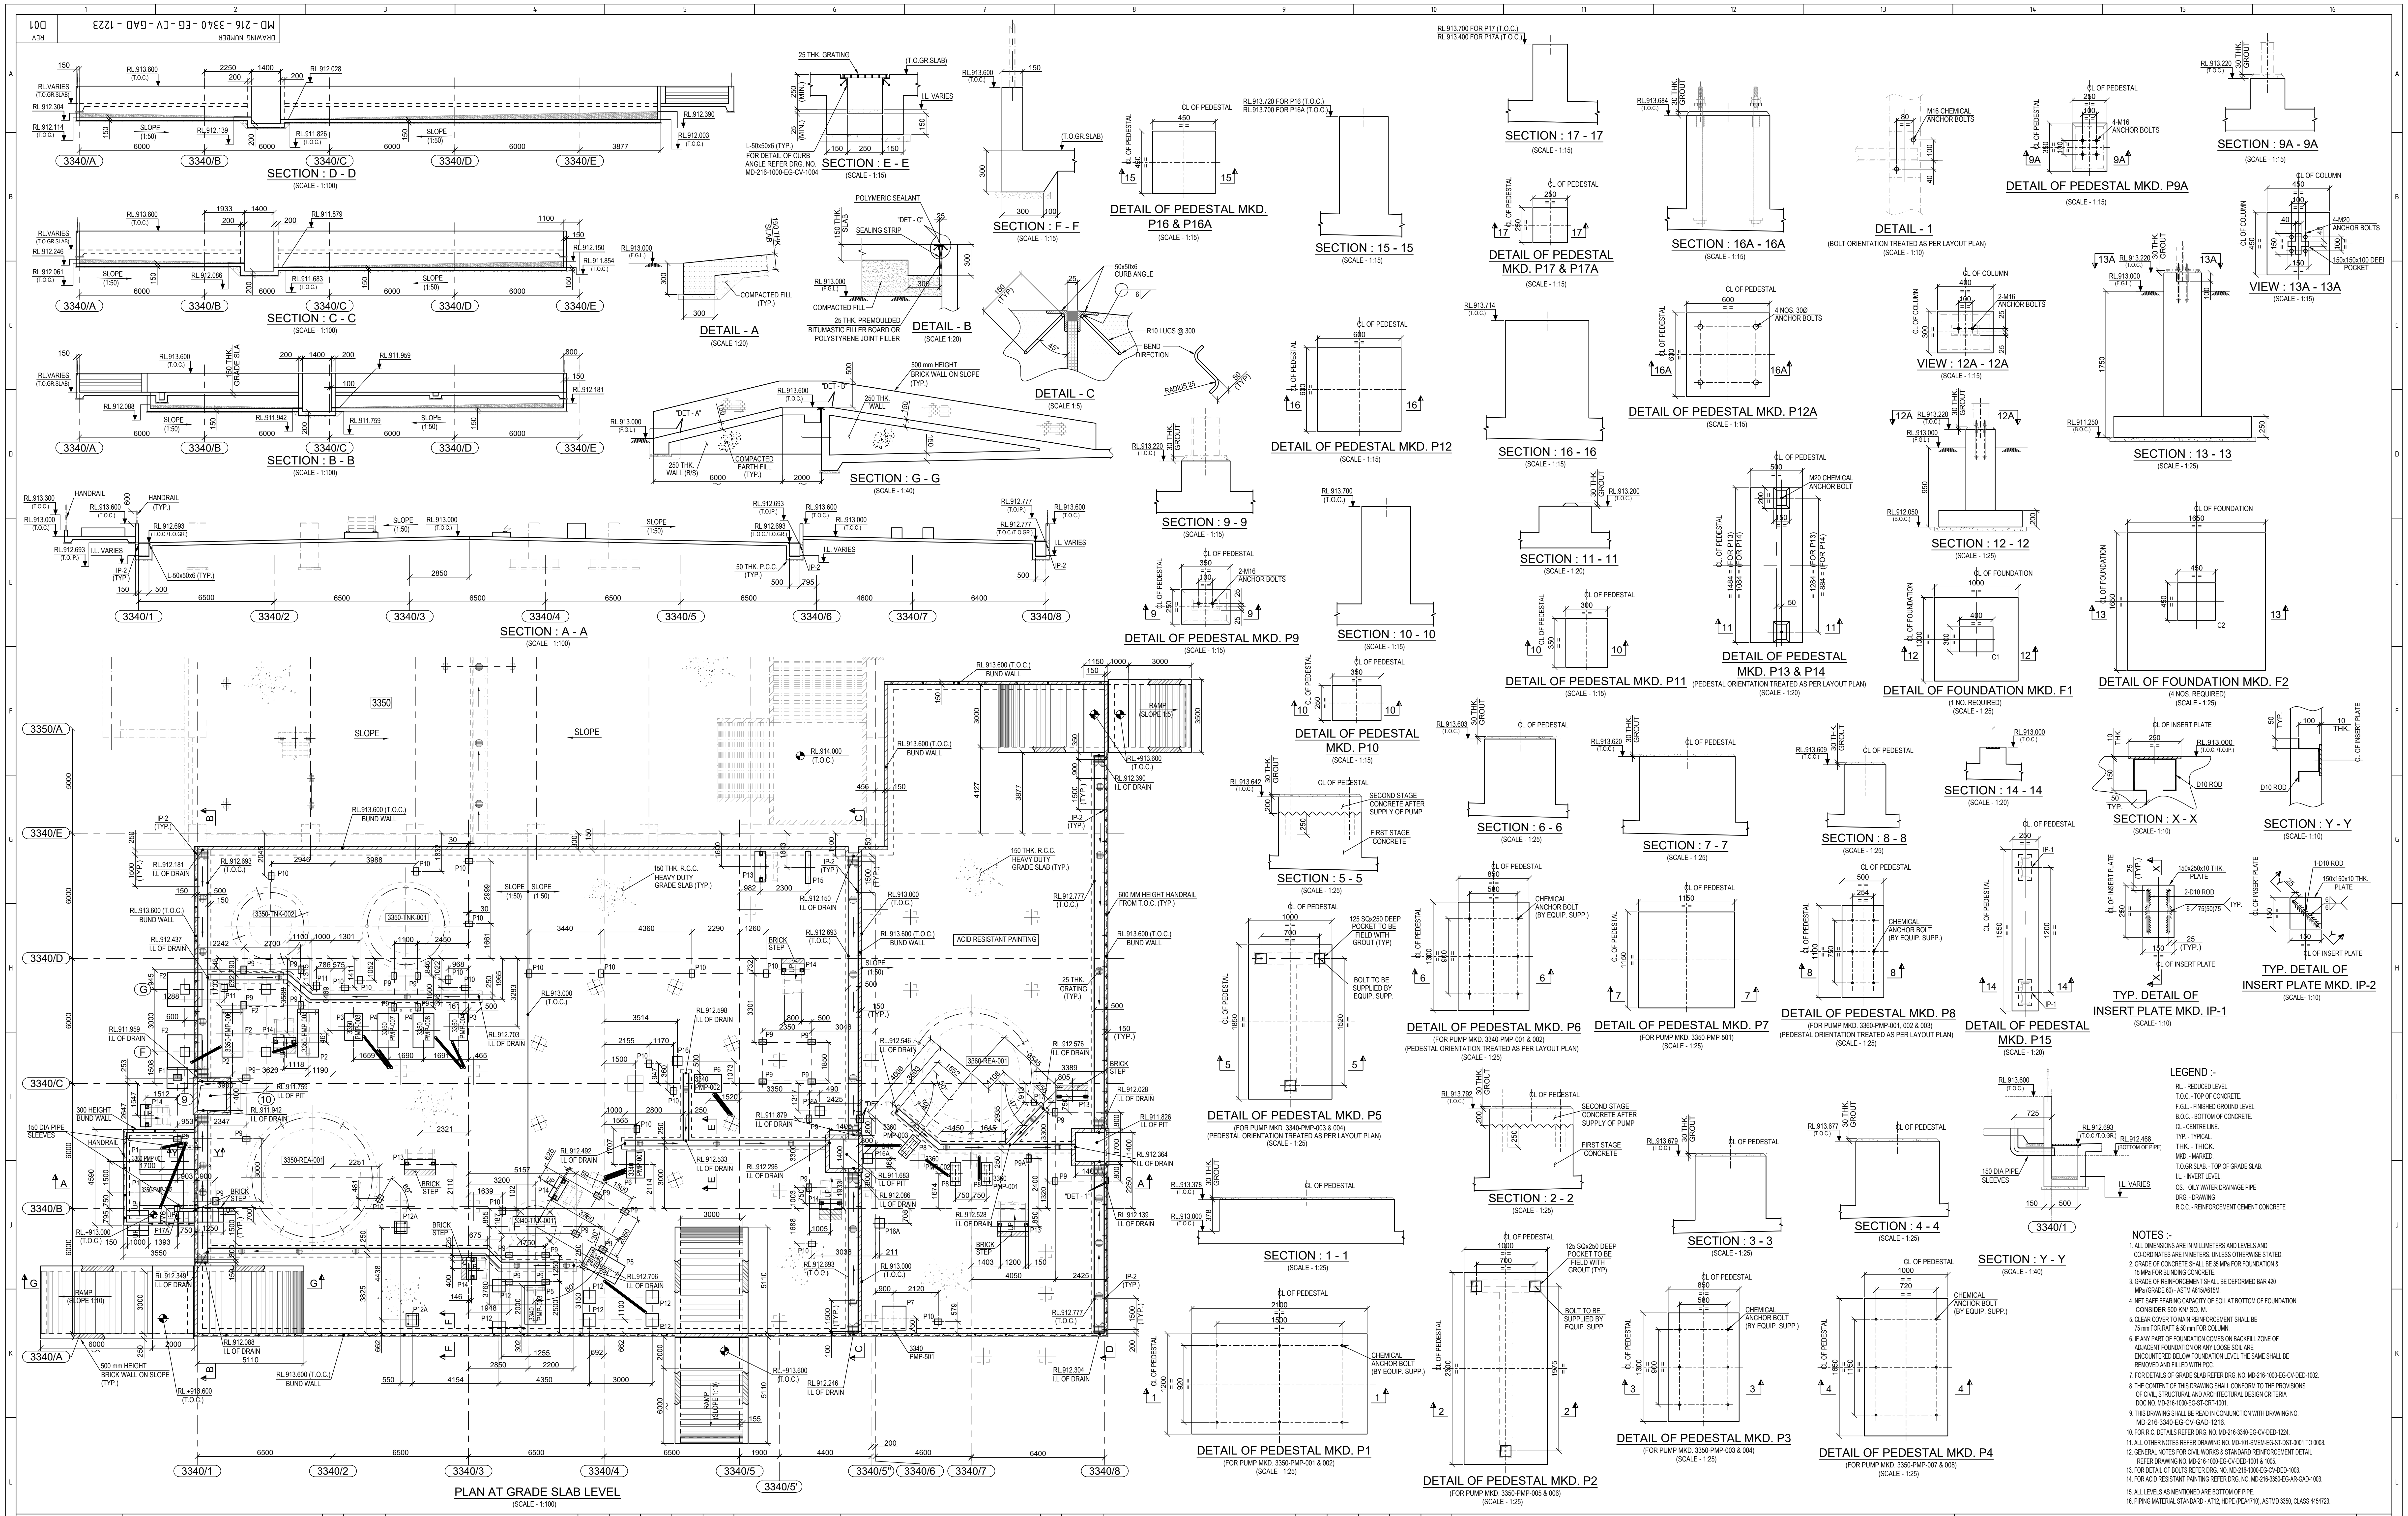
SECTION : D - D (SCALE - 1:100)
SECTION : C - C (SCALE - 1:100)
SECTION : B - B (SCALE - 1:100)
SECTION : A - A (SCALE - 1:100)
SECTION : E - E (SCALE - 1:15)
SECTION : F - F (SCALE - 1:15)
DETAIL - A (SCALE 1:20)
DETAIL - B (SCALE 1:20)
DETAIL - C (SCALE 1:5)
SECTION : G - G (SCALE - 1:40)
DETAIL OF PEDESTAL MKD. P16 & P16A (SCALE - 1:15)
SECTION : 15 - 15 (SCALE - 1:15)
DETAIL OF PEDESTAL MKD. P12 (SCALE - 1:15)
SECTION : 9 - 9 (SCALE - 1:15)
DETAIL OF PEDESTAL MKD. P9 (SCALE - 1:15)
SECTION : 10 - 10 (SCALE - 1:15)
DETAIL OF PEDESTAL MKD. P10 (SCALE - 1:15)
SECTION : 17 - 17 (SCALE - 1:15)
DETAIL OF PEDESTAL MKD. P17 & P17A (SCALE - 1:15)
SECTION : 16 - 16 (SCALE - 1:15)
SECTION : 11 - 11 (SCALE - 1:20)
DETAIL OF PEDESTAL MKD. P11 (SCALE - 1:15)
SECTION : 16A - 16A (SCALE - 1:15)
DETAIL OF PEDESTAL MKD. P12A (SCALE - 1:15)
DETAIL OF PEDESTAL MKD. P13 & P14 (PEDESTAL ORIENTATION TREATED AS PER LAYOUT PLAN) (SCALE - 1:20)
DETAIL - 1 (BOLT ORIENTATION TREATED AS PER LAYOUT PLAN) (SCALE - 1:10)
VIEW : 12A - 12A (SCALE - 1:15)
SECTION : 12 - 12 (SCALE - 1:25)
DETAIL OF FOUNDATION MKD. F1 (1 NO. REQUIRED) (SCALE - 1:25)
DETAIL OF PEDESTAL MKD. P9A (SCALE - 1:15)
SECTION : 9A - 9A (SCALE - 1:15)
VIEW : 13A - 13A (SCALE - 1:15)
SECTION : 13 - 13 (SCALE - 1:25)
DETAIL OF FOUNDATION MKD. F2 (4 NOS. REQUIRED) (SCALE - 1:25)
SECTION : 14 - 14 (SCALE - 1:20)
SECTION : X - X (SCALE - 1:10)
SECTION : Y - Y (SCALE - 1:10)
SECTION : 5 - 5 (SCALE - 1:25)
SECTION : 6 - 6 (SCALE - 1:25)
SECTION : 7 - 7 (SCALE - 1:25)
SECTION : 8 - 8 (SCALE - 1:25)
DETAIL OF PEDESTAL MKD. P15 (SCALE - 1:20)
TYP. DETAIL OF INSERT PLATE MKD. IP-1 (SCALE- 1:10)
TYP. DETAIL OF INSERT PLATE MKD. IP-2 (SCALE- 1:10)
DETAIL OF PEDESTAL MKD. P5 (FOR PUMP MKD. 3340-PMP-003 & 004) (PEDESTAL ORIENTATION TREATED AS PER LAYOUT PLAN) (SCALE - 1:25)
DETAIL OF PEDESTAL MKD. P6 (FOR PUMP MKD. 3340-PMP-001 & 002) (PEDESTAL ORIENTATION TREATED AS PER LAYOUT PLAN) (SCALE - 1:25)
DETAIL OF PEDESTAL MKD. P7 (FOR PUMP MKD. 3350-PMP-501) (SCALE - 1:25)
DETAIL OF PEDESTAL MKD. P8 (FOR PUMP MKD. 3360-PMP-001, 002 & 003) (PEDESTAL ORIENTATION TREATED AS PER LAYOUT PLAN) (SCALE - 1:25)
SECTION : 1 - 1 (SCALE - 1:25)
SECTION : 2 - 2 (SCALE - 1:25)
SECTION : 3 - 3 (SCALE - 1:25)
SECTION : 4 - 4 (SCALE - 1:25)
SECTION : Y - Y (SCALE - 1:40)
DETAIL OF PEDESTAL MKD. P1 (FOR PUMP MKD. 3350-PMP-001 & 002) (SCALE - 1:25)
DETAIL OF PEDESTAL MKD. P2 (FOR PUMP MKD. 3350-PMP-005 & 006) (SCALE - 1:25)
DETAIL OF PEDESTAL MKD. P3 (FOR PUMP MKD. 3350-PMP-003 & 004) (SCALE - 1:25)
DETAIL OF PEDESTAL MKD. P4 (FOR PUMP MKD. 3350-PMP-007 & 008) (SCALE - 1:25)
PLAN AT GRADE SLAB LEVEL (SCALE - 1:100)

LEGEND :-

RL. - REDUCED LEVEL.
T.O.C. - TOP OF CONCRETE.
F.G.L. - FINISHED GROUND LEVEL.
B.O.C. - BOTTOM OF CONCRETE.
CL - CENTRE LINE.
TYP. - TYPICAL.
THK. - THICK.
MKD. - MARKED.
T.O.GR.SLAB. - TOP OF GRADE SLAB.
I.L. - INVERT LEVEL.
OS. - OILY WATER DRAINAGE PIPE
DRG. - DRAWING
R.C.C. - REINFORCEMENT CEMENT CONCRETE

NOTES :-

1. ALL DIMENSIONS ARE IN MILLIMETERS AND LEVELS AND CO-ORDINATES ARE IN METERS. UNLESS OTHERWISE STATED.
2. GRADE OF CONCRETE SHALL BE 35 MPa FOR FOUNDATION & 15 MPa FOR BLINDING CONCRETE.
3. GRADE OF REINFORCEMENT SHALL BE DEFORMED BAR 420 MPa (GRADE 60) - ASTM A615/A615M.
4. NET SAFE BEARING CAPACITY OF SOIL AT BOTTOM OF FOUNDATION CONSIDER 500 KN/ SQ. M.
5. CLEAR COVER TO MAIN REINFORCEMENT SHALL BE 75 mm FOR RAFT & 50 mm FOR COLUMN.
6. IF ANY PART OF FOUNDATION COMES ON BACKFILL ZONE OF ADJACENT FOUNDATION OR ANY LOOSE SOIL ARE ENCOUNTERED BELOW FOUNDATION LEVEL THE SAME SHALL BE REMOVED AND FILLED WITH PCC.
7. FOR DETAILS OF GRADE SLAB REFER DRG. NO. MD-216-1000-EG-CV-DED-1002.
8. THE CONTENT OF THIS DRAWING SHALL CONFORM TO THE PROVISIONS OF CIVIL, STRUCTURAL AND ARCHITECTURAL DESIGN CRITERIA DOC NO. MD-216-1000-EG-ST-CRT-1001.
9. THIS DRAWING SHALL BE READ IN CONJUNCTION WITH DRAWING NO. MD-216-3340-EG-CV-GAD-1216.
10. FOR R.C. DETAILS REFER DRG. NO. MD-216-3340-EG-CV-DED-1224.
11. ALL OTHER NOTES REFER DRAWING NO. MD-101-SMEM-EG-ST-DST-0001 TO 0008.
12. GENERAL NOTES FOR CIVIL WORKS & STANDARD REINFORCEMENT DETAIL REFER DRAWING NO. MD-216-1000-EG-CV-DED-1001 & 1005.
13. FOR DETAIL OF BOLTS REFER DRG. NO. MD-216-1000-EG-CV-DED-1003.
14. FOR ACID RESISTANT PAINTING REFER DRG. NO. MD-216-3350-EG-AR-GAD-1003.
15. ALL LEVELS AS MENTIONED ARE BOTTOM OF PIPE.
16. PIPING MATERIAL STANDARD - AT12, HDPE (PEA4710), ASTMD 3350, CLASS 4454723.

DOCUMENT NUMBER	REFERENCE DOCUMENTS	REV	DATE	REVISION DESCRIPTION	DRN	CHK	ENG	APP	EMP
		D01	15/03/2023	AS-BUILT	SUP	SGC	SHD	PRI	
		C04	13/04/2021	ISSUED FOR CONSTRUCTION & REVISED AS MKD. C04	SUP	SGC	SHD	PRI	
MD-216-3340-EG-ST-GAD-2196	CONCENTRATE THICKENING, MISCELLANEOUS PLATFORMS	C03	10/03/2021	ISSUED FOR CONSTRUCTION & REVISED AS MKD. C03	PDK	SGC	SHD	PRI	
MD-216-1000-EG-ST-CRT-1001	CIVIL, STRUCTURAL AND ARCHITECTURAL DESIGN CRITERIA	C02	23/12/2020	ISSUED FOR CONSTRUCTION & REVISED AS MKD. C02	AMJ	SGC	SHD	PRI	
MD-216-3350-EG-AR-GAD-1001	CONCENTRATE FILTRATION, FLOOR PLAN	C01	12/11/2020	ISSUED FOR CONSTRUCTION & REVISED AS MKD. C01	PDK	SGC	SHD	PRI	
MD-216-3340-EG-ME-GAD-1021	CONCENTRATE THICKENING, PLAN AT 913.000	A01	30/09/2020	ISSUED FOR REFERENCE	PDK	SGC	SHD	PRI	

DOCUMENT NUMBER	REFERENCE DOCUMENTS	REV	DATE	REVISION DESCRIPTION	DRN	CHK	ENG	APP	EMP

RESERVED FOR VENDOR LOGO AND DRAWING NUMBER

This drawing is the property of LARSEN & TOUBRO and must not be passed on to any person or body not authorized by us to receive it nor be copied or otherwise made use either in full or in part by such person or body without our prior permission in writing.

The content of these documents are the sole property of Outotec Oyj. Any rights not expressly granted herein are reserved. Reproduction, transfer or distribution of part or all of the contents in any form without prior written permission of Outotec is prohibited.

Saudi Arabian Mining Company شركة التعدين العربية السعودية

This document and the information contained herein is Ma'aden proprietary know-how. This document or any part thereof should not be reproduced, stored in a retrieval system or transmitted by any means, electronic or otherwise, or divulged without prior written permission of Ma'aden.

LARSEN & TOUBRO DRAWING NUMBER	019045_450_C_G_24092_004	REVISION 5
OUTOTEC DRAWING NUMBER	900707 __GAU01 __ST01__MTL01 __33427	
DOCUMENT ID	0U100686830	REVISION 5

DRAWN	PDK	14/09/2020
CHECKED	SGC	21/09/2020
ENGINEER	SHD	11/09/2020
APPROVED	PRI	30/09/2020
EMPLOYER		
SCALE	1:100	A0

MANSOURAH - MASSARAH GOLD PROJECT
GENERAL ARRANGEMENT DRAWING
CONCENTRATE THICKENING
GENERAL ARRANGEMENT OF GRADE SLAB

DRAWING NUMBER: MD - 216 - 3340 - EG - CV - GAD - 1223
REV: D01